

State of Wisconsin

County of FOREST

ss. ESTABLISHMENT OF QUARTER - QUARTER SECTION CORNER BETWEEN ORIGINAL GOVERNMENT SURVEY CORNERS.

I, NEAL SPERHAKE, do hereby certify that on the TWENTY-EIGHTH day of JULY, 19 64, I established the SOUTH ONE SIXTEENTH CORNER BETWEEN SECTION 36 TOWNSHIP 35 NORTH, RANGE 13 EAST, AND SECTION 31, TOWNSHIP 35 NORTH, RANGE 14 EAST, Fourth Principal Meridian, as described hereon.

History: There is no record of this corner having ever been previously established.

Description of monument and accessories I established to perpetuate the location of this corner:


At the point determined for the location of the corner I emplaced a:

GALVANIZED IRON PIPE, THREE FEET LONG, ONE INCH IN DIAMETER, WITH ALUMINUM CAP DENOTED AS, "KIMBERLY CLARK CORP. T35N S 1/16 BTWN. 36 & 31 R13-14E SPERHAKE RLS 463 7/28/64."

The pipe is witnessed by:

- Maple 4 S 88°W 6 links. (SCRIBED S 36 BT).
- Maple 5 S 32°E 27 links. (SCRIBED S 31 BT).

Description as to how corner was located: Since both the section corner 1/4 mile south and the quarter section corner 1/4 mile north have been previously established with a distance between them of 39.75 chains, the S 1/16 corner was set 19.87 1/2 chains from either corner and on a straight line between them.

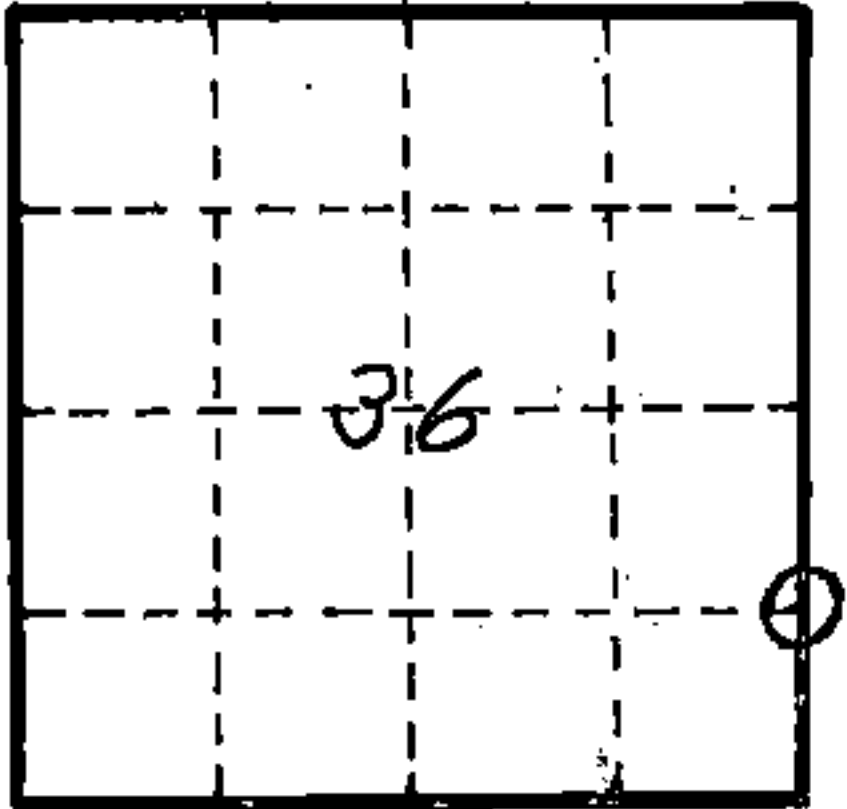

O = Corner monument restored

89623

REGISTRAR'S OFFICE
FOREST COUNTY, WIS.
JAN 12 1965
FILE
M. 10 o'clock A. L.
Anna Peterson Register of Deeds

Resident witnesses _____

Dated at Crandon, Wisconsin, this 12th day of January, 1965.

Signature Neal Sperhake

Title Registered Land Surveyor Registration No. 463

~~Office of~~ Forest County ~~of~~ Wisconsin,

I hereby certify that the within instrument was ~~filed in this~~ filed in this office for record on the 12th day of January 1965, and was ~~filed in Book No.~~ signed and sworn to of ~~County Records~~ before me.

Surveyor's Seal

Signature Anna Peterson Title Notary Public

43513361000

Index No. 125