

CERTIFIED LAND CORNER RESTORATION

State of Wisconsin }
County of Forest } ss.

I Jean F. Resvick, do hereby certify that on the 22 day of September, 1978, I found evidence of the Northeast Section corner of Section 9 Township 35 North Range 14 East, Fourth Principal Meridian, as described hereon; and that from this evidence I established a new monument and accessories as described hereon to perpetuate the original location of this corner.

Description of original monument and accessories and subsequent restorations:
Surveyed in 1857 by James McBride
80 chains north between Sections 9 & 10, set post
Hemlock 12, N8W, 55 lks.
Sugar 14, N47E, 21 lks.
Birch 12, S31E, 44 lks.
Sugar 18, S19W, 50 lks.
19.1 chains east enter swamp bears N and S
25.1 chains east, stream 100 lks. runs north


Description of corner evidence found:

Iron pipe in mound of rock near fence corner
Old fence north and east.
From fence corner, Hemlock stump N8W, 55 lks.
Sugar stump N47E, 21 lks.
Birch stump S31E, 44 lks.
Sugar stump S19E, 50 lks.

These stumps are in the last stages of decay. Root pattern of each stump found along with wood solid enough to identify species.

Description of monument and accessories I established to perpetuate the location of this corner:

Set 2. inch inside diameter, galvanized iron pipe, 3 feet long, filled with concrete with brass cap stamped T35N, R14E, S4, S3, S9, S10, 1978, S-802.
Blazed and scribed the following new bearing trees:
Maple 9, N79E, 9.98 feet
Maple 6, S29E, 9.48 feet
Maple 5, S54W, 4.81 feet
Ash 9, N5W, 38.01 feet
Set steel sign post north side of monument.

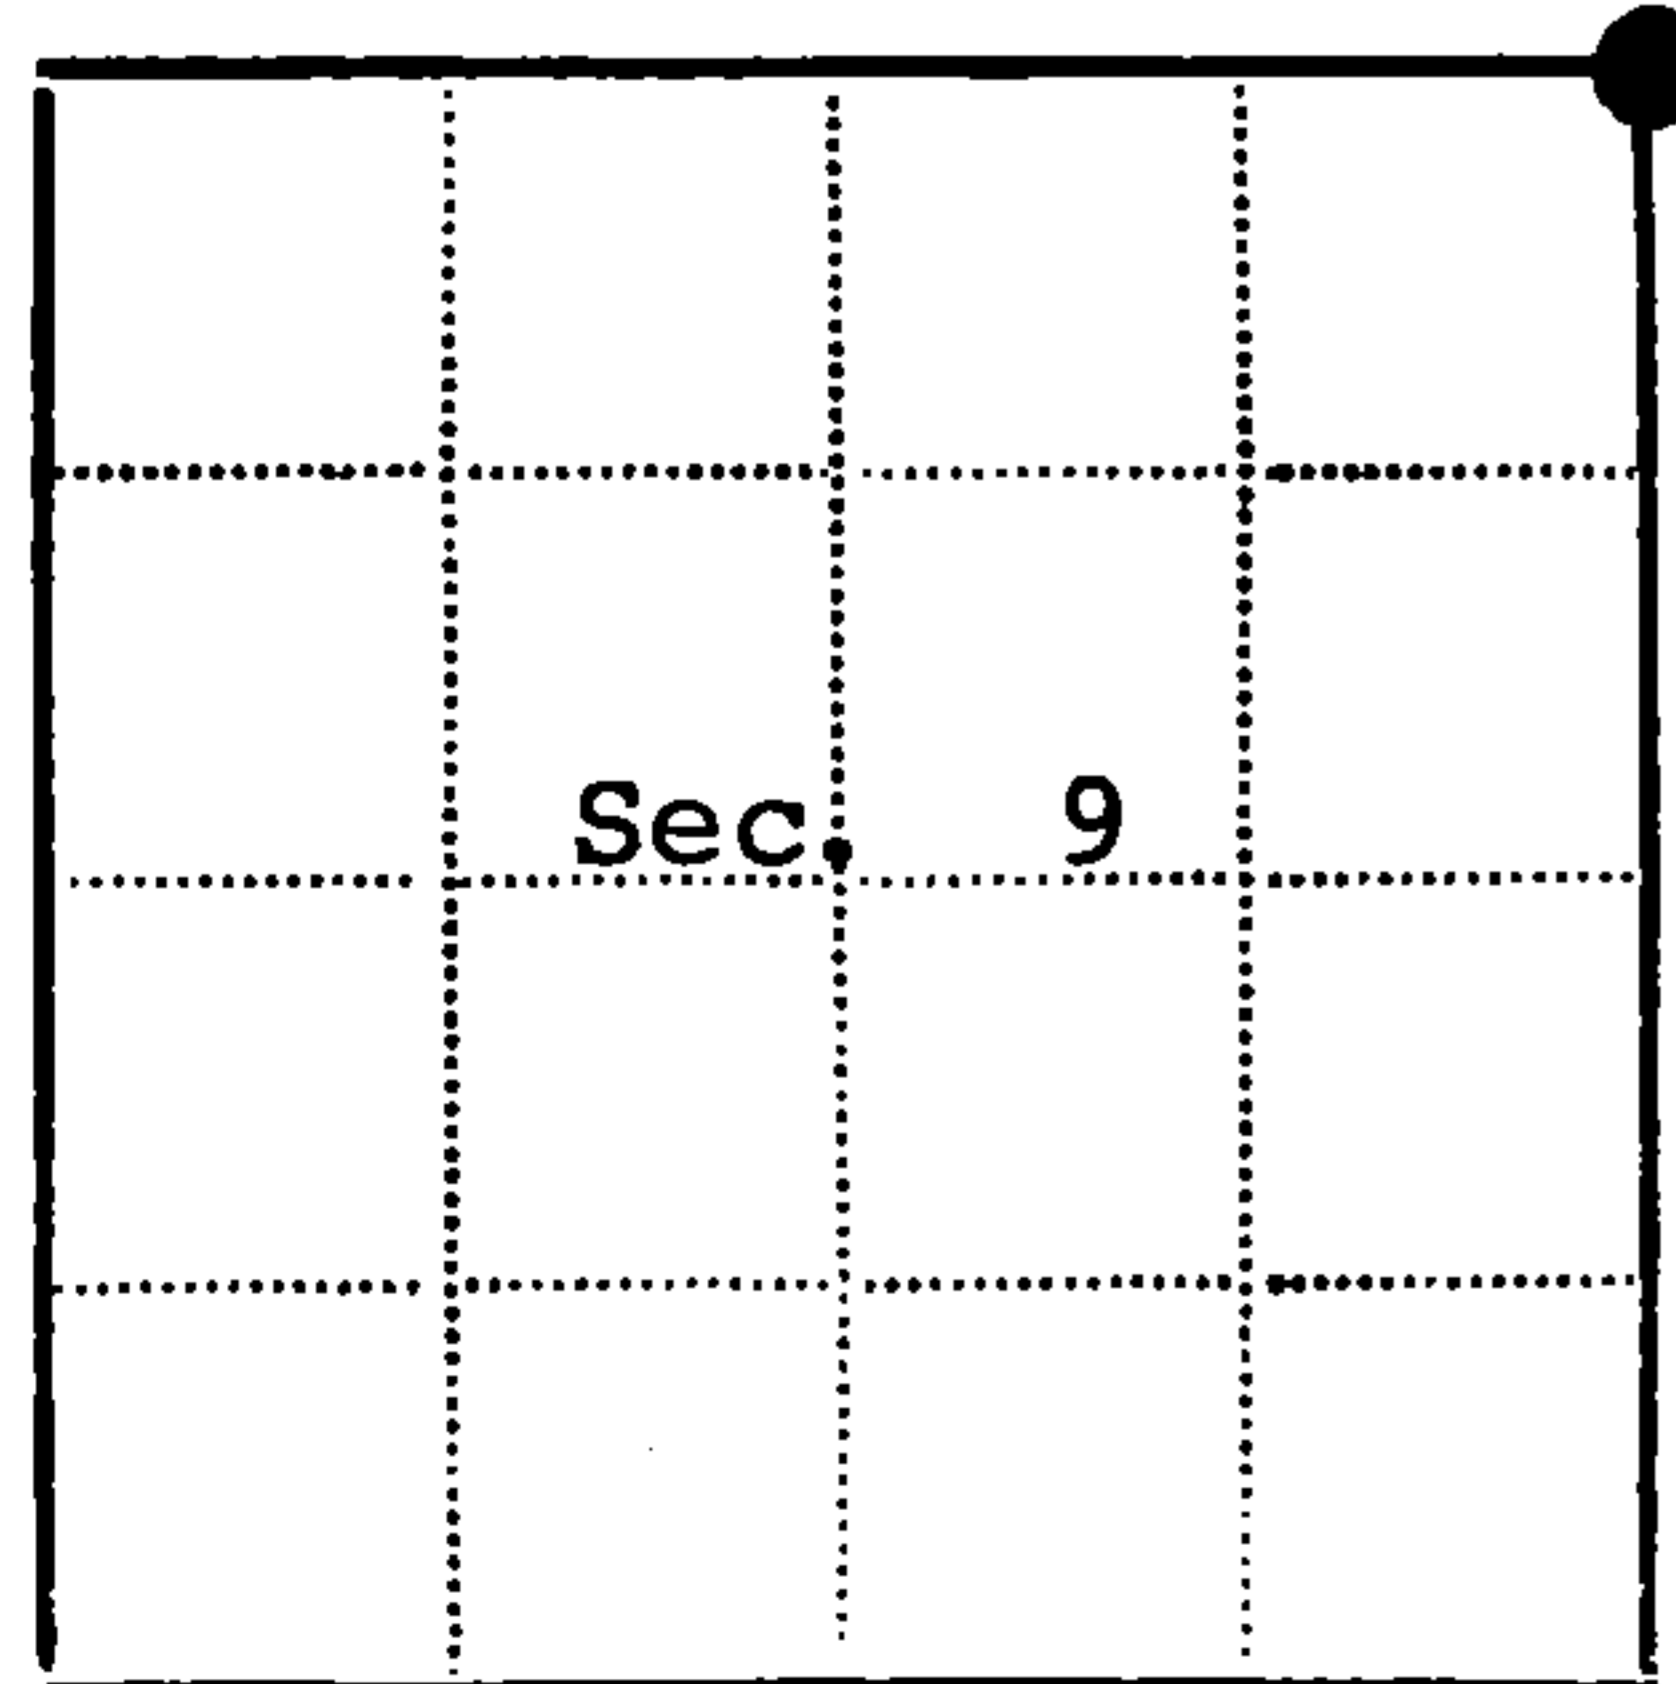

● - Corner monument restored
□ -

Resident witnesses.....

Dated at Rhinelander Wisconsin day of November 1978.

Signature *Jean F. Resvick* Title Land Surveyor
(County Surveyor, Registered Land Surveyor, or other duly authorized official)

Surveyors Registration No. S-802 DOCUMENT NUMBER

115176

Office of Register of Deeds County of Forest

I hereby certify that the within instrument was filed in this office for record on the 27th day of November 1978, and was filed in Book No. Page No. of County Records.

Signature *Eugene J. Staty* Title Register of Deeds

Township 35 North Range 14 East Section 9 Index No. E-13 Page No.

E 13