

CERTIFIED LAND CORNER RESTORATION

Index No. **N 6-7**

State of Wisconsin }
County of Forest } ss.

I Jean F. Resvick, do hereby certify that on the 7th day of August, 19 63, I found evidence of the East Meander corner of Sections 17 and 20 Township 35, North, Range 14 East, Fourth Principal Meridian, as described hereon; and that from this evidence I established a new monument and accessories as described hereon to perpetuate the original location of this corner.

Resident witnesses:


History of original corner establishment:
Surveyed in 1859 by James McBride
45.00 chains west between Sections 17 and 20
Set meander corner post
W. Pine 14", S56°E, 42 Lks.
Y. Pine 15", N52°E, 53 Lks.
5.10 chains east to quarter corner between Sections 17 and 20

Description of corner evidence found:
Iron bar, 2-feet long, 3/4 inch diameter on lakeshore.
Y. Pine stump 19-inches diameter with scribing, N52°E, 34.98 feet from iron bar.
W. Pine stump nearly gone, S56°E, 27.70 feet from bar.

Description of monument and accessories I established to perpetuate the original location of this corner.
Replaced iron bar with 6-inch diameter concrete monument, 4-feet long, flush with ground to prevent ice from pushing monument over. With brass cap marked:

from which the following blazed and scribed new bearing trees bear:
Place iron bar alongside of monument
N. Pine 3", N11°E, 34.15 ft. (51.7 Lks)
N. Pine 3", S43°E, 7.90 ft. (1.20 Lks)

FORM 985 H. C. MILLER CO., MILWAUKEE

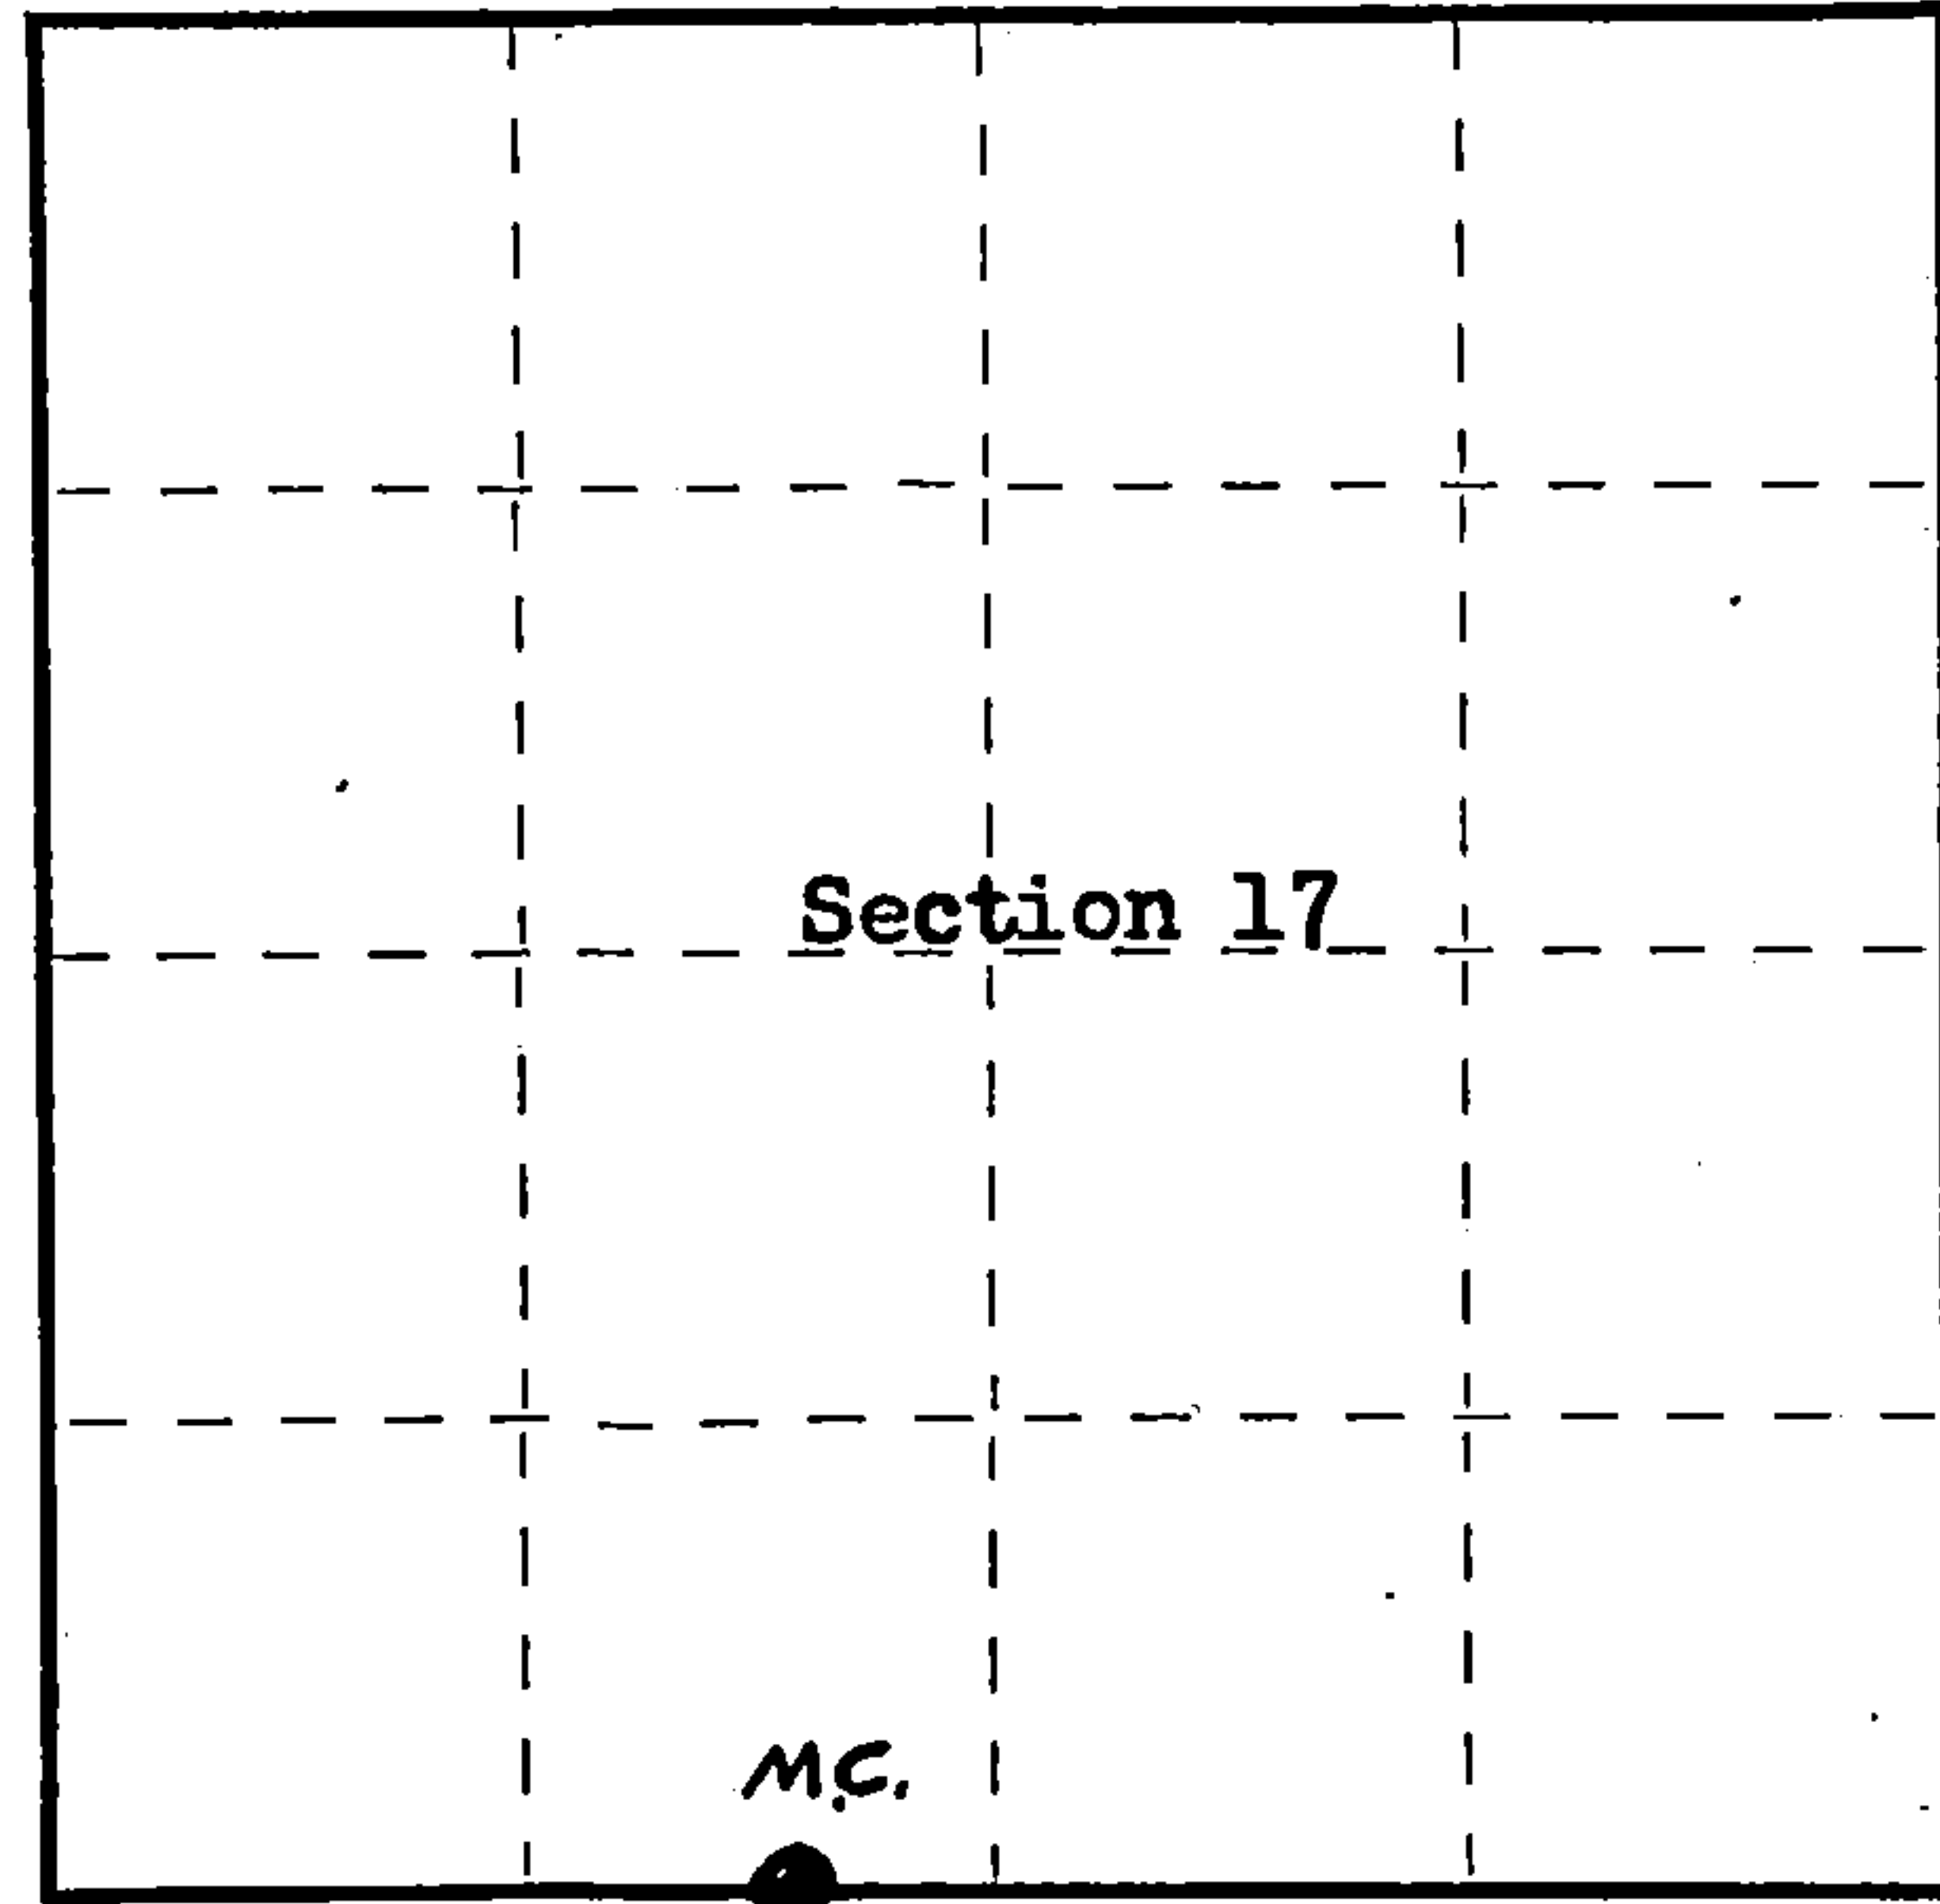

T35N R14E
MC / S17
 / S20
 1963
 S-802

89301

Dated at Rhineland, Wis., this 20th day of March, 19 64

Signature Jean F. Resvick Title Cadastral Surveyor Registration No. S-802
(County Surveyor, Registered Land Surveyor, or other duly authorized official)

Office of Register of Deeds, County of Forest, I hereby certify that the within instrument was filed in this office for record on the 21st day of Oct., 19 64 at 11 o'clock A. M. Doc. #89301 Vol. 1 Page N+16 + ~~Index~~ LAND CORNER RESTORATIONS

Anna Peterson
(Register of Deeds)

By _____ Deputy

○ = Corner monument restored.

43514170024