

CERTIFIED LAND CORNER RESTORATION

177 R15
Index No.
R15

State of Wisconsin }
County of Forest } ss.

I, Jean F. Resvick, do hereby certify that on the 35th day of October, 1962, I found evidence of the quarter corner of Sections 22 & 27 Township 35, North, Range 14 East, Fourth Principal Meridian, as described hereon; and that from this evidence I established a new monument and accessories as described hereon to perpetuate the original location of this corner.


Resident witnesses:

.....
.....
.....

History of original corner establishment:
Surveyed in 1859 by James McBride
Set wood post
Tamarack 10" S20°E, 74 lks.
Tamarack 10" N87°E, 415 lks.

Description of corner evidence found:
1. 2" galvanized iron pipe, with brass cap marked 1/4, S22, S27, 1961
set by Robert Kolbe of Conner Lumber Company
2. 1" galvanized iron pipe and 2 squared stakes by monument
3. Tamarack stump, 13" diam. S20°E, 48.8 ft. scribe showing

Description of monument and accessories I established to perpetuate the original location of this corner.
Blazed and scribed the following new bearing trees:
Tamarack 4", S78° E, 44.0 ft.
Tamarack 4", S30° W, 18.58 ft.

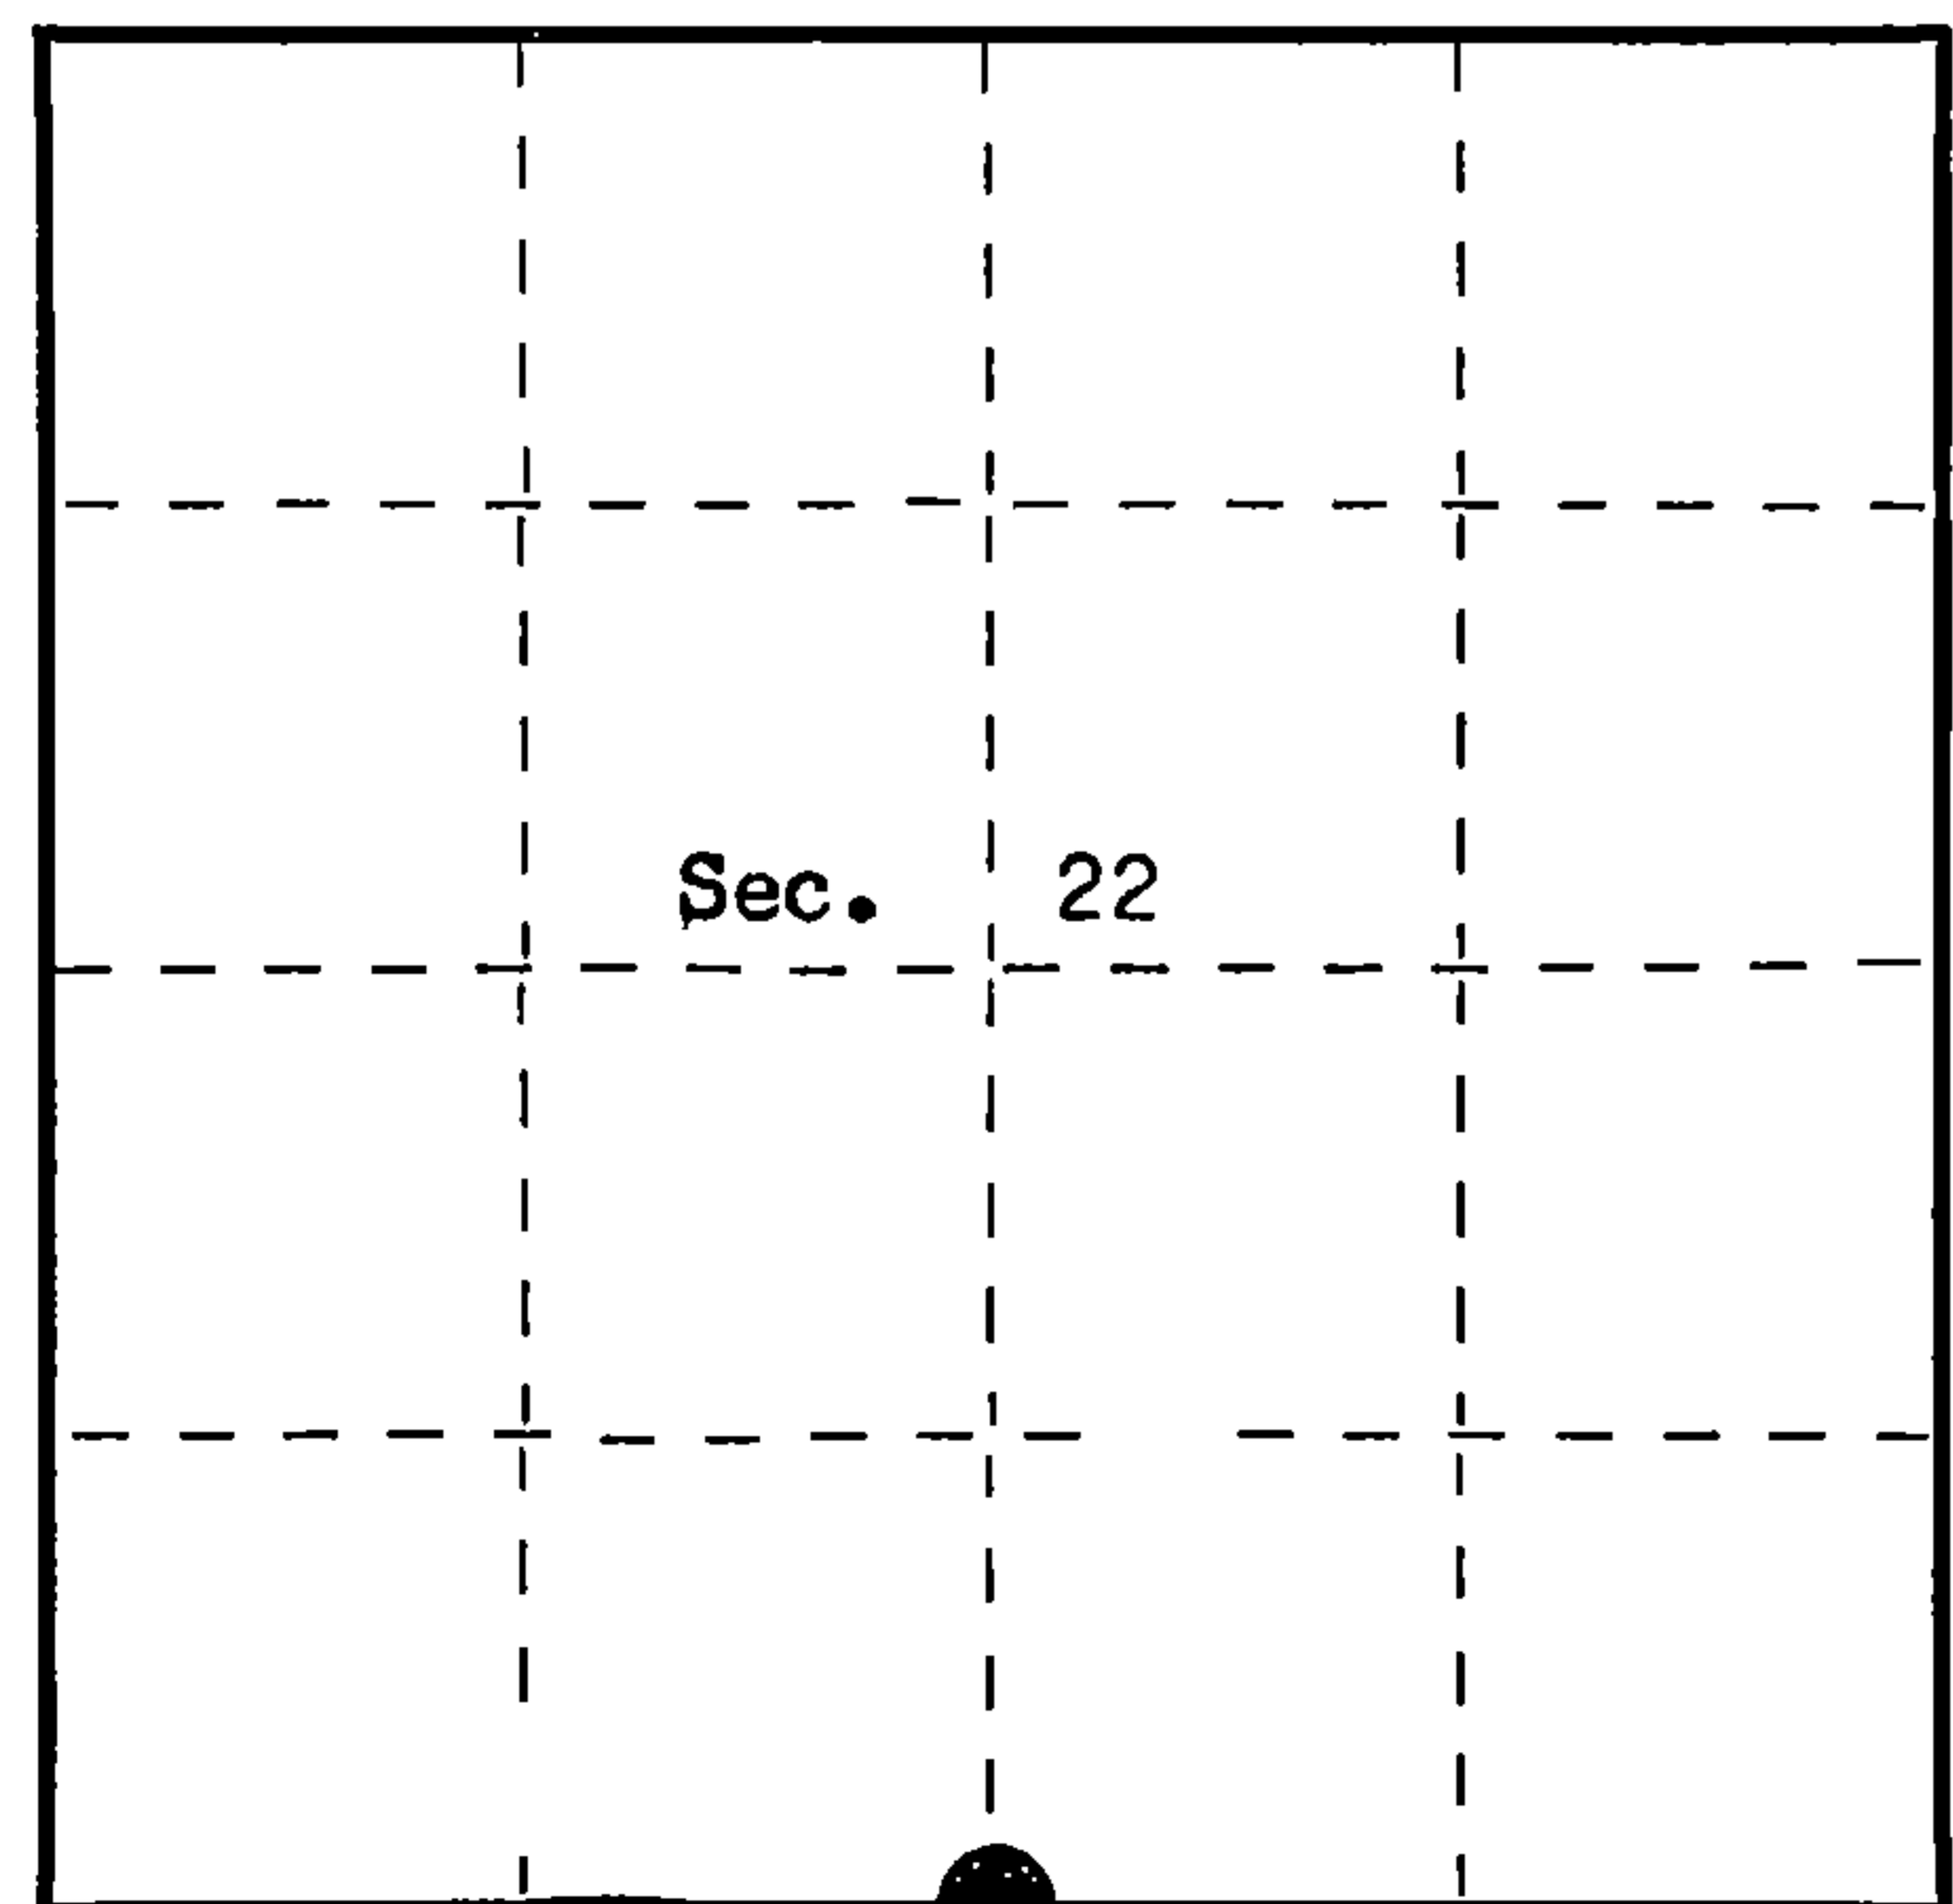

○ = Corner monument restored.



Dated at Rhinelander, Wis., this _____ day of _____
Signature: *Jean F. Resvick* Cadastral Surveyor - U. S. Government
Victor H. Hedman Title: Cadastral Surveyor Registration No. S-185*
(County Surveyor, Registered Land Surveyor, or other duly authorized official) *Reviewed and Approved

Office of Register of Deeds, County of Forest, I hereby certify that the within instrument was filed in this office for record on the 4 day of November, 1963 at 9:00 o'clock A. M.

Anna Peterson
.....
(Register of Deeds)

By _____ Deputy

87828

FORM 985 H. C. MILLER CO., MILWAUKEE

4351422 0020