


U. S. PUBLIC LAND SURVEY MONUMENT RECORD.

INSTRUCTIONS: This record shall show the location of the corner and shall include all of the following nine elements (a through i).

- (a) Identify the corner by reference to the U.S. public land survey system.
○ = Corner monument restored.

1/4 CORNER TO SECTIONS 5 AND 32, TOWNSHIP 34 AND 35 N., R. 14 E.

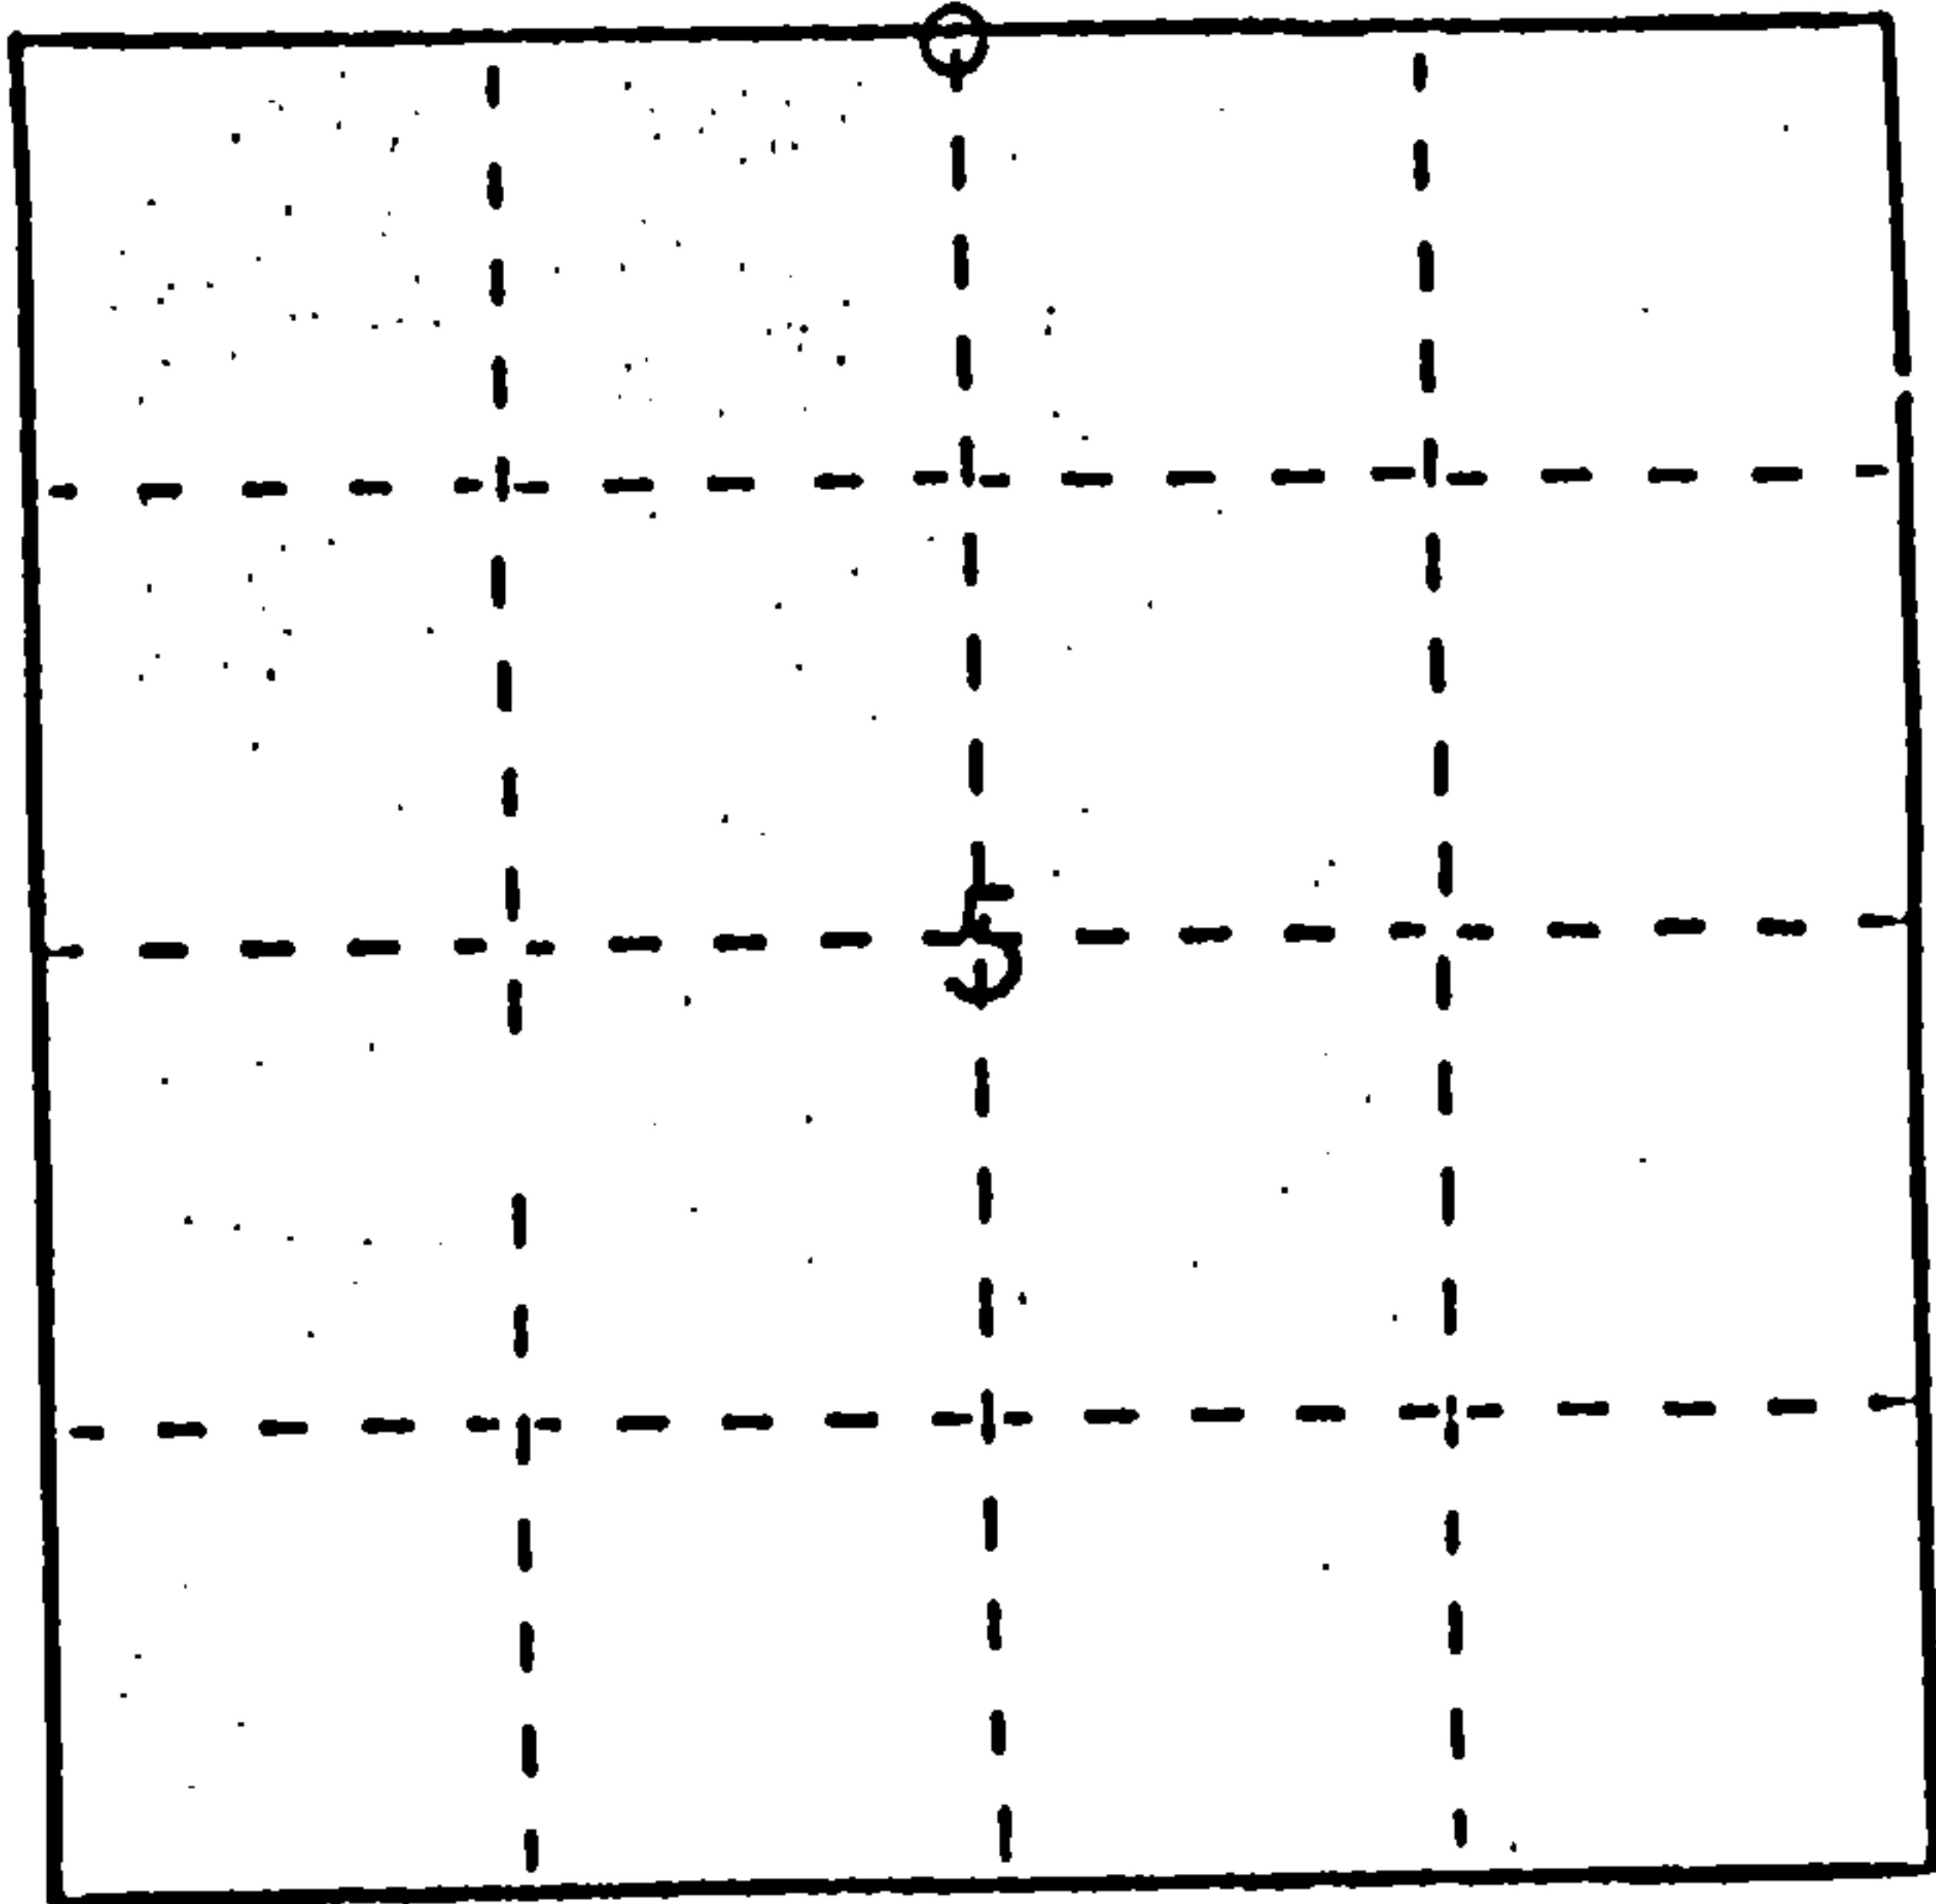

(b) Describe any record evidence, monument evidence, occupational evidence, testimonial evidence or any other material evidence you considered, and whether the monument was found or placed.


- 1857 MILLARD, SURVEY TOWNSHIP LINE
- 1859 JAMES McBRIDE, SURVEY OF SECTION 5
- 1946 GOV'T. LAND OFFICE, REMAINS OF ORIGINAL B.T. FOUND, SET CONCRETE MONUMENT WITH BRASS CAP TO IDENTIFY CORNER, NEW B.T.s TAMARACK 4" S.22° E. 164 LKS., DEAD CEDAR 7" N.63° W. 8 LKS.
- 1963 RESVICK R.L.S. NO. S-802, NEW B.T., ASPEN 10" N.33° W. 45.50FT.
- 1982 FISHER R.L.S. NO. S-836, SUBDIVISION OF SECTION 5, FOUND MONUMENT, RESVICK B.T., NOTED THE FOLLOWING B.T.s TAMARACK 4" S.22° E. 10.20FT., CEDAR (DEAD) 7" N.63° W. 5.90FT., SET STEEL SIGN POST 1 FT. EAST OF CORNER
- 1989 DOBBRATZ R.L.S. NO. S-973, FOUND MONUMENT, STEEL SIGN POST AND 2 B.T.s AS NOTED BY FISHER IN 1982.

(c) In the plan view drawing below, provide reference ties to at least 4 witness monuments, or, if the location is within a municipality, to at least 2 witness monuments. (Witness monuments shall be made of concrete, natural stone, iron or other equally durable material.) Describe witness monuments.

(d) Show a plan view drawing depicting the relevant monuments and reference ties which is sufficient in detail to enable accurate relocation of the corner monument if the corner monument is disturbed. Indicate north.

- B.T.s
- ① ASPEN 10" N.33° W. 45.32FT. (EXISTING)
 - ④ TAMARACK 4" S.22° E. 108.2FT. (EXISTING)
 - ⑤ ASPEN 7" S.82° W. 62.35FT. (NEW)

- WITNESS MONUMENT
- ② FOUND CONCRETE MONUMENT WITH BRASS CAP AT CORNER
 - ③ FOUND STEEL SIGN POST 0.35FT. EAST OF CORNER.

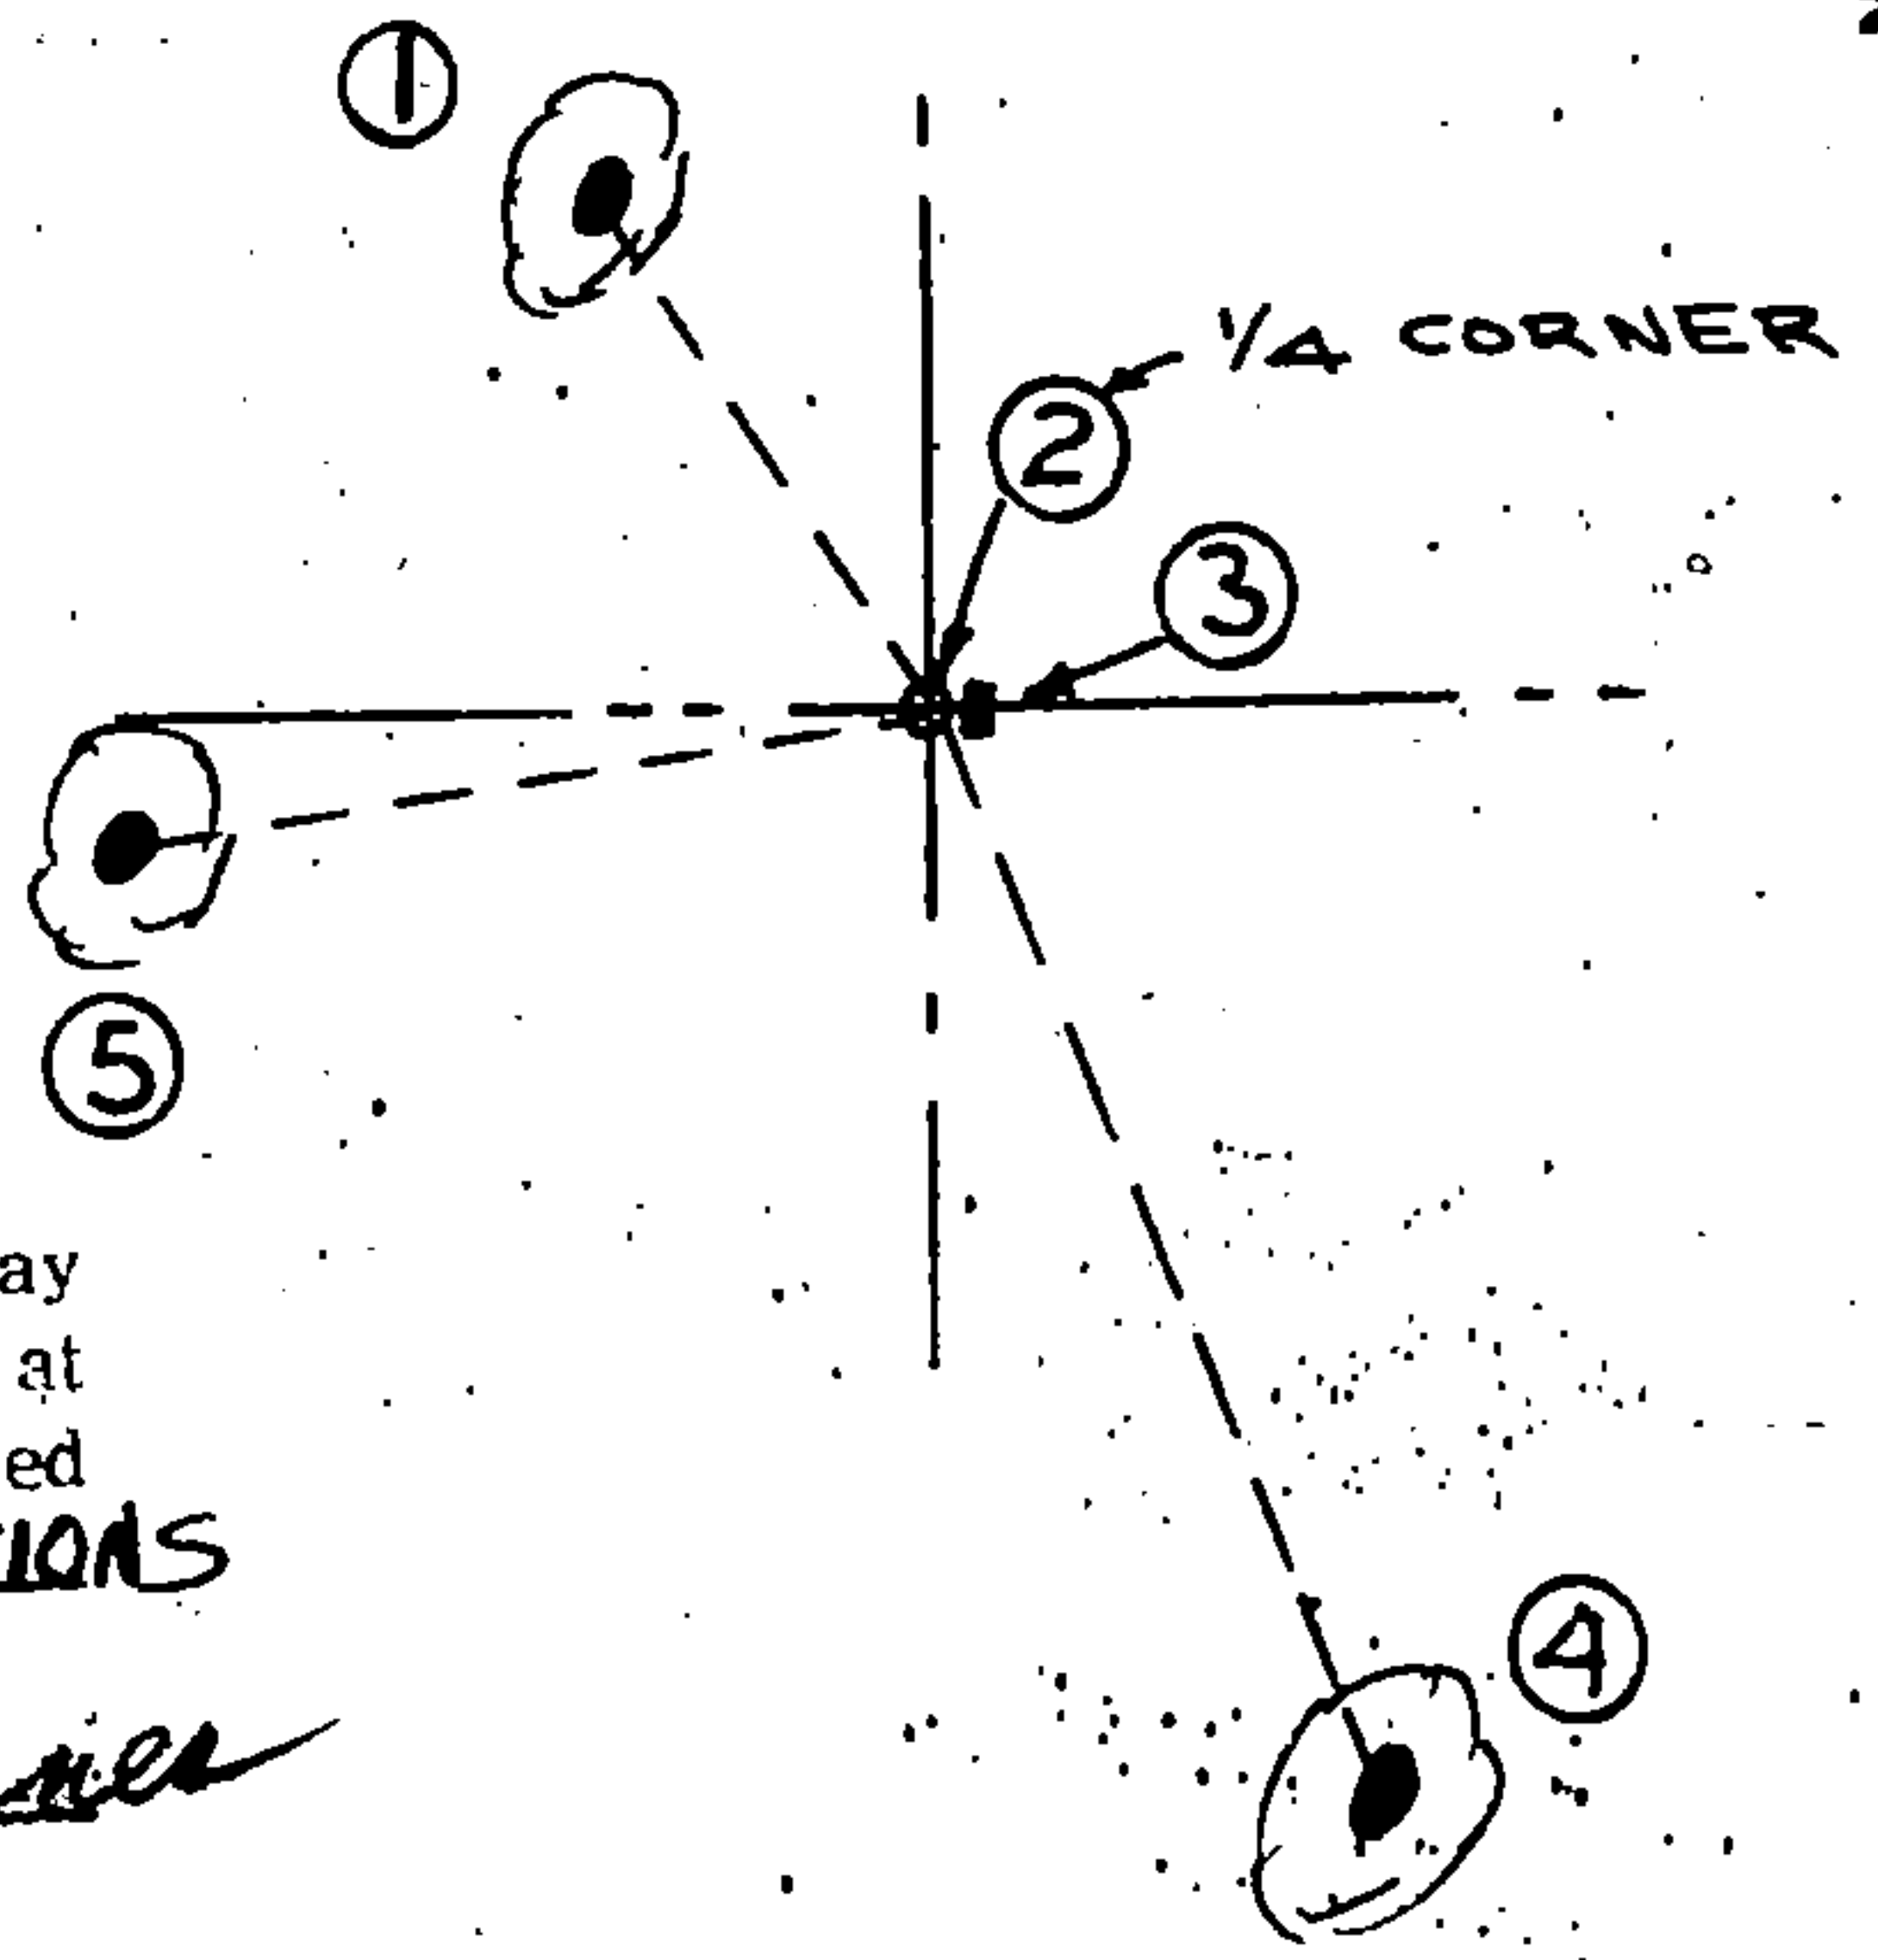

REGISTER'S OFFICE
Forest County, Wis.

Received for record this 26th day of February A.D. 1990 at 10:10 o'clock A.M. and recorded in Vol. CORNER RESTORATIONS page A-7

Paul Schlenker
Register of Deeds

NOT TO SCALE

A 7

(e) Describe any material discrepancy between the location of the corner as restored or reestablished and the location of that corner as previously restored or reestablished by distance and direction. Show the discrepancy on the plan view drawing under (d), above. Show the distances between the corner as previously restored or reestablished and (1) the corner as restored or reestablished, and (2) to at least 2 of the witness monuments shown on the drawing in (d), above.

NONE

(f) Was the corner restored through acceptance of (1) an obliterated evidence location, or, (2) a found perpetuated location?

(2) FOUND PERPETUATED CORNER

(g&h) Was the corner reestablished through lost corner proportionate methods? If so, show the method, including the directions and distances to other public land survey corners used as evidence or used for proportioning in determining the corner location?

WAYNE G. DOBBRATZ

(1) I, Wayne G. Dobbratz (type or print name) certify that the corner location shown on this record was determined by me or under my direction and control and that this U.S. Public Land Survey Monument Record is correct and complete to the best of my knowledge and belief.

Signature

10/20/89

Date

CERTIFICATE READY FOR FILING:

Doris Staege
District Ranger

