

CERTIFIED LAND CORNER ~~RESTORATION~~ LOCATION RESTORATION

State of Wisconsin }
County of Forest } ss.

I Jean F. Resvick, do hereby certify that on the 4 day of May, 1977, I found evidence of the located the North one sixteenth corner ~~at~~ between Sections 13 and 18 Township 35 North, Ranges 15 and 16 East, Fourth Principal Meridian, as described hereon; and that ~~from this evidence~~ I established a ~~new~~ monument and accessories as described hereon to perpetuate the ~~original~~ location of this corner:

Description of original monument and accessories and subsequent restorations:

None

Description of corner evidence found:

Location of corner set on line and at midpoint between section corner and quarter corner.

Section corner bears N0°17'W, 1315.94 feet

Quarter corner bears S0°17'E, 1315.94 feet

Iron pipe found bears east 4.4 feet

Description of monument and accessories I established to perpetuate the location of this corner:



At the corner position set a 2 inch inside diameter, galvanized iron pipe, 5 feet long, filled with concrete, with brass cap stamped:

T35N, R15E, N 1/16, R16E, S13, S18, 1977; S-802

from which the following new blazed and scribed new bearing trees bear

Hemlock 18, N65E, 97.36 feet

Set steel sign post 0.30 ft. NW of monument

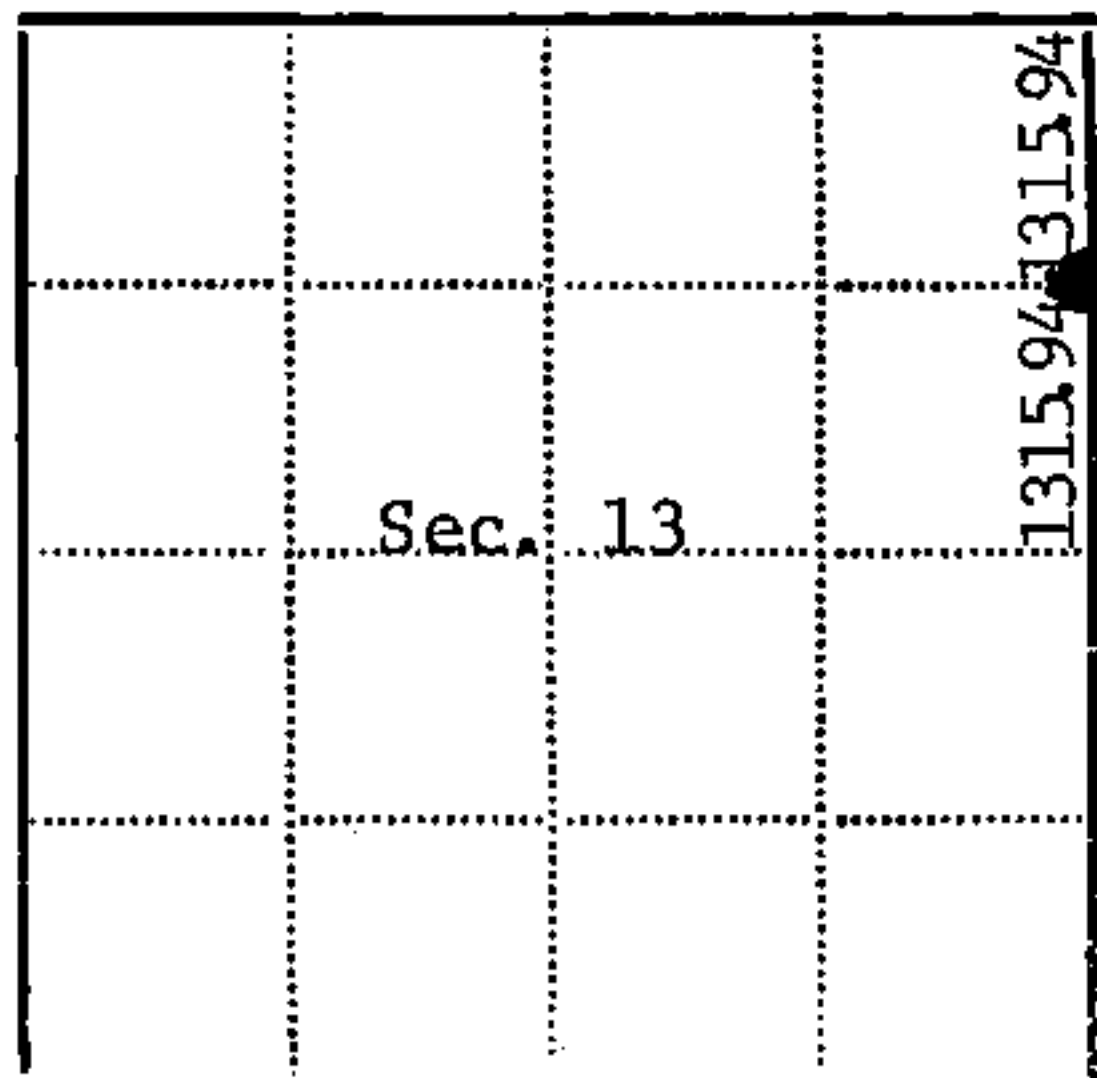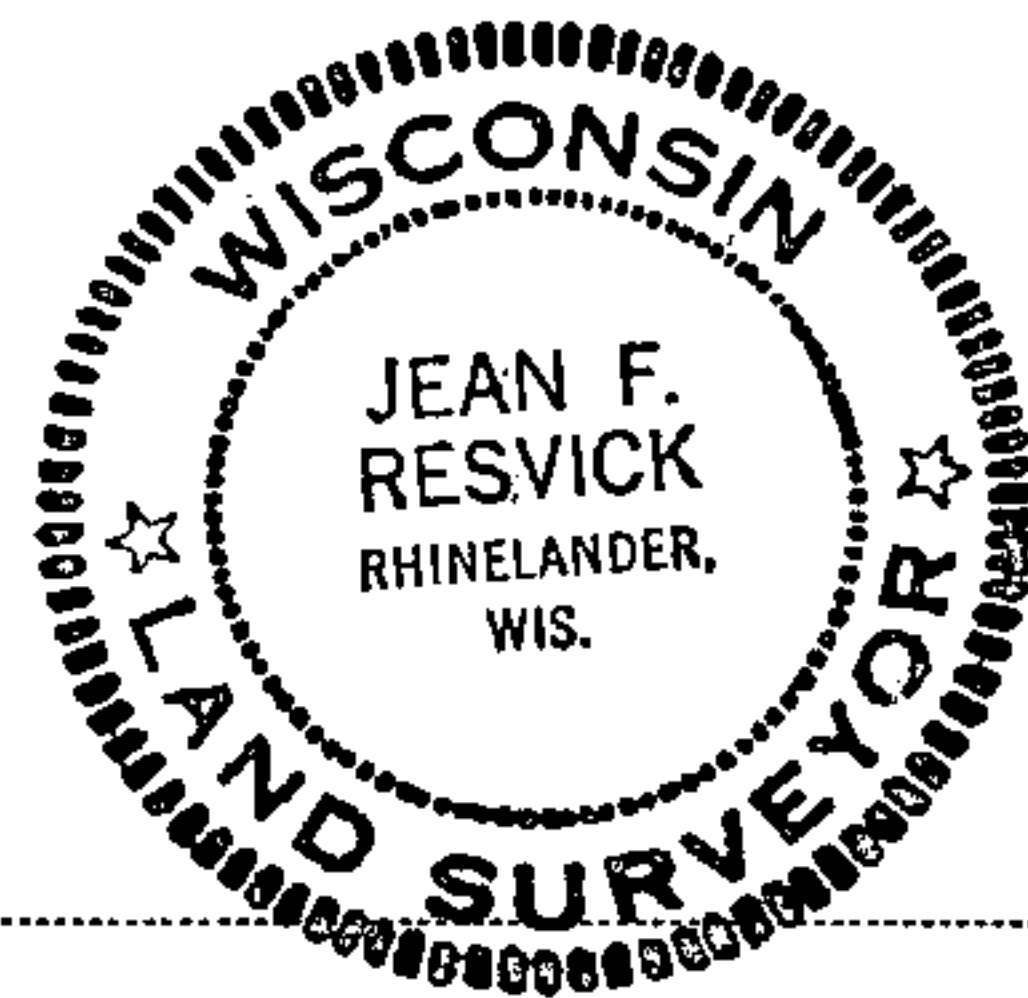

- - Corner monument restored
- -

Resident witnesses.....

Dated at Rhinelander, Wisconsin, this 26 day of September 19 77.

Signature *Jean F. Resvick* Title Land Surveyor
(County Surveyor, Registered Land Surveyor, or other duly authorized official)

Surveyors Registration No. S-802 DOCUMENT NUMBER 113292

Office of Register of Deeds County of Forest

I hereby certify that the within instrument was filed in this office for record on the 13th day of February 19 78, and was filed in Book No. Page No. of County Records.

Signature *Eugene Stutzman* Title Register of Deeds

Township 35 North, Range 15 East, Section 13, Index No. K-25, Page No.

K 25