


U. S. PUBLIC LAND SURVEY MONUMENT RECORD

INSTRUCTIONS: This record shall show the location of the corner and shall include all of the following nine elements (a through i).

(a) Identify the corner by reference to the U.S. public land survey system.

○ = Corner monument restored.

Section Corner to Sections 14-15-22-23, T.35N., R.15E. Forest County, Wisconsin.

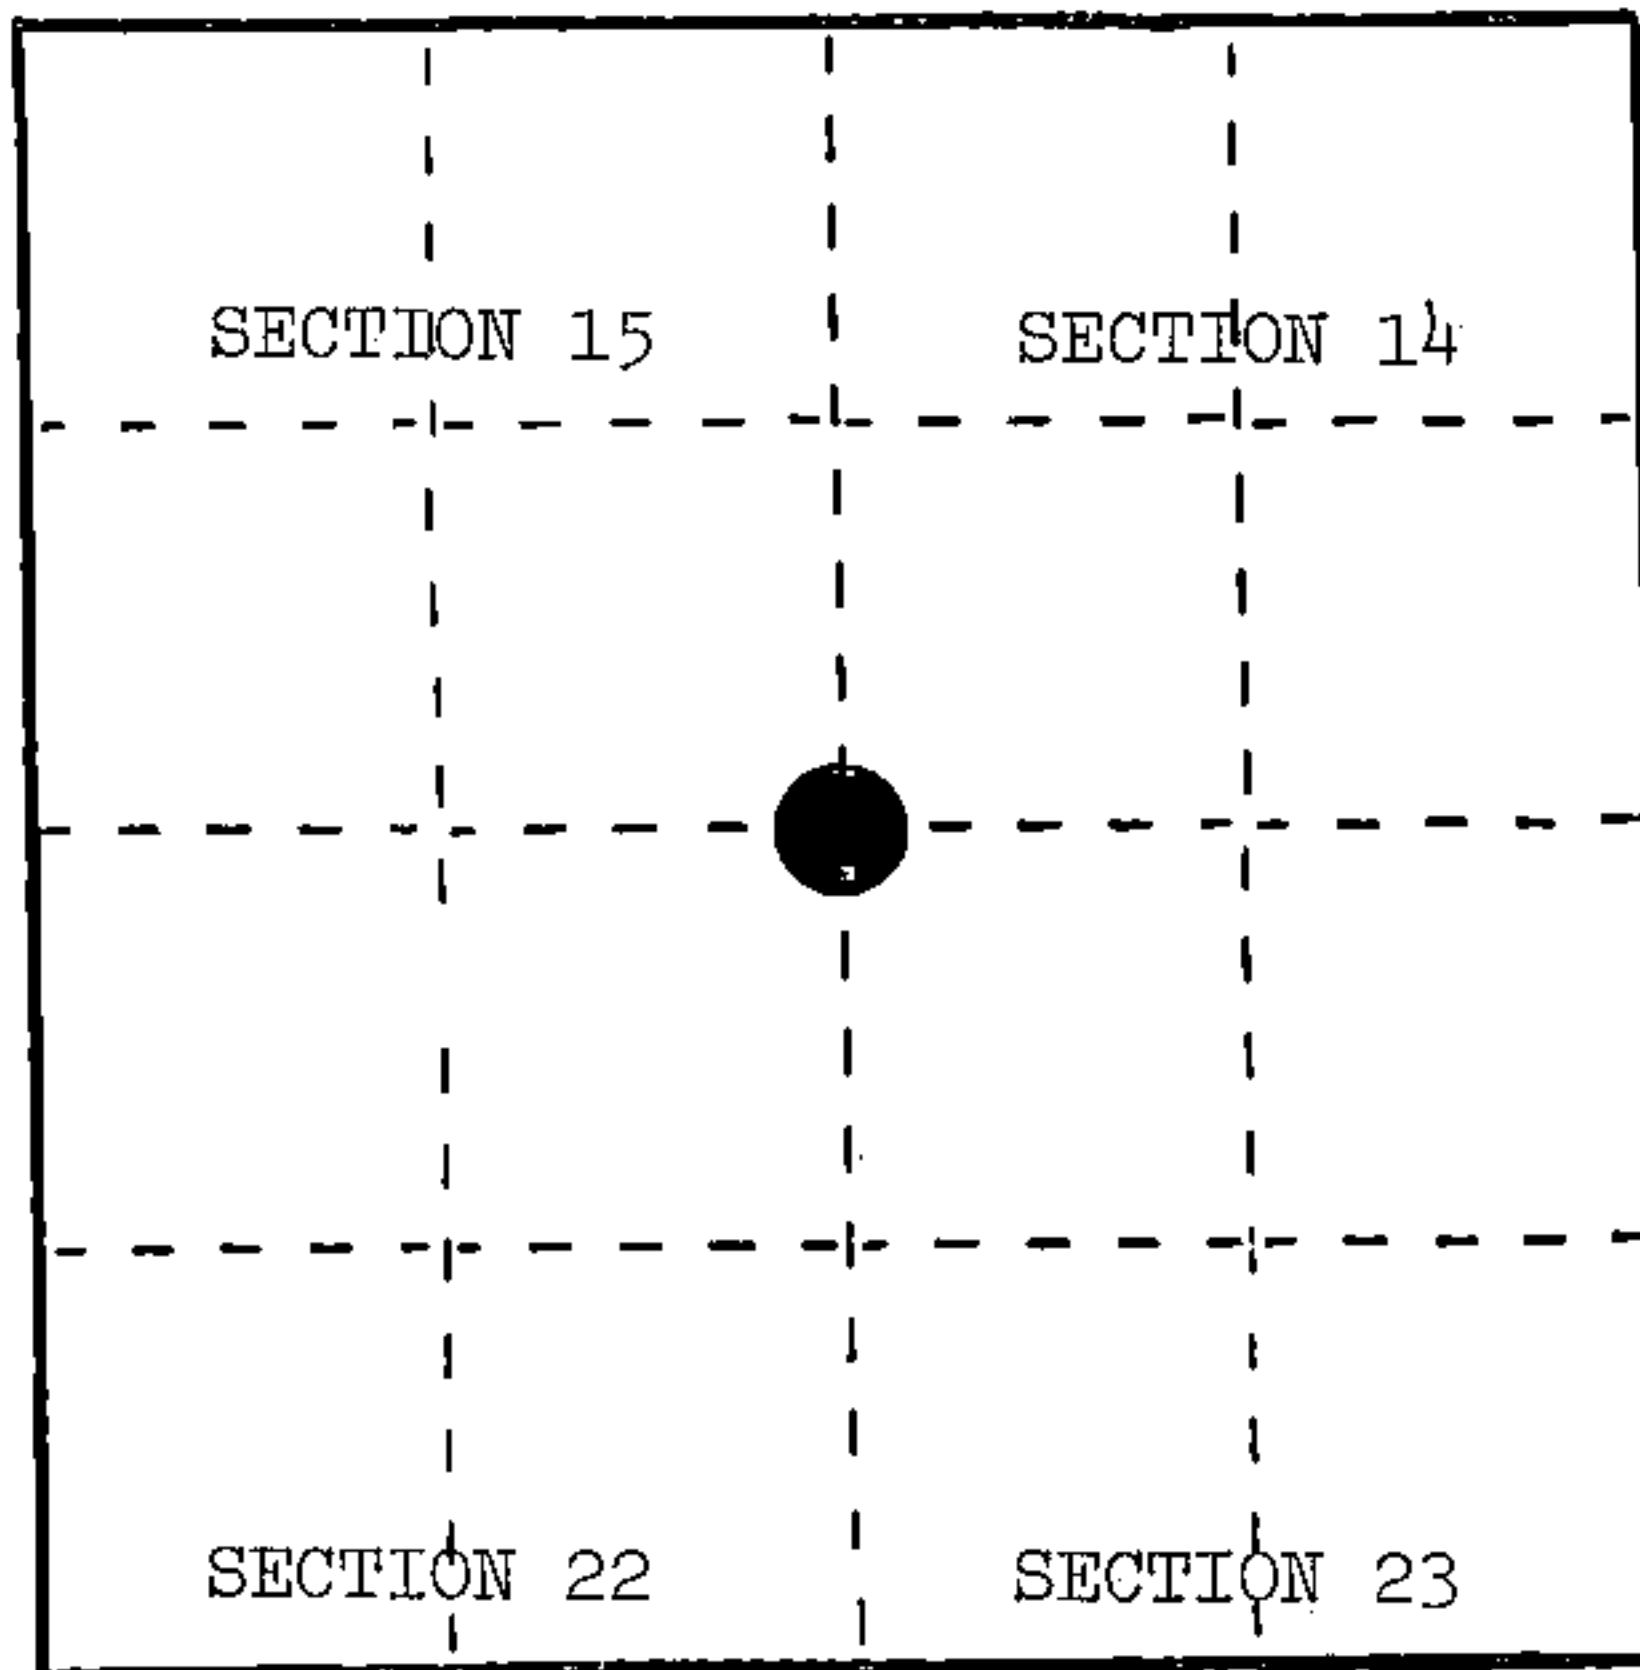


(b) Describe any record evidence, monument evidence, occupational evidence, testimonial evidence or any other material evidence you considered, and whether the monument was found or placed.

In 1859, James McBride set a wood post with the following BTs: Birch, 10", N.82°W., 5 links; Sugar, 14", N.28°E., 38 links; Sugar, 12", S.64°E., 50 links; Hemlock, 10", S.28°W., 40 links. In 1905, N. H. Smith was at corner and set an Elm post with no new BTs. In 1909, J. J. Melendy found an Elm post and remains of original BTs. He placed a mound of rock around Elm post. In 1982, R. Widmar, a BLM surveyor found a 2½" iron pipe set in a mound of stone with no original evidence. He found the following local BTs: Maple, 15", S.78°E., 14 links; Maple, 7", S.88°W., 27 links; Maple, 11", N.2°W., 19½ links. He replaced iron pipe with 2½" x 30" aluminum monument and set the following new BTs: Maple, 10", N.89°E., 54 links; Maple, 14", S.54°E., 57 links; Yellow Birch, 5", S.13°W., 37 links; Maple, 7", N.45°W., 56 links. In 1987, Alan Harrison found monument as set by Widmar and added BTs as shown in sketch.

(c) In the plan view drawing below, provide reference ties to at least 4 witness monuments, or, if the location is within a municipality, to at least 2 witness monuments. (Witness monuments shall be made of concrete, natural stone, iron or other equally durable material.) Describe witness monuments.

(d) Show a plan view drawing depicting the relevant monuments and reference ties which is sufficient in detail to enable accurate relocation of the corner monument if the corner monument is disturbed. Indicate north.

1. 2½" x 30" monument in a mound of stone, stamped to identify the corner.
2. Sugar, 8", N.85°E., 35.30 feet
3. Sugar, 11", S.44°E., 37.90 feet
4. Yellow Birch, 4", S.15°W., 24.42 feet
5. Sugar, 6", N.37°W., 36.78 feet
6. Steel Sign Post, North, 1.20 feet

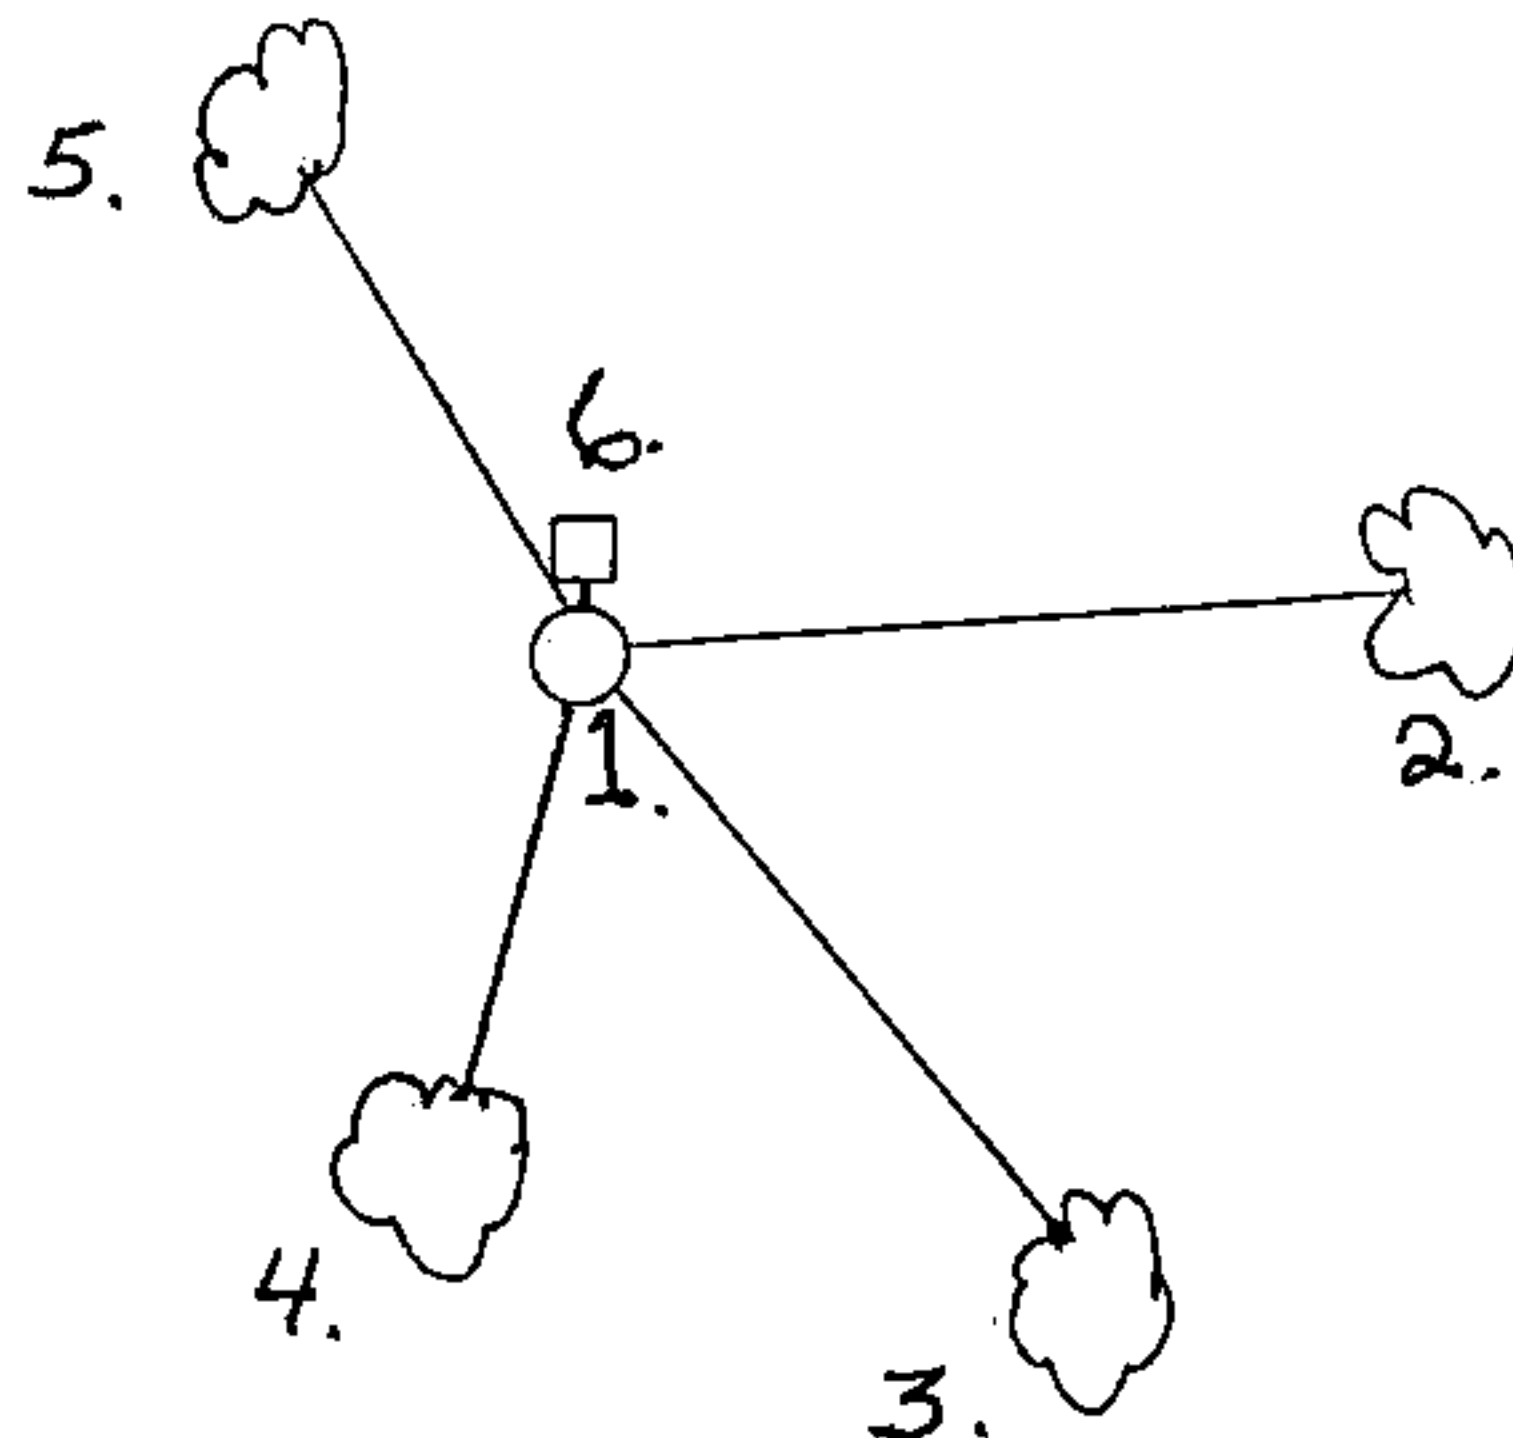

REGISTER'S OFFICE  
Forest County, Wis.

Received for record this 19<sup>th</sup> day  
of September A.D., 1990 at  
3:15 o'clock P.M. and recorded  
in Vol. CORNER RESTORATIONS  
page N-17

*Paul Ackerman*  
Register of Deeds

(e) Describe any material discrepancy between the location of the corner as restored or reestablished and the location of that corner as previously restored or reestablished by distance and direction. Show the discrepancy on the plan view drawing under (d), above. Show the distances between the corner as previously restored or reestablished and (1) the corner as restored or reestablished, and (2) to at least 2 of the witness monuments shown on the drawing in (d), above.

None.

(f) Was the corner restored through acceptance of (1) an obliterated evidence location, or, (2) a found perpetuated location?

(1) an obliterated evidence location.

(g&h) Was the corner reestablished through lost corner proportionate methods? If so, show the method, including the directions and distances to other public land survey corners used as evidence or used for proportioning in determining the corner location?

No.

(i) I, Alan D. Harrison  
(Type or print name) certify that the corner location shown on this record was determined by me or under my direction and control and that this U.S. Public Land Survey Monument Record is correct and complete to the best of my knowledge and belief.

Alan D. Harrison 3/28/88  
Signature Date

Certificate ready for filing:

Darrell E. Richards  
Act. District Ranger

