


U. S. PUBLIC LAND SURVEY MONUMENT RECORD

**INSTRUCTIONS:** This record shall show the location of the corner and shall include all of the following nine elements (a through i).

(a) Identify the corner by reference to the U.S. public land survey system.

● = Corner monument restored.

Section Corner to Sections 17, 18, 19 & 20; T35N, R15E, 4th P.M.

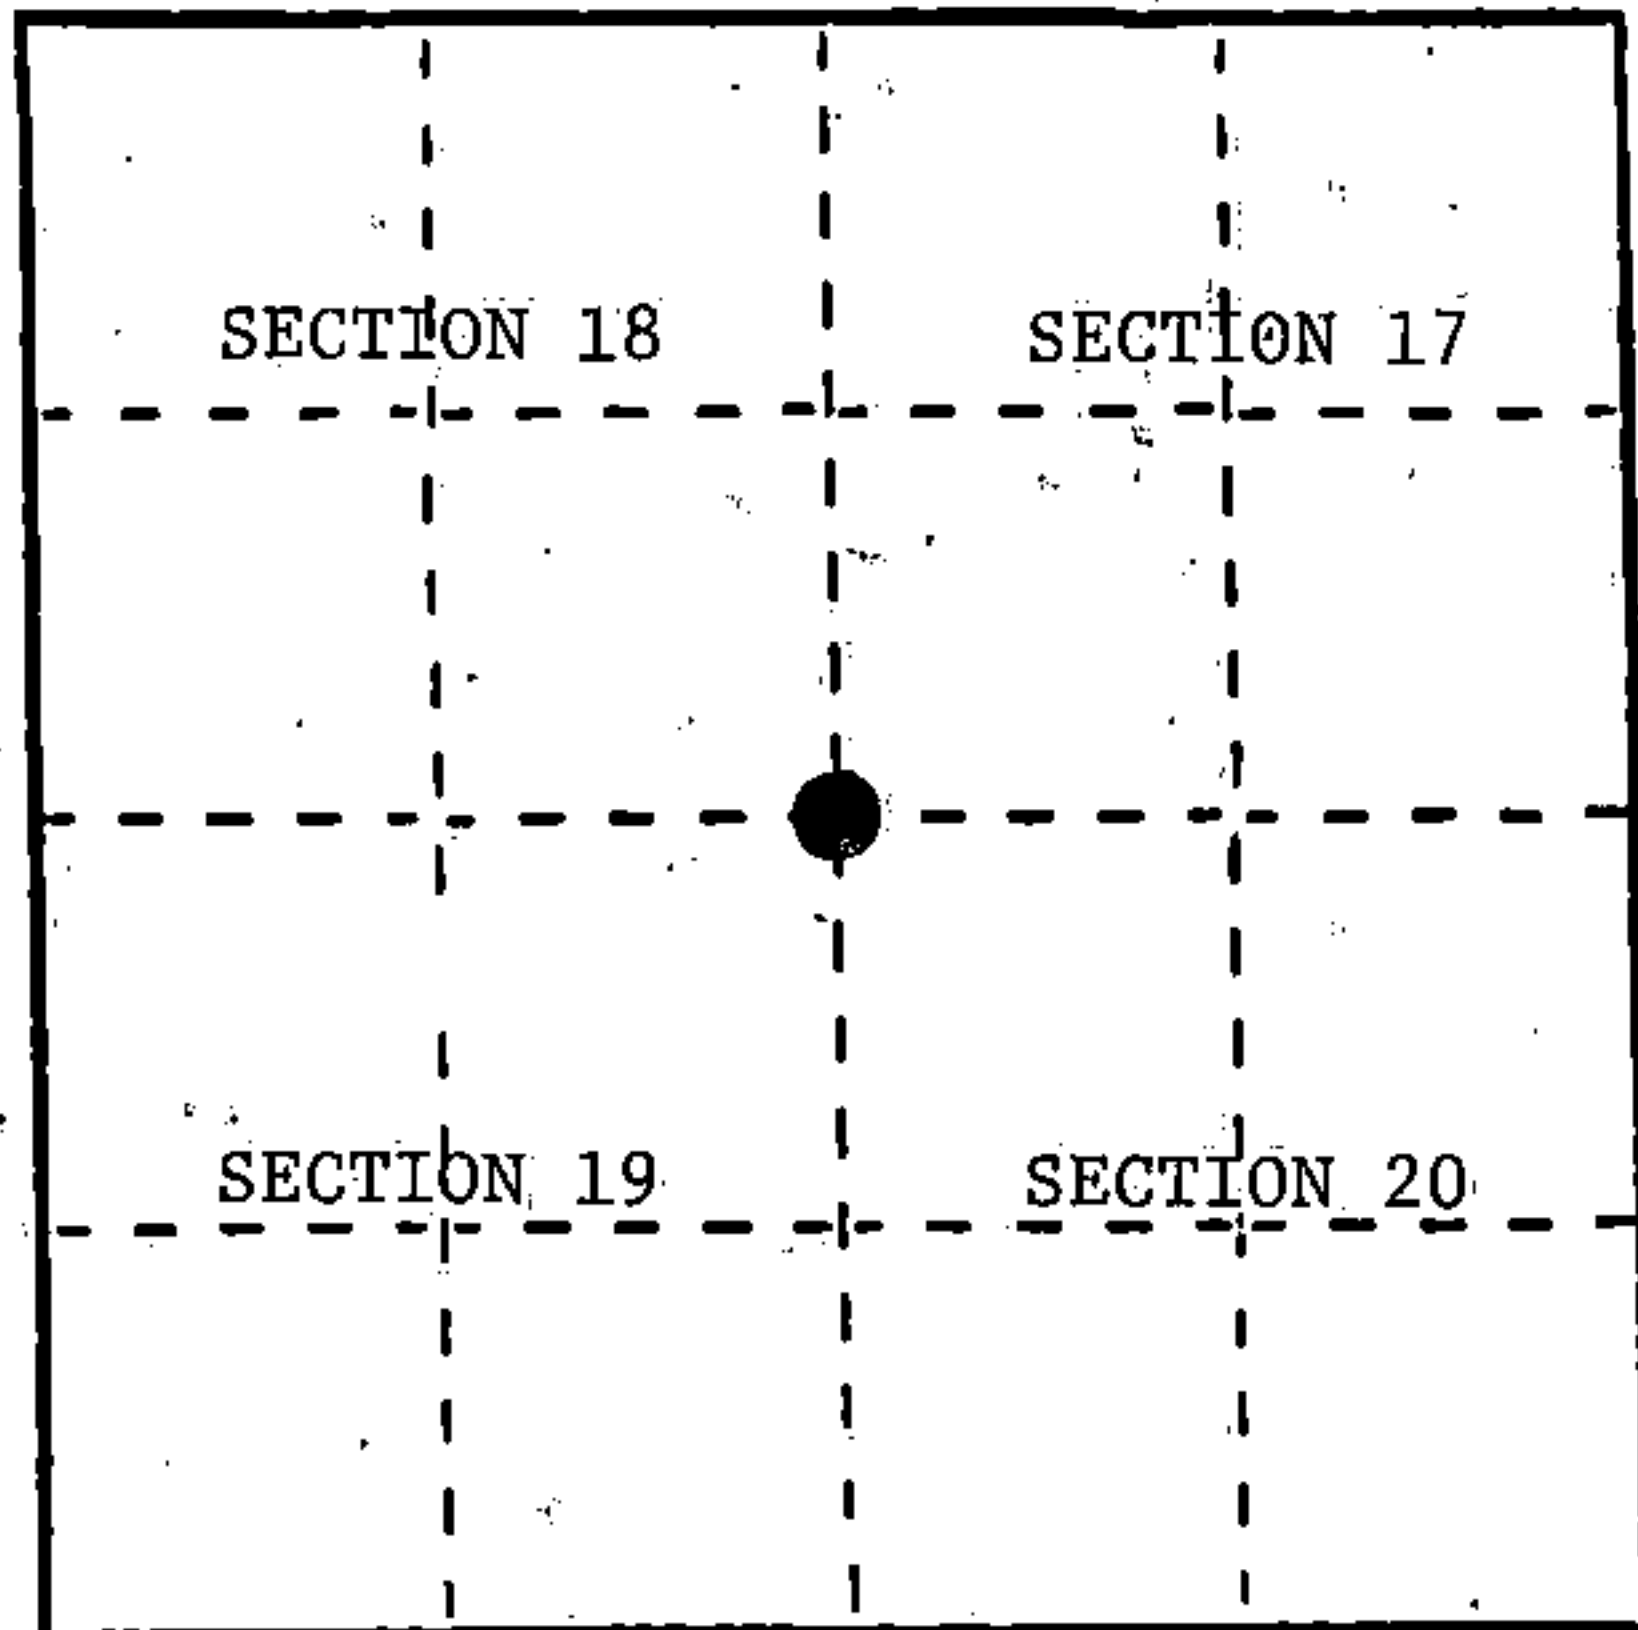

REGISTER'S OFFICE  
Forest County, Wis.

Received for record this 6<sup>th</sup> day  
of Sept A.D., 1989 at  
10:25 o'clock A.M. and recorded  
in Vol. CORNER RESTORATIONS  
page N-5

*Paul Heckenbrenner*  
Register of Deeds

(b) Describe any record evidence, monument evidence, occupational evidence, testimonial evidence or any other material evidence you considered, and whether the monument was found or placed.


In 1859 James McBride established this corner and set a wood post with BTs:  
12" Hemlock, N72°E, 47 Links                      16" Birch, S12°E, 36 Links  
12" Birch, S28°W, 49 Links                      10" Lynn, N86°W, 6 Links

5/9/89 - We found evidence of restorations in the past, a large pine stump with "BT" scribe clear. A recently cut off fence post. From this area we have evidence of the Hemlock BT, N72°E, 31.0'; the Birch, S12°E, 23.8' and the Birch S28°W, 34.5'. We restore this corner from the remains of these three original BTs. No record of who or when the large pine stump was scribed. Looks to be the Smith or Melindy era, however.

(c) In the plan view drawing below, provide reference ties to at least 4 witness monuments, or, if the location is within a municipality, to at least 2 witness monuments. (Witness monuments shall be made of concrete, natural stone, iron or other equally durable material.) Describe witness monuments.

(d) Show a plan view drawing depicting the relevant monuments and reference ties which is sufficient in detail to enable accurate relocation of the corner monument if the corner monument is disturbed. Indicate north.

- 1) 2 1/2" x 36" Aluminum Monument
- 2) 6" Red Pine, S9°W, 37.95'
- 3) 8" Red Pine, S63°W, 51.58'
- 4) 12" Sugar Maple, N12°W, 103.01'
- 5) 14" Sugar Maple, N58°W, 96.87'
- 6) Steel Sign Post, SW, 1.73'

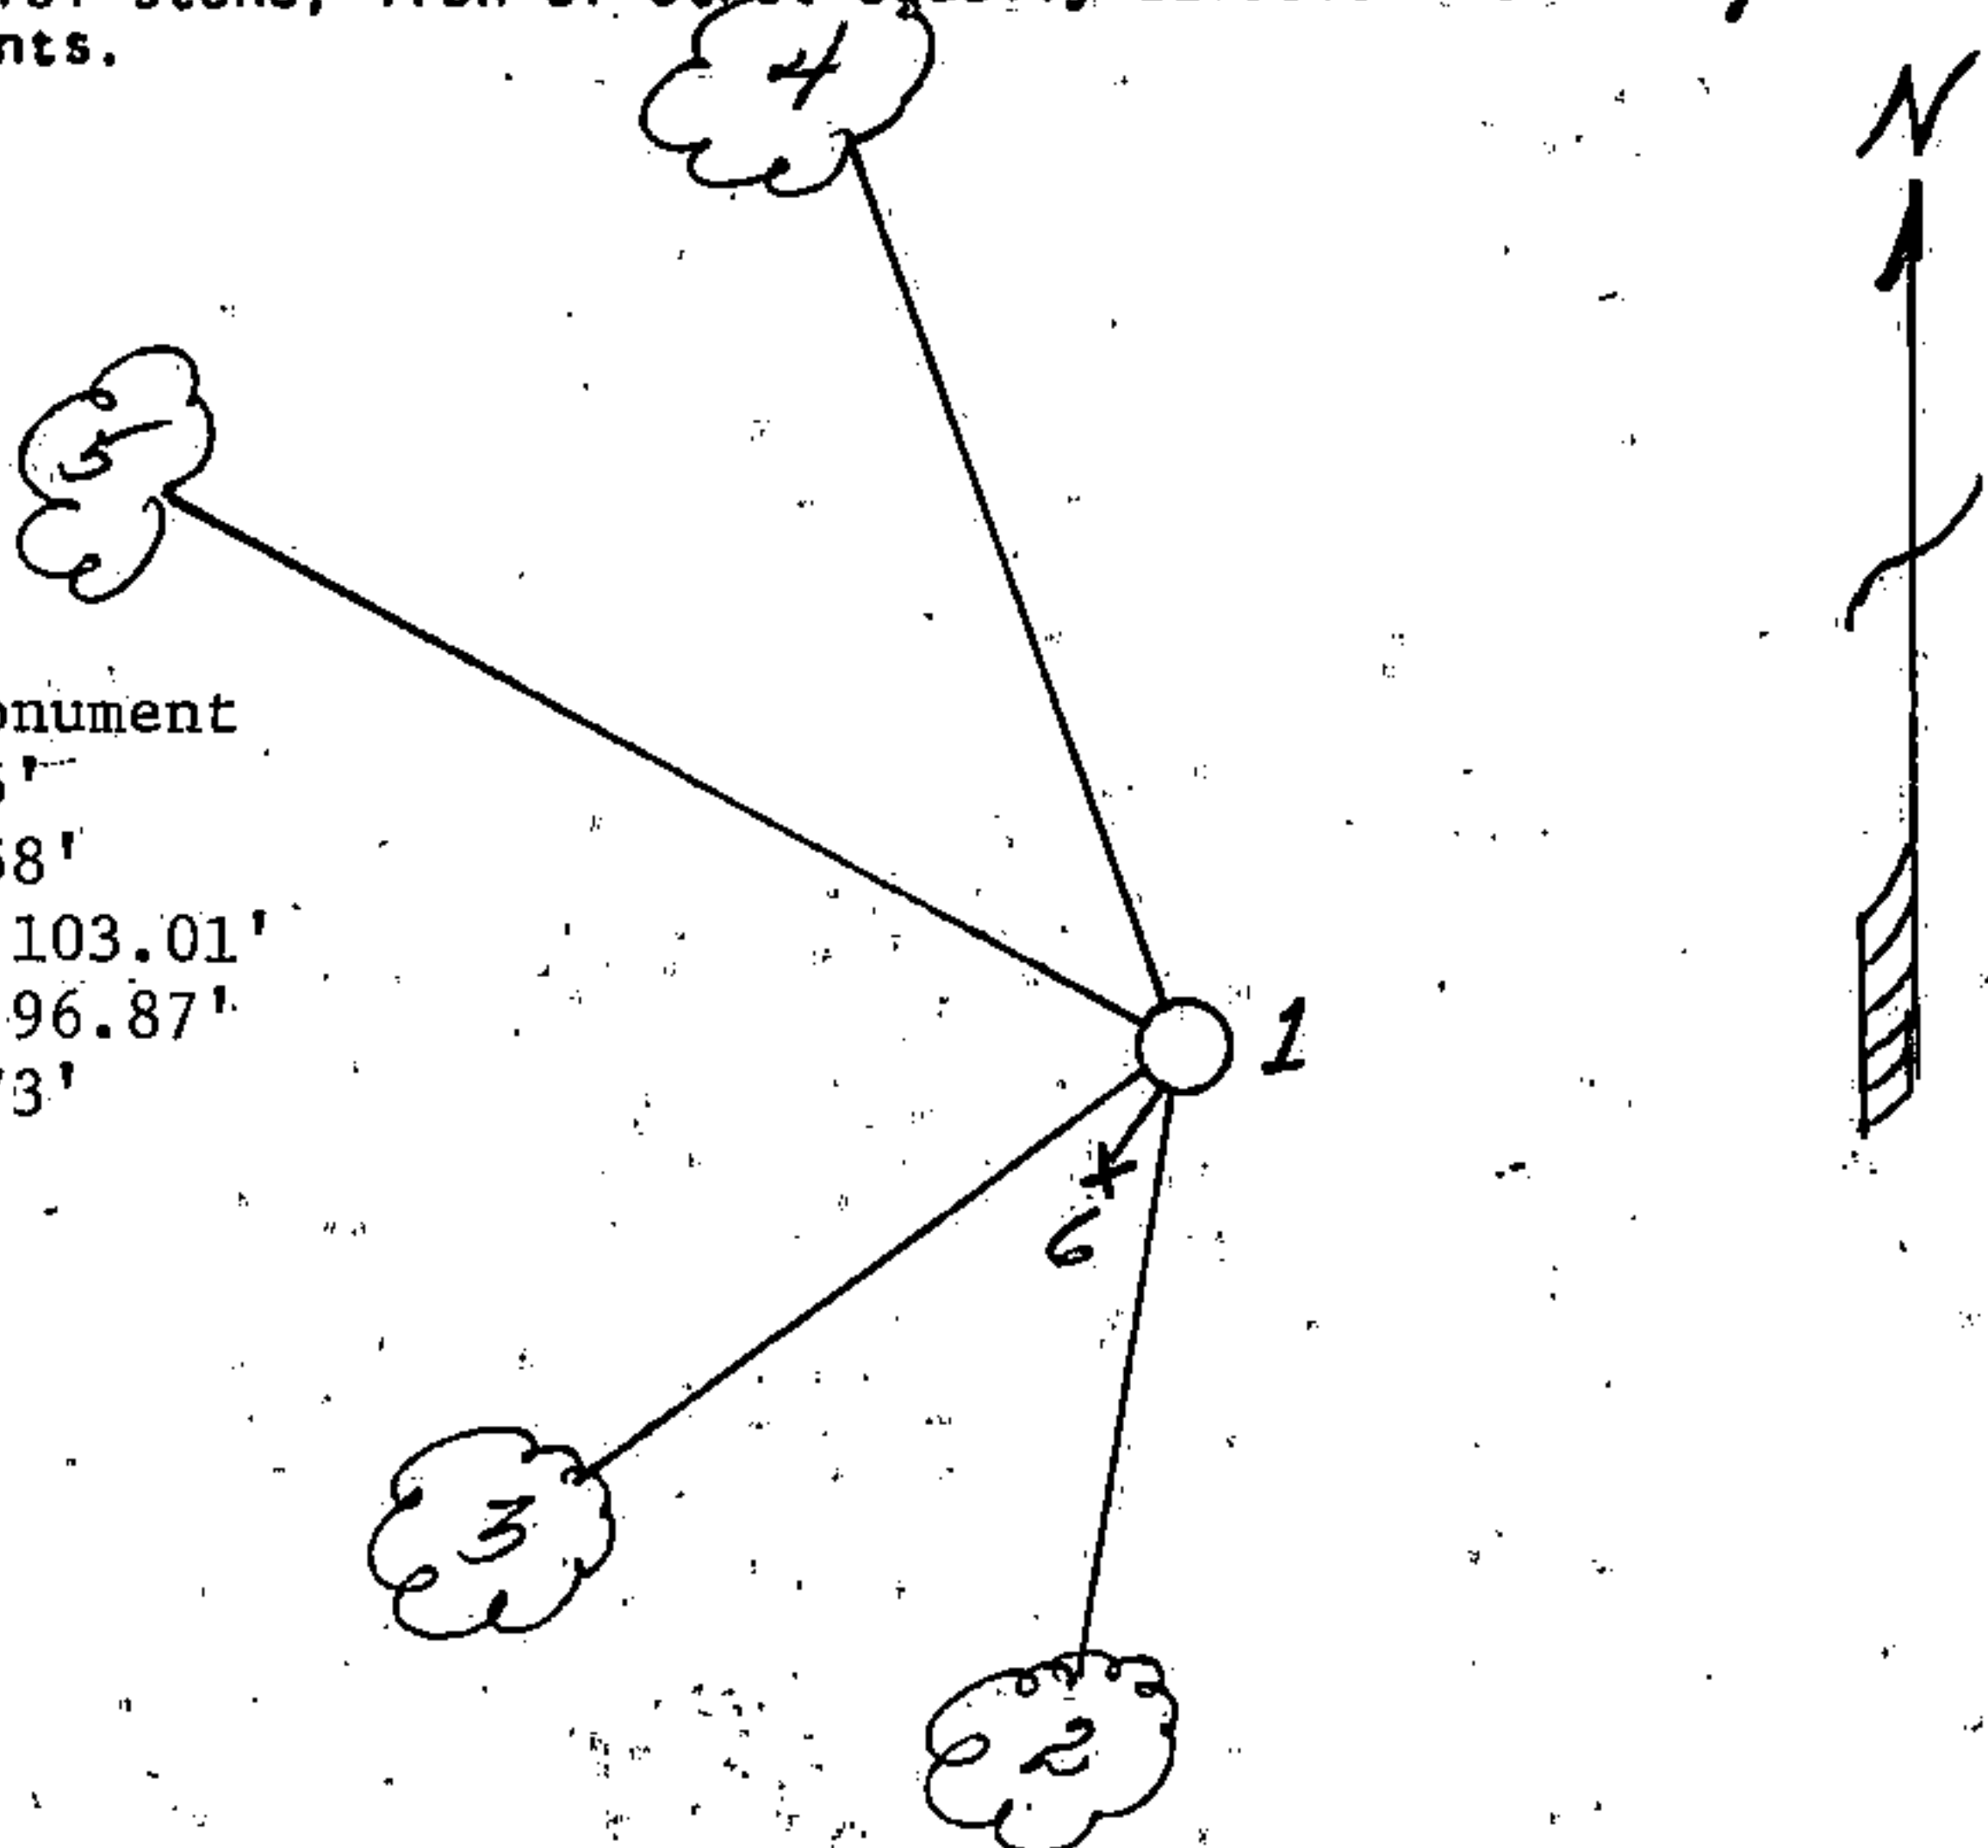

(e) Describe any material discrepancy between the location of the corner as restored or reestablished and the location of that corner as previously restored or reestablished by distance and direction. Show the discrepancy on the plan view drawing under (d), above. Show the distances between the corner as previously restored or reestablished and (1) the corner as restored or reestablished, and (2) to at least 2 of the witness monuments shown on the drawing in (d), above.

None

(f) Was the corner restored through acceptance of (1) an obliterated evidence location, or, (2) a found perpetuated location?

An obliterated location.

(g&h) Was the corner reestablished through lost corner proportionate methods? If so, show the method, including the directions and distances to other public land survey corners used as evidence or used for proportioning in determining the corner location?

Affix Land Surveyor Seal



(i) Milo E. Stefan

(Type or print name) certify that the corner location shown on this record was determined by me or under my direction and control and that this U.S. Public Land Survey Monument Record is correct and complete to the best of my knowledge and belief.

Milo E. Stefan  
Signature

6/24/89  
Date

Certificate ready for filing:

Dale S. Stage  
District Ranger