

CERTIFIED LAND CORNER RESTORATION

State of Wisconsin }  
 County of Forest } ss.

I Jean F. Resvick, do hereby certify that on the 23d day of June, 19 65, I found evidence of the North quarter corner of Section 36 Township 35 North, Range 15 East, Fourth Principal Meridian, as described hereon; and that from this evidence I established a new monument and accessories as described hereon to perpetuate the original location of this corner:

Description of original monument and accessories and subsequent restorations:

Survey in 1859 by James McBride  
 40.00 chains west corrected between Sections 25 and 36 set wood post  
 W. Ash 6", N.21 E., 16 lks.  
 Hemlock 10", S.37°E., 14 lks.




Description of corner evidence found:


4x4 post, scribed 1/4S, S25, S36 on both east and west side of road.  
 4x4 posts measure 66 ft. East and West between them. West 4x4 has F.S. poster rusted beyond reading.  
 The two posts are accepted as being witnesses to the quarter corner which falls in the road on a curve.

Description of monument and accessories I established to perpetuate the original location of this corner:

Set a 2 in. inside diam., galvanized iron pipe, 30 inches long, 6 ins. below surface of the road and 33 ft. from each witness post for quarter corner between Sections 25 and 26. Replaced 4x4 witness post on west side road with 2 in. inside diam., galvanized iron pipe, 30 ins. long, 6 ins. above ground. Replaced 4 x4 witness post East side road with 2 ins. inside diam., galvanized iron pipe, 5 feet long, filled with concrete, flanged at bottom, with brass cap marked:

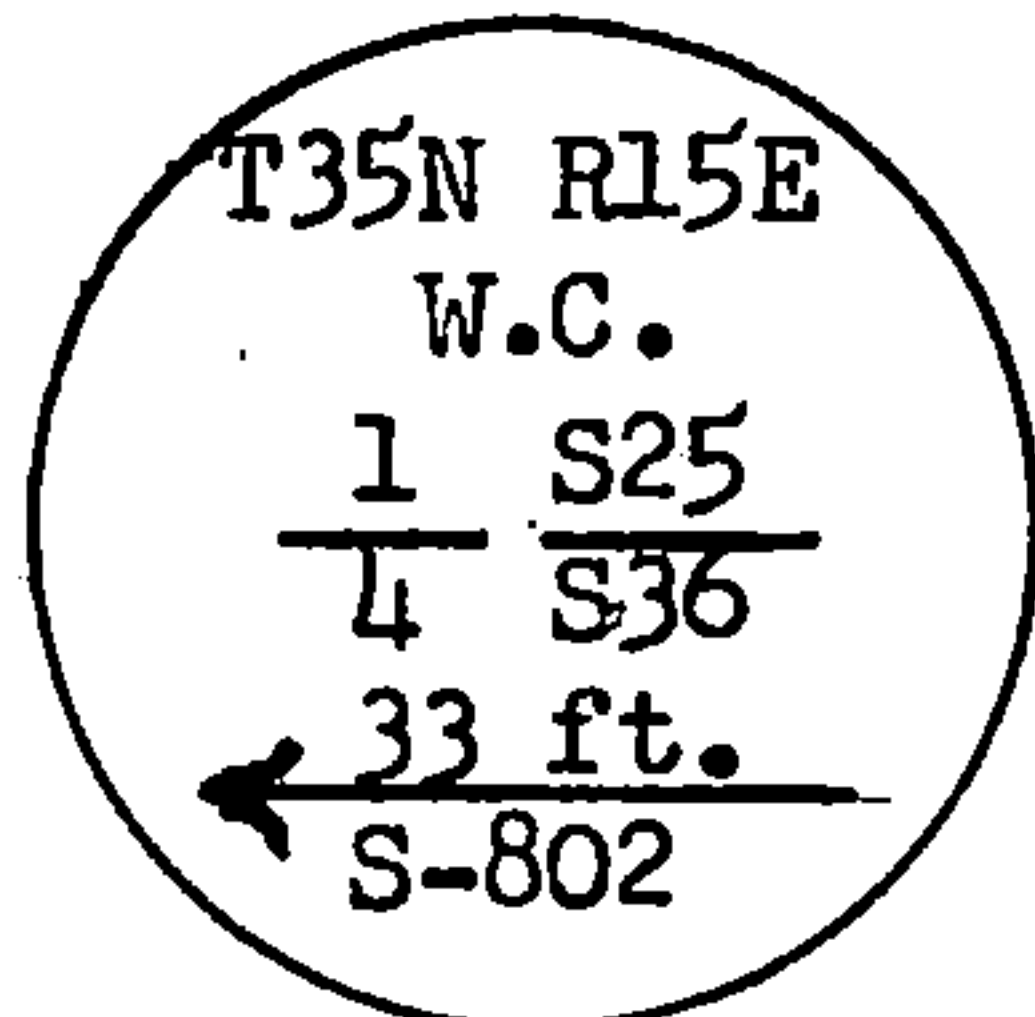

from which the following blazed and scribed bearing trees bear.  
 Elm 4", N.64° 30' E., 17.50 ft. or 26.52 lks.  
 Elm 3", S5°E., 4.66 ft. or 7.06 lks.

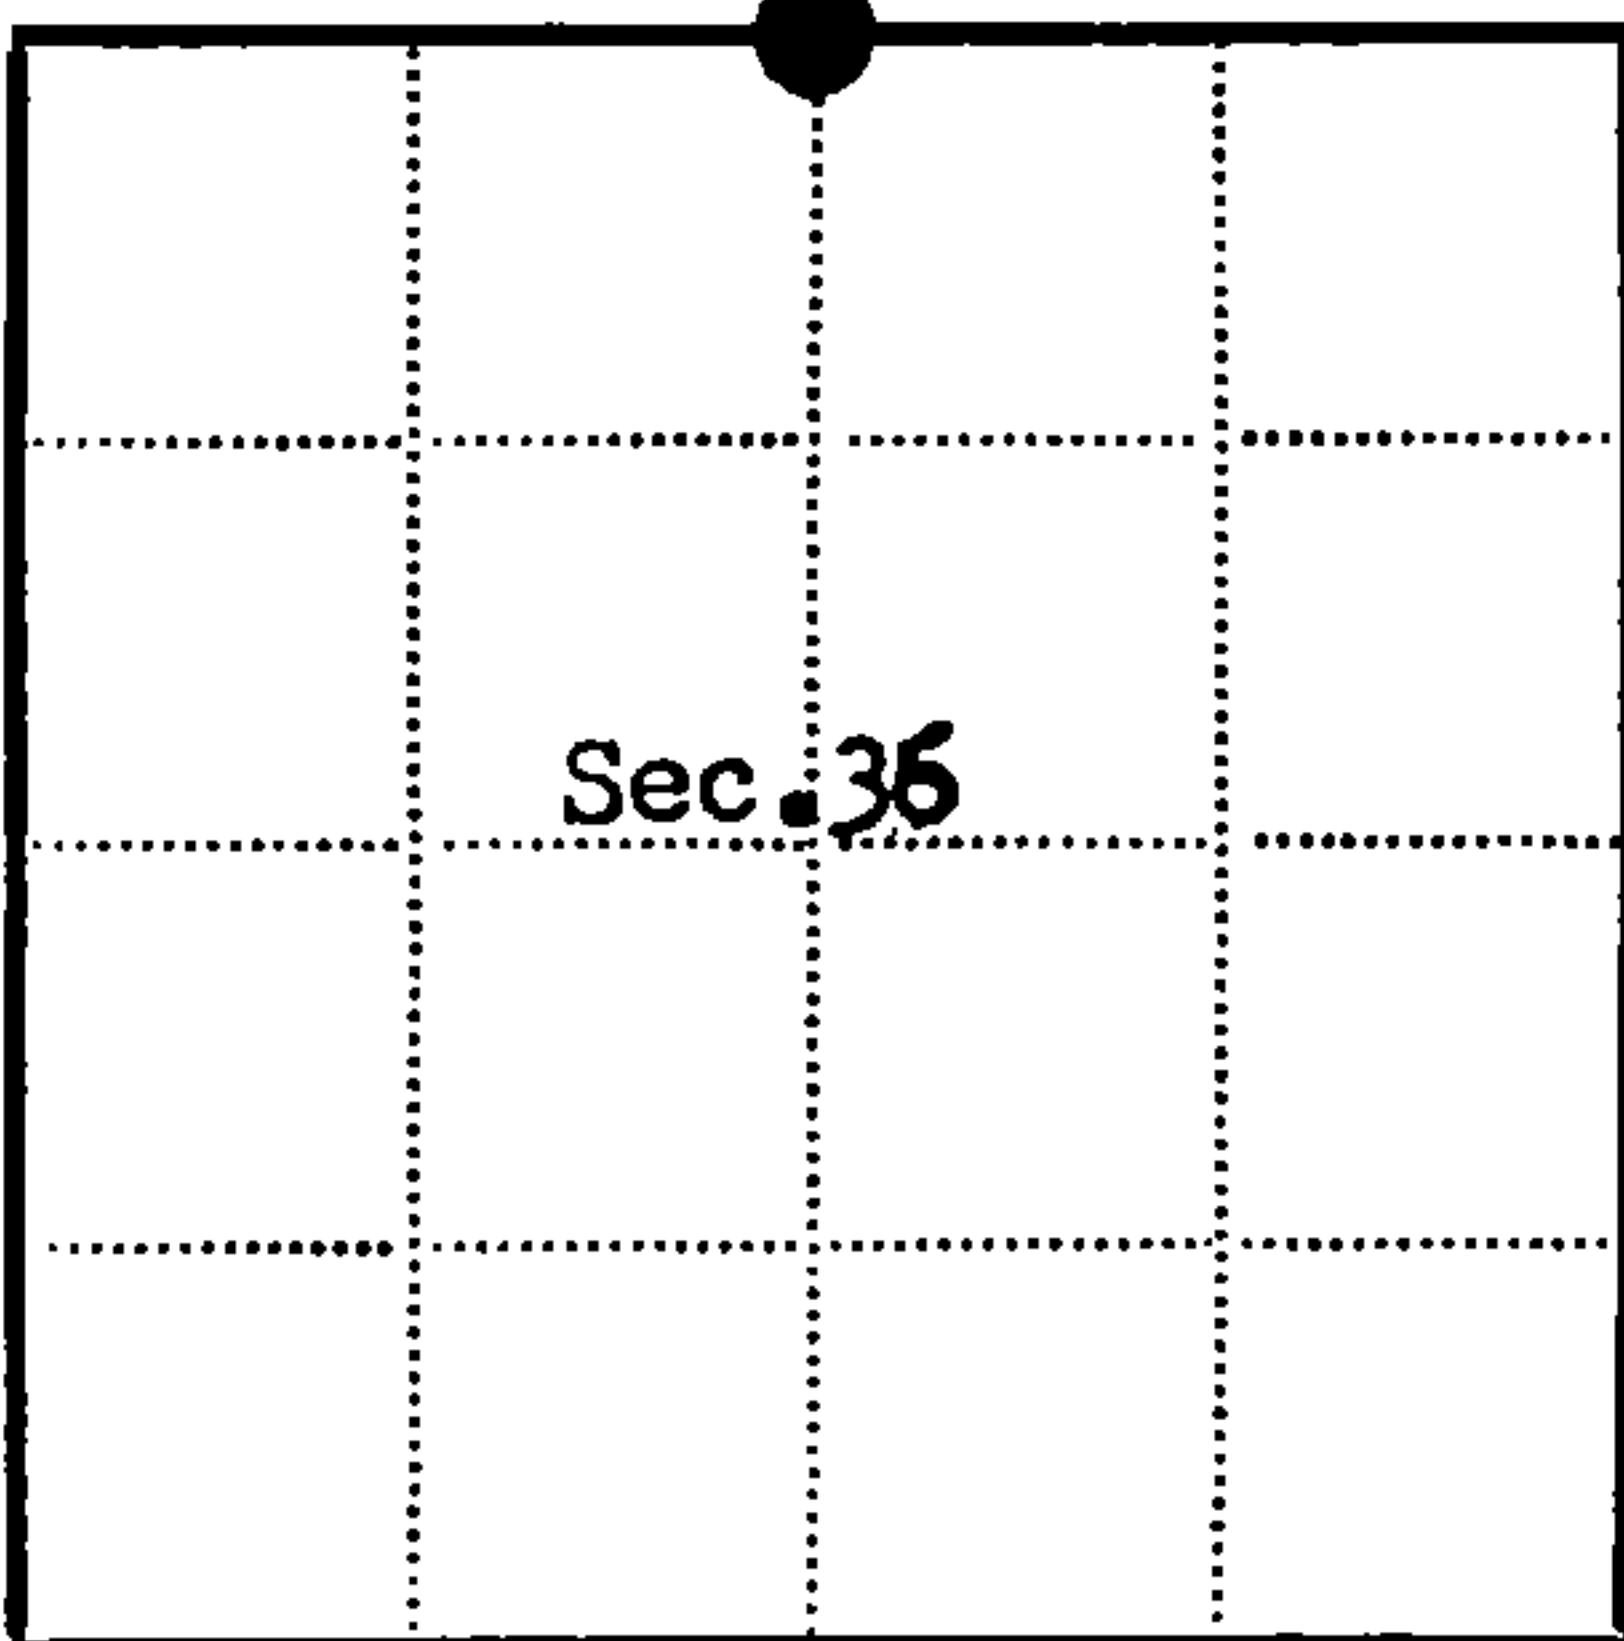

● = Corner monument restored  
 □ =

Resident witnesses.....

Dated at Rhineland Wisconsin, this 3rd day of Sept 19 65.

Signature Jean F. Resvick Title Cadastral Surveyor  
 (County Surveyor, Registered Land Surveyor, or other duly authorized official)

Surveyors Registration No. S-802 90972

Office of Register of Deeds County of Forest

I hereby certify that the within instrument was filed in this office for record on the 17 day of December 1965, and was filed in Book No. 1 Page No. 4 PM of County Records.

Signature Anna Peterson Title Register of Deeds

Township 35 North, Range 15 East, Section 36, Index No. V-23, Page No. 4 PM