

DOCUMENT NUMBER
136605


U. S. PUBLIC LAND SURVEY MONUMENT RECORD

INSTRUCTIONS: This record shall show the location of the corner and shall include all of the following nine elements (a. through i).

(a) Identify the corner by reference to the U.S. public land survey system.

○ = Corner monument restored.

Quarter Corner Common to Sections 3 and 34
T34-35N, R15E, Forest County, Wisconsin.

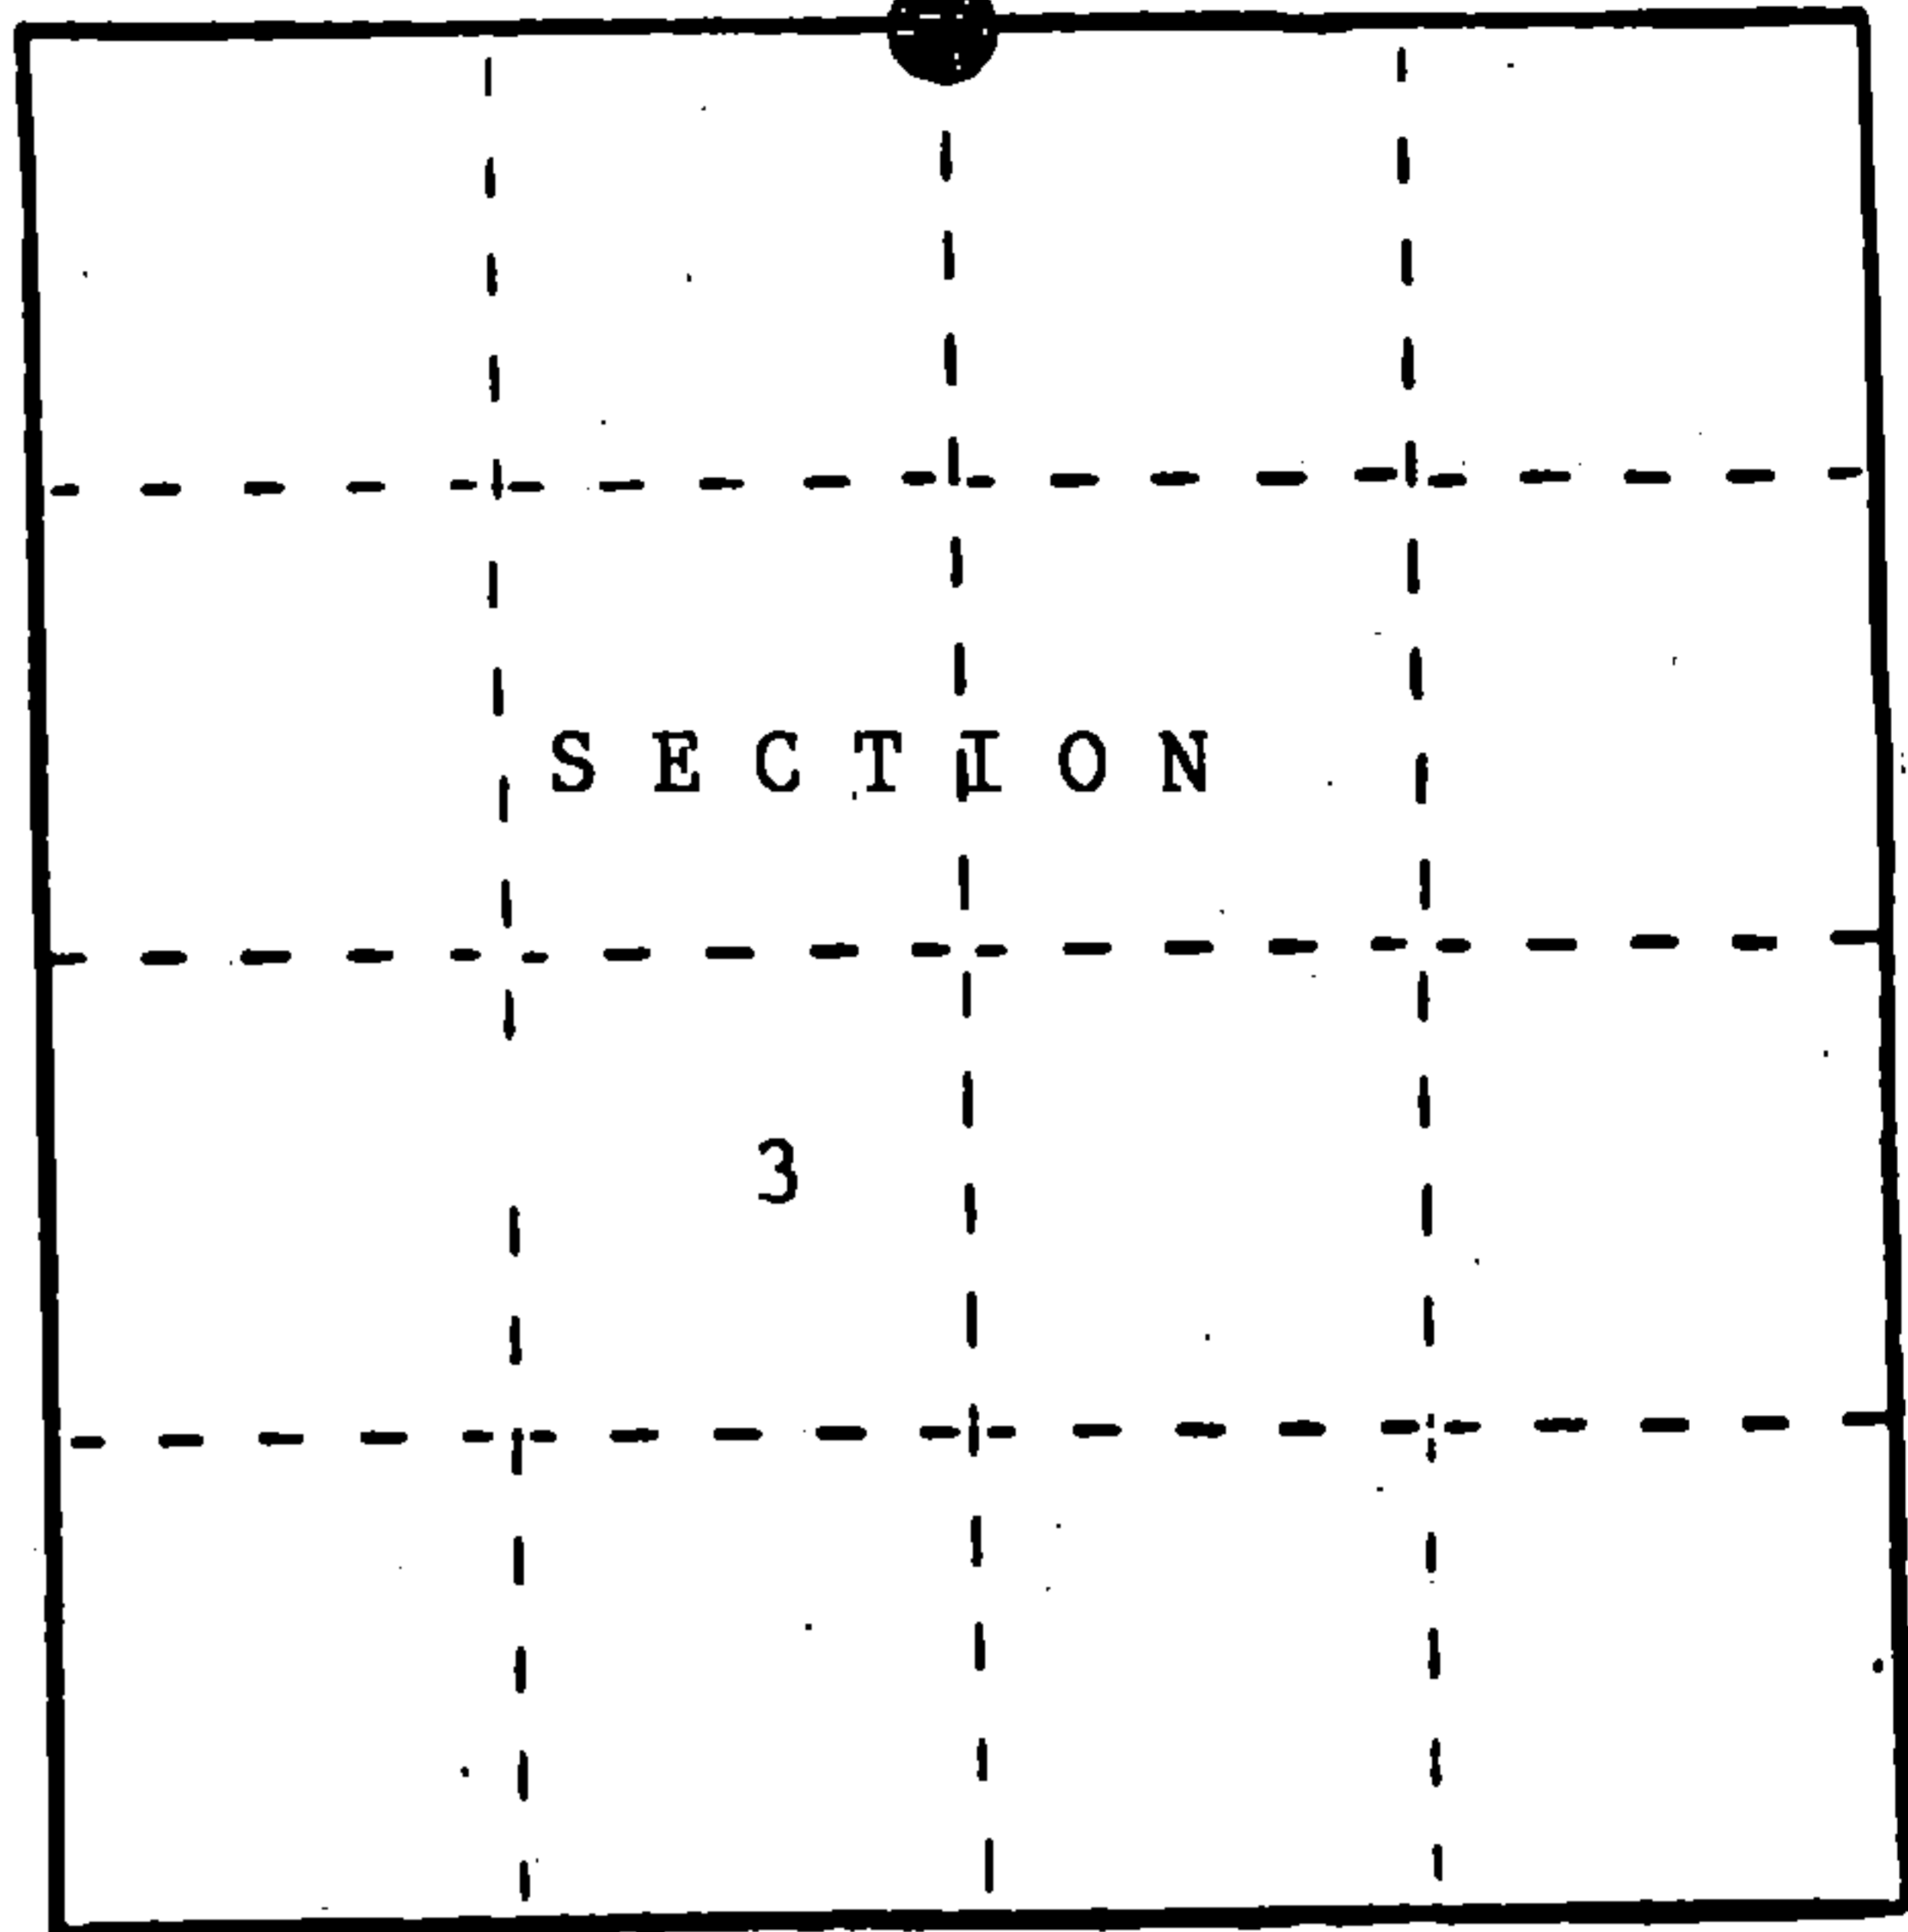

REGISTER'S OFFICE
Forest County, Wis. *gd*
Received for record this *9* day
of *December* A.D., 19*88* at
2:50 o'clock *P.* M. and recorded
in Vol. *CORNER RESTORATIONS*
page *A-15*
Paul Aschenbrenner
Register of Deeds

(b) Describe any record evidence, monument evidence, occupational evidence, testimonial evidence or any other material evidence you considered, and whether the monument was found or placed.

In 1857, A. Curtis set a wood post for the corner and the following corner references:

- Hemlock 10" N73°W 24 lks.
- Hemlock 14" S49°E 24 lks.


In 1988, Found no evidence.

Placed a 2 1/2' X 36" aluminum monument.

(c) In the plan view drawing below, provide reference ties to at least 4 witness monuments, or, if the location is within a municipality, to at least 2 witness monuments. (Witness monuments shall be made of concrete, natural stone, iron or other equally durable material.) Describe witness monuments.

(d) Show a plan view drawing depicting the relevant monuments and reference ties which is sufficient in detail to enable accurate relocation of the corner monument if the corner monument is disturbed. Indicate north.

1. 2 1/2" X 36" aluminum magnetic cap monument, placed in a mound of stones, stamped to identify the corner.
2. Black Ash 9" N30°E 38.33 ft.
3. Red Maple 10" S79°E 48.26 ft.
4. Hemlock 14" S05°E 24.87 ft.
5. Red Maple 10" S77°W 33.97 ft.
6. Steel sign post South 2.2 ft.

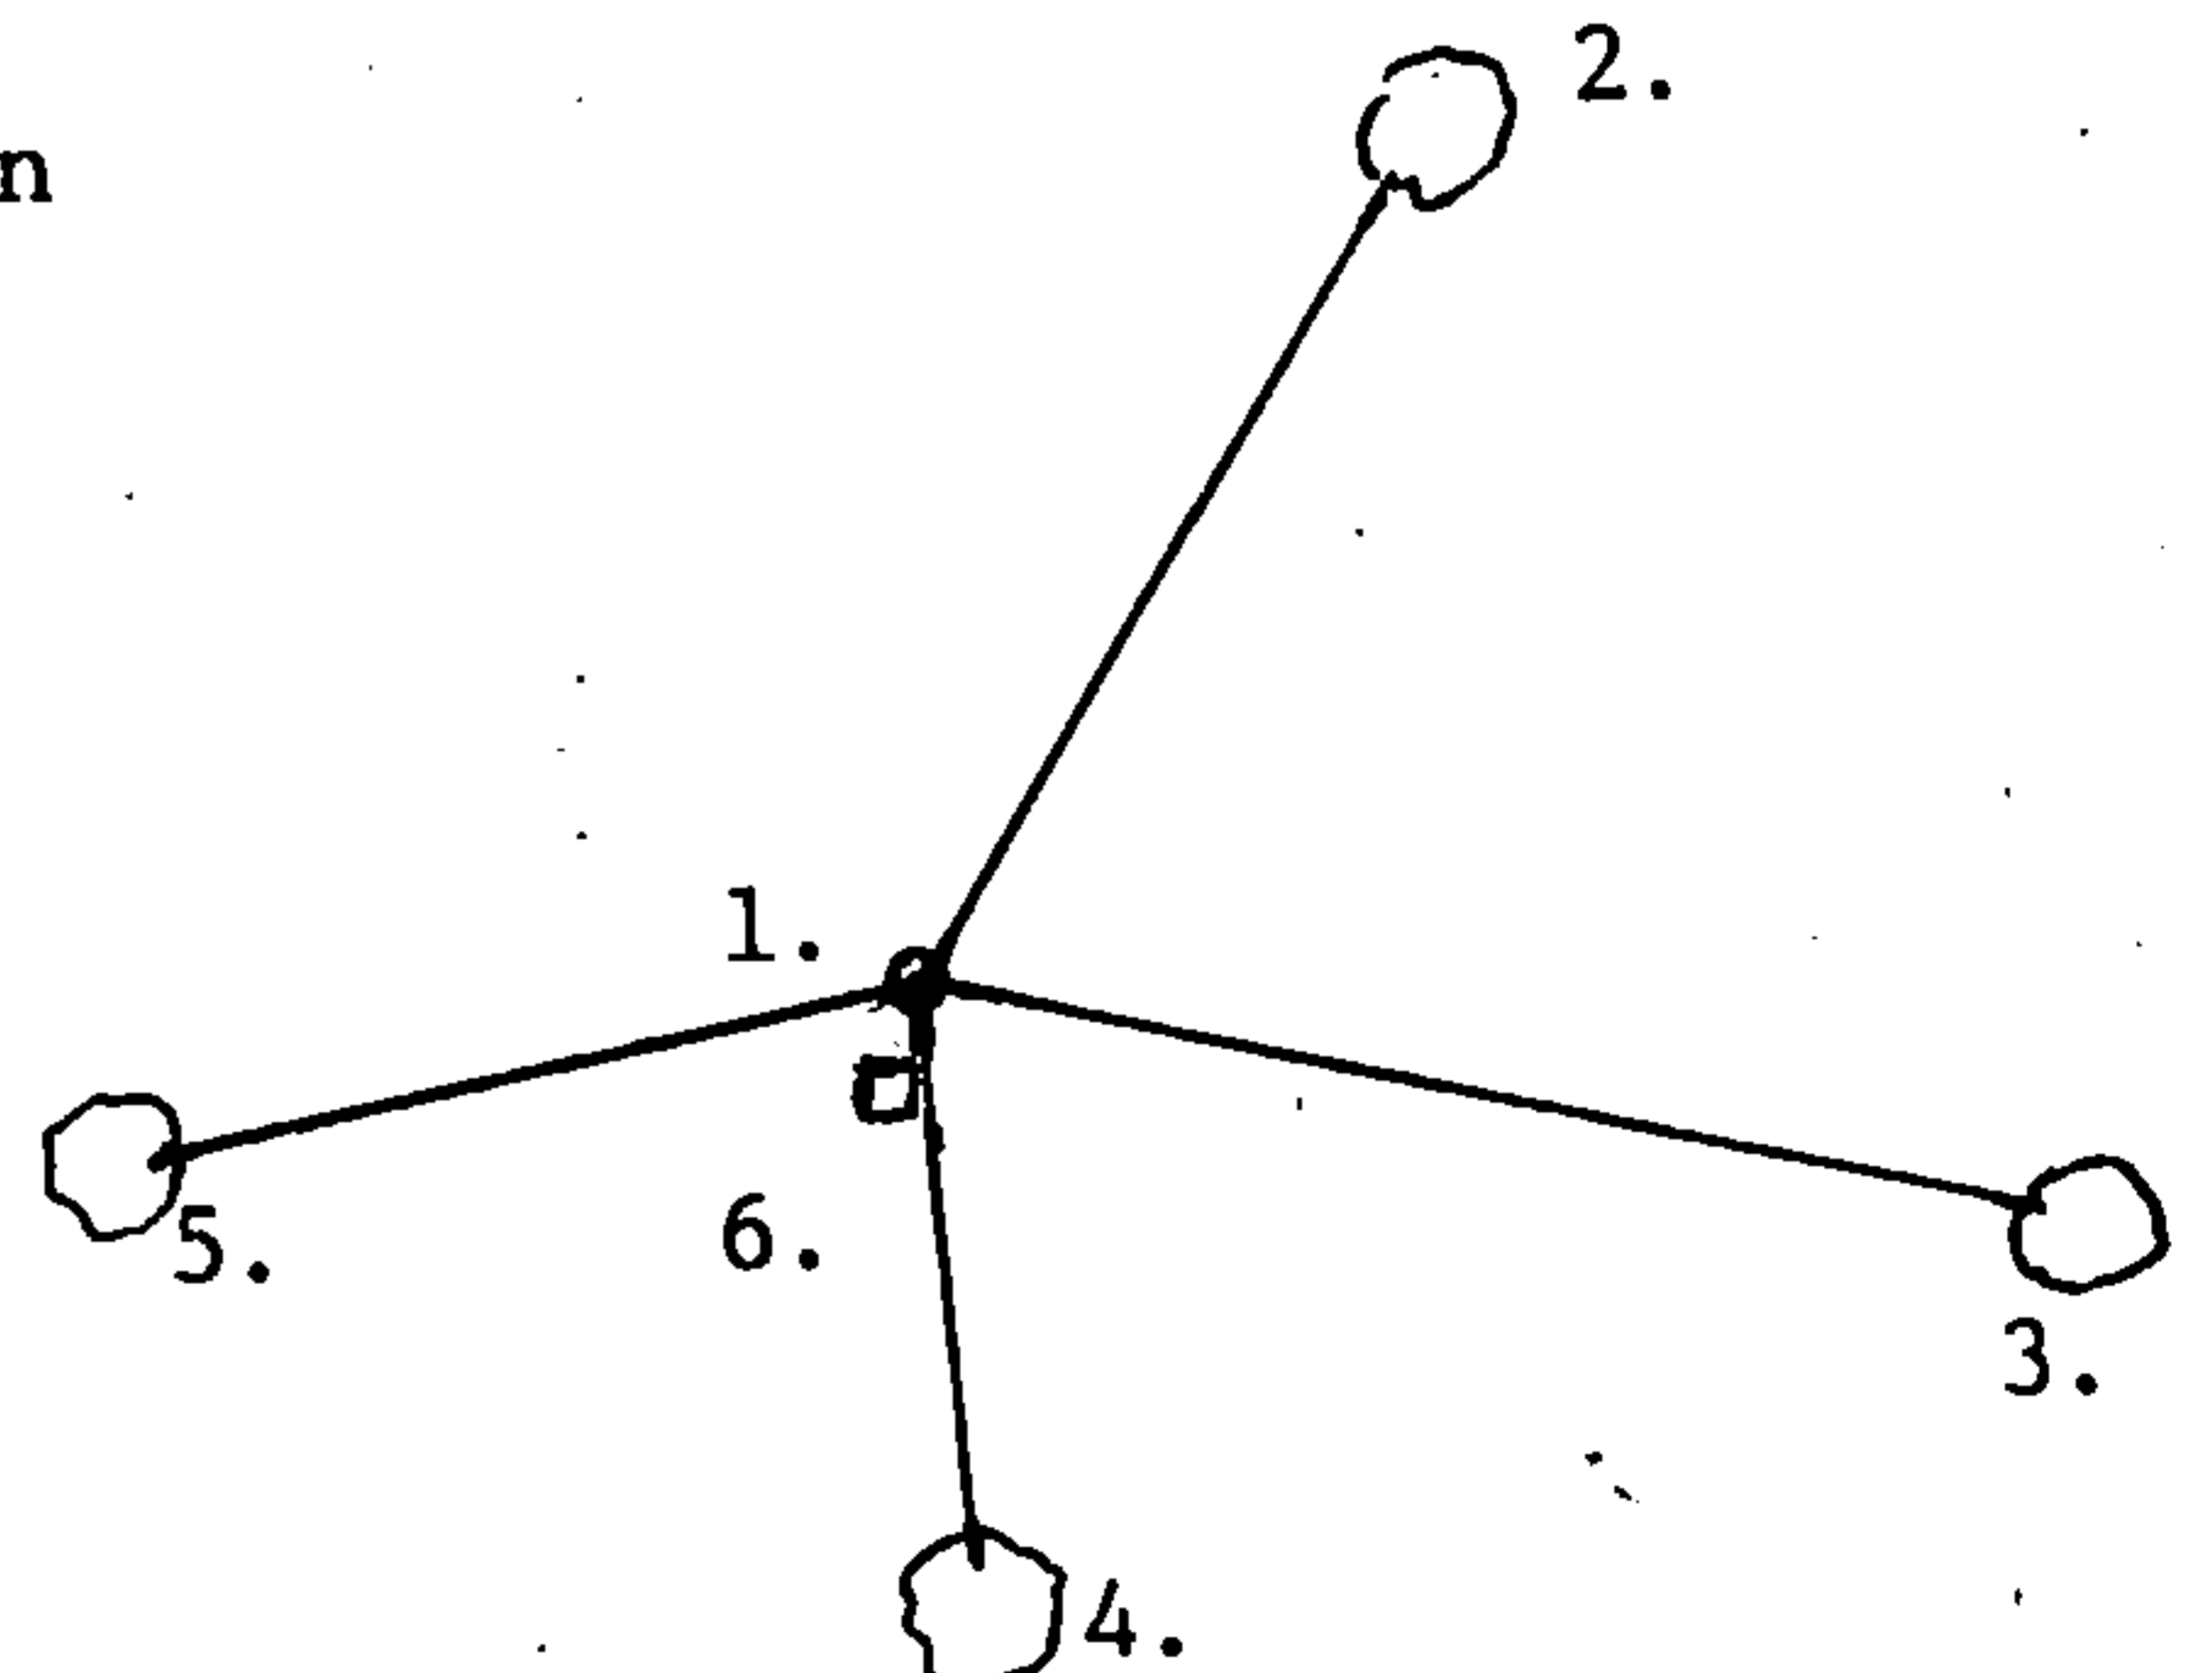

(e) Describe any material discrepancy between the location of the corner as restored or reestablished and the location of that corner as previously restored or reestablished by distance and direction. Show the discrepancy on the plan view drawing under (d), above. Show the distances between the corner as previously restored or reestablished and (1) the corner as restored or reestablished, and (2) to at least 2 of the witness monuments shown on the drawing in (d), above.


No discrepancy, first corner restoration.

(f) Was the corner restored through acceptance of (1) an obliterated evidence location, or, (2) a found perpetuated location?

No, See g and h.


(g&h) Was the corner reestablished through lost corner proportionate methods? If so, show the method, including the directions and distances to other public land survey corners used as evidence or used for proportioning in determining the corner location?

Corner restored by proportionate method.

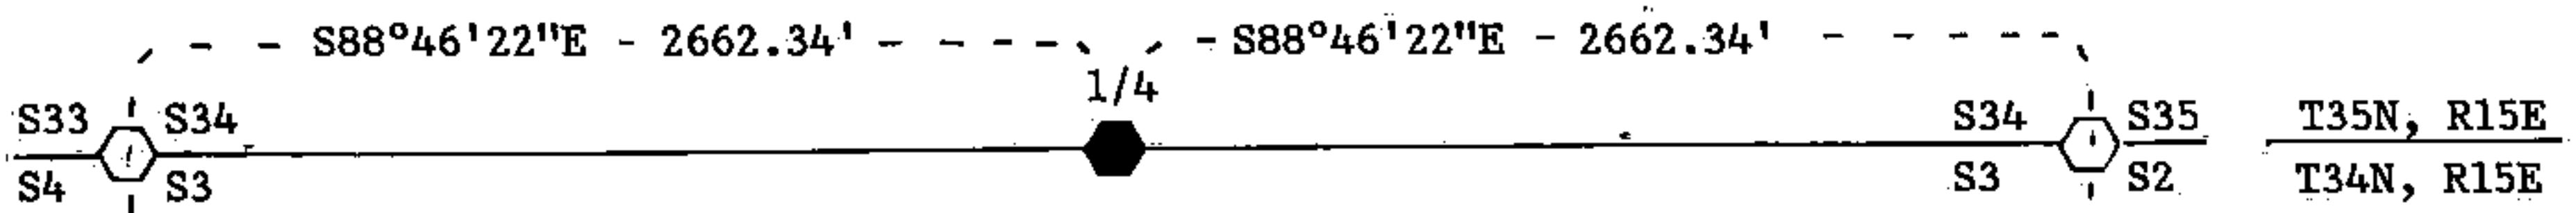

S33 S34
S4 S3

S34 S35
S3 S2 T35N, R15E
T34N, R15E

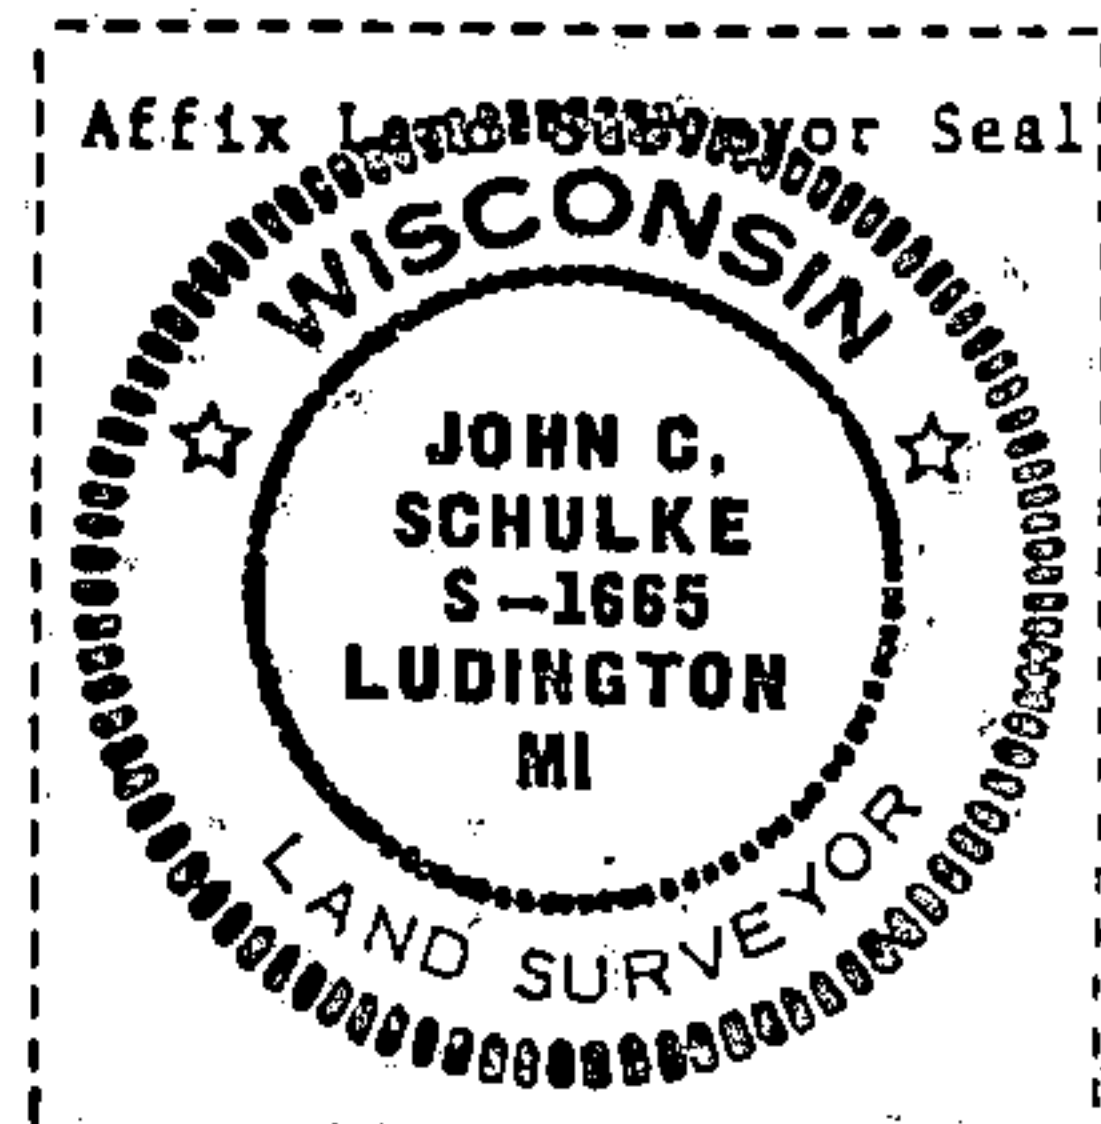

(1) I, John C. Schulke
(type or print name) certify that the corner location shown on this record was determined by me or under my direction and control and that this U.S. Public Land Survey Monument Record is correct and complete to the best of my knowledge and belief.

John C. Schulke Oct 16, 1988
Signature Date

Certificate ready for filing. Dale B. Stage
District Ranger