

CERTIFIED LAND CORNER RESTORATION

State of Wisconsin }
County of Forest } ss.

I Jean F. Resvick, do hereby certify that on the 29th day of April, 1975, I found evidence of the Southeast Section corner of Section 24 Township 35 North, Range 16 East, Fourth Principal Meridian, as described hereon; and that from this evidence I established a new monument and accessories as described hereon to perpetuate the original location of this corner:

Description of original monument and accessories and subsequent restorations:

Surveyed in August 1857 by Artemas Curtis
Surveyed in December 1934 and July 1935 by J.J. Jenkins, Menominee County Surveyor. N00°15'E between Sections 25 and 30. 79.90 chains set a 4 inch iron post with a brass cap stamped: Marinette Co. Survey, T35N R16E, T35N R17E, 19, 24, 25, 30.


Description of corner evidence found:

Monument as described above and in place.

Description of monument and accessories I established to perpetuate the location of this corner:

Blazed and scribed the following new bearing trees:

- Cherry, 9", N60°E, 10.06 feet
- Maple, 18", S51°E, 53.51 feet
- R. Pine, 5", S65°W, 26.03 feet
- Elm, 7", N53°W, 40.65 feet
- Set a steel sign post north of the monument, 0.50 feet

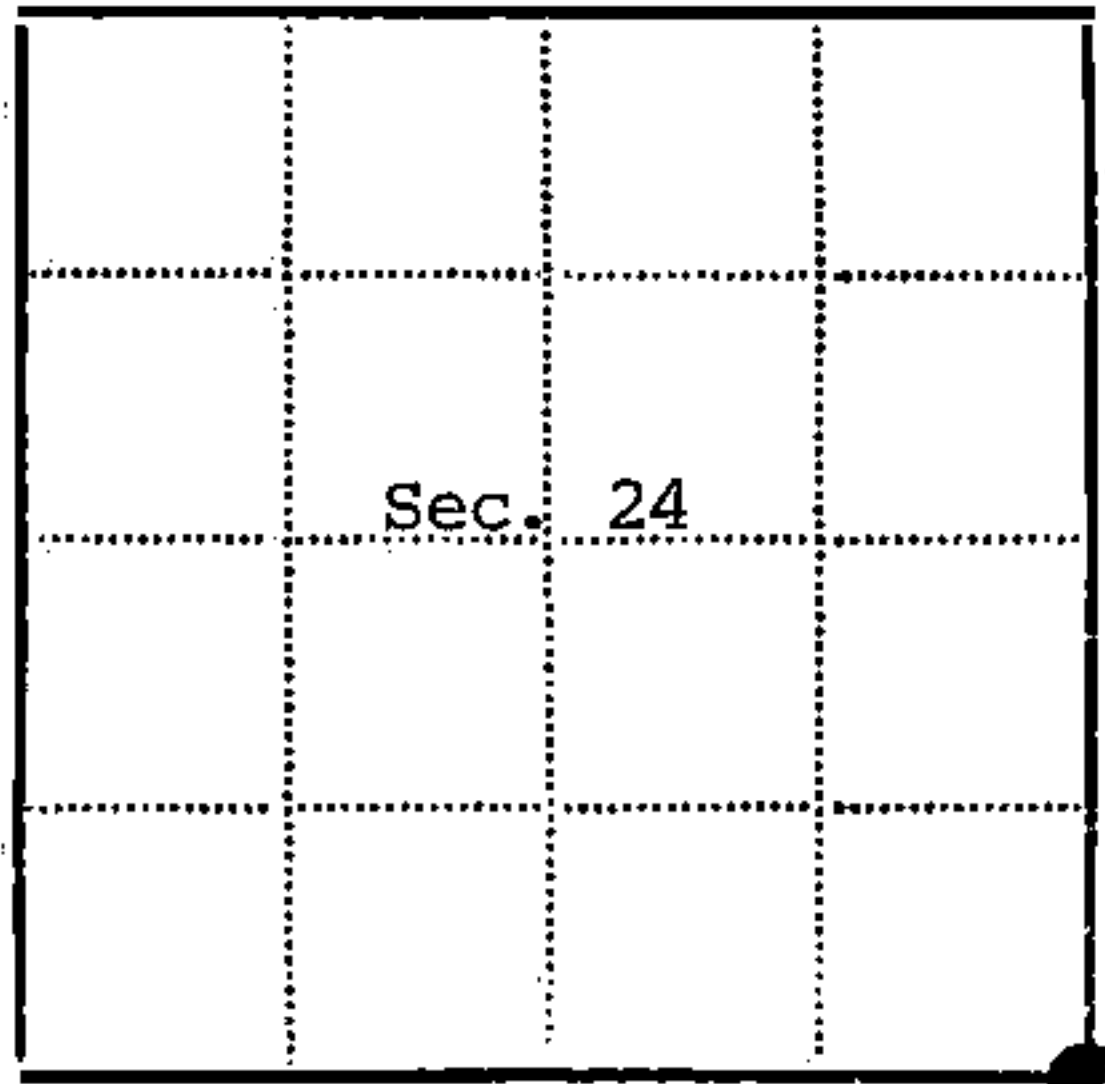

● - Corner monument restored
□ -

Resident witnesses.....

Dated at Rhinelander Wisconsin, this 15 day of June 1976.

Signature *Jean F. Resvick* Title Land Surveyor
(County Surveyor, Registered Land Surveyor, or other duly authorized official)

Surveyors Registration No. s-802

DOCUMENT NUMBER
109583

Office of Register of Deeds County of Forest

I hereby certify that the within instrument was filed in this office for record on the 2nd day of July 1976 and was filed in Book No. Page No. of County Records.

Signature *Eugene Stutzny* Title Register of Deeds

Township 35 North, Range 16 East, Section 24, Index No. R-25, Page No.

4351624 0000

SEE ALSO P-1 T-35N-R16E

R25