


## U. S. PUBLIC LAND SURVEY MONUMENT RECORD

## INSTRUCTIONS:

This record shall show the location of the corner and shall include all of the following nine elements (a through i).

- (a) Identify the corner by reference to the U.S. public land survey system.  
 ● = Corner monument restored.

Quarter corner to sections 30 and 31,  
 T.35N., R.16E., Forest County, Wisconsin.

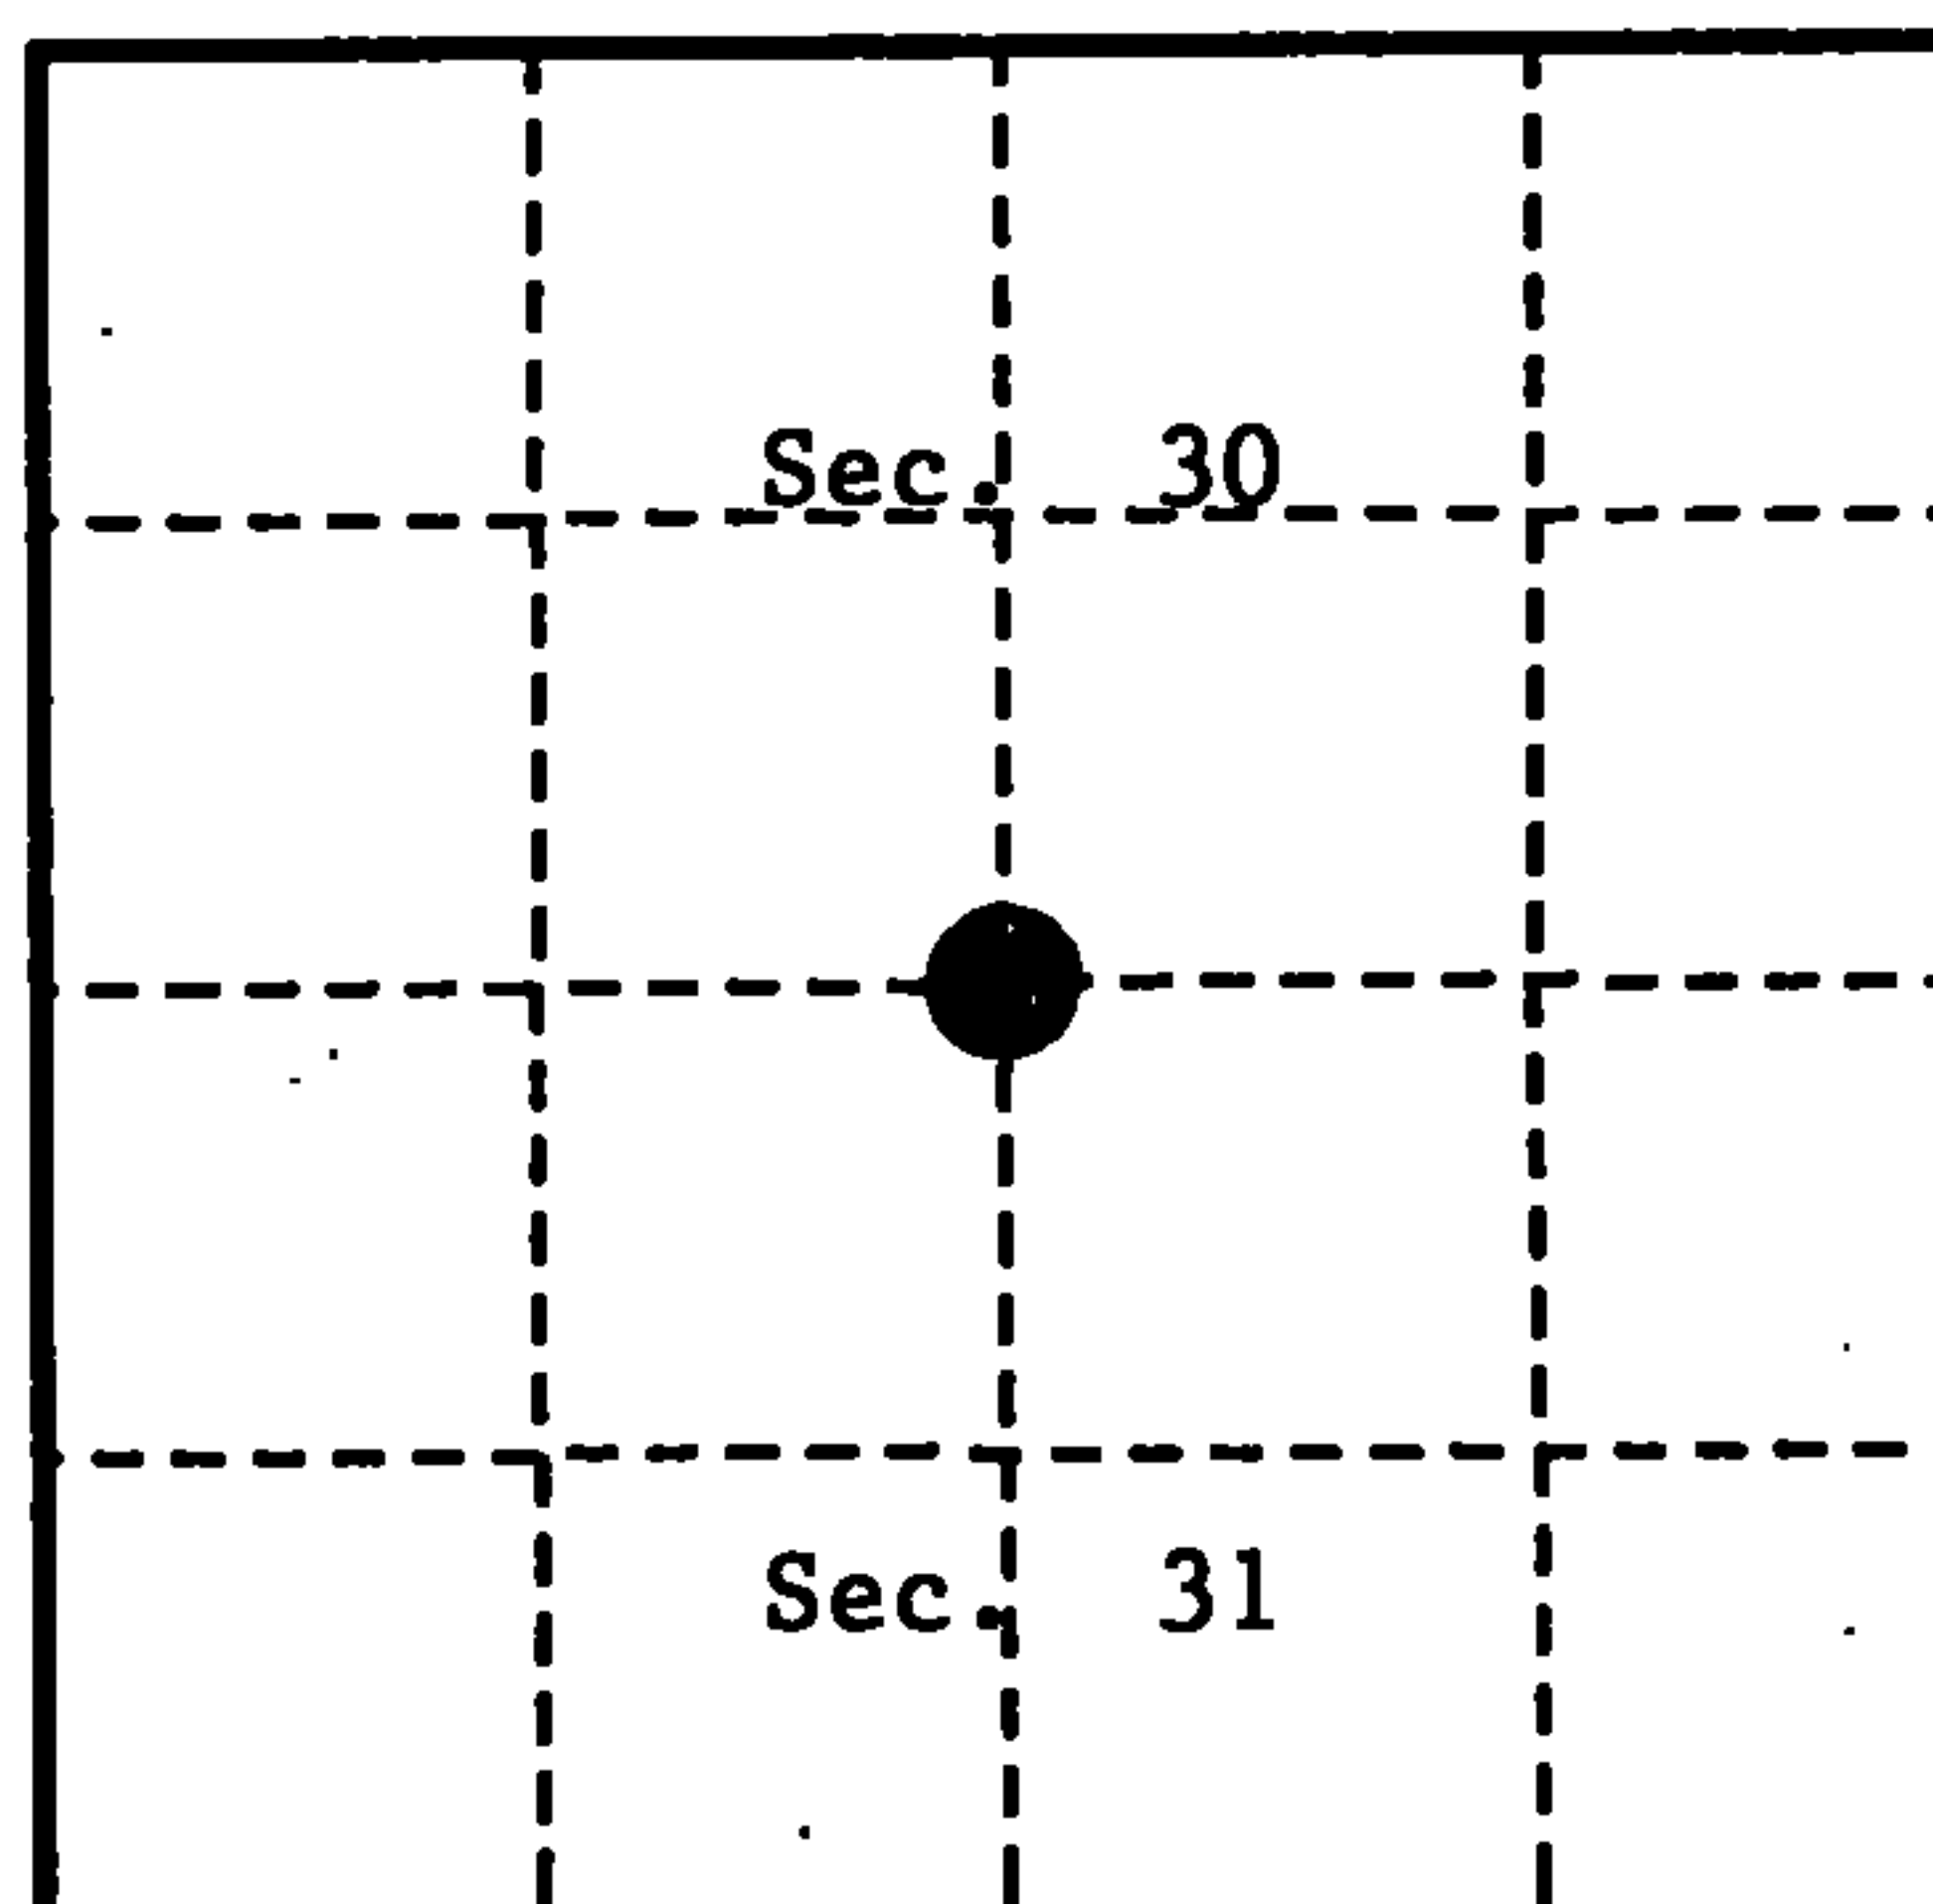

- (b) Describe any record evidence, monument evidence, occupational evidence, testimonial evidence or any other material evidence you considered, and whether the monument was found or placed.

In 1858, James McBride set a wood post with the following B.T.'s: Sugar Maple, 7", S.15°W., 23 links (15.18 feet); Sugar Maple, 8", N.34°W., 17 links (11.22 feet).

In 1979, Milo Stefan (RLS) found a strand of barb wire fence on the ground and about 20 feet north of the fence is a 20 inch Sugar Maple with a face on the southeast side which could be the Northwest B.T. (need chain saw to examine).


In 1985, Neider and Reichelt found the fence line and fence corner. Corner is south-southwest of an old clearing. Blazed trees facing corner area.

In 1990, Alan Harrison (RLS) found corner as per Neider and Reichelt. Accepted fence corner as best evidence of corner location. Set monument and made the following B.T.'s.

- (c) In the plan view drawing below, provide reference ties to at least 4 witness monuments, or, if the location is within a municipality, to at least 2 witness monuments. (witness monuments shall be made of concrete, natural stone, iron or other equally durable material.)

- (d) Show a plan view drawing depicting the relevant monuments and reference ties which is sufficient in detail to enable accurate relocation of the corner monument if the corner monument is disturbed. Indicate north.

- 2½" x 36" aluminum monument with tablet stamped to identify the corner.
- Sugar Maple, 8", N.80°E., 12.41 feet.
- Basswood, 7", S.03°E., 8.33 feet.
- Sugar Maple, 10", N.77°W., 17.90 feet.
- Steel Sign Post, East, 1.19 feet.

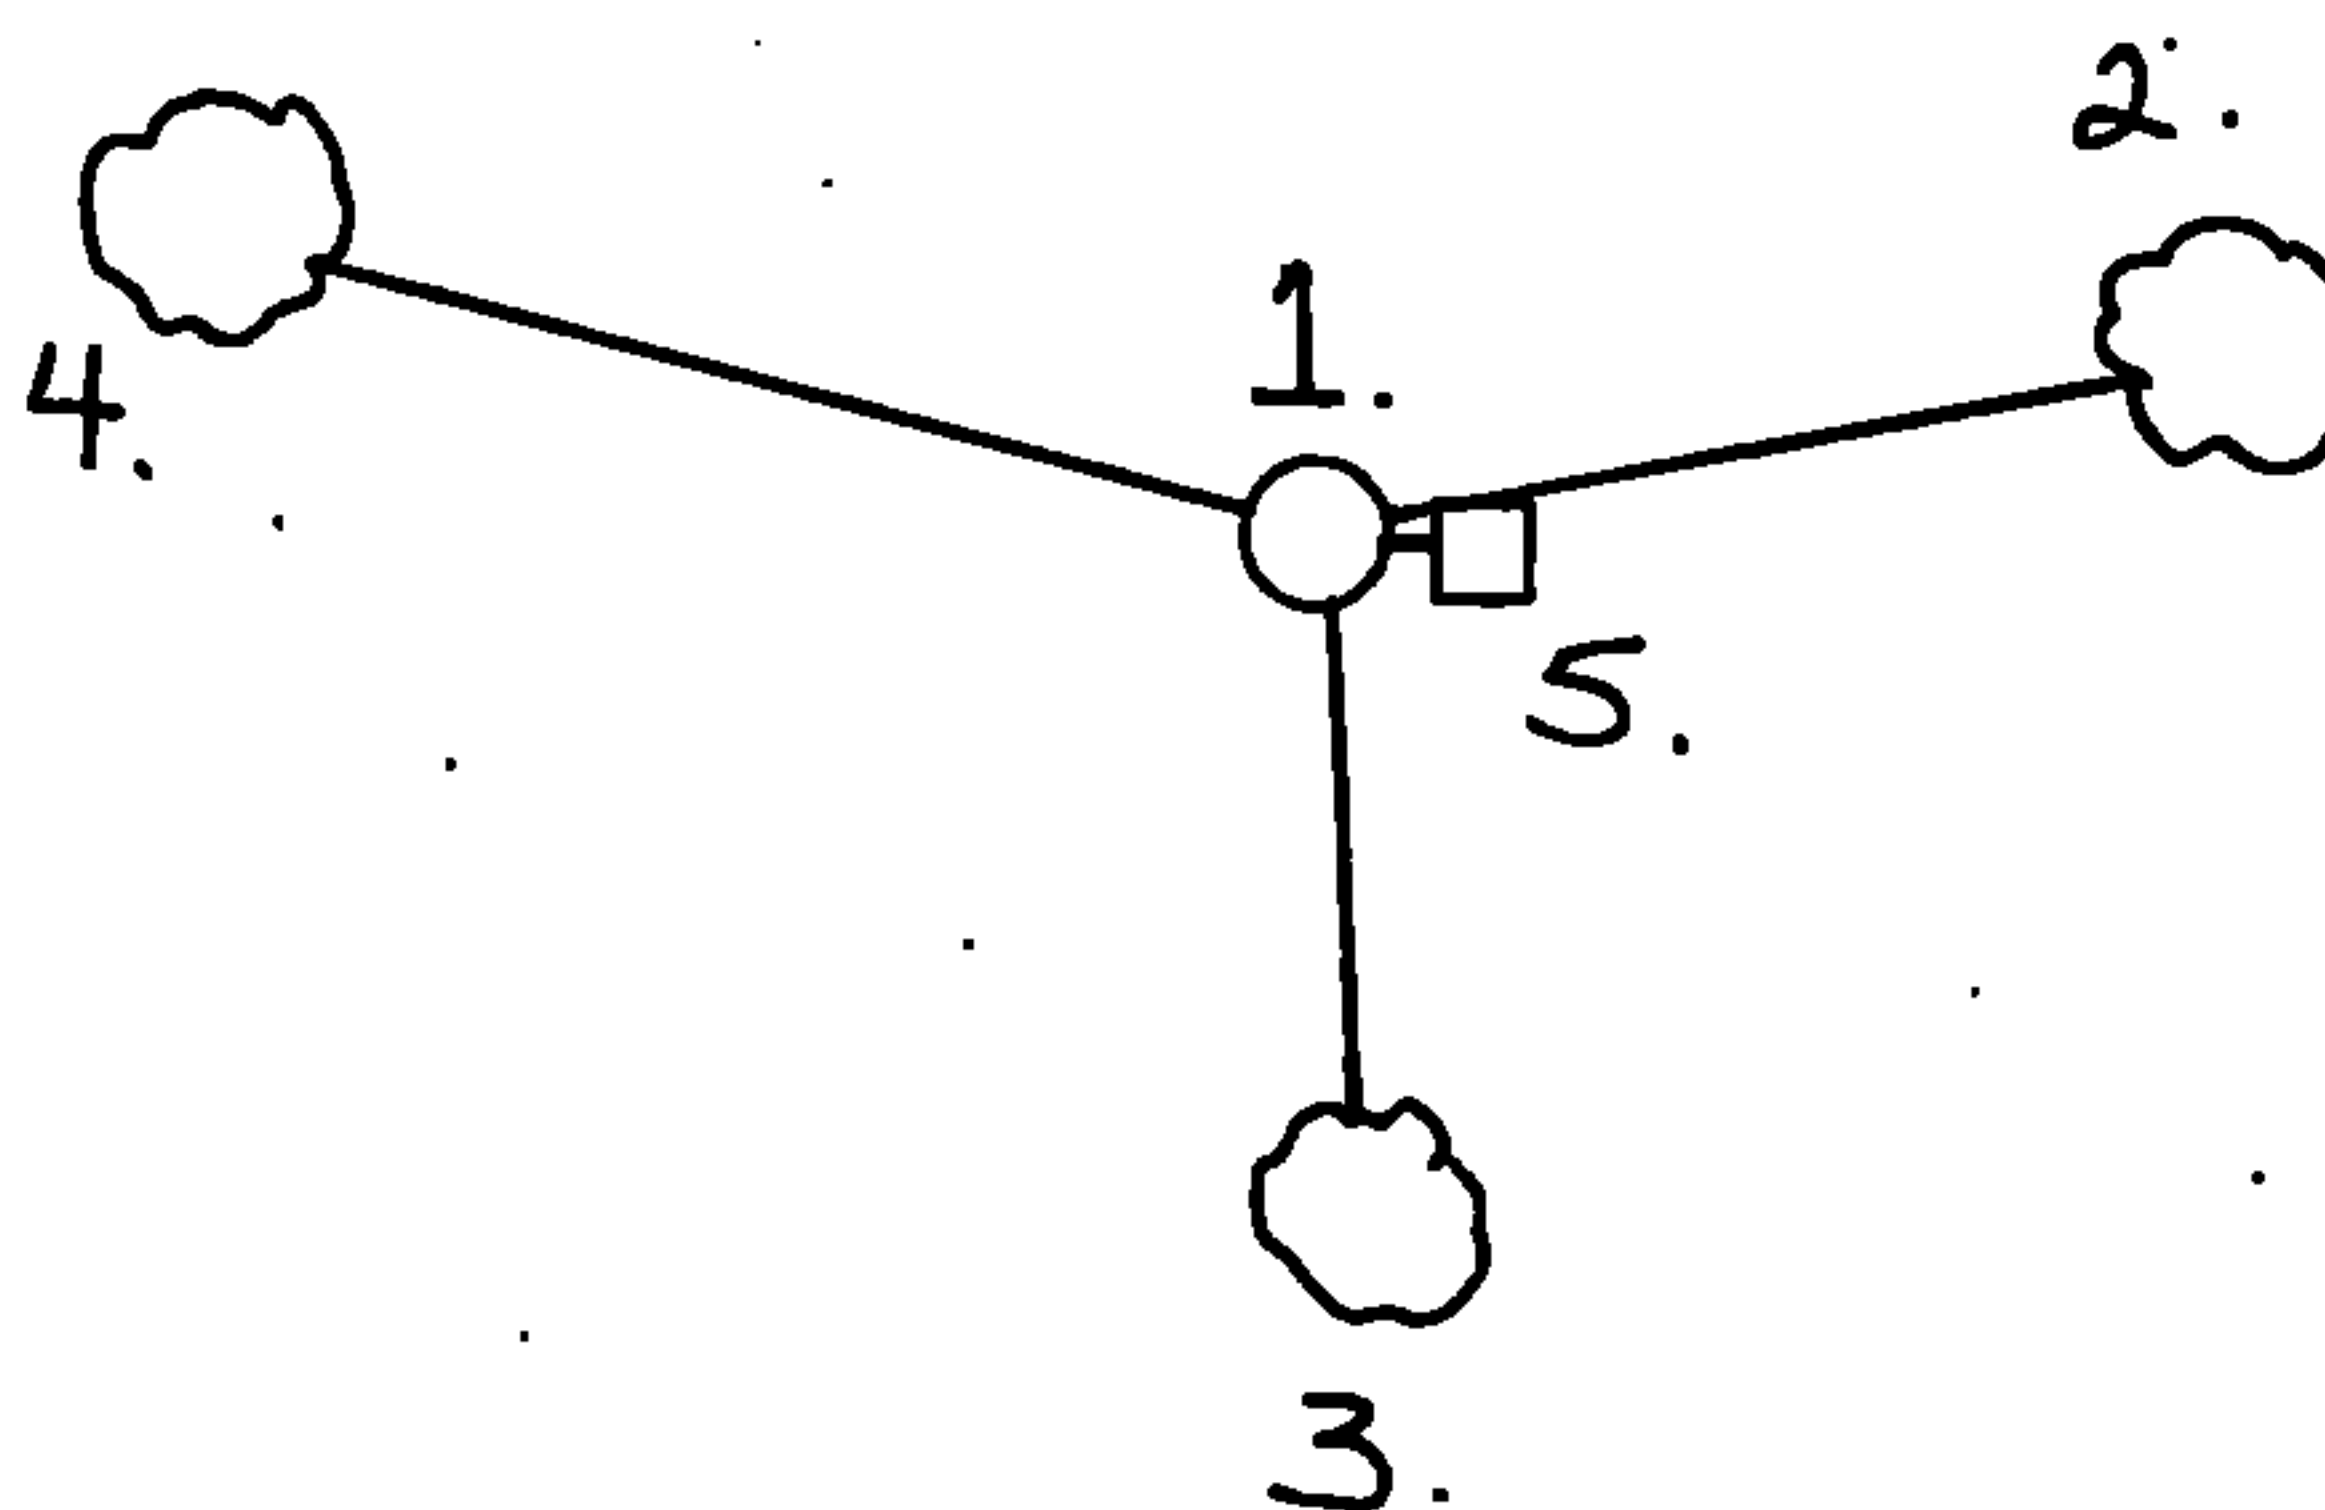

REGISTER'S OFFICE  
 Forest County, Wis.

Received for record this 8<sup>th</sup> day  
 of May A.D. 1991 at  
1:40 o'clock P.M. and recorded  
 in Vol. OWNER RESTORATIONS  
 page V-3.

Register of Deeds

Book 2, Page 46

43516300020

V-3

(a) Describe any material discrepancy between the location of the corner as restored or reestablished and the location of that corner as previously restored or reestablished by distance and direction. Show the discrepancy on the plan view drawing under (d), above. Show the distances between the corner as previously restored or reestablished and (1) the corner as restored or reestablished, and (2) to at least 2 of the witness monuments shown on the drawing in (d), above.

None.

(f) Was the corner restored through acceptance of (1) an obliterated evidence location, or, (2) a found perpetuated location?

(1) an obliterated evidence location

(g & h) Was the corner reestablished through lost corner proportionate methods? If so, show the method, including the directions and distances to other public land survey corners used as evidence or used for proportioning in determining the corner location?

None.

(1) I, Alan D. Harrison

(type or print name) certify that the corner location shown on this record was determined by me or under my direction and control and that this U.S. Public Land Survey Monument Record is correct and complete to the best of my knowledge and belief.

Alan D. Harrison 5/2/91  
Signature Date

CERTIFICATE READY FOR FILING:

Ale O Staege  
District Ranger

