

CERTIFIED LAND CORNER RESTORATION

Index No. **NI**


State of Wisconsin }
County of Forest } ss.

I, Philip T. Hansen, do hereby certify that on the 7th day of October, 1975, I found evidence of the Section corner of Sections 13, 18, 19, and 24 Township 36 North, Range 11 and 12 East, Fourth Principal Meridian, as described hereon; and that from this evidence I established a new monument and accessories as described hereon to perpetuate the original location of this corner.


Resident witnesses:

Glen Barker

Jim Claflin

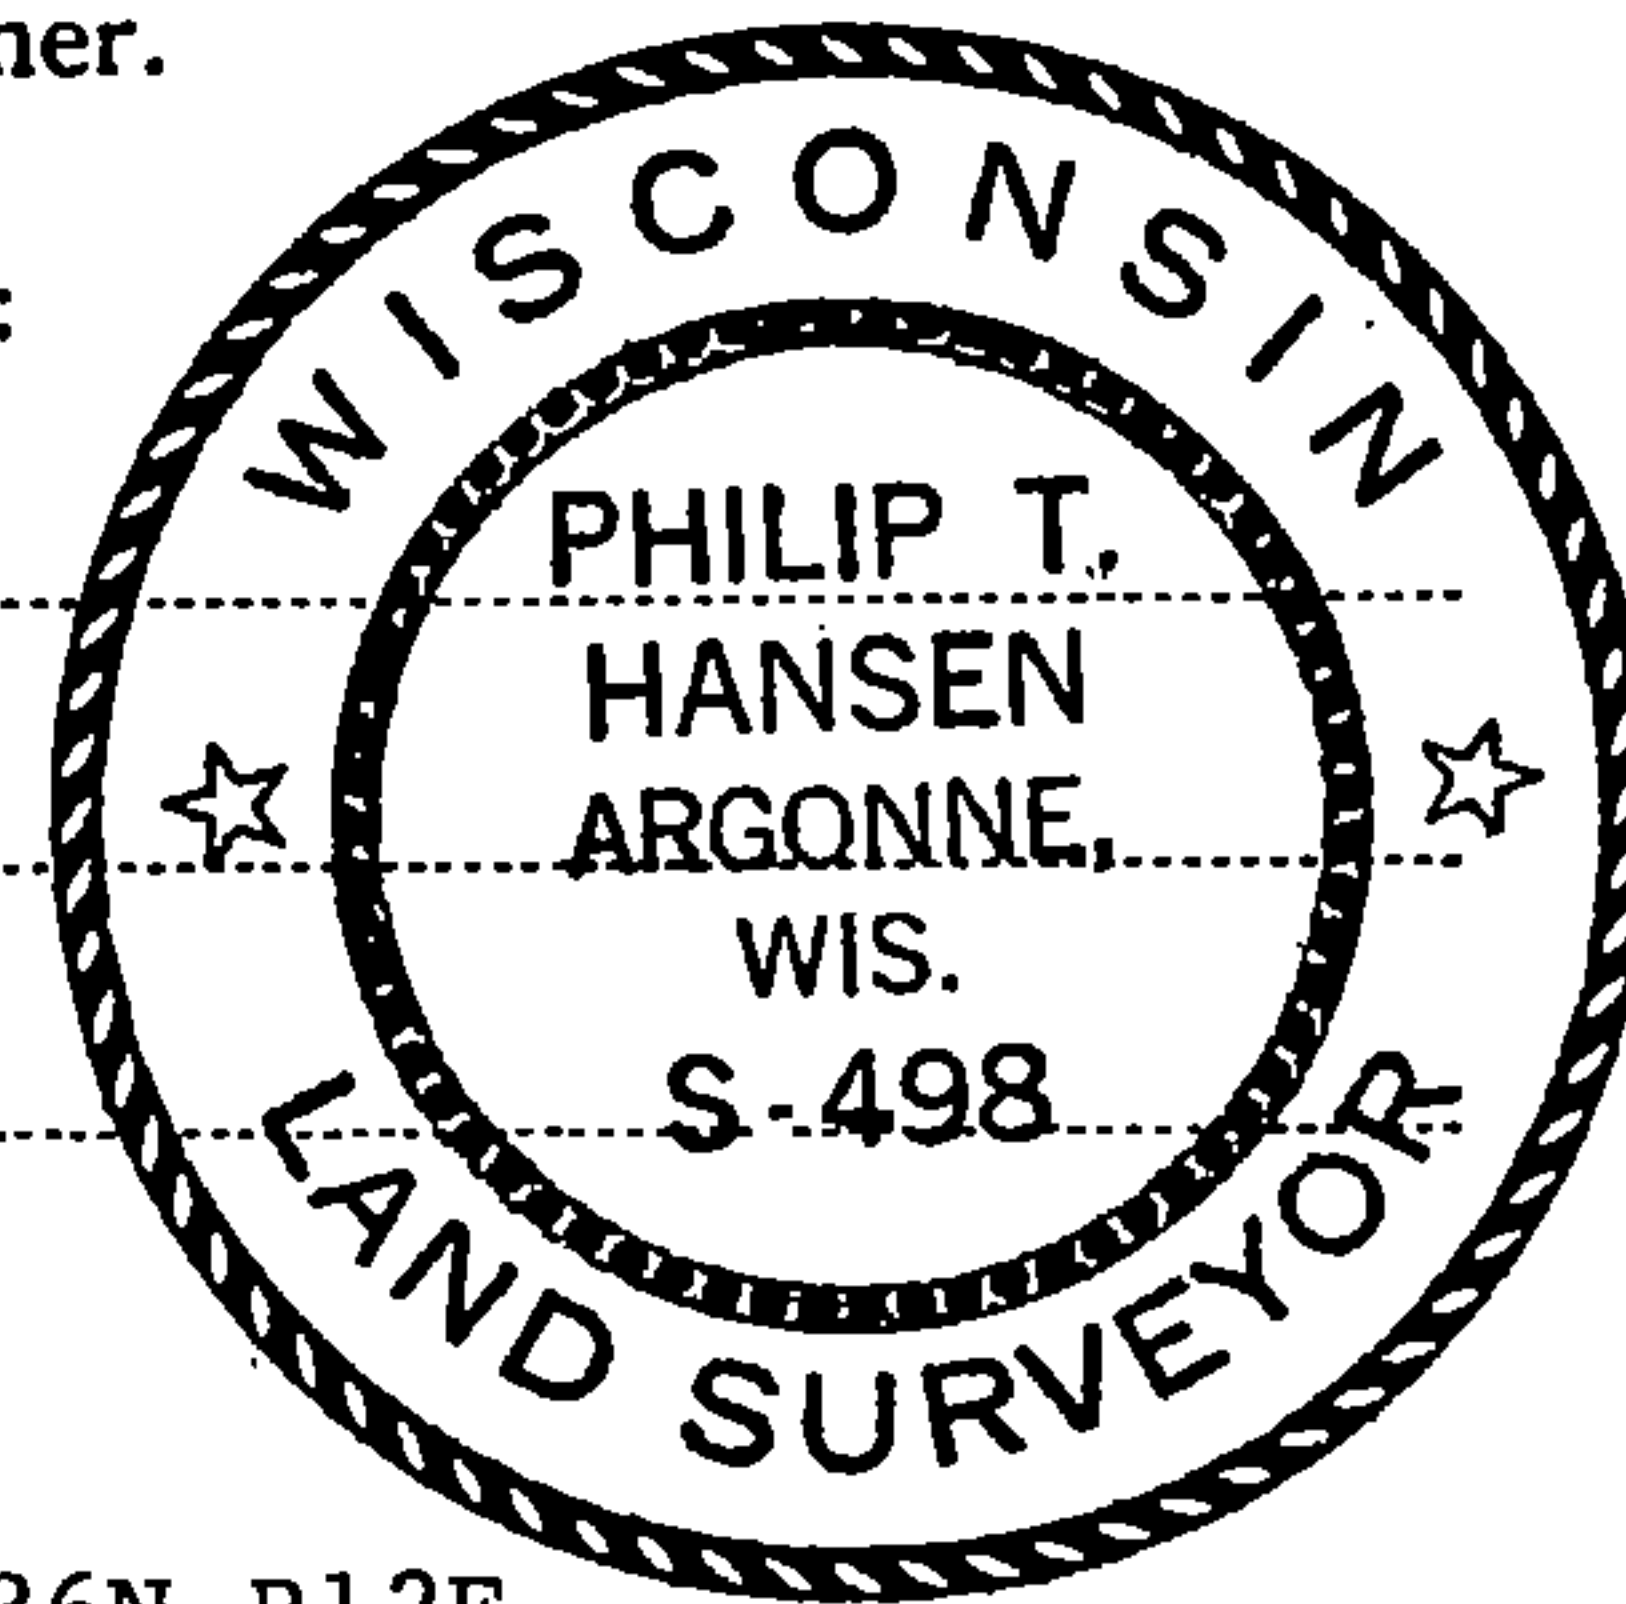

FORM 985 H. C. MILLER CO., MILWAUKEE

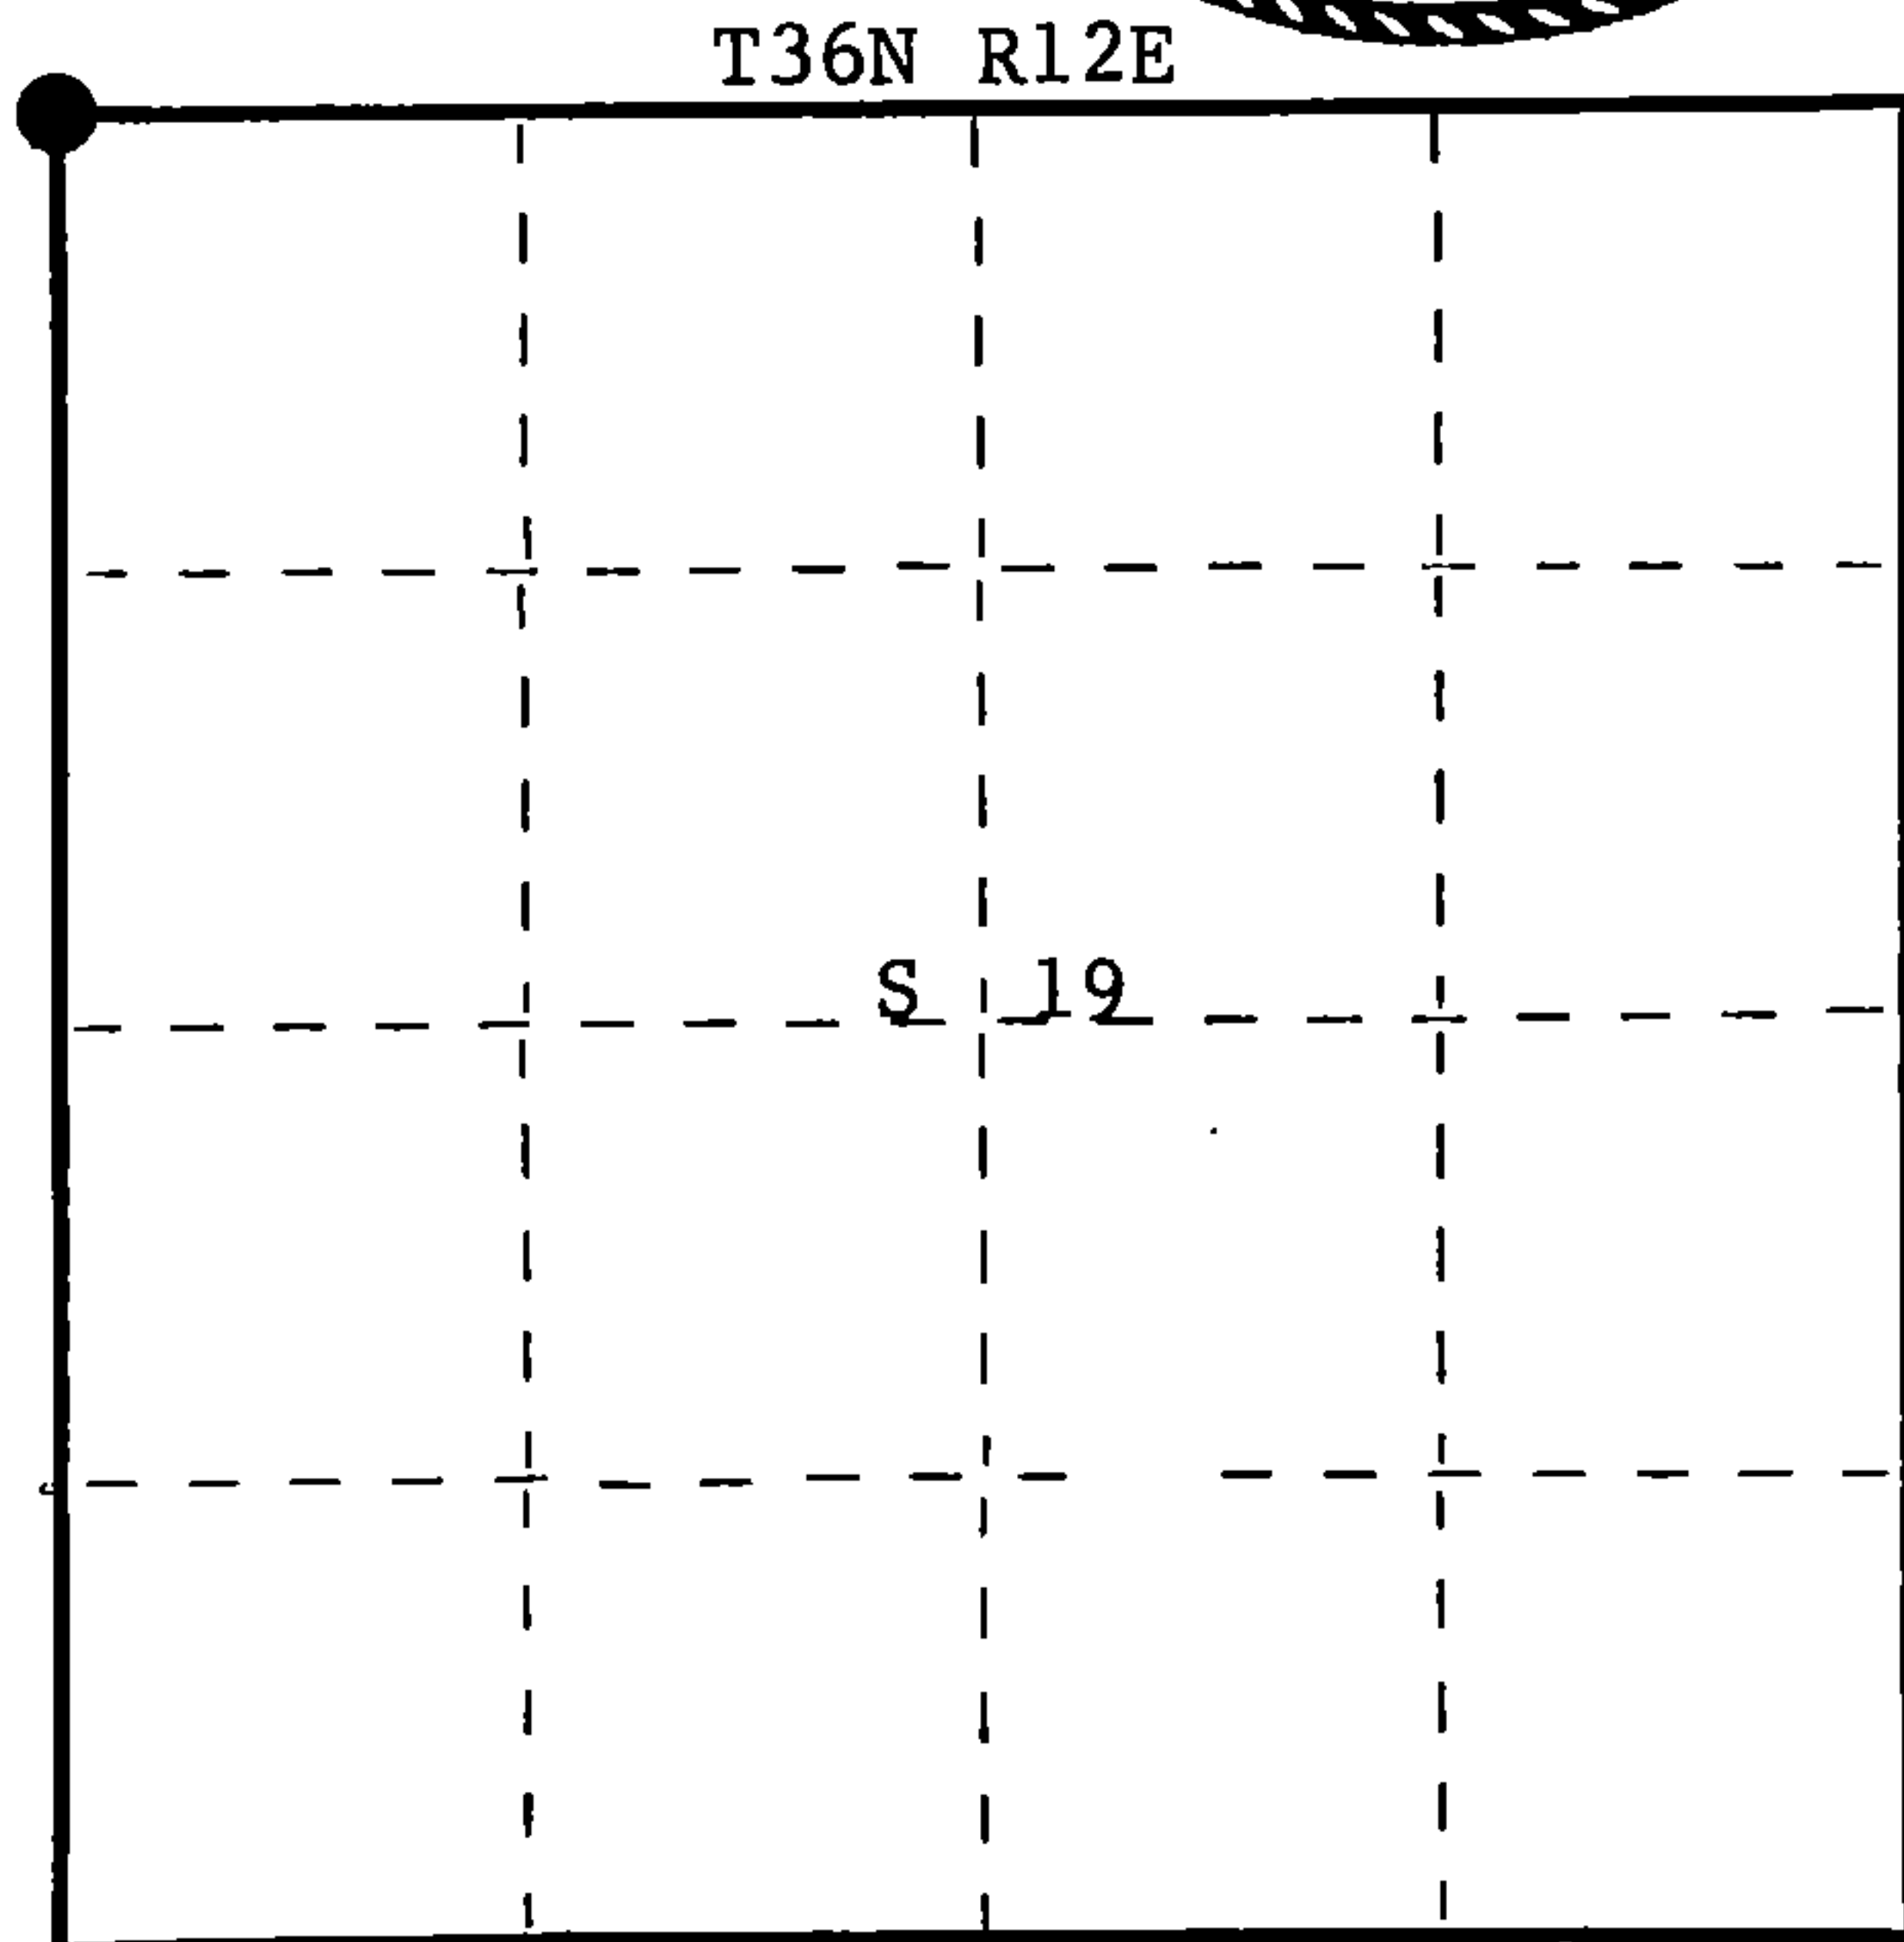

○ = Corner monument restored.

History of original corner establishment:

Original corner established by Alfred Millard, Government Deputy Surveyor, in 1858 from which white pine 10" bears N25°E, 18 links; white pine 12" bears N65°W, 49 links; and white pine 12" bears S40°W, 30 links.

Corner restored by H.C. Lawrence, Registered Land Surveyor, in 1950. Recovered OBT's:

White pine stump S40°W 30 links

White pine stump N25°E 18 links, with scribe marks.

Set new post from these BT's. A balsam 18" had been marked for BT but no notes were available for it. Rescribed balsam S16°E, 20 links.

Description of corner evidence found:

Recovered 5" tamarack post, squared and scribed S13 R11E, S24 T36N, S19, S18 R12E, in fair condition.

Recovered OBT's: Original white pine 12" S40°W 31 links - now a decayed stump.
Balsam 18" S16°E 20 links - scribing rotted out.

Description of monument and accessories I established to perpetuate the original location of this corner.

Replaced tamarack post with 2-1/2" Berntsen A-1 Federal Monument. Aluminum with magnet installed in cap and base, projecting 6" above ground, cap stamped -

S498
T36N

NBT's: B. spruce 6" S40°W 29.6 links - scribed SC BT.
B. spruce 6" N45°W 26.5 links - scribed SC BT.

R R
11 13 | 18 12
E 24 | 19 E

Post and BT's painted blue.

1975

Dated at Argonne, Wis., this 10th day of October, 1975

Signature: *Philip T. Hansen* Title Registered Land Surveyor Registration No. S-498
(County Surveyor, Registered Land Surveyor, or other duly authorized official)

Office of Register of Deeds, County of Forest, I hereby certify that the within instrument was filed in this office for record on the 16th day of October, 1975 at 2:30 o'clock P.M.

Eugene Staszny
(Register of Deeds)
By _____ Deputy

DOCUMENT NUMBER -- **107993**

436113000