

CERTIFIED LAND CORNER RESTORATION

Index No. C-4

State of Wisconsin }
County of Forest } ss.


I Philip T. Hansen, do hereby certify that on the 29th day of July, 1976, I found evidence of the EC 1/16 corner of Section 6 Township 36, North, Range 12 East, Fourth Principal Meridian, as described hereon; and that from this evidence I established a new monument and accessories as described hereon to perpetuate the original location of this corner.

Resident witnesses:


Glen Barker

Jim Claflin

Herb Wagoner

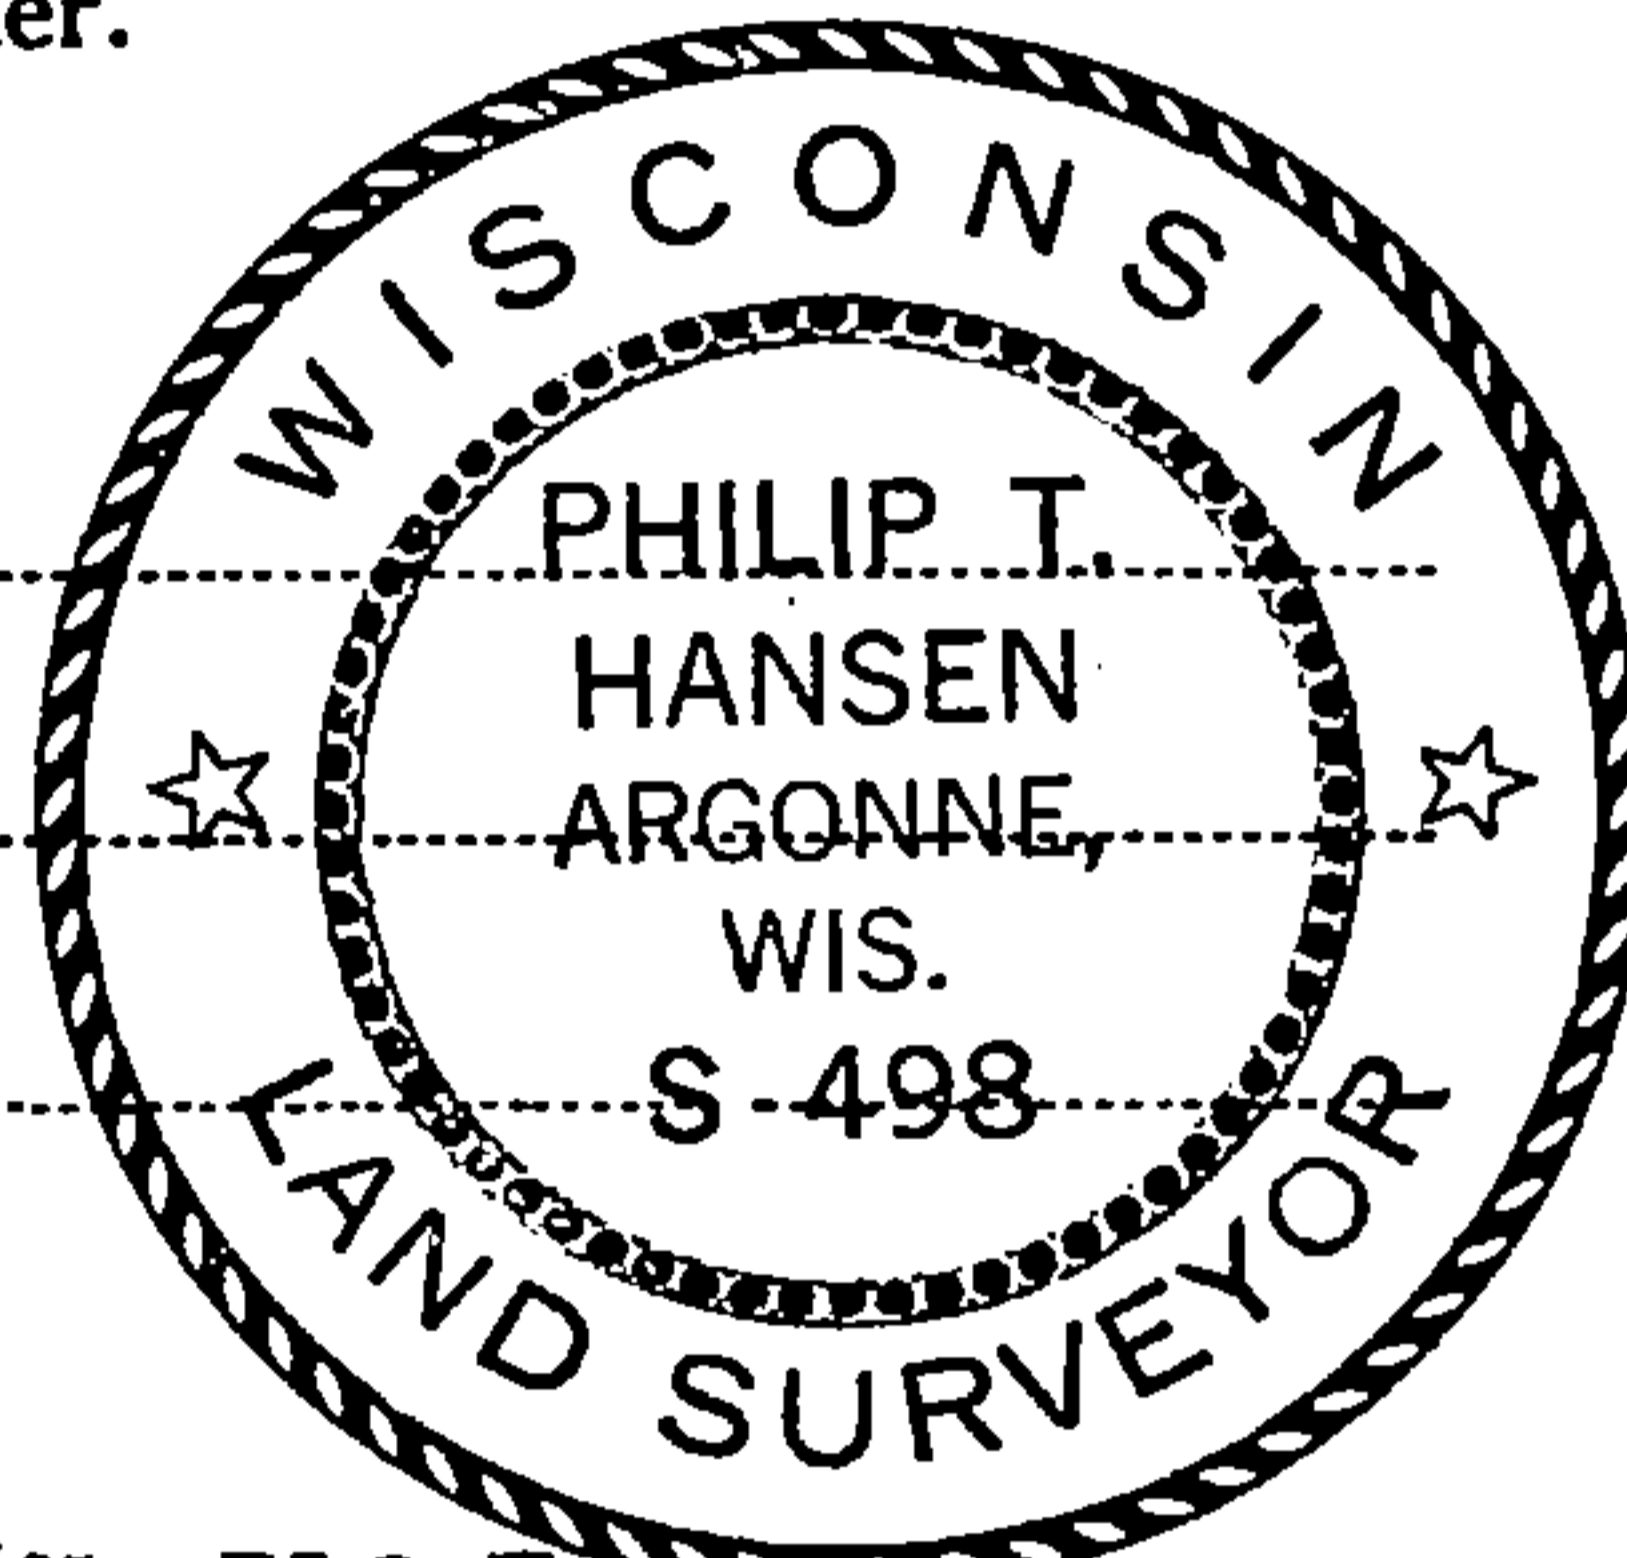

T36N R12 E

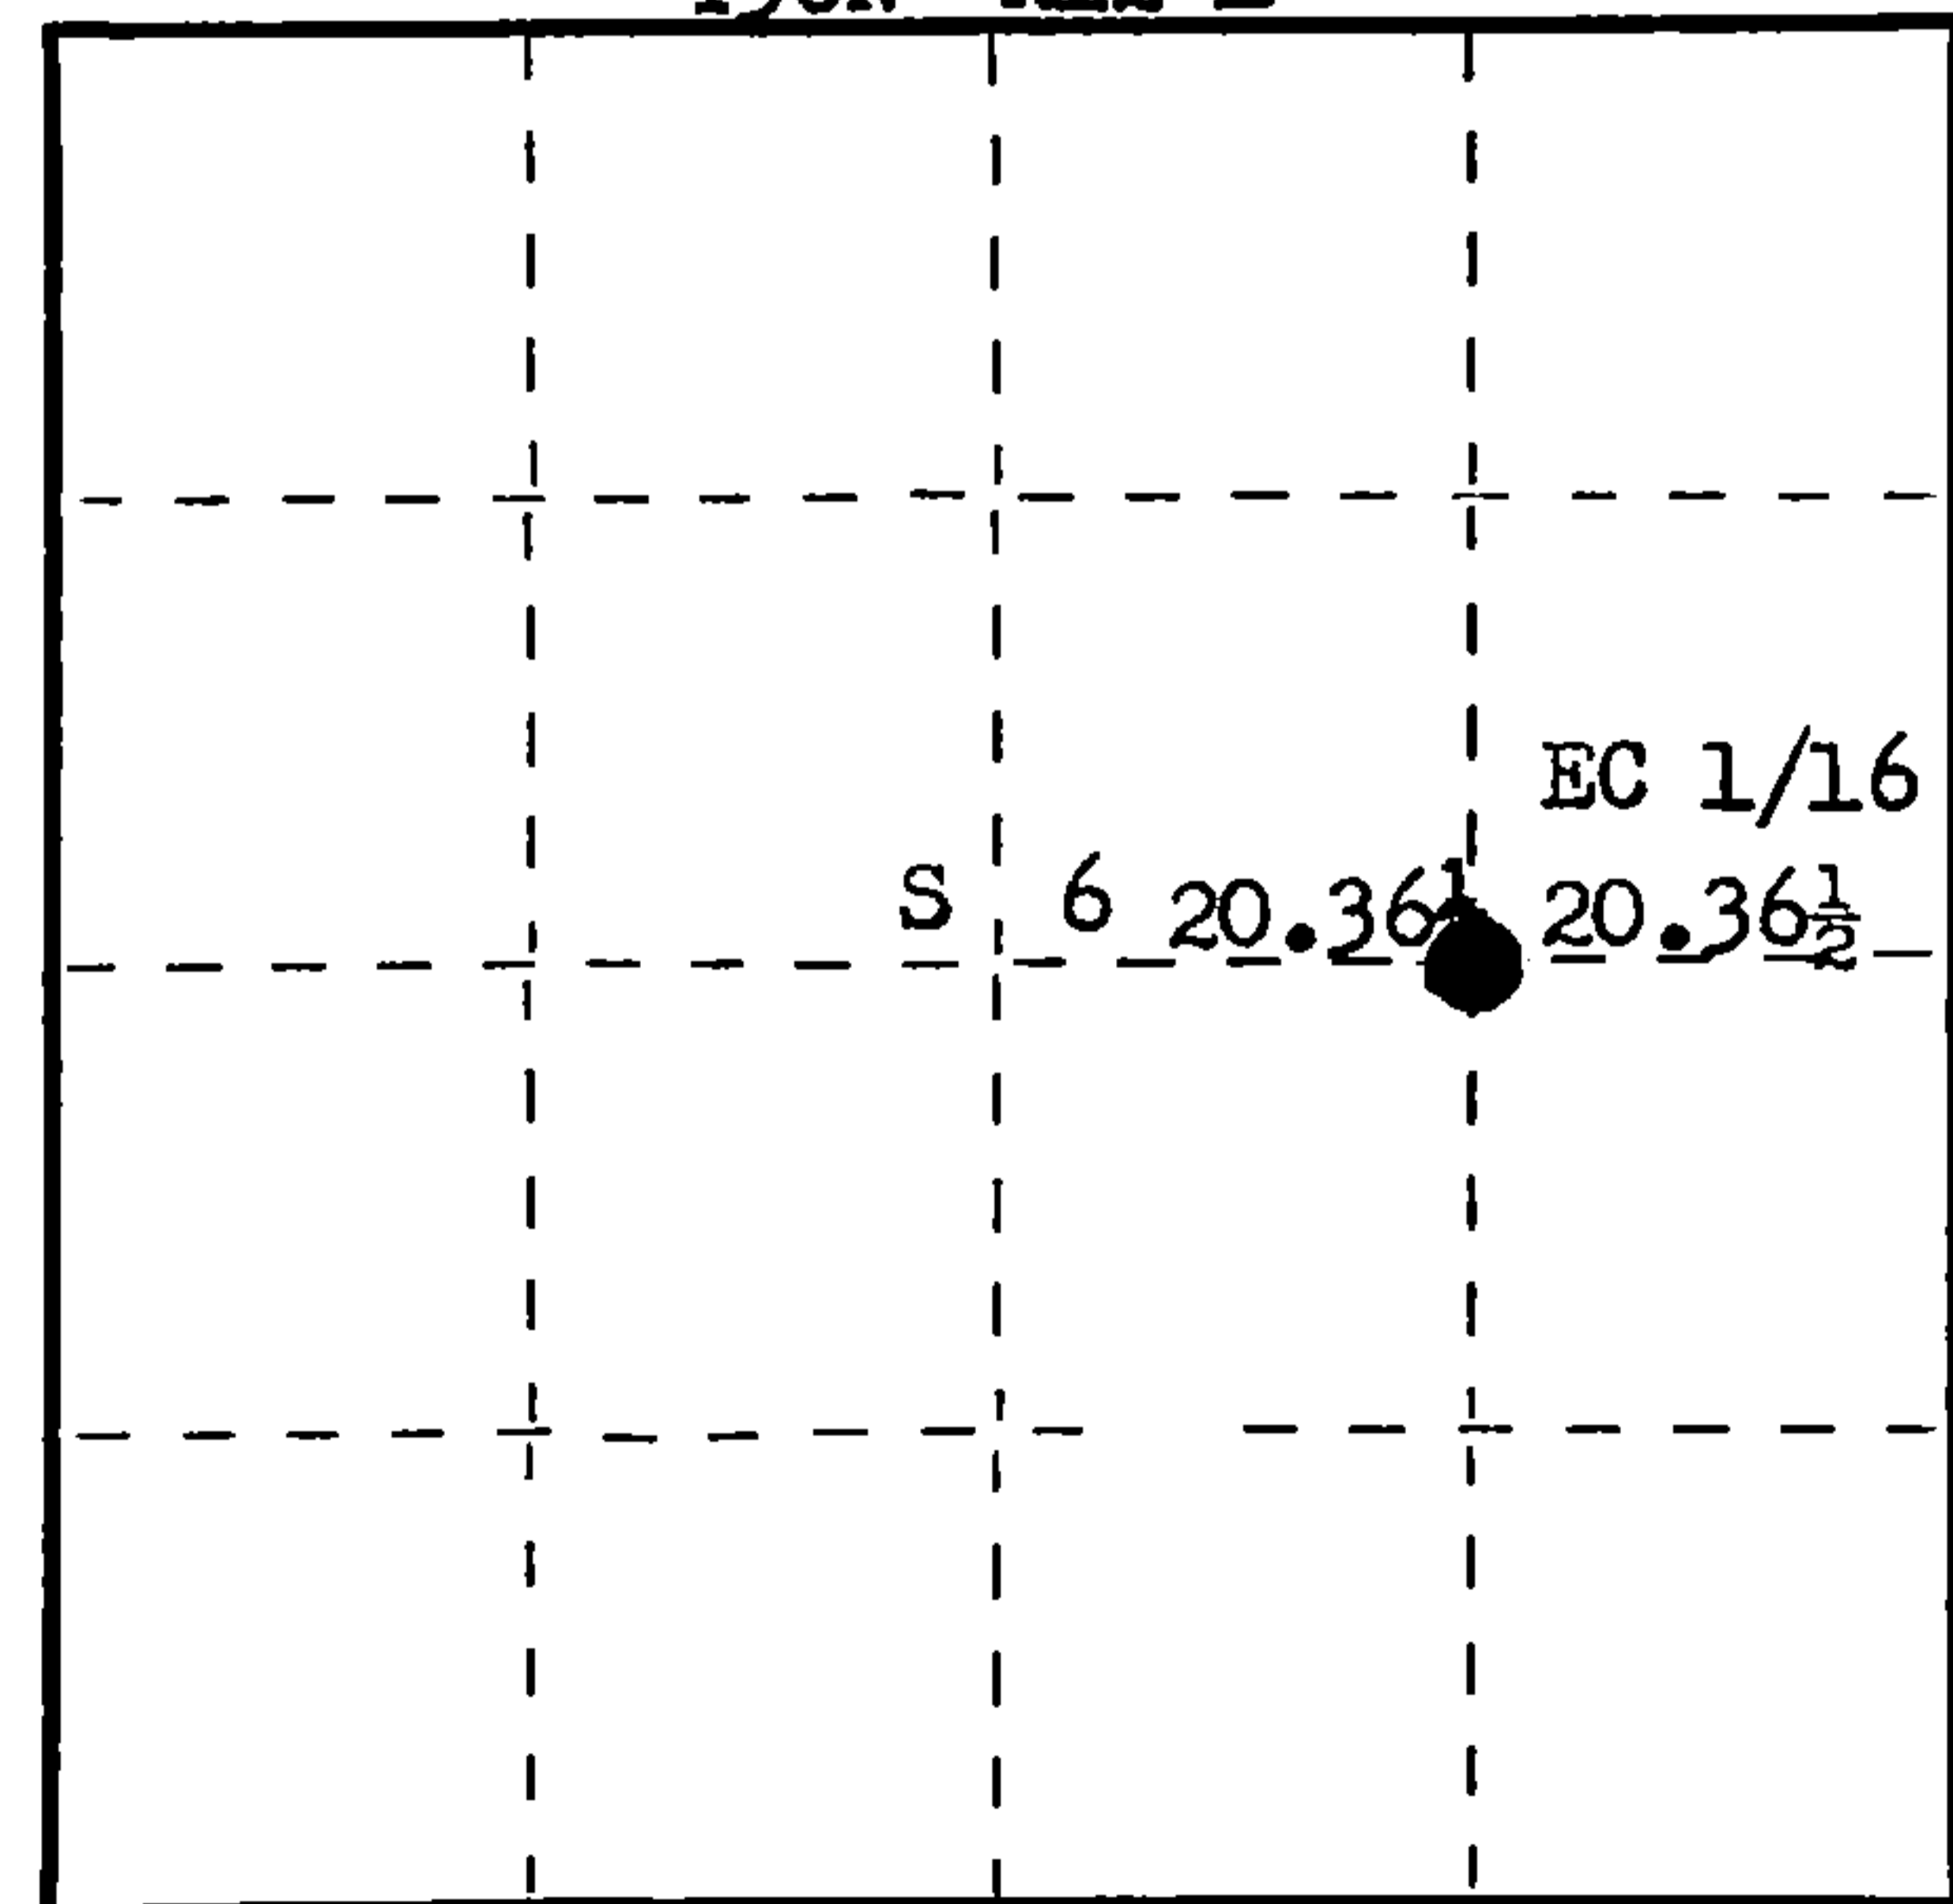

○ = Corner monument restored.

History of original corner establishment:

Corner established by H.C. Lawrence, Registered Land Surveyor, in 1956.

Set 4" cedar post on line between C 1/4 and E 1/4 equidistant 20.36 $\frac{1}{2}$ chs.

No BTs were marked.

Description of corner evidence found:

Recovered 4" cedar post, squared and scribed EC 1/16 S6, EC 1/16 S6 in fair condition.

No BTs recovered.

Description of monument and accessories I established to perpetuate the original location of this corner.

Replaced 4" cedar post with 1 $\frac{1}{2}$ " iron pipe with 2" brass cap stamped.

Monument projects 24" above ground.

NBT - Cedar 8" N 68° W 36.1 lks, scribed 1/16 BT.

Cedar 8" S 44° W 40.7 lks, scribed 1/16 BT.

S498
T36N R12E
EC 1/16 S 6
CPI-1976

Monument and BTs painted blue.

Dated at Rhineland, Wis., this 17th day of August, 1976

Signature Philip T. Hansen Title Registered Land Surveyor Registration No. S-498
(County Surveyor, Registered Land Surveyor, or other duly authorized official)

Office of Register of Deeds, County of Oneida, I hereby certify that the within instrument was filed in this office for record on the 8th day of September, 1976 at 10 o'clock A. M.

Eugene Staszny
(Register of Deeds)

By _____ Deputy

DOCUMENT NUMBER
110107

FORM 985 H. C. MILLER CO., MILWAUKEE

43612061010