

CERTIFIED LAND CORNER RESTORATION

Index No. V-1


State of Wisconsin }  
County of Forest } ss.

I William B. Cochrane, do hereby certify that on the 28 th day of September, 19 80, I found evidence of the Northwest Section corner of Section 31 Township 36, North, Range 13 East, Fourth Principal Meridian, as described hereon; and that from this evidence I established a new monument and accessories as described hereon to perpetuate the original location of this corner.

Resident witnesses:

Miles H. Cochrane

Dennis E. Statezny

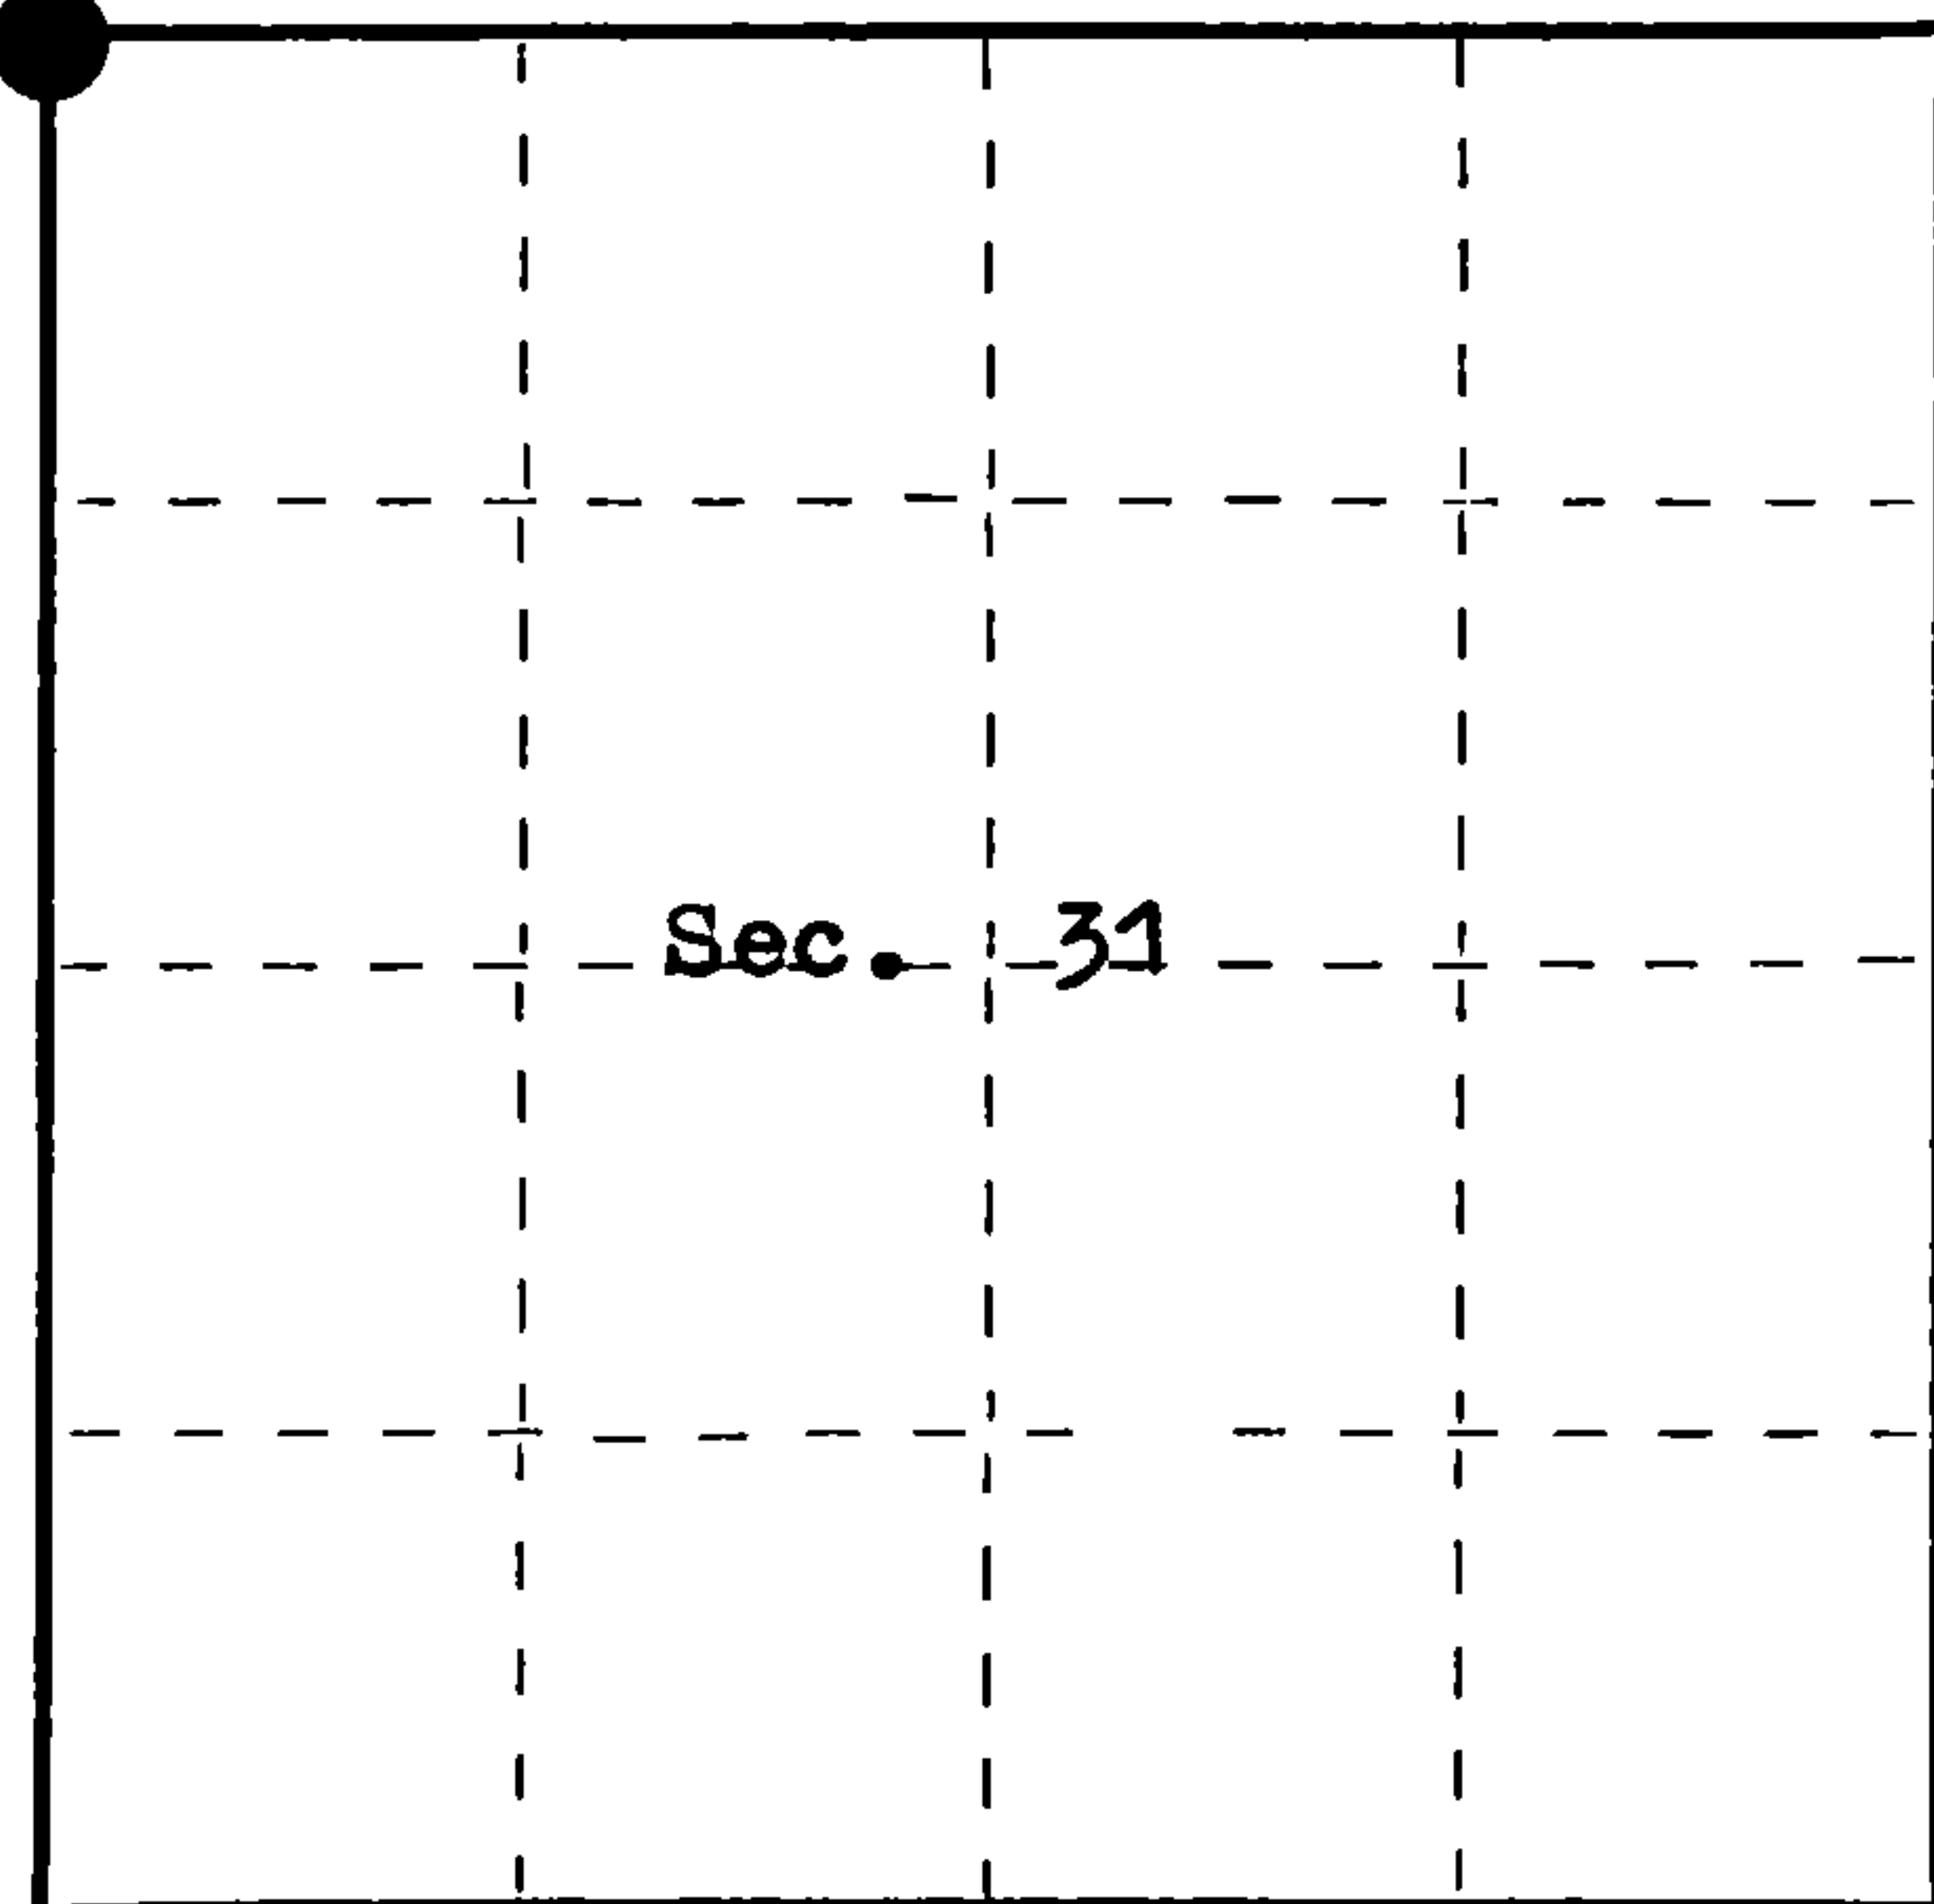

○ = Corner monument restored.

History of original corner establishment:

**Surveyed in 1858**

North between sections 31 and 36. 80.00 chains set post corner of Sections 25, 30, 31, and 36, Ranges 12 and 13 East

- Sugar, 18", N 28° E, 32 links
- Lynn, 10", N 50° W, 40 links
- Ironwood, 10", S 60° W, 34 links
- Ironwood, 10", S 45° E, 16 links

Description of corner evidence found:

North-South gravel road and "T" road West.  
Iron pipe buried below the road surface.  
No original evidence was found.


This position was tied into the subdivision of section 31 and found to agree with other measurements.

Description of monument and accessories I established to perpetuate the original location of this corner.

I set a reference monument N 36° W, 42.58 feet from the corner.  
The reference monument is a 2½ inch diameter aluminum pipe, 30 inches long, with a Forest County aluminum cap stamped:

**T36N, R12E, R13E, S25, S30, S31, S36, 1980, S-1107, REFERENCE MONUMENT**

- A power pole #3612-25R2, bears N 54° W, 40.96 feet from the corner
- A power pole #3613-30L3, bears N 43° E, 25.01 feet from the corner

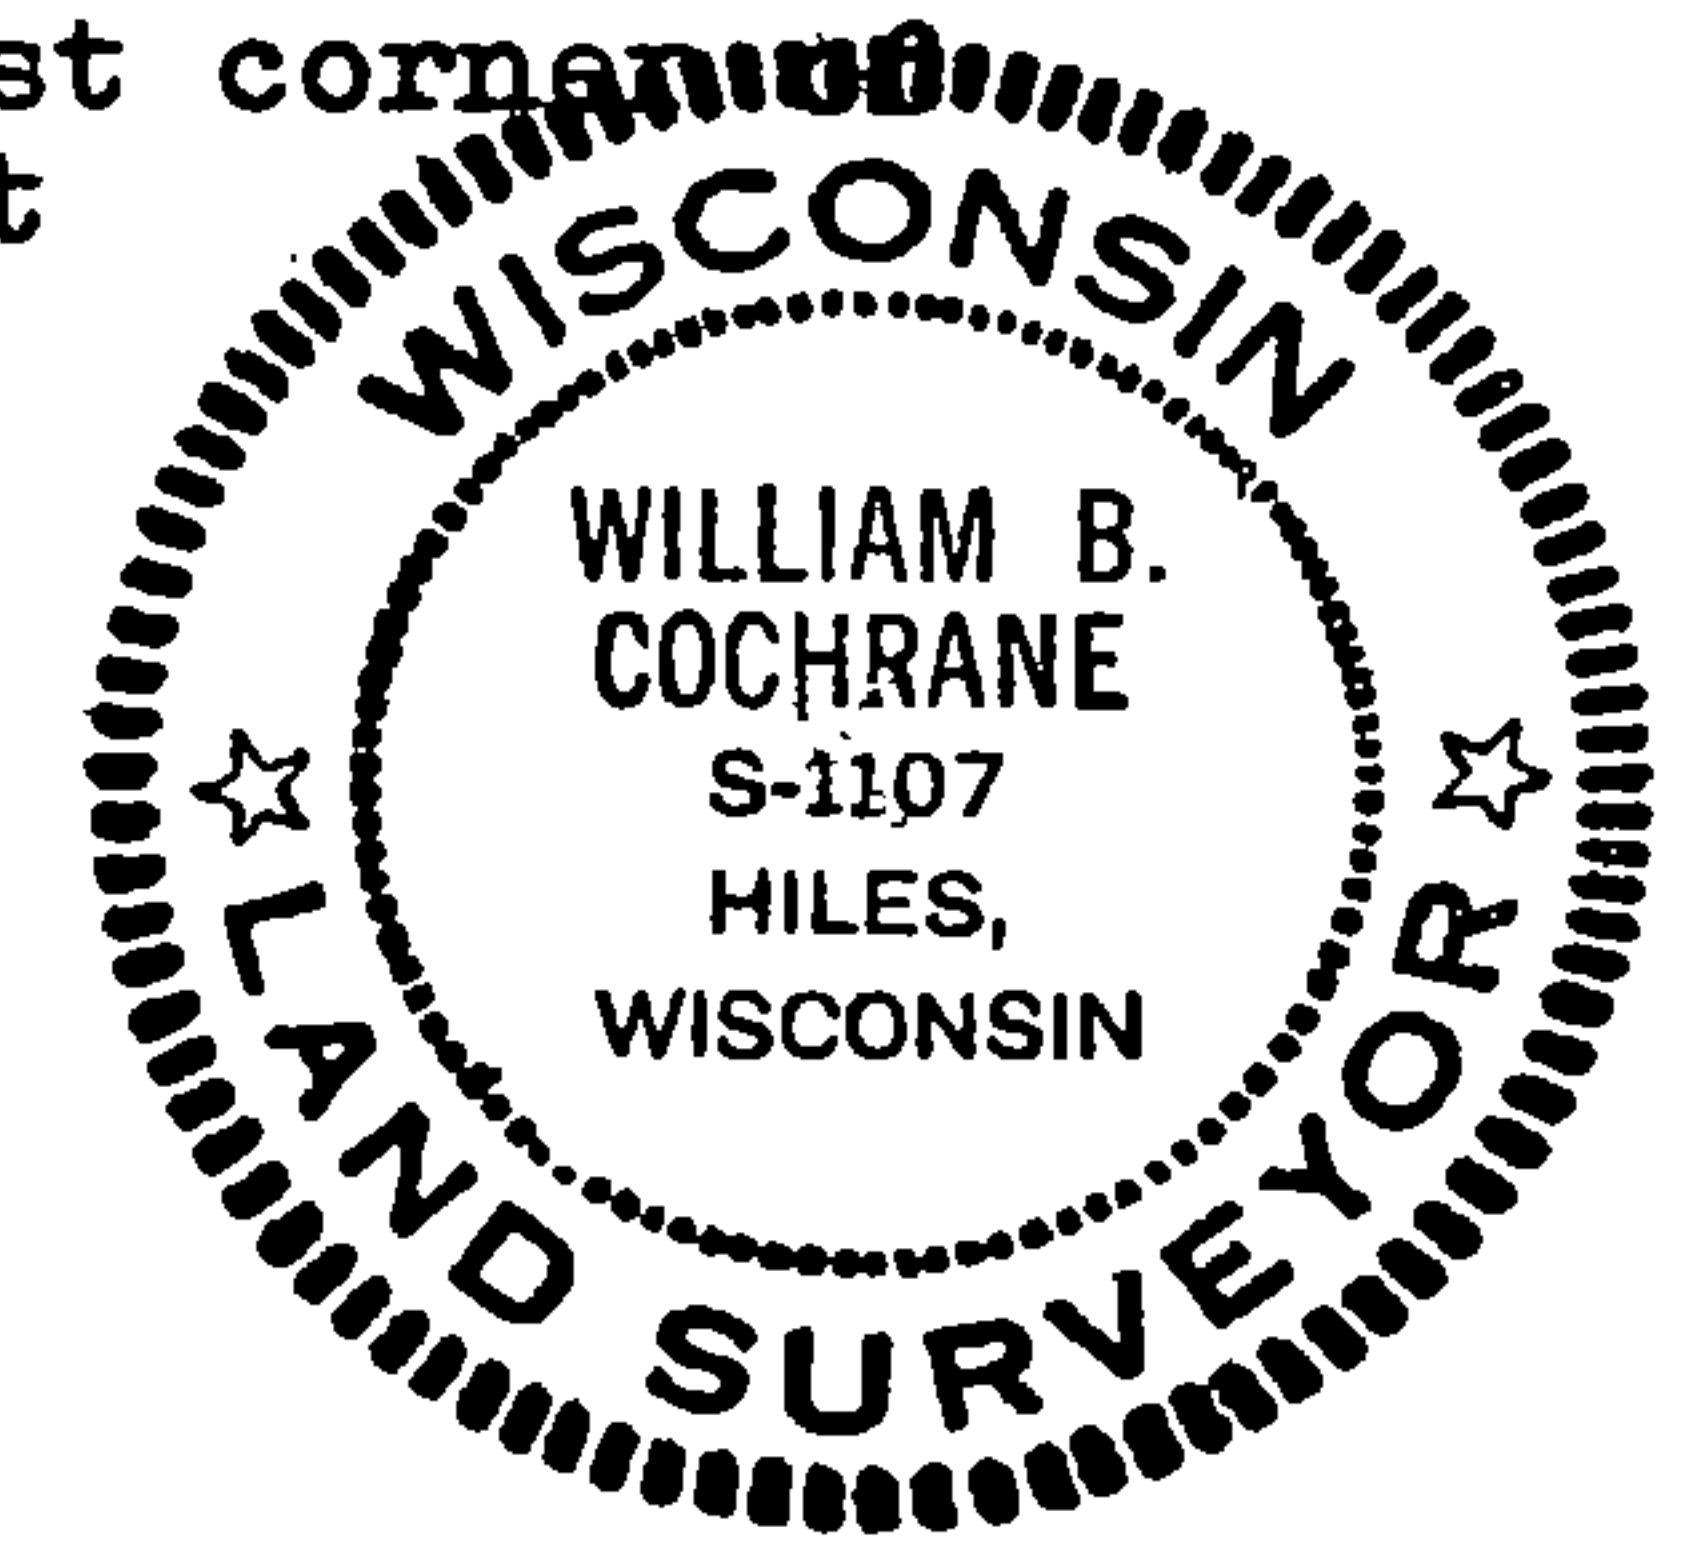

43612-25 0000

Dated at Hiles, Wis., this 8 th day of December 8, 19 80.

Signature William B. Cochrane Title Land Surveyor Registration No. S-1107  
(County Surveyor, Registered Land Surveyor, or other duly authorized official)

Office of Register of Deeds, County of Forest, I hereby certify that the within instrument was filed in this office for record on the 19 th day of December, 19 80 at 11:30 o'clock A. M.

Eugene Statezny  
(Register of Deeds)

DOCUMENT NO. **119136**

By \_\_\_\_\_ Deputy