

CERTIFIED LAND CORNER RESTORATION

Index No. V-20

State of Wisconsin }
County of Forest } ss.


History of original corner establishment:
No records of any previous survey.

I Philip T. Hansen, do hereby certify that on the 4th day of August, 19 77, I ~~found~~ established ~~the~~ E 1/16 corner of Section 26 & 35 Township 36, North, Range 12 East, Fourth Principal Meridian, as described hereon; and that from this evidence I established a new monument and accessories as described hereon to perpetuate the original location of this corner.

Description of corner evidence found:
No evidence of any corner was recovered. Corner set by traverse and computation.
Ran traverse between previously established 1/4 corner between Section 26/35 and Section Corner 25, 26, 36, 35. Computed distance 37.251 chains. Set E 1/16 at 18.6255 chains intermediate.

Resident witnesses:


Glen Barker
Jim Claflin
Herb Wagoner

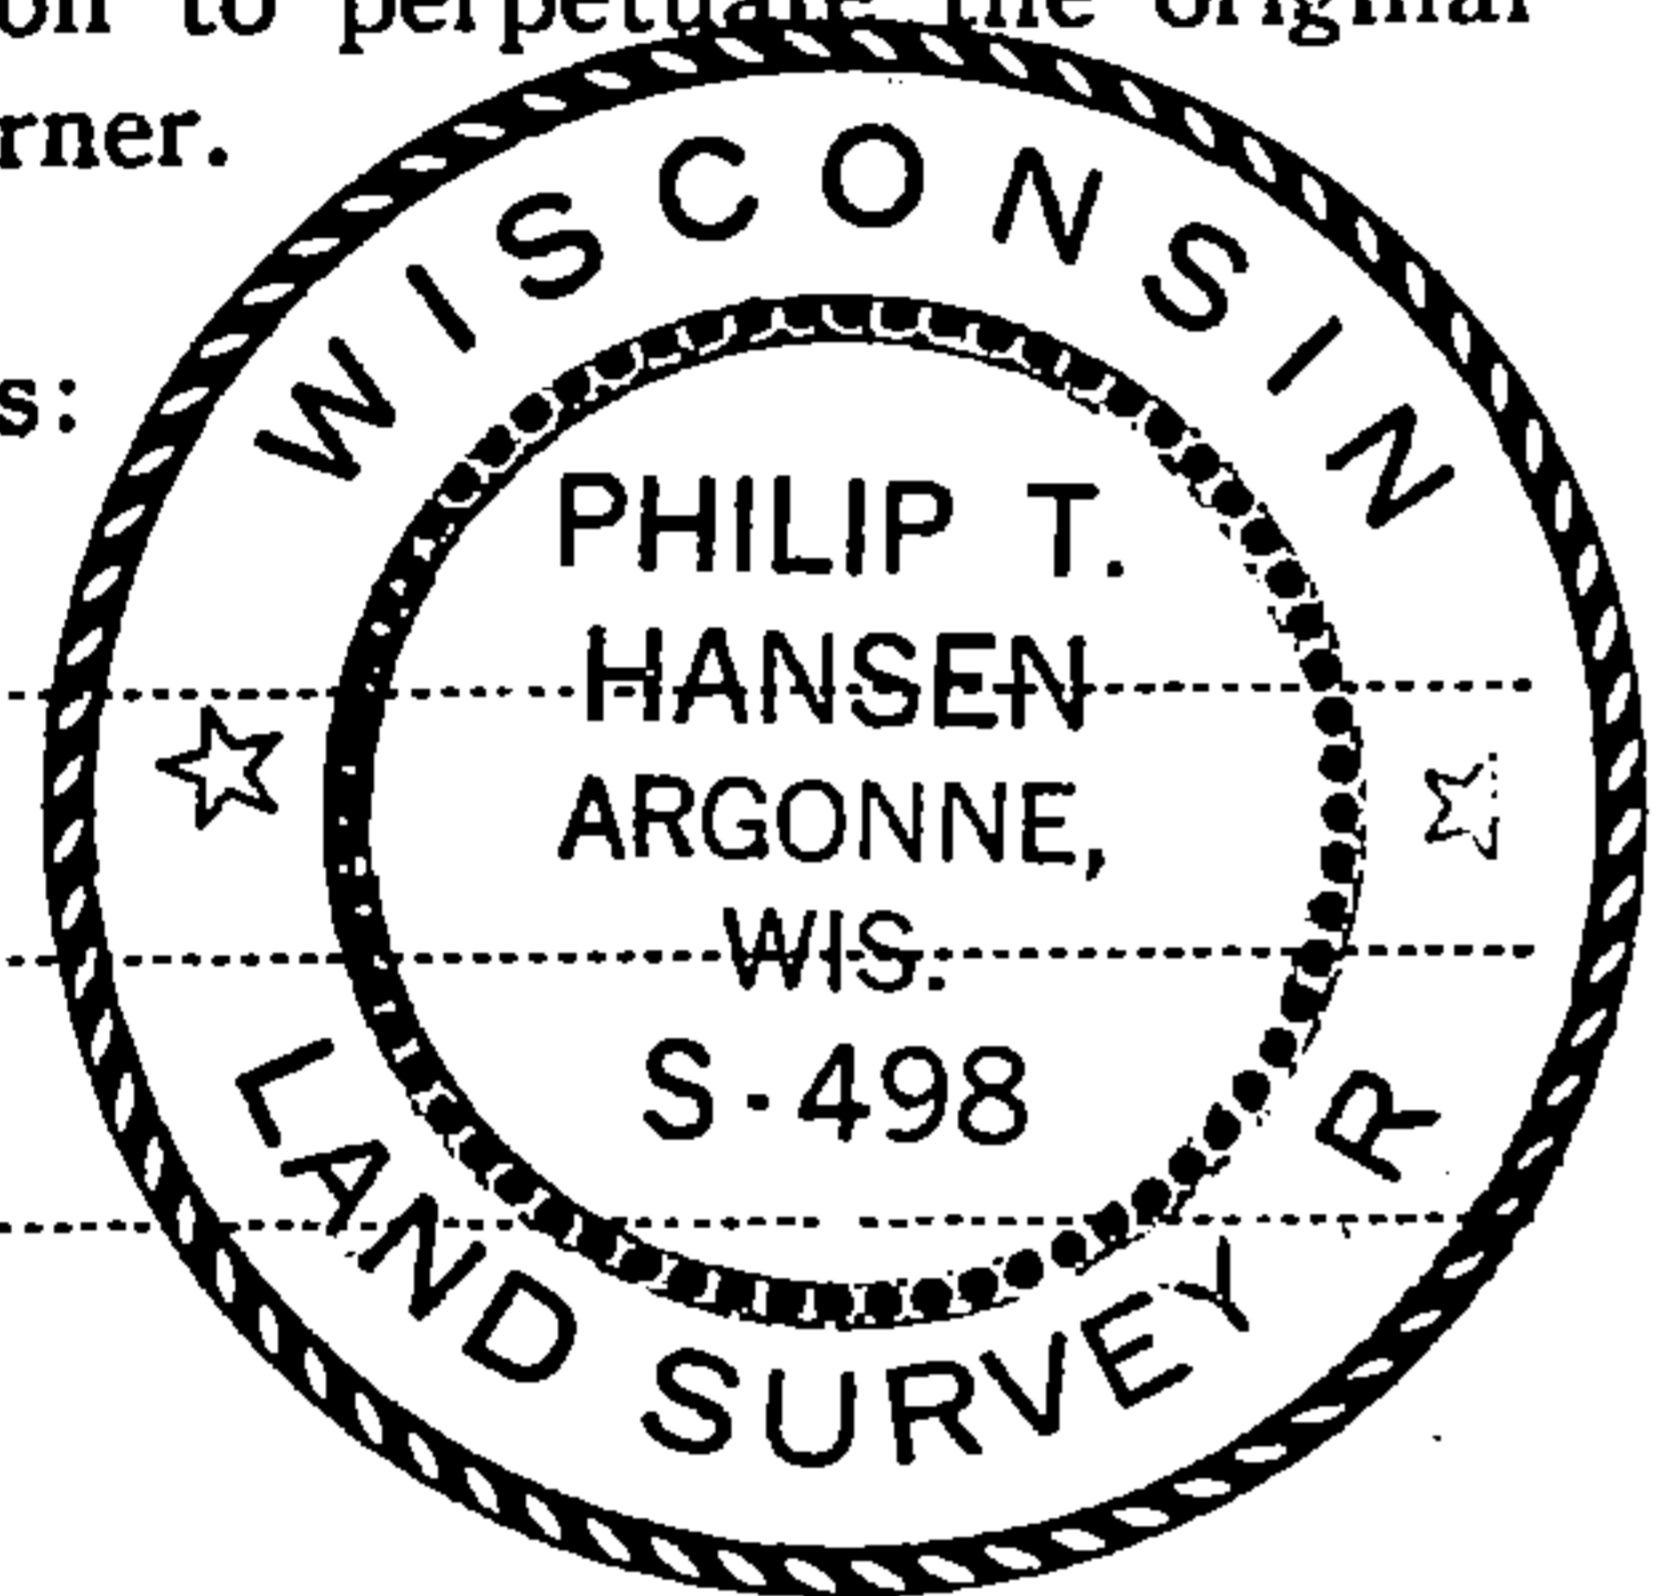

Description of monument and accessories I established to perpetuate the original location of this corner.
Set 1 1/2" x 18" iron rod in centerline of Kendal Road, 5" below surface.
Set 1 1/2" iron pipe with 2" brass cap for Witness Corner, 55 links north of true corner. Monument projects 18" above ground. Cap stamped:
Marked NBTs from true corner.
Sugar 8" S12°E, 62.5 links, scribed 1/16 BT.
Sugar 14" S20°W, 44.6 links, scribed 1/16 BT.

S498
T36N R12E
E 1/16 S 26
S 35 W.C.
S - 55 lks.
CPI - 1977

FORM 985 H. C. MILLER CO., MILWAUKEE

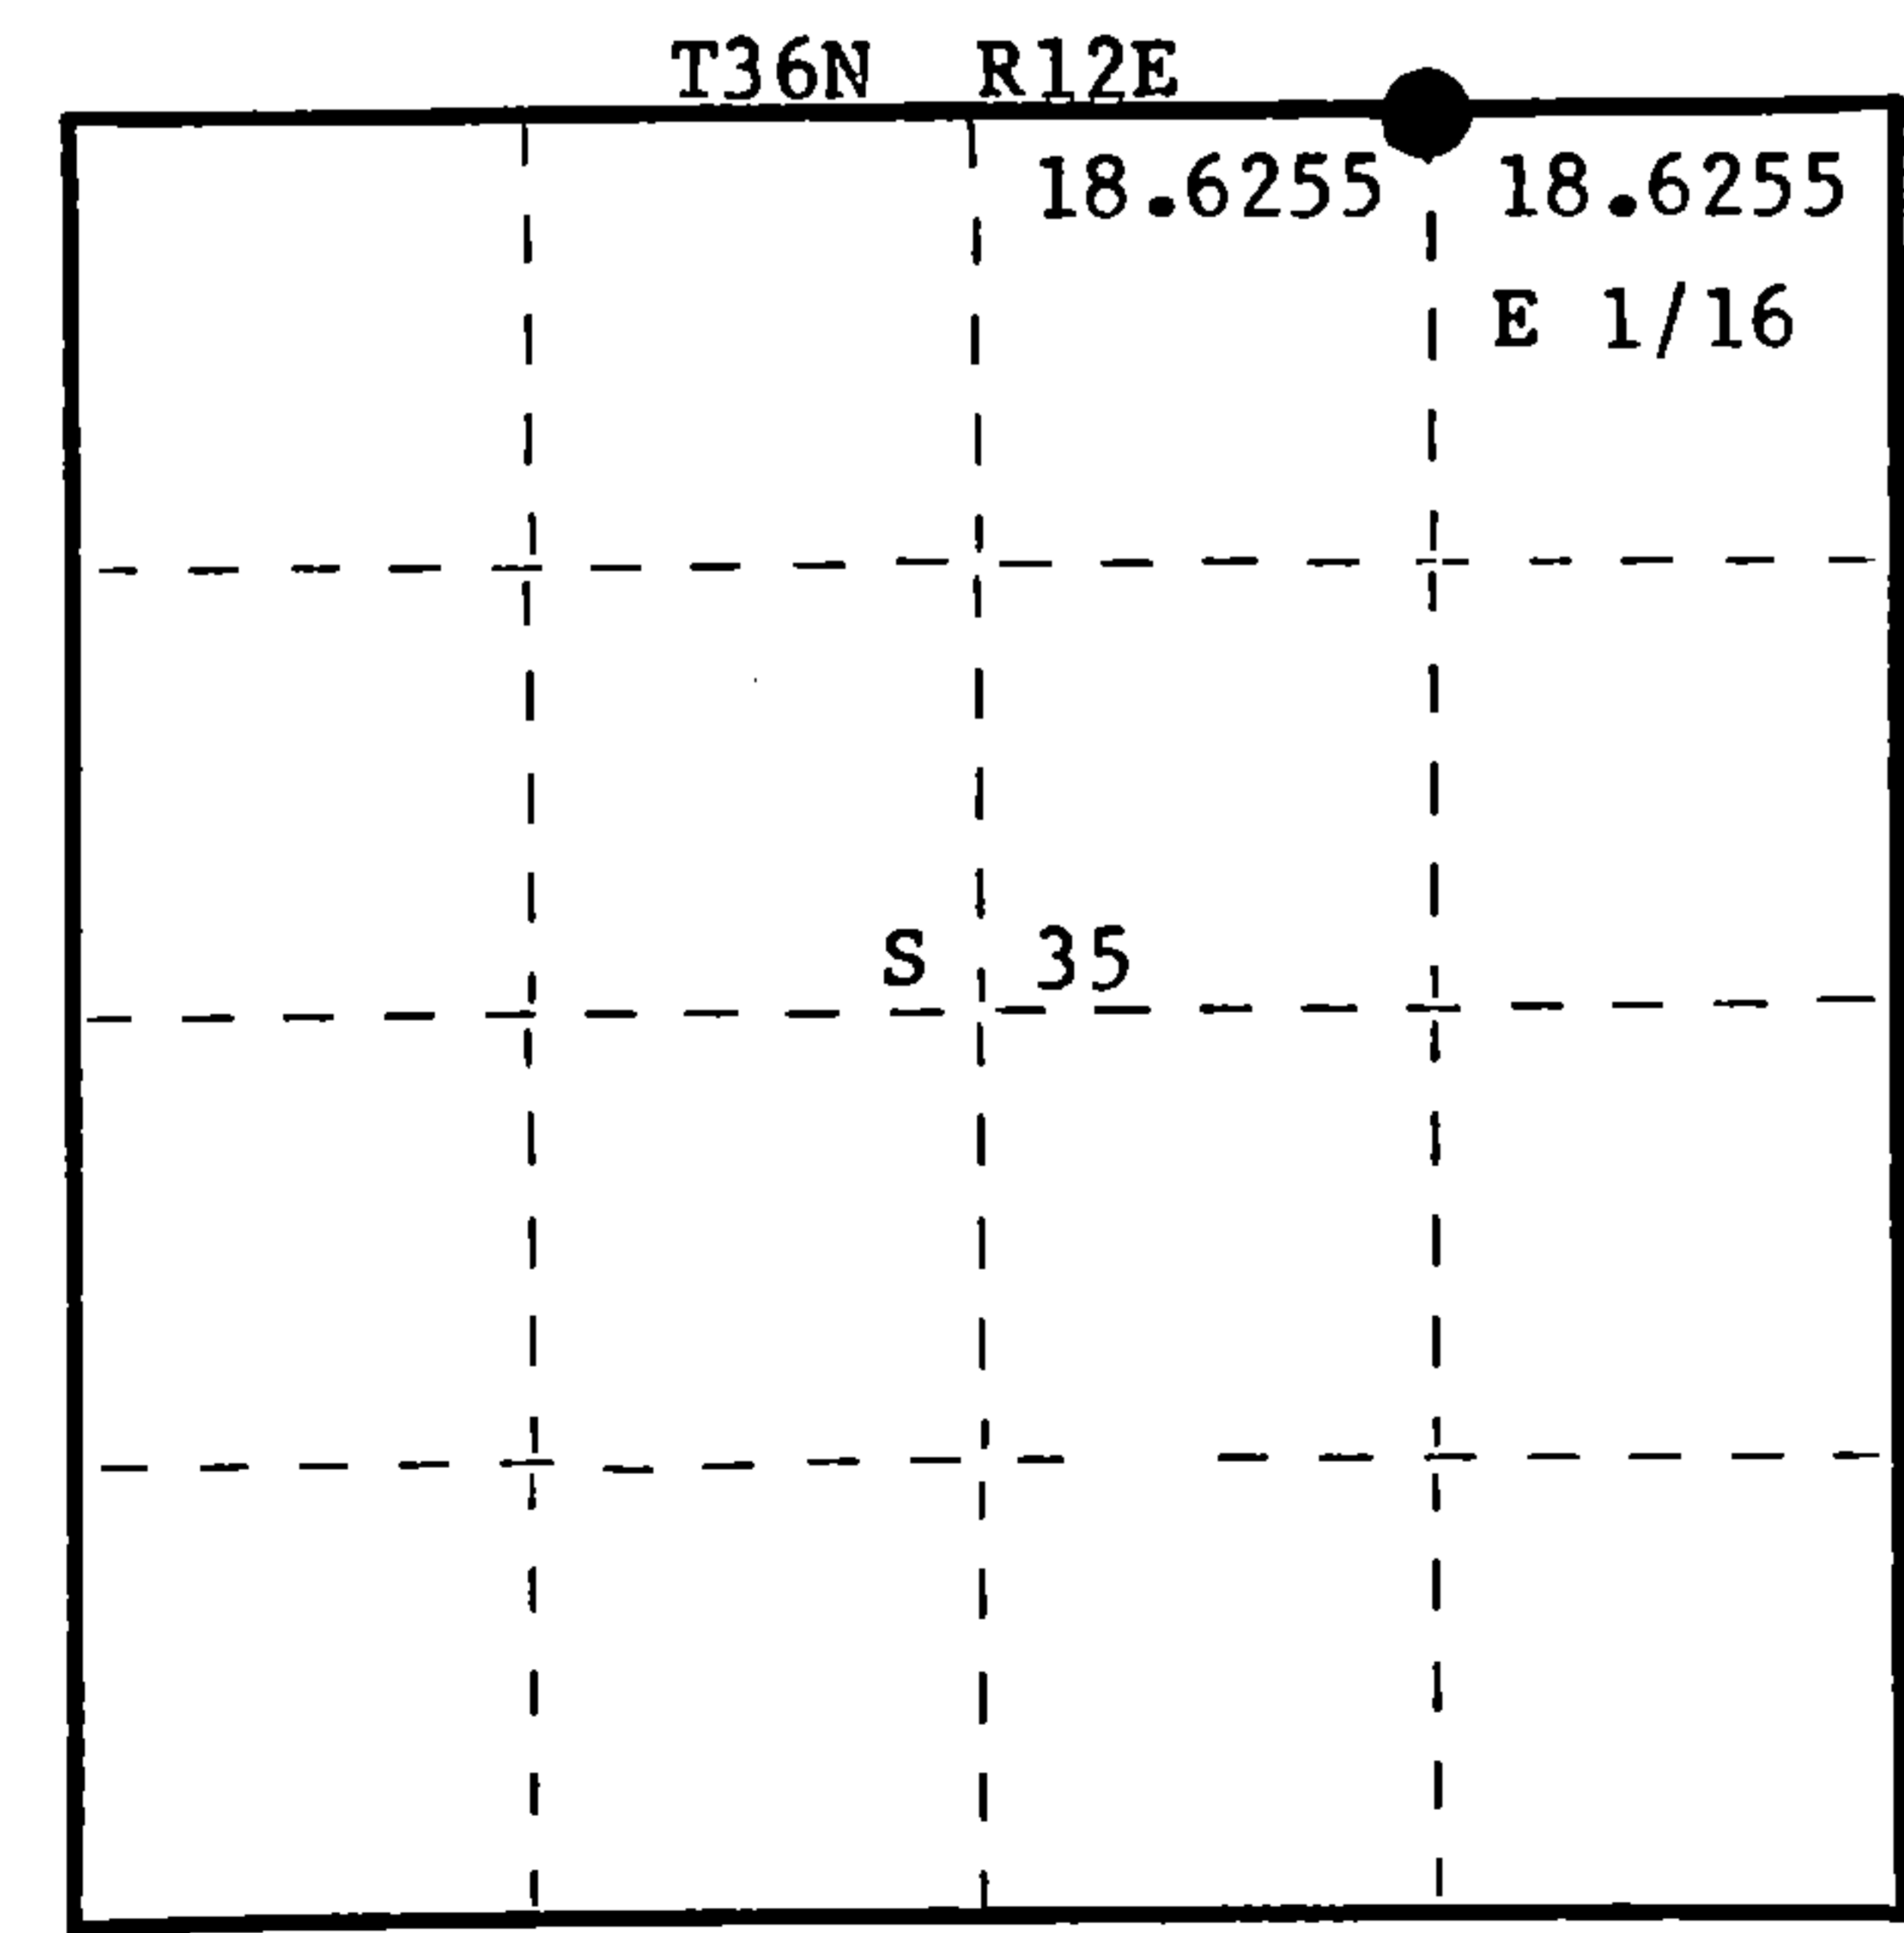

○ = Corner monument restored.

Dated at Rhineland, Wis., this 15th day of August, 19 77.

Signature Philip T. Hansen Title Registered Land Surveyor Registration No. S-498
(County Surveyor, Registered Land Surveyor, or other duly authorized official)

Office of Register of Deeds, County of Forest, I hereby certify that the within instrument was filed in this office for record on the 22nd day of AUGUST, 19 77.
at 3:30 o'clock P. M.

Eugene Stutzman
(Register of Deeds)
By _____ Deputy

DOCUMENT NUMBER **112161**

43012260010