U S PUBLIC LAND SURVEY MONUMENT RECORD

A-E 7.08(3)(a) Identity of corner EAST 1/4 CORNER OF SECTION 27 TOWNSHIP 36 NORTH RANGE 12 EAST OF THE 4TH PM TOWN OF CRANDON, COUNTY OF FOREST

WISCRS - FOREST COUNTY N: 571,669.914 USft 820,790.640 USft Datum: NAD83 (2011) GNSS Method RTN - Direct GNSS Control WISCORS VRS

The coordinate value shown has been verified by the average of two or more GPS observations at a markedly different time.

A-E 7.08(3)(b) Description of any record evidence, monument evidence, occupational evidence, testimonial evidence, or any other material evidence.

Original Surveyor: William E. Daugherty

Date of Original Survey Commenced:

August 4, 1859

Completed:

August 9, 1859

Original Accessories:

Hemlock

Sugar

S 48° F WEST

9 20 See Previous Monument Record:

Index No. T-17


Document No. 172369

July 23, 2001 - Surveyor 2197 - Michael A. Treml - restored the corner through acceptance of obliterated evidence, and set a stamped Forest County aluminum monument.

A-E 7.08(3)(f) The corner is a found perpetuated location.

September 13, 2021 - I found a 2 1/2" diameter aluminum pipe with a 3 1/4" diameter aluminum capped Forest County aluminum monument stamped to identify the corner, leaning west. I straightened the monument, and reset its position from previously measured distances to: the Northeast Corner of Section 27, and to the Center 1/4 Corner Section 26, and the existing utility pole witness established by Treml.

A-E 7.08(3)(c)(d)(e)(h) Plan view of corner with references to at least 4 witness monuments. If in disagreement with previously established corner, show the distances between the two corners and also indicate the ties to the disputed. The directions and distances to other public land survey corners used as evidence or used for determining the corner location.

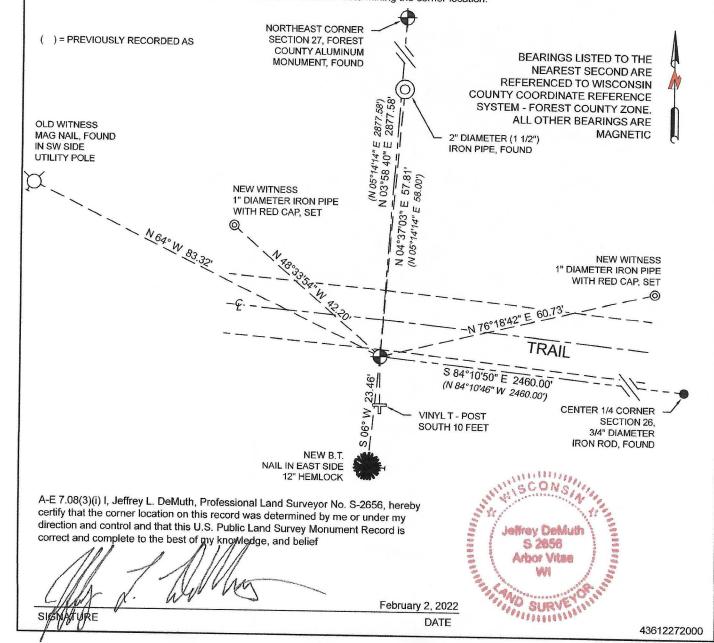

CERTIFIED LAND CORNER RESTORATION

Index No. V-17

History of original corner establishment:

Original Corner established by J.L. Nowlin, Deputy Surveyor, in 1859 from which Tamarack 15" bears N80°E, 33 links; Fir 9" bears N82°W, 20 links.

No records of any subsequent survey.

Description of corner evidence found:

No evidence of any corner recovered after extensive search.

Corner established by proportion. Corner established by doubling distance from recovered 1/4 corner and E 1/16 corner. Ran traverse between two aforementioned corners. Computed distance 1305.792 ft. (19.7847 chains) at bearing N 89° 24' 30" E. Extended line and set section corner at 19.7847 chains N 89° 24' 30" E of E 1/16 corner.

Description of monument and accessories I established to perpetuate the original location of this corner.

Set 2½" Berntsen A-1 Federal Monument for corner projecting 18" above ground. Corner sets 17' north of old section line road. Road makes a bend to the south at this point.

Cap stamped:

Corner sets in tag alder brush. No trees available for BTs. Set 2 3/4" iron pipes with 2" brass caps for witness monuments projecting 18" above ground.

#1 - North 30 links, stamped: W/C S 30 lks.
#2 - West 20 links, stamped: W/C E 20 lks.

T36N R12E
Sec. 27 26
34 35
S498-1977

Dated at	Rhinelander	, Wis., this	9th	day	of	August	, 19.77
	Hilip J Annsen	Title	Registered	Land	Surveyo	r Reg	
Office of Re	, .						certify that the within
instrument	was filed in this office for re	cord on the	Forest 22nd day of	day of	AUGUST	, 1977	
at 3:30	o'clock Pe M						112158
Rv	(Register of Deed		Deputy	,			