

CERTIFIED LAND CORNER RESTORATION

Index No. V-12

State of Wisconsin }
County of Forest } ss.

History of original corner establishment:
No record or evidence of any previous survey or corner set.

I Philip T. Hansen, do hereby certify that on the 17th day of June, 1976, I found evidence of the E 1/16 corner of Sec. 28 and 33 Township 36, North, Range 12 East, Fourth Principal Meridian, as described hereon; and that from this evidence I established a new monument and accessories as described hereon to perpetuate the original location of this corner.


Description of corner evidence found: Corner established by proportional measurement from Section Corner 28, 29, 32 and 33 and Section 27, 28, 33 - 34. Total distance computed by traverse, 84.14 chains. - Set E 1/16 corner at 21.035 chains N 83° 49'30" E of 1/4 Sec. Corner, equidistant to Section Corner.

Resident witnesses:


Glen Barker

Jim Claflin

Herb Wagoner

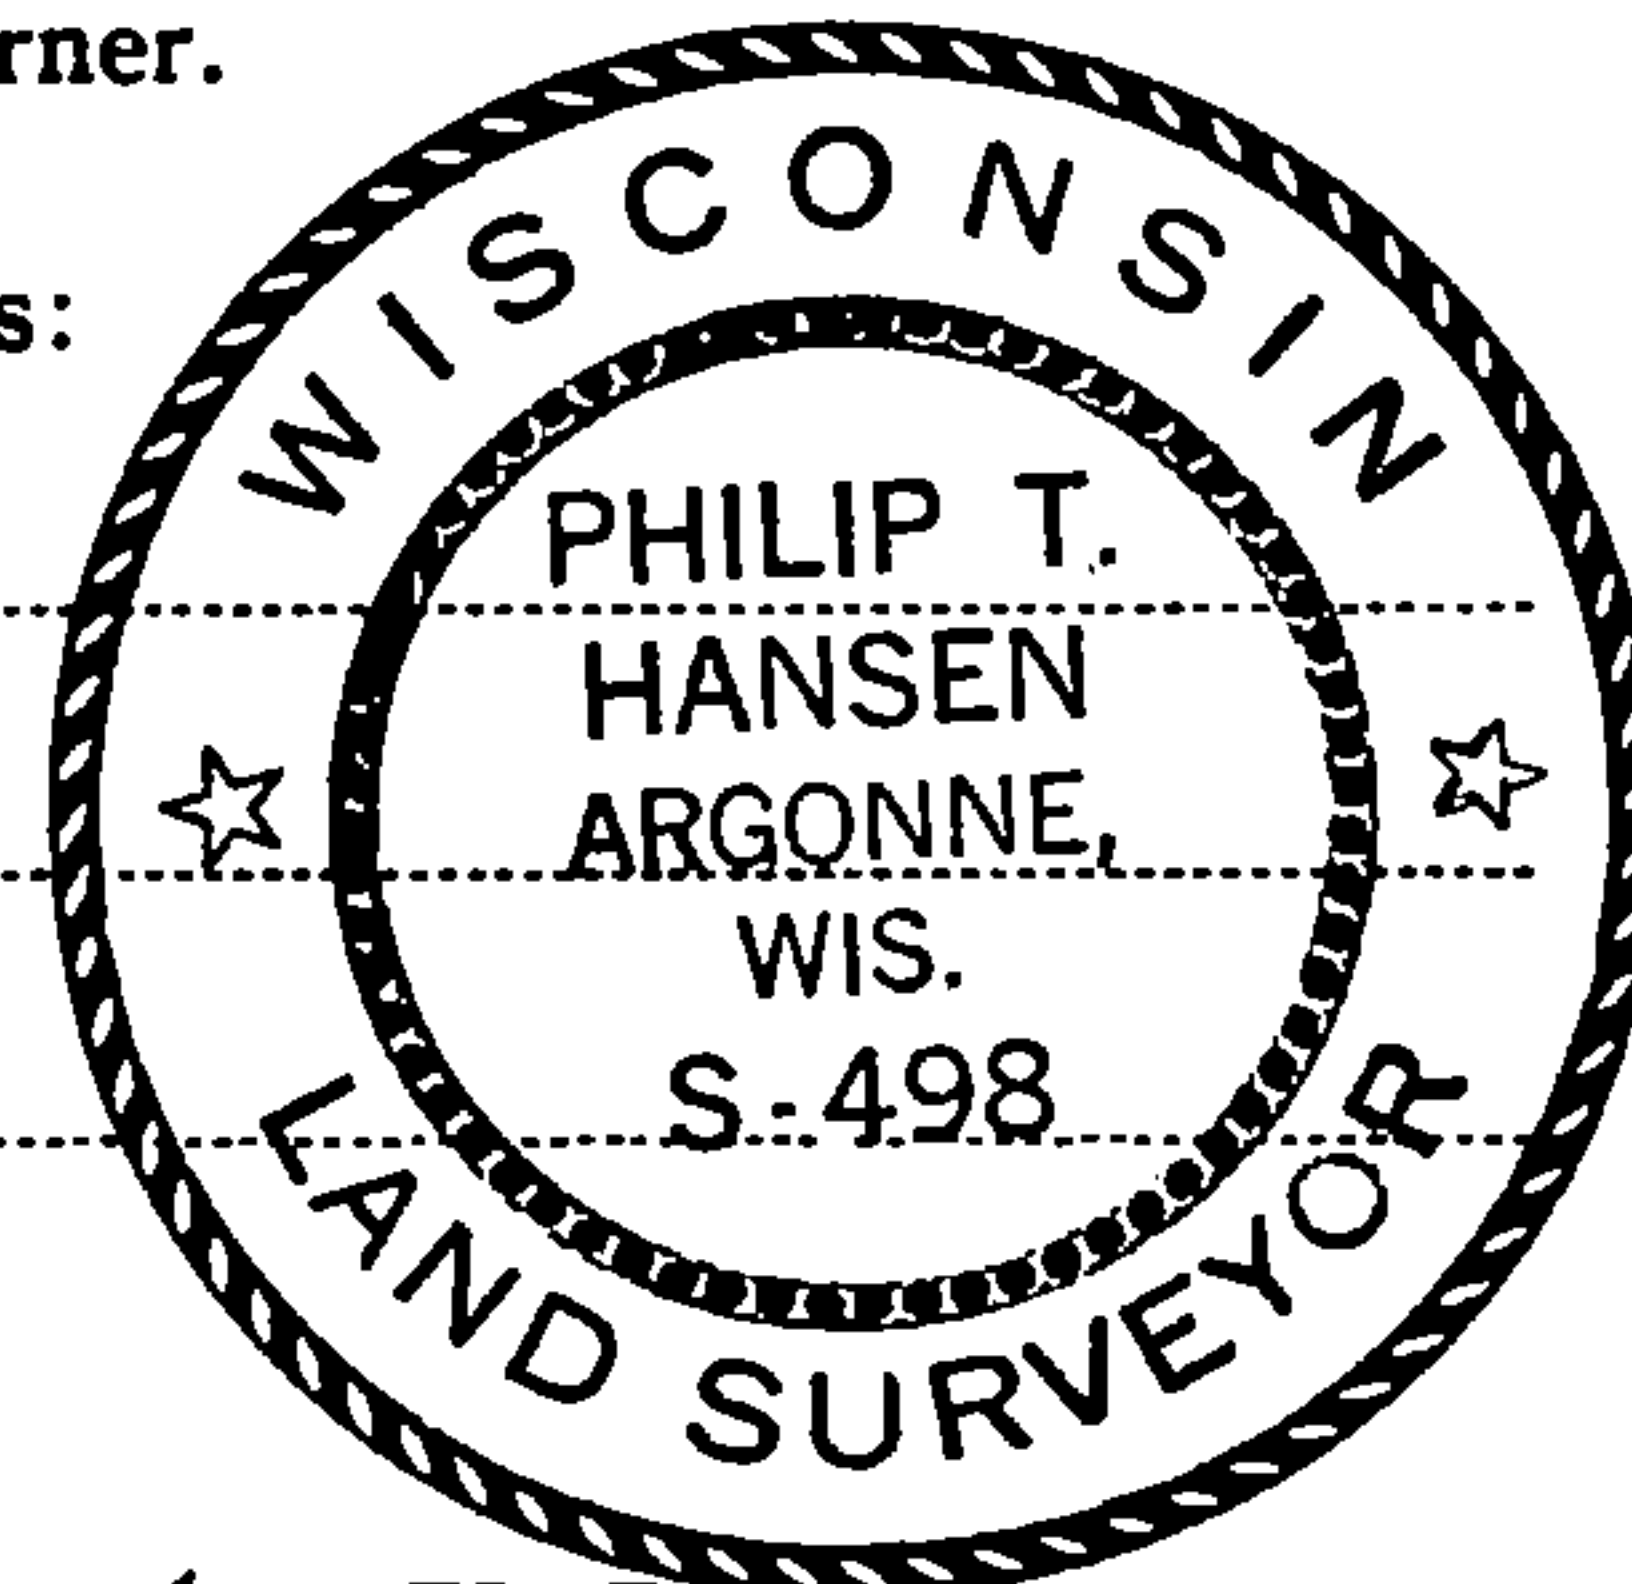

FORM 985
Wisconsin Planning History Co.
Madison, Wisconsin

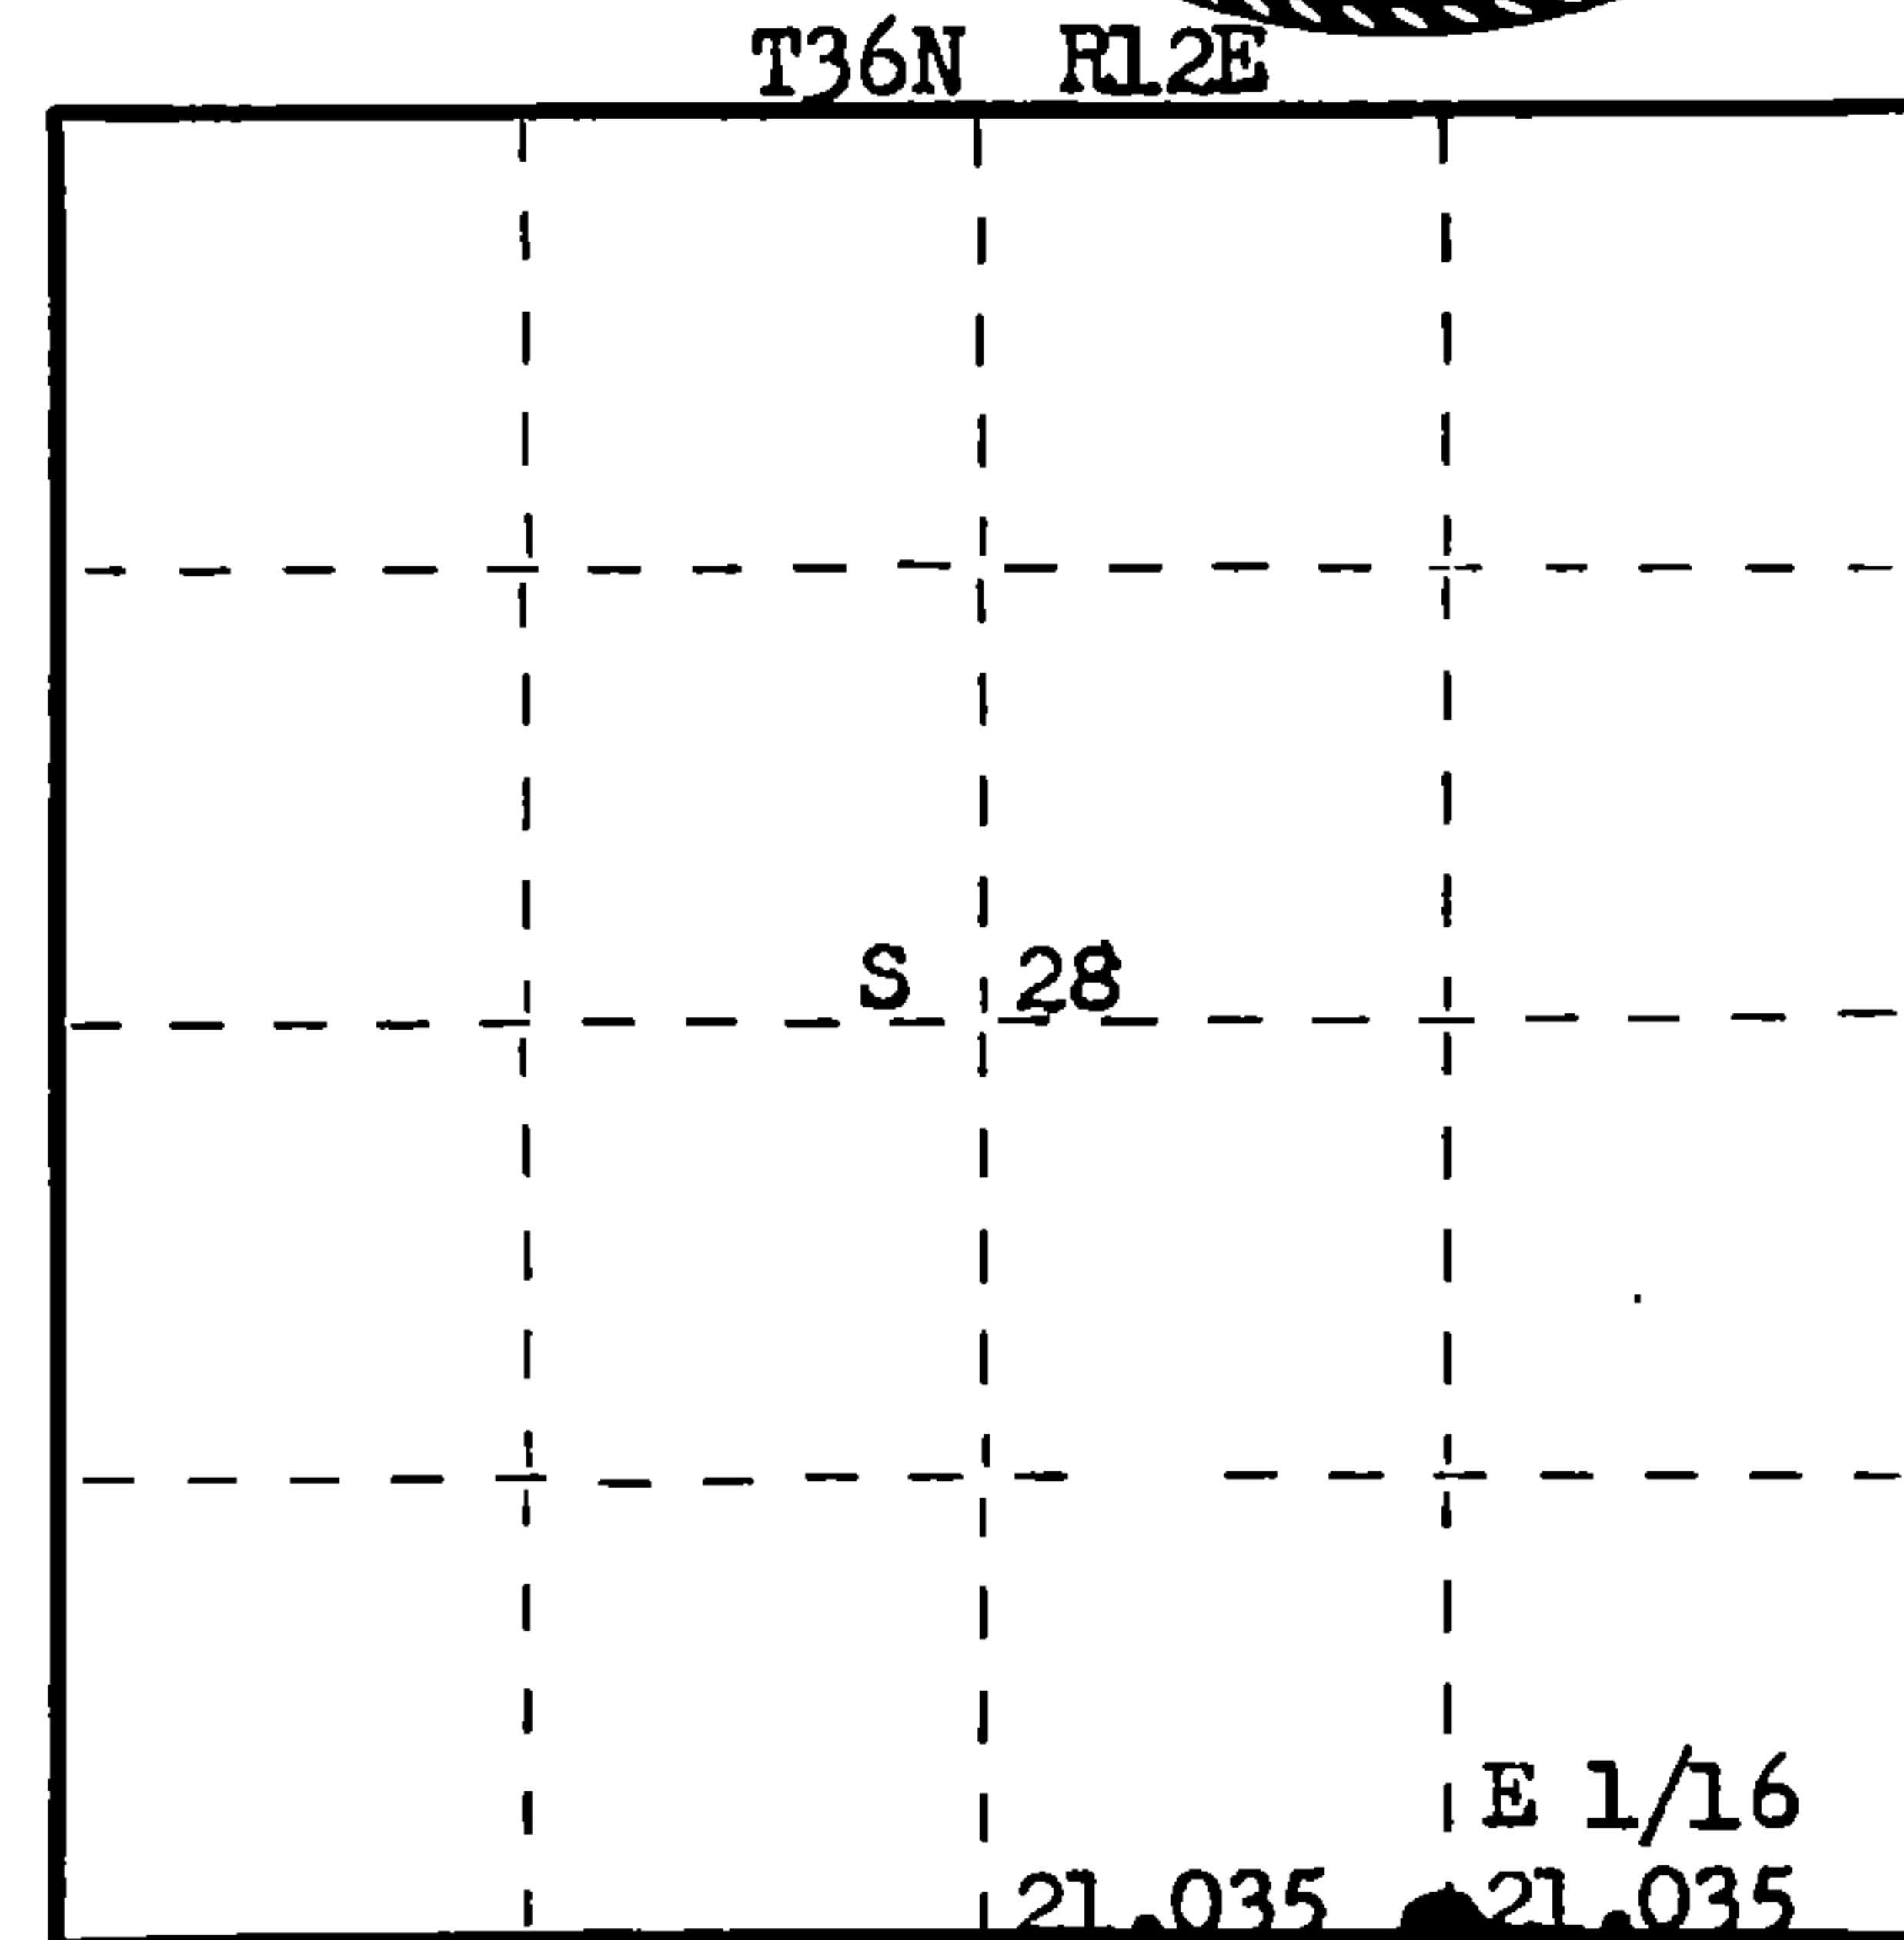

Description of monument and accessories I established to perpetuate the original location of this corner.

Set a 1 1/2" x 20" iron pipe for true corner on South edge of Ison Road, 4" below surface of road.

Set a 1 1/2" iron pipe with 2" brass cap 25 lks. South for a Witness Corner.

Pipe projects 18" above ground. Cap stamped.

NBTs - Sugar 18" N32°E 86.9 lks, scribed 1/16 BT.

Sugar 8" S22°W 81.7 lks, scribed 1/16 BT.

Measurements and bearings made to true corner.

Pipe and BTs painted blue.

S498
T36N RL2E
E 1/16 S 28 / S 33 W.C.
N. 25 lks.
CPI - 1976

Dated at Rhineland, Wis., this 22nd day of June, 1976

Signature Philip T. Hansen Title Registered Land Surveyor Registration No. S-498
(County Surveyor, Registered Land Surveyor, or other duly authorized official)

Office of Register of Deeds, County of Forest, I hereby certify that the within instrument was filed in this office for record on the 28th day of June, 1976 at 3:45 o'clock P. M.

Eugene Stegmyr
(Register of Deeds)

DOCUMENT NUMBER -- **109544**

○ = Corner monument restored.

By..... Deputy

43612 28 0010