

CERTIFIED LAND CORNER RESTORATION


Index No. V-8

State of Wisconsin }
County of Forest } ss.


I Philip T. Hansen, do hereby certify that on the 3rd day of May, 1976, I found evidence of the E 1/16 corner of Section 29 & 32 Township 36, North, Range 12 East, Fourth Principal Meridian, as described hereon; and that from this evidence I established a new monument and accessories as described hereon to perpetuate the original location of this corner.

Resident witnesses:

Glen Barker
Jim Claflin
Herb Wagoner

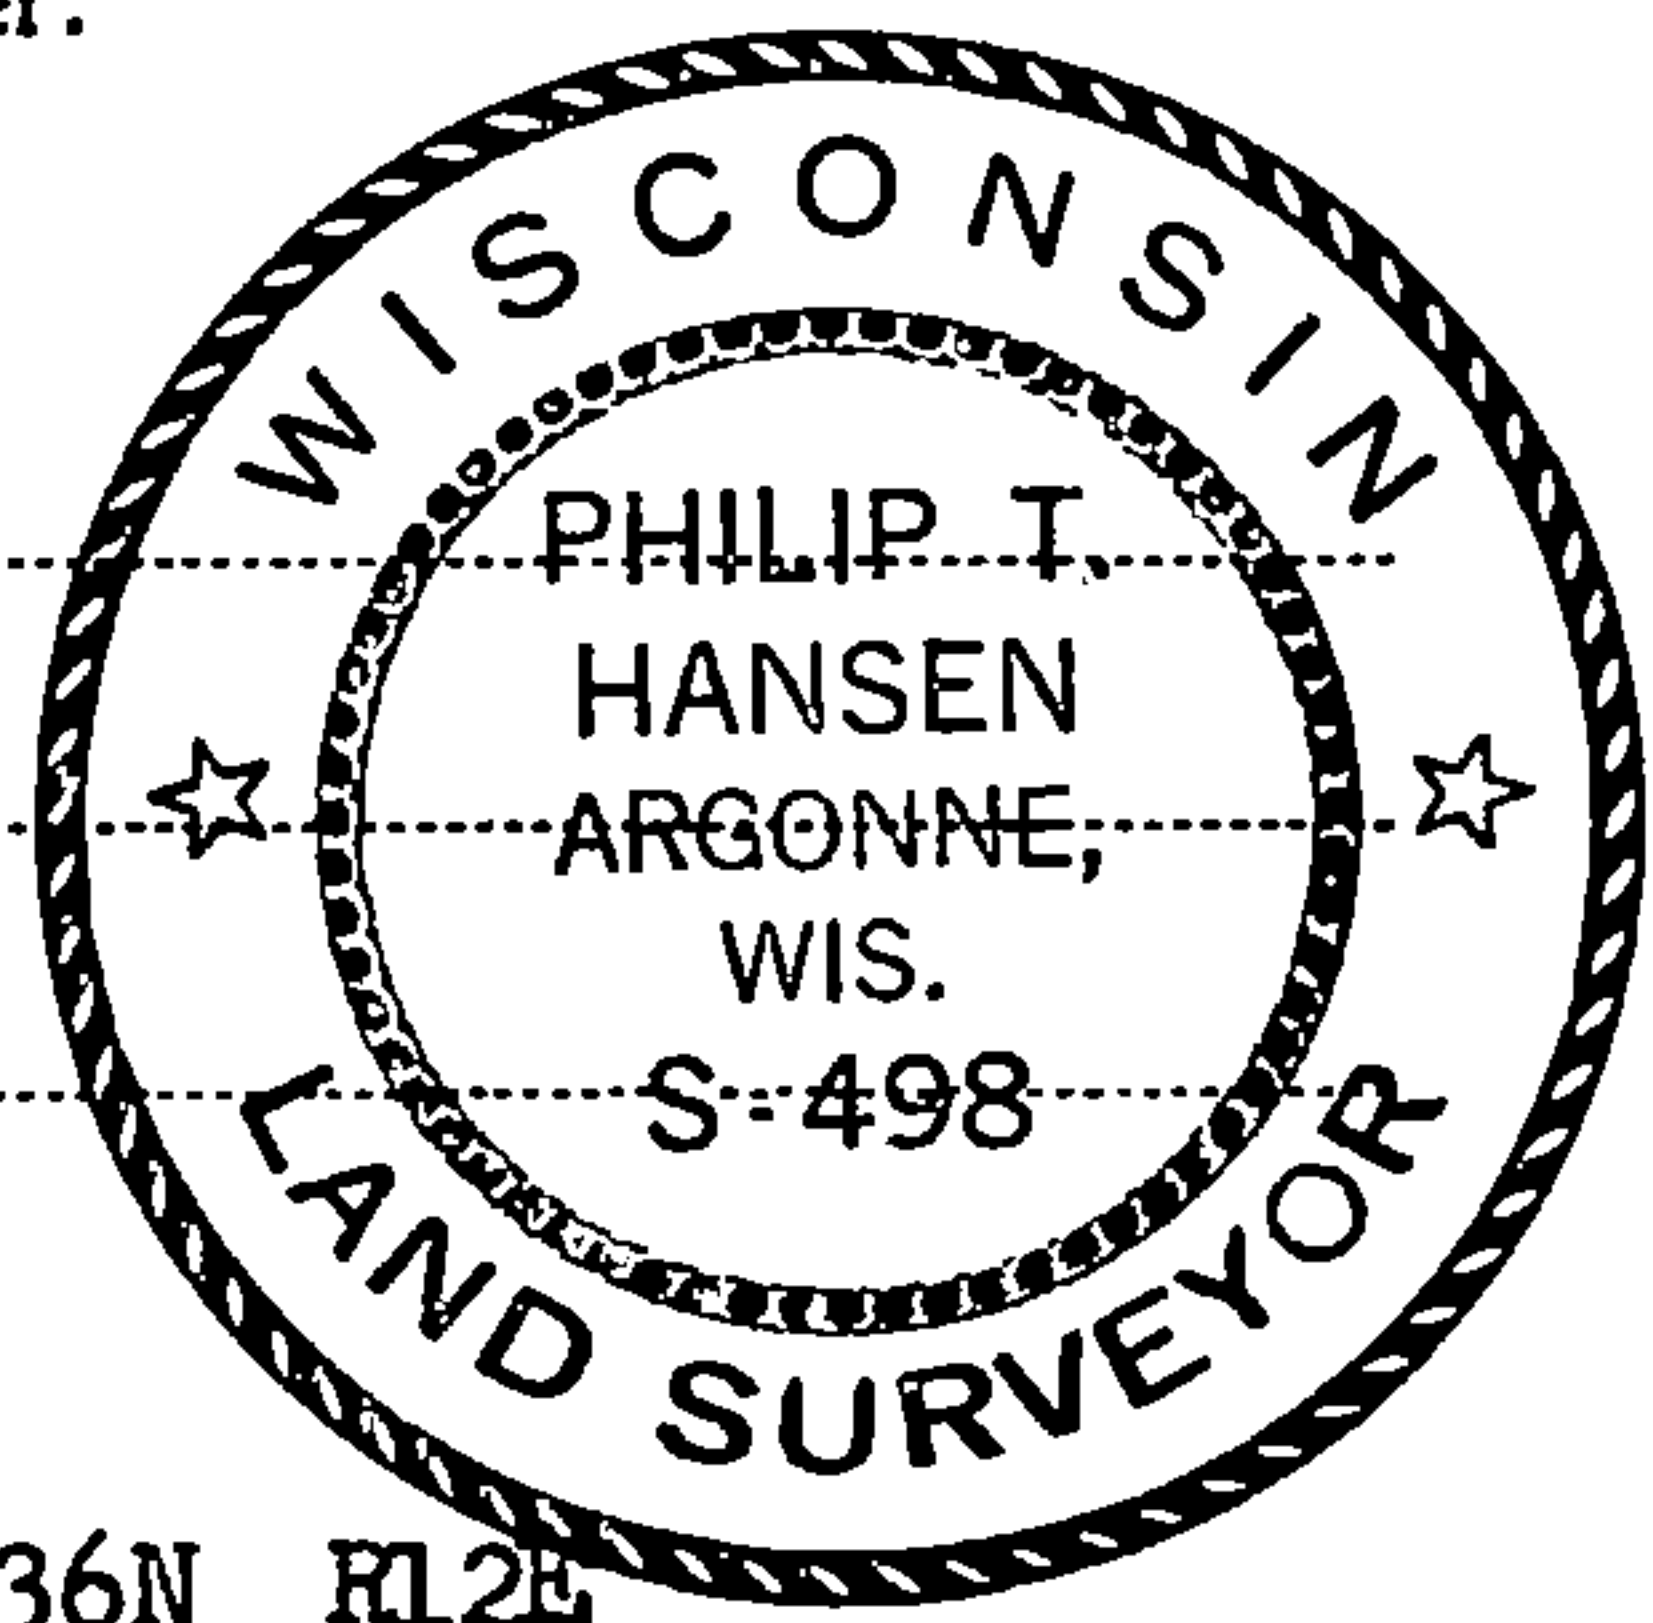

FORM 985

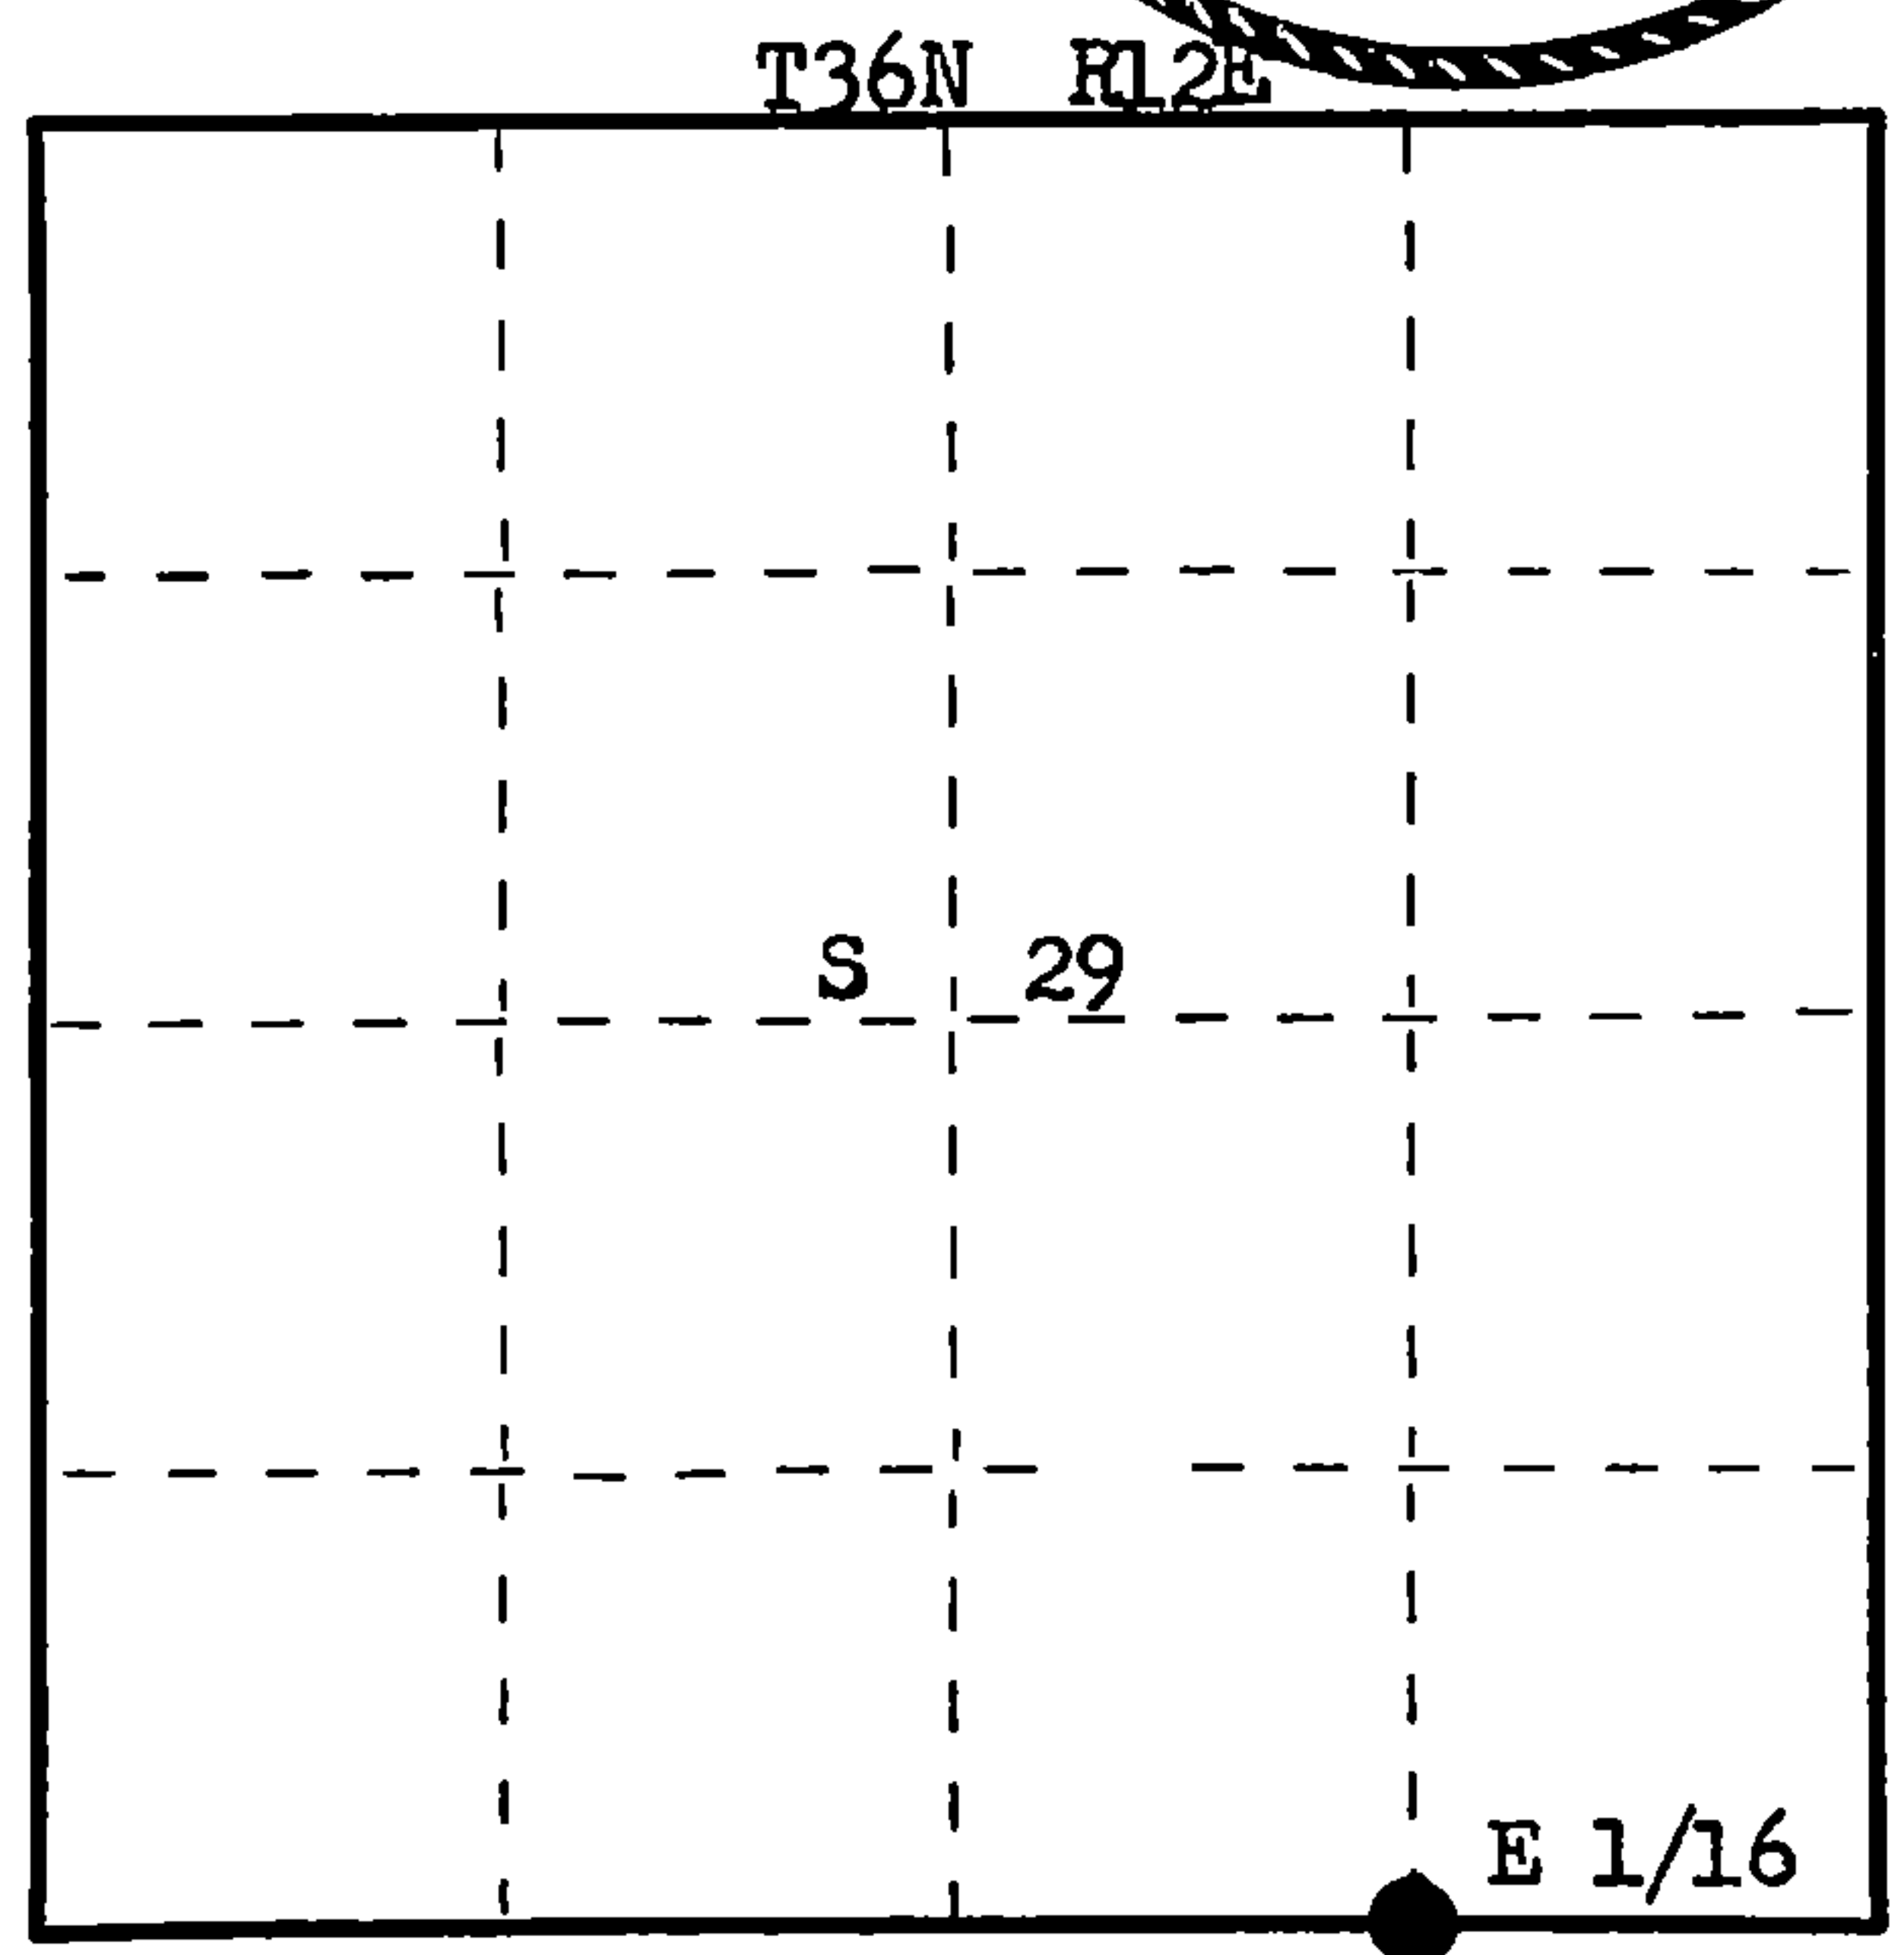

○ = Corner monument restored.

History of original corner establishment:

Original corner established by I.R. Ritter, County Surveyor, in 1931. Set wood post and marked BTs - Yellow Birch 14" S20°E 13.4 lks, Hemlock 16" S21°E 37.8 lks. Have information from local dwellers that State of Wisconsin ran this line at later date. Believed they placed 1 1/2" x 3' iron pipe at corner.

Description of corner evidence found:

Recovered 1 1/2" x 3' iron pipe projecting 6" above ground.
Also found old squared elm stake, scribed 1/16 beside the iron pipe.
Recovered OBT - Yellow Birch 14" S 2° E 13.4 lks, scribed X 1/16 BT.
Hemlock S 21° E 37.8 lks. scribed X 1/16 BT.

Description of monument and accessories I established to perpetuate the original location of this corner.

Replaced iron pipe with 1 1/2" OD iron pipe w/2" brass cap stamped
Marked NBTs - Sugar 7" S85°E 47.7 lks, scribed 1/16 BT.
Sugar 6" N34°E 34.8 lks, scribed 1/16 BT.
Pipe projects 18" above ground.
Pipe and BTs painted blue.
Corner sets in the bed of old narrow gauge RR

S498
T36N R12E
E 1/16 S129
S132
CPI-1976

Dated at Rhineland, Wis., this 11th day of June, 1976

Signature Philip T. Hansen Title Registered Land Surveyor Registration No. S-498
(County Surveyor, Registered Land Surveyor, or other duly authorized official)

Office of Register of Deeds, County of Forest, I hereby certify that the within instrument was filed in this office for record on the 28th day of June, 1976 at 3:15 o'clock P. M.

Eugene Staszny
(Register of Deeds)
By..... Deputy

DOCUMENT NUMBER **109542**

43612290010