

CERTIFIED LAND CORNER RESTORATION

Index No. U 8

State of Wisconsin }  
County of Forest } ss.


I Philip T. Hansen, do hereby certify that on the 4th day of May, 1976, I found evidence of the SE 1/16 corner of Section 29 Township 36, North, Range 12E, Fourth Principal Meridian, as described hereon; and that from this evidence I established a new monument and accessories as described hereon to perpetuate the original location of this corner.

Resident witnesses:


Glen Barker

Jim Claflin

Herb Wagoner

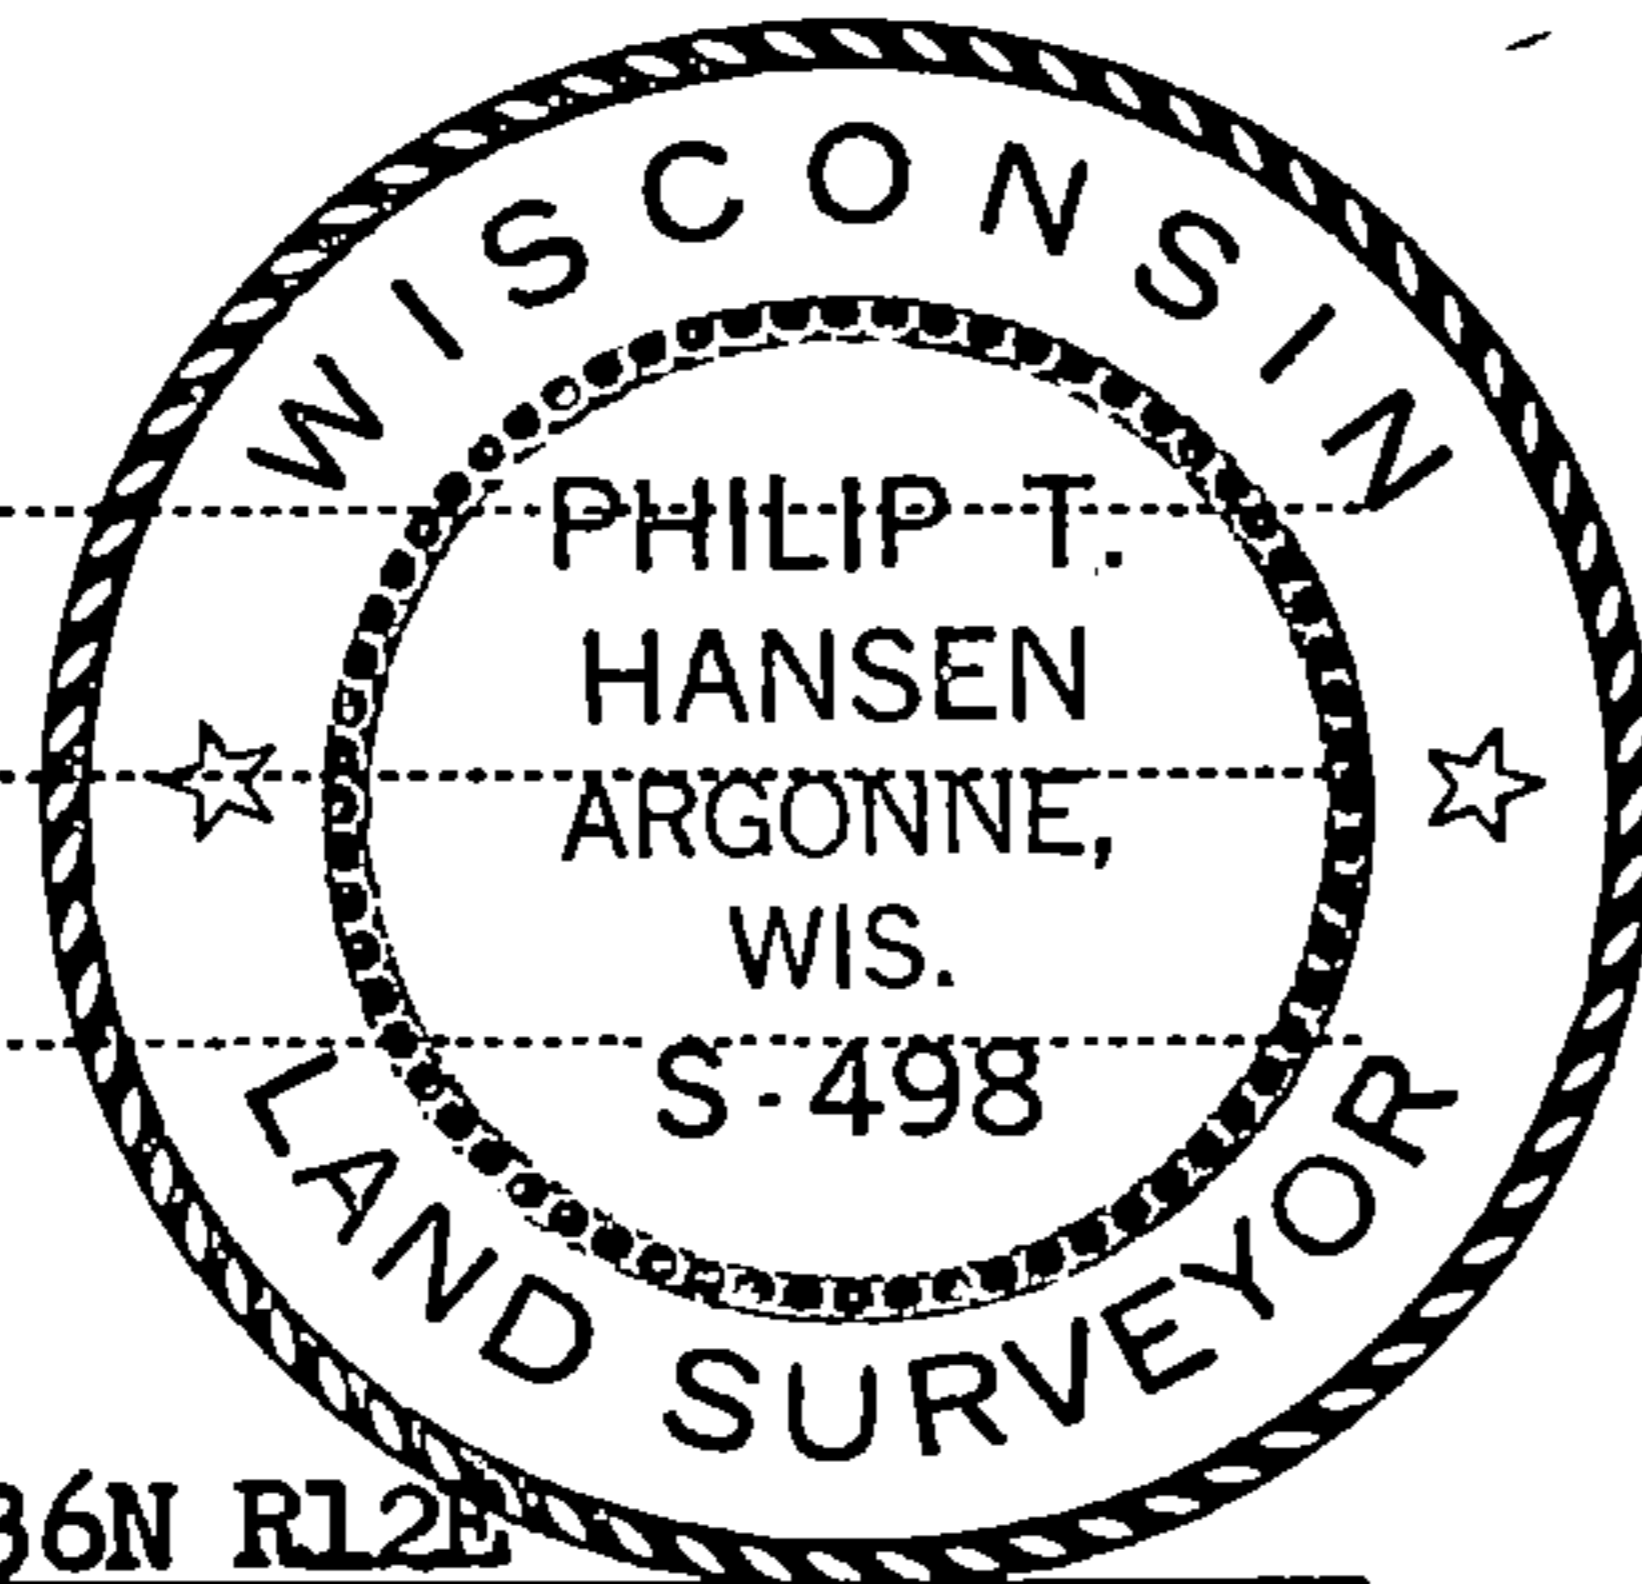

T36N R12E

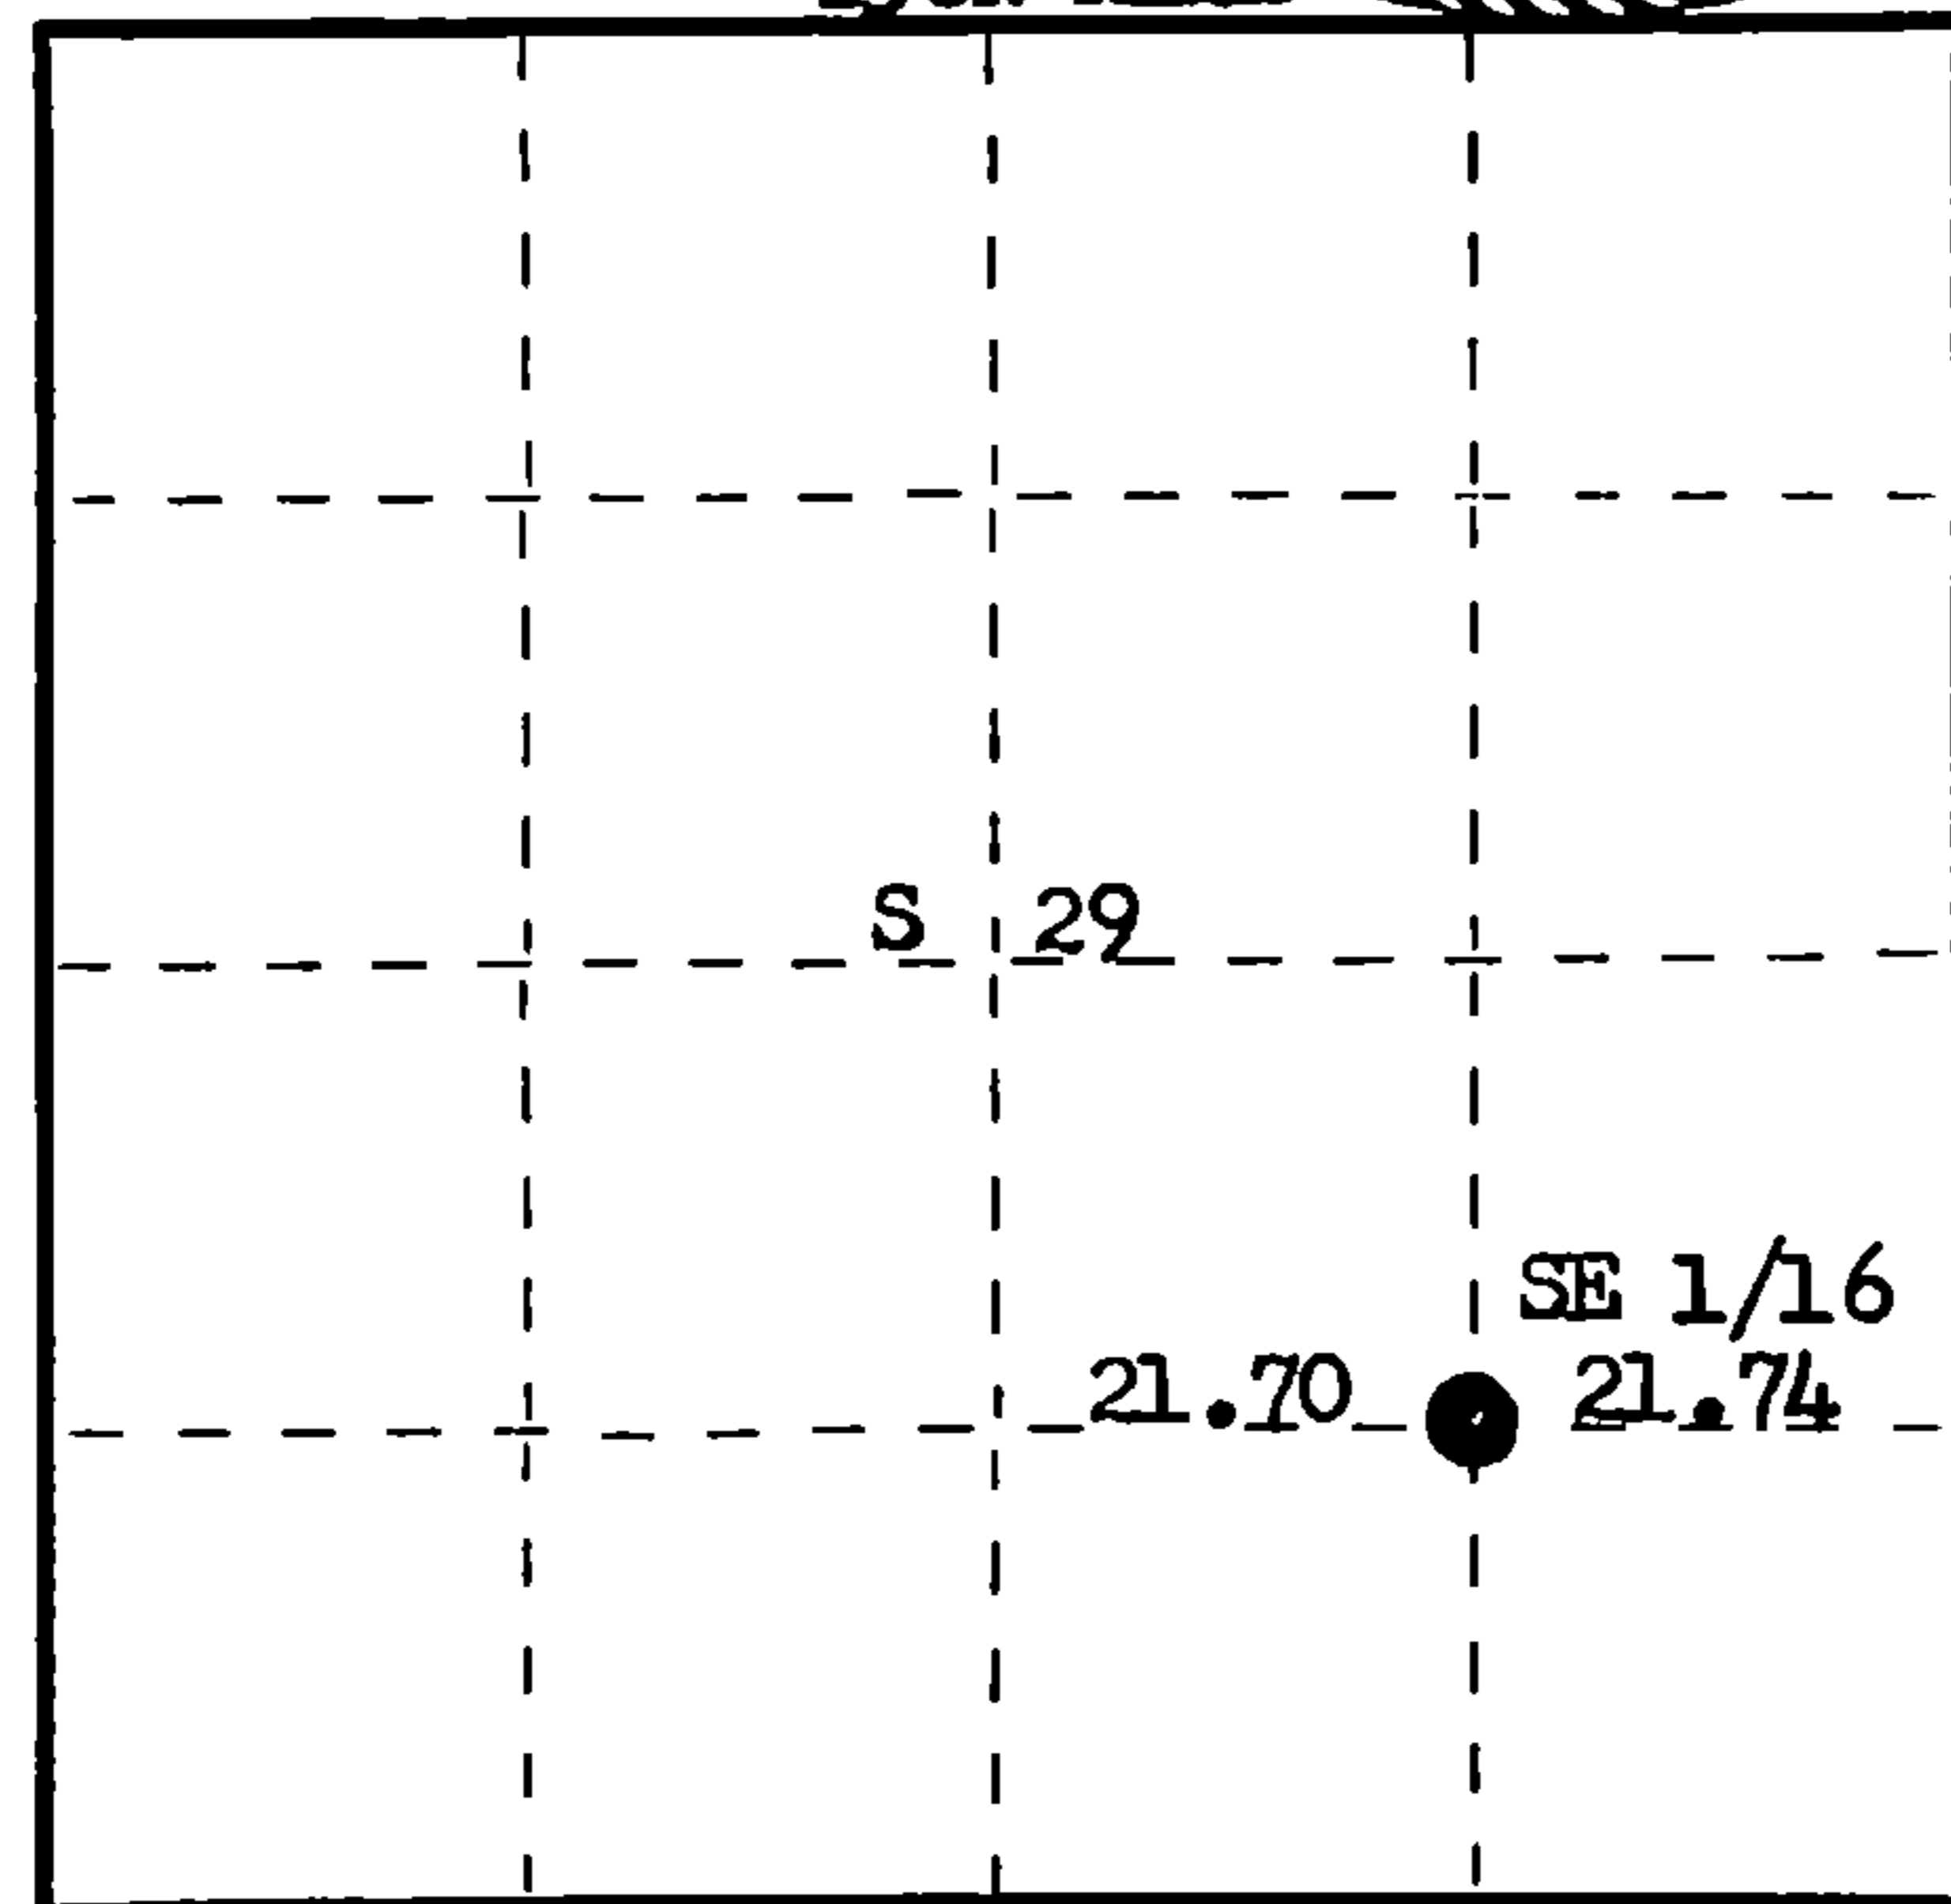

○ = Corner monument restored.

History of original corner establishment:

Chained east from SC 1/16 corner. At 21.70 chains recovered cedar post. Continued East at 21.74 chains intersected centerline of Tower Road. Bearing of line S88°E.

Description of corner evidence found:

Recovered 6" cedar post, squared on top end, around the bottom of which was a rock cairn.

No evidence of any OBTs visible.

Description of monument and accessories I established to perpetuate the original location of this corner.

Replaced old wood post with 1 1/2" iron pipe with 2" brass cap, stamped  
Pipe projects 18" above ground.

NBTs - Sugar 5" N50°W 9.5 lks, scribed 1/16 BT.

Sugar 6" S52°E 26.4 lks, scribed 1/16 BT.

Pipe and BTs painted blue.

S498

T36N R12E

SE 1/16 S/29

CPI-1976

Dated at Rhineland, Wis., this 11th day of June, 1976

Signature Philip T. Hansen Title Registered Land Surveyor Registration No. S-498  
(County Surveyor, Registered Land Surveyor, or other duly authorized official)

Office of Register of Deeds, County of Forest, I hereby certify that the within instrument was filed in this office for record on the 28th day of June, 1976 at 3:45 o'clock P. M.

Eugene Stutzman   
(Register of Deeds)

DOCUMENT NUMBER --- **109538**

By \_\_\_\_\_ Deputy

FORM 985

43012291010