

CERTIFIED LAND CORNER RESTORATION

Index No. T-9

State of Wisconsin }  
County of Forest } ss.


I Philip T. Hansen, do hereby certify that on the 16th day of June, 1976, I found evidence of the Quarter corner of Section 28 - 29 Township 36, North, Range 12 East, Fourth Principal Meridian, as described hereon; and that from this evidence I established a new monument and accessories as described hereon to perpetuate the original location of this corner.

Resident witnesses:


Glen Barker

Jim Claflin

Herb Wagoner

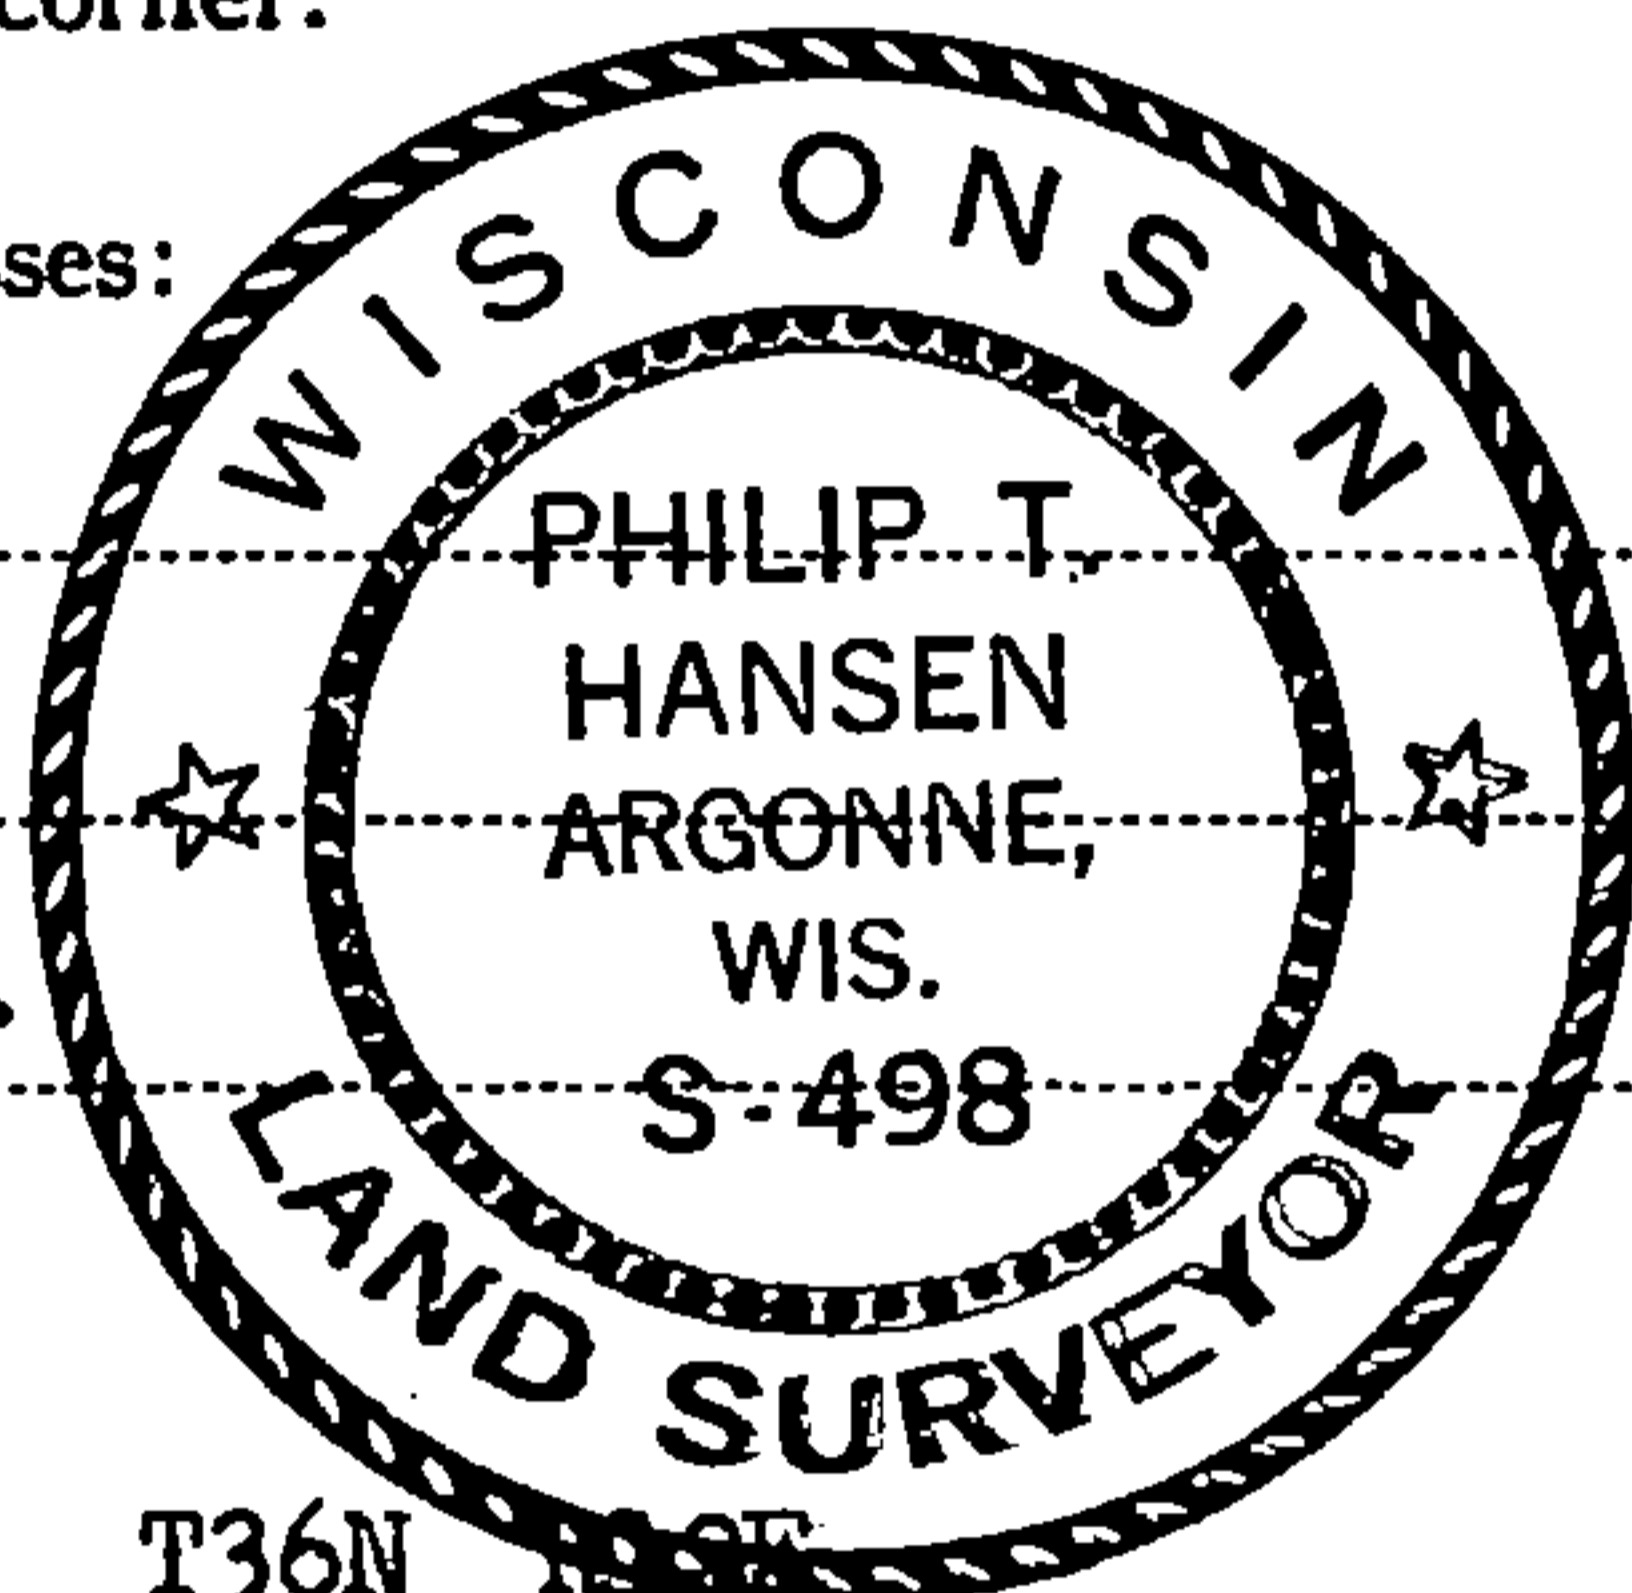

FORM 985

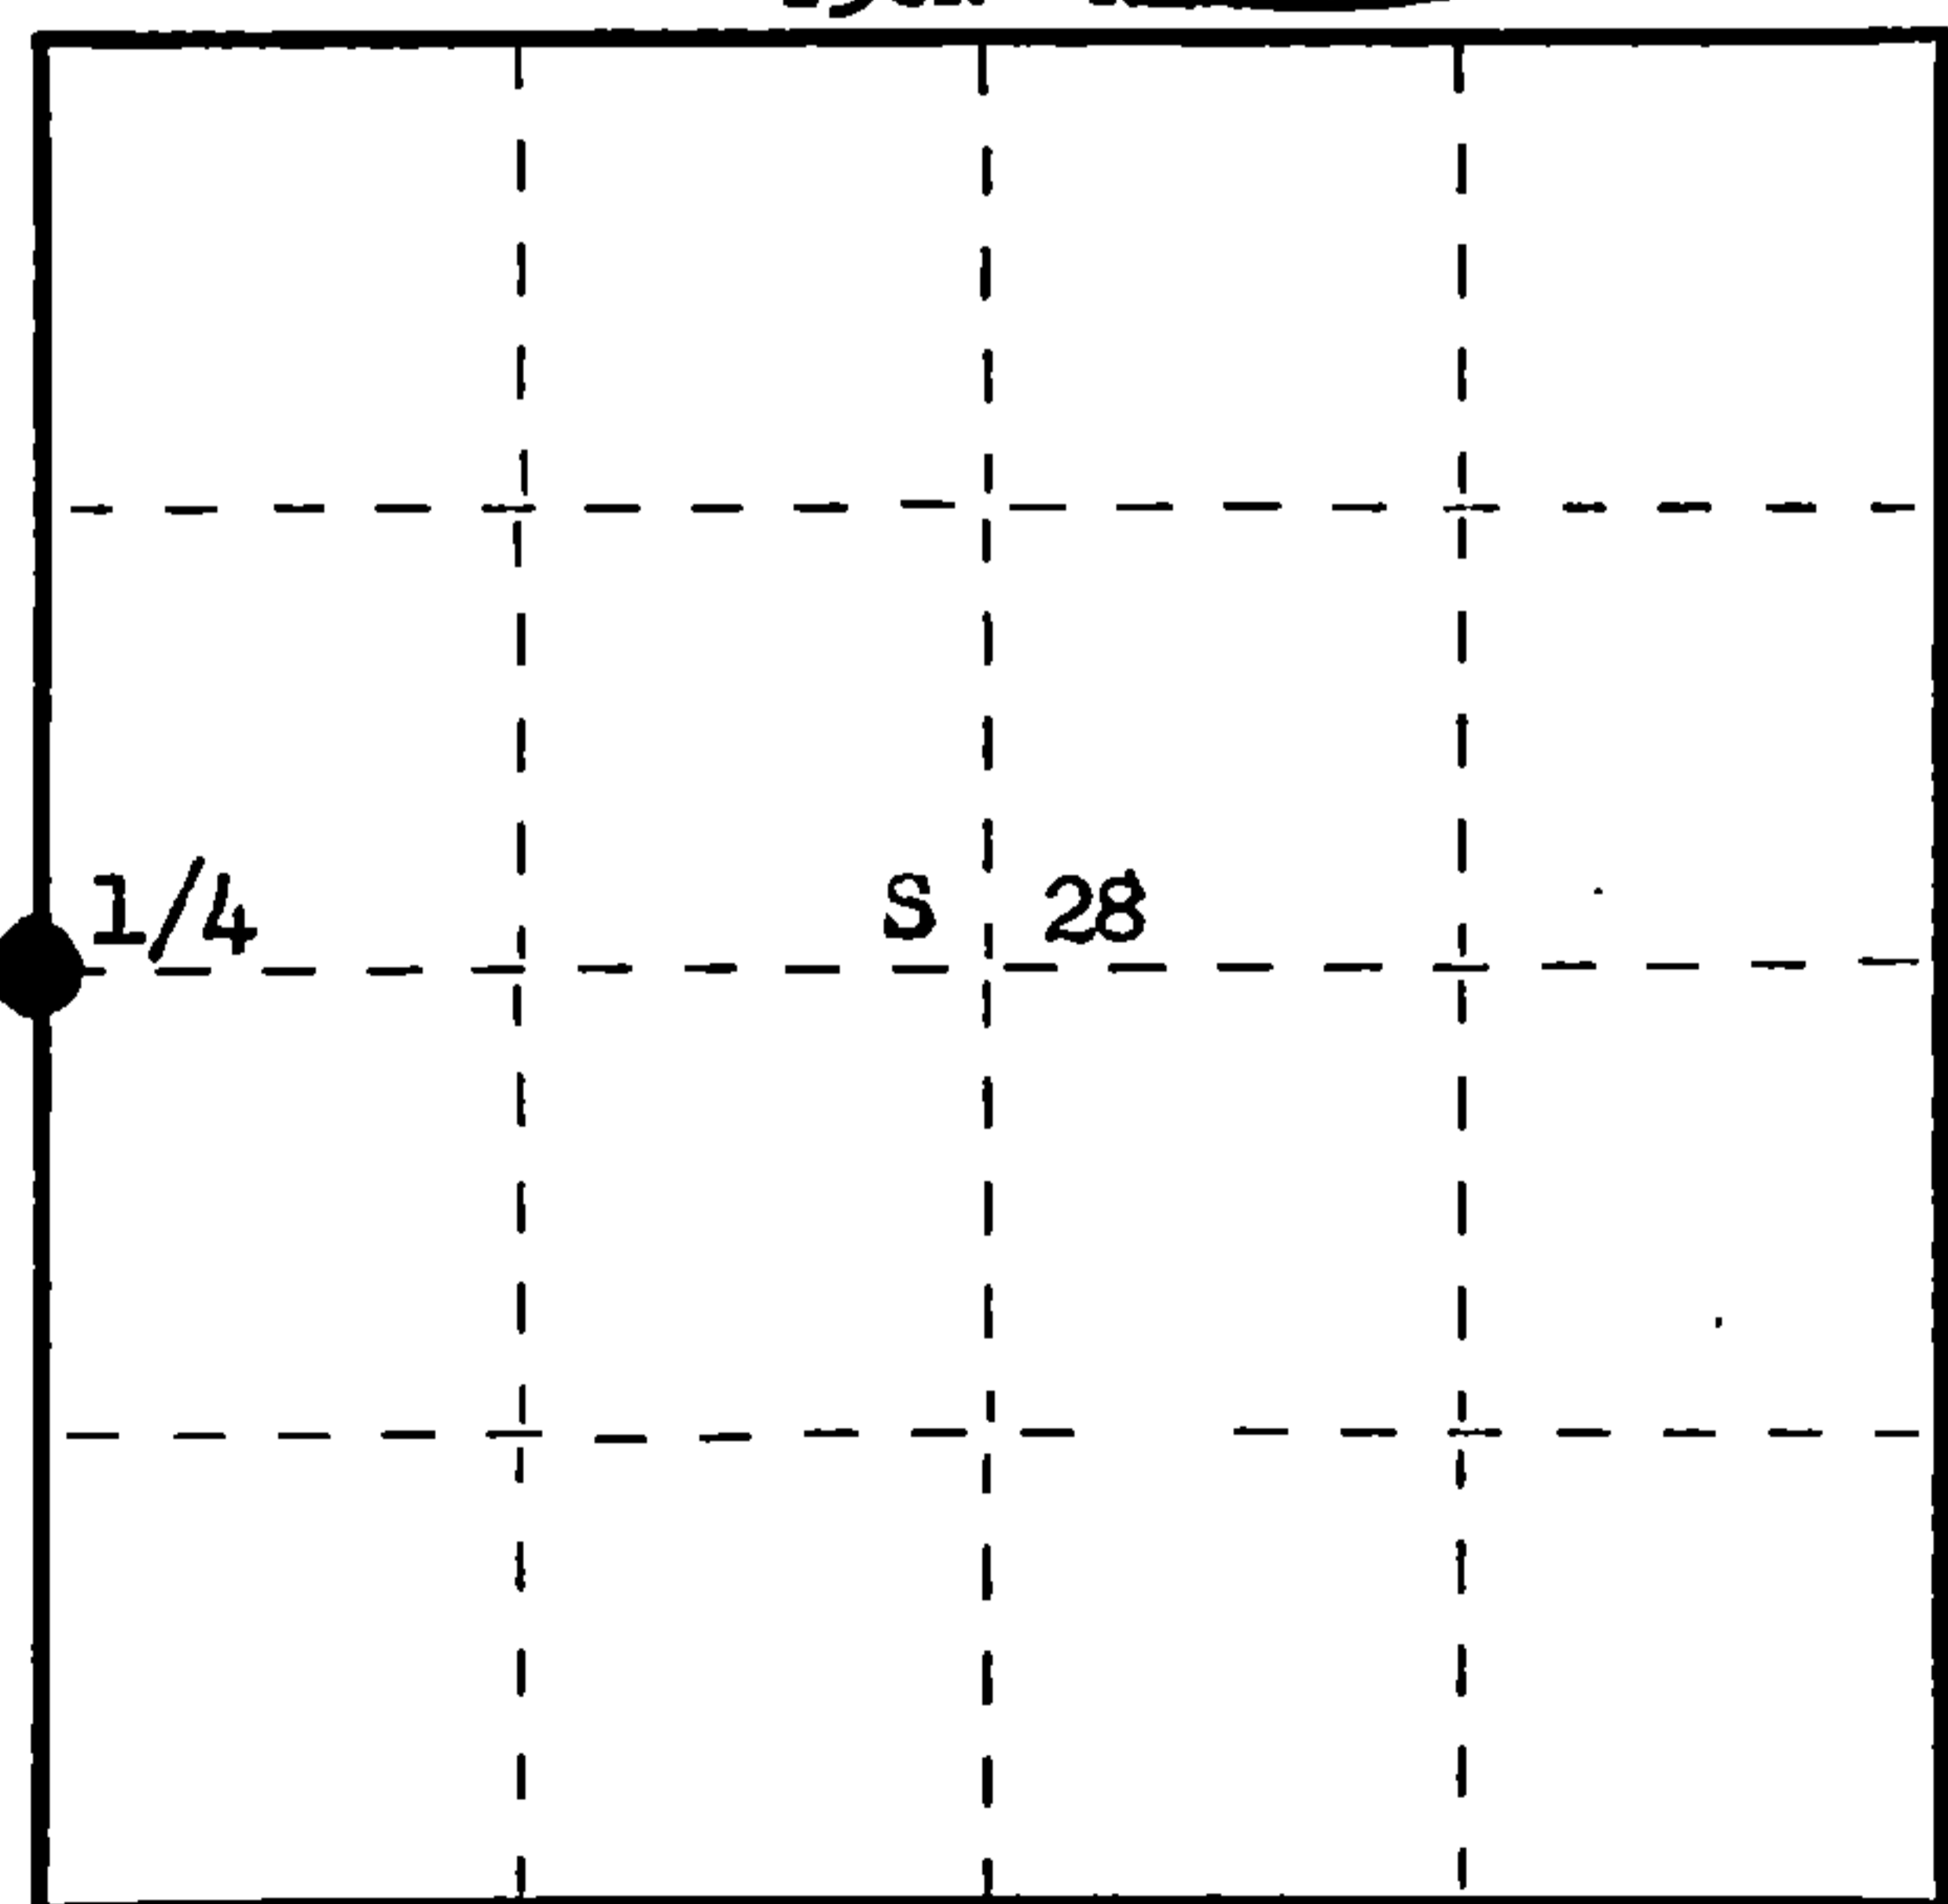

○ = Corner monument restored.

History of original corner establishment:

Original corner established by Wm. E. Dougherty, Deputy Surveyor, in 1859, from which Birch 10" bears S86°E 17 lks and Birch 8" bears N71°W 18 lks.

State Highway Engineers tied to this 1/4 corner during survey for relocation of Highway "8".

Description of corner evidence found:

Recovered 7" yellow right of way post set for 1/4 corner.

No record of any bearing trees. Distance to North right of way line (112') checks records on highway plat.

Computed traverse distance from Section Corner 28, 29, 32, 33 is 40.65 chains, bearing N 0° 19' E.

Description of monument and accessories I established to perpetuate the original location of this corner.

Set 2 1/2" Berntsen A-1 Federal Monument 30 lks West for witness corner. Monument projects 8" above ground. Cap stamped.

NBTs - Sugar 6" S66°E 107.7 lks, scribed 1/4 BT.

Power Pole #MB 69 - PP 35 N 44° W 9.0 lks.

Pipe and BT painted blue.

T36N R12E

W. C.

S498 1/4 29/28 1976

E 30 lks. to Cor.

Dated at Rhineland, Wis., this 21st day of June, 1976

Signature Philip T. Hansen Title Registered Land Surveyor Registration No. S-498  
(County Surveyor, Registered Land Surveyor, or other duly authorized official)

Office of Register of Deeds, County of Forest, I hereby certify that the within instrument was filed in this office for record on the 22nd day of June, 1976 at 3:45 o'clock P. M.

Eugene Stutzman  
(Register of Deeds)

DOCUMENT NUMBER

**109502**

By \_\_\_\_\_ Deputy

43612292000