

CERTIFIED LAND CORNER RESTORATION

Index No. X-5

State of Wisconsin }
County of Forest } ss.

History of original corner establishment: Original Corner established by Wm. E. Dougherty, Deputy Surveyor, in 1859, from which Birch 9" bears S 73° W 10 lks and Birch 10" bears N 77° E 25 lks.


I Philip T. Hansen, do hereby certify that on the 9th day of August, 1976, I ~~found~~ established ~~at~~ the Quarter corner of Section 31 and 32 Township 36, North, Range 12 East, Fourth Principal Meridian, as described hereon; and that from this evidence I established a new monument and accessories as described hereon to perpetuate the original location of this corner.

Resident witnesses:

Glen Barker

Jim Claflin

Herb Wagoner

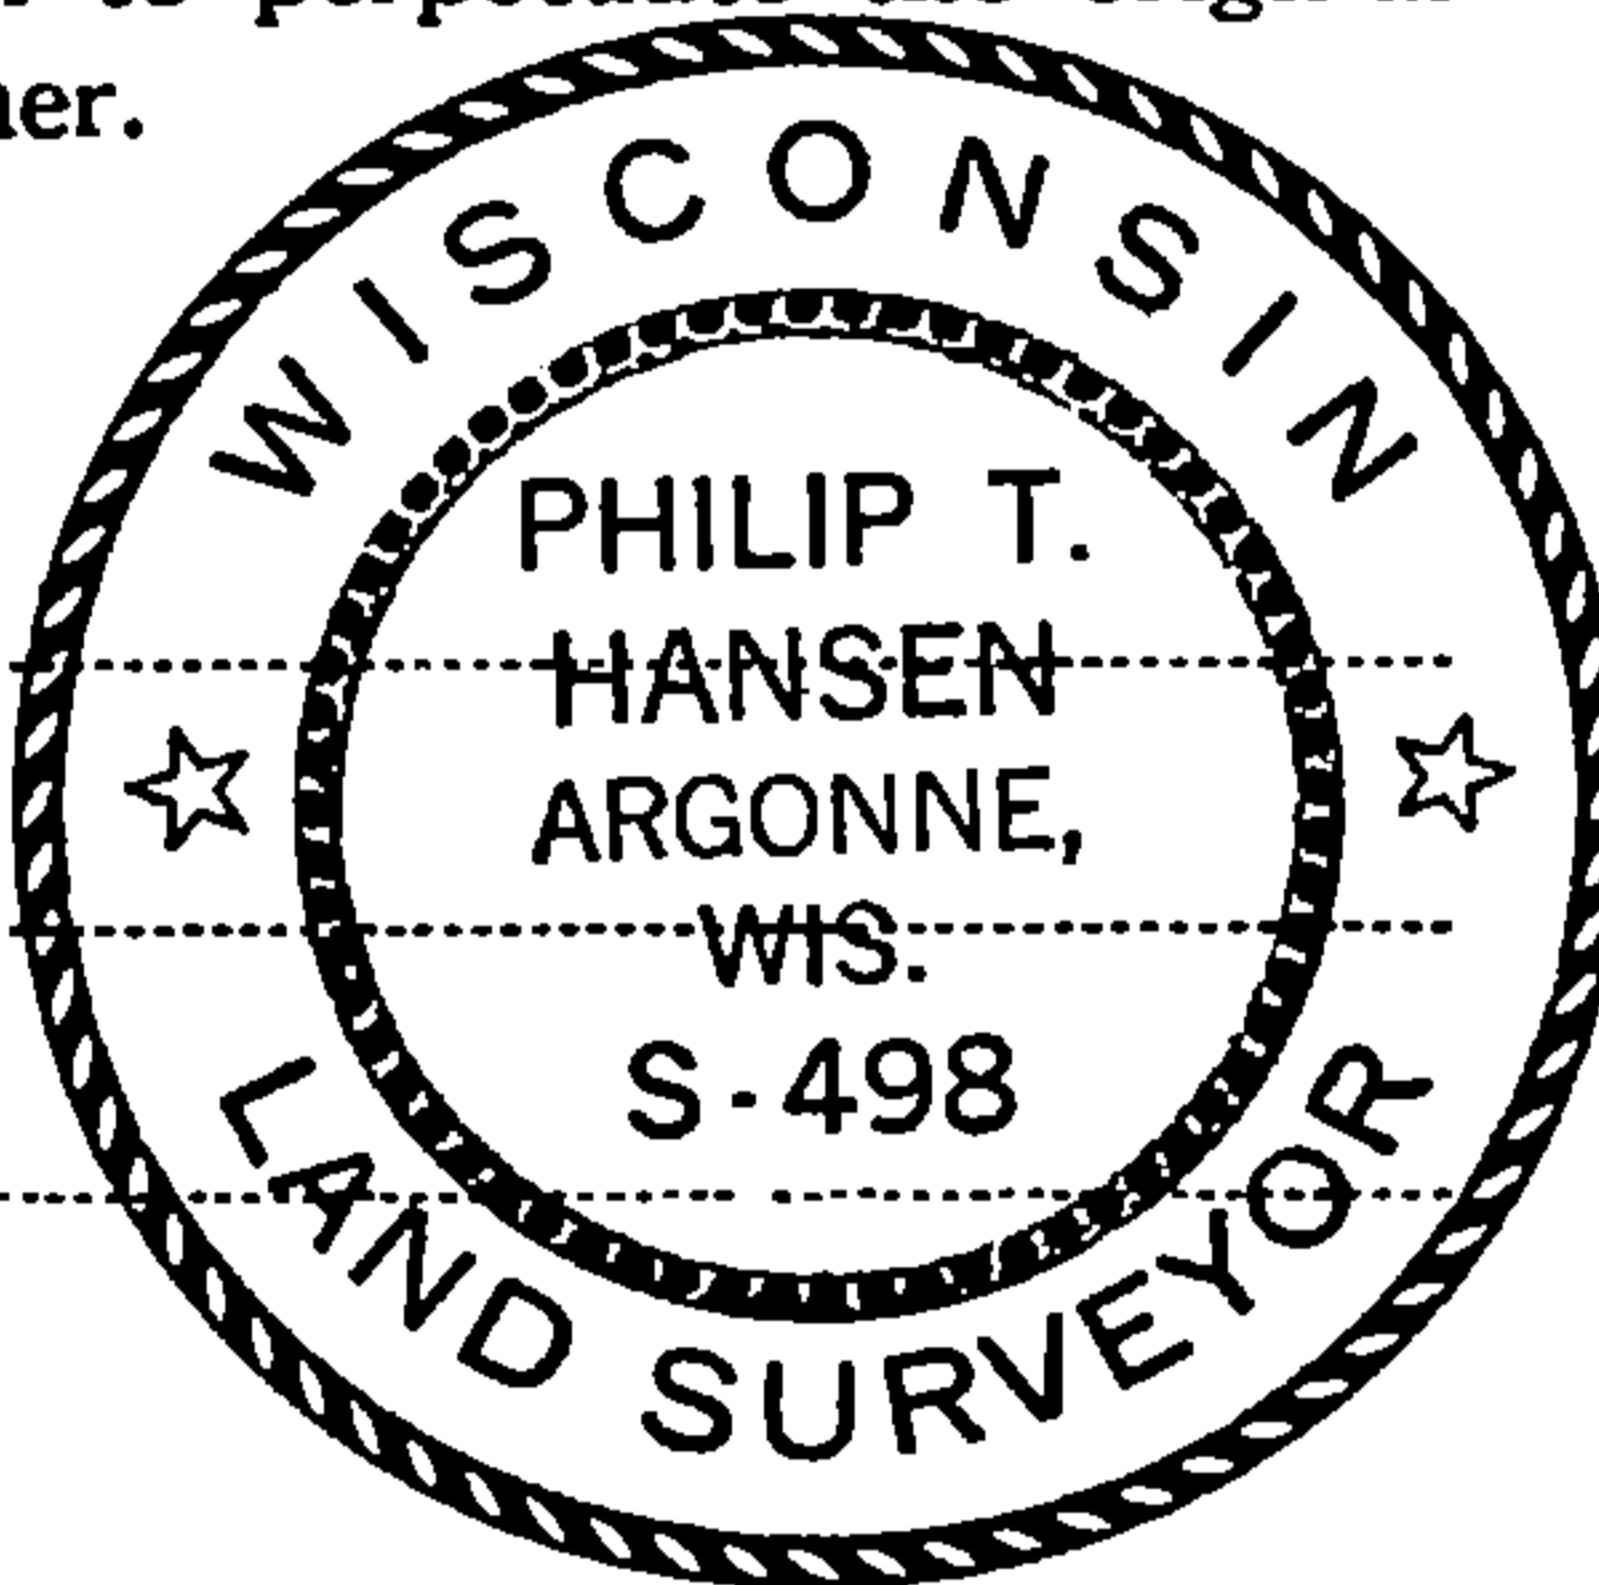


Description of corner evidence found: No evidence of this Corner found. Corner re-established from testimony from E.R. Cole, who witnessed the original Corner and who helped remove the original BTs for road construction. A house was built in 1918, while Corner still existed, just South of the E-W 1/4 line. This house is still standing. Cole stated that he could stand in the West window and observe the corner post standing just North of the extended E-W line of north side of house. The corner and BTs were later removed for road construction of town road south. The road was built on the section line.

Description of monument and accessories I established to perpetuate the original location of this corner.

Set a RR spike in center line of Cole Road at point shown and selected 39.229 chains S 1° 56' 49" E of Section Corner 29, 30, 31 and 32.
Set a 2 1/2" Berntsen A-1 federal monument 160 lks east, cap stamped.
Monument projects 12" above ground.
NETs - Sugar 8" N 55° E 1.376 chs, scribed 1/4 BT.
BO - Power pole N 88° W 22.6 lks.
NE Corner, Coles Barn S 32° W 1.535 chs.
Monument and BT painted blue.

T36N R12E
1/4 31 | 32
W. 160 lks to Cor.
S498-1976

FORM 985 H. C. MILLER CO., MILWAUKEE

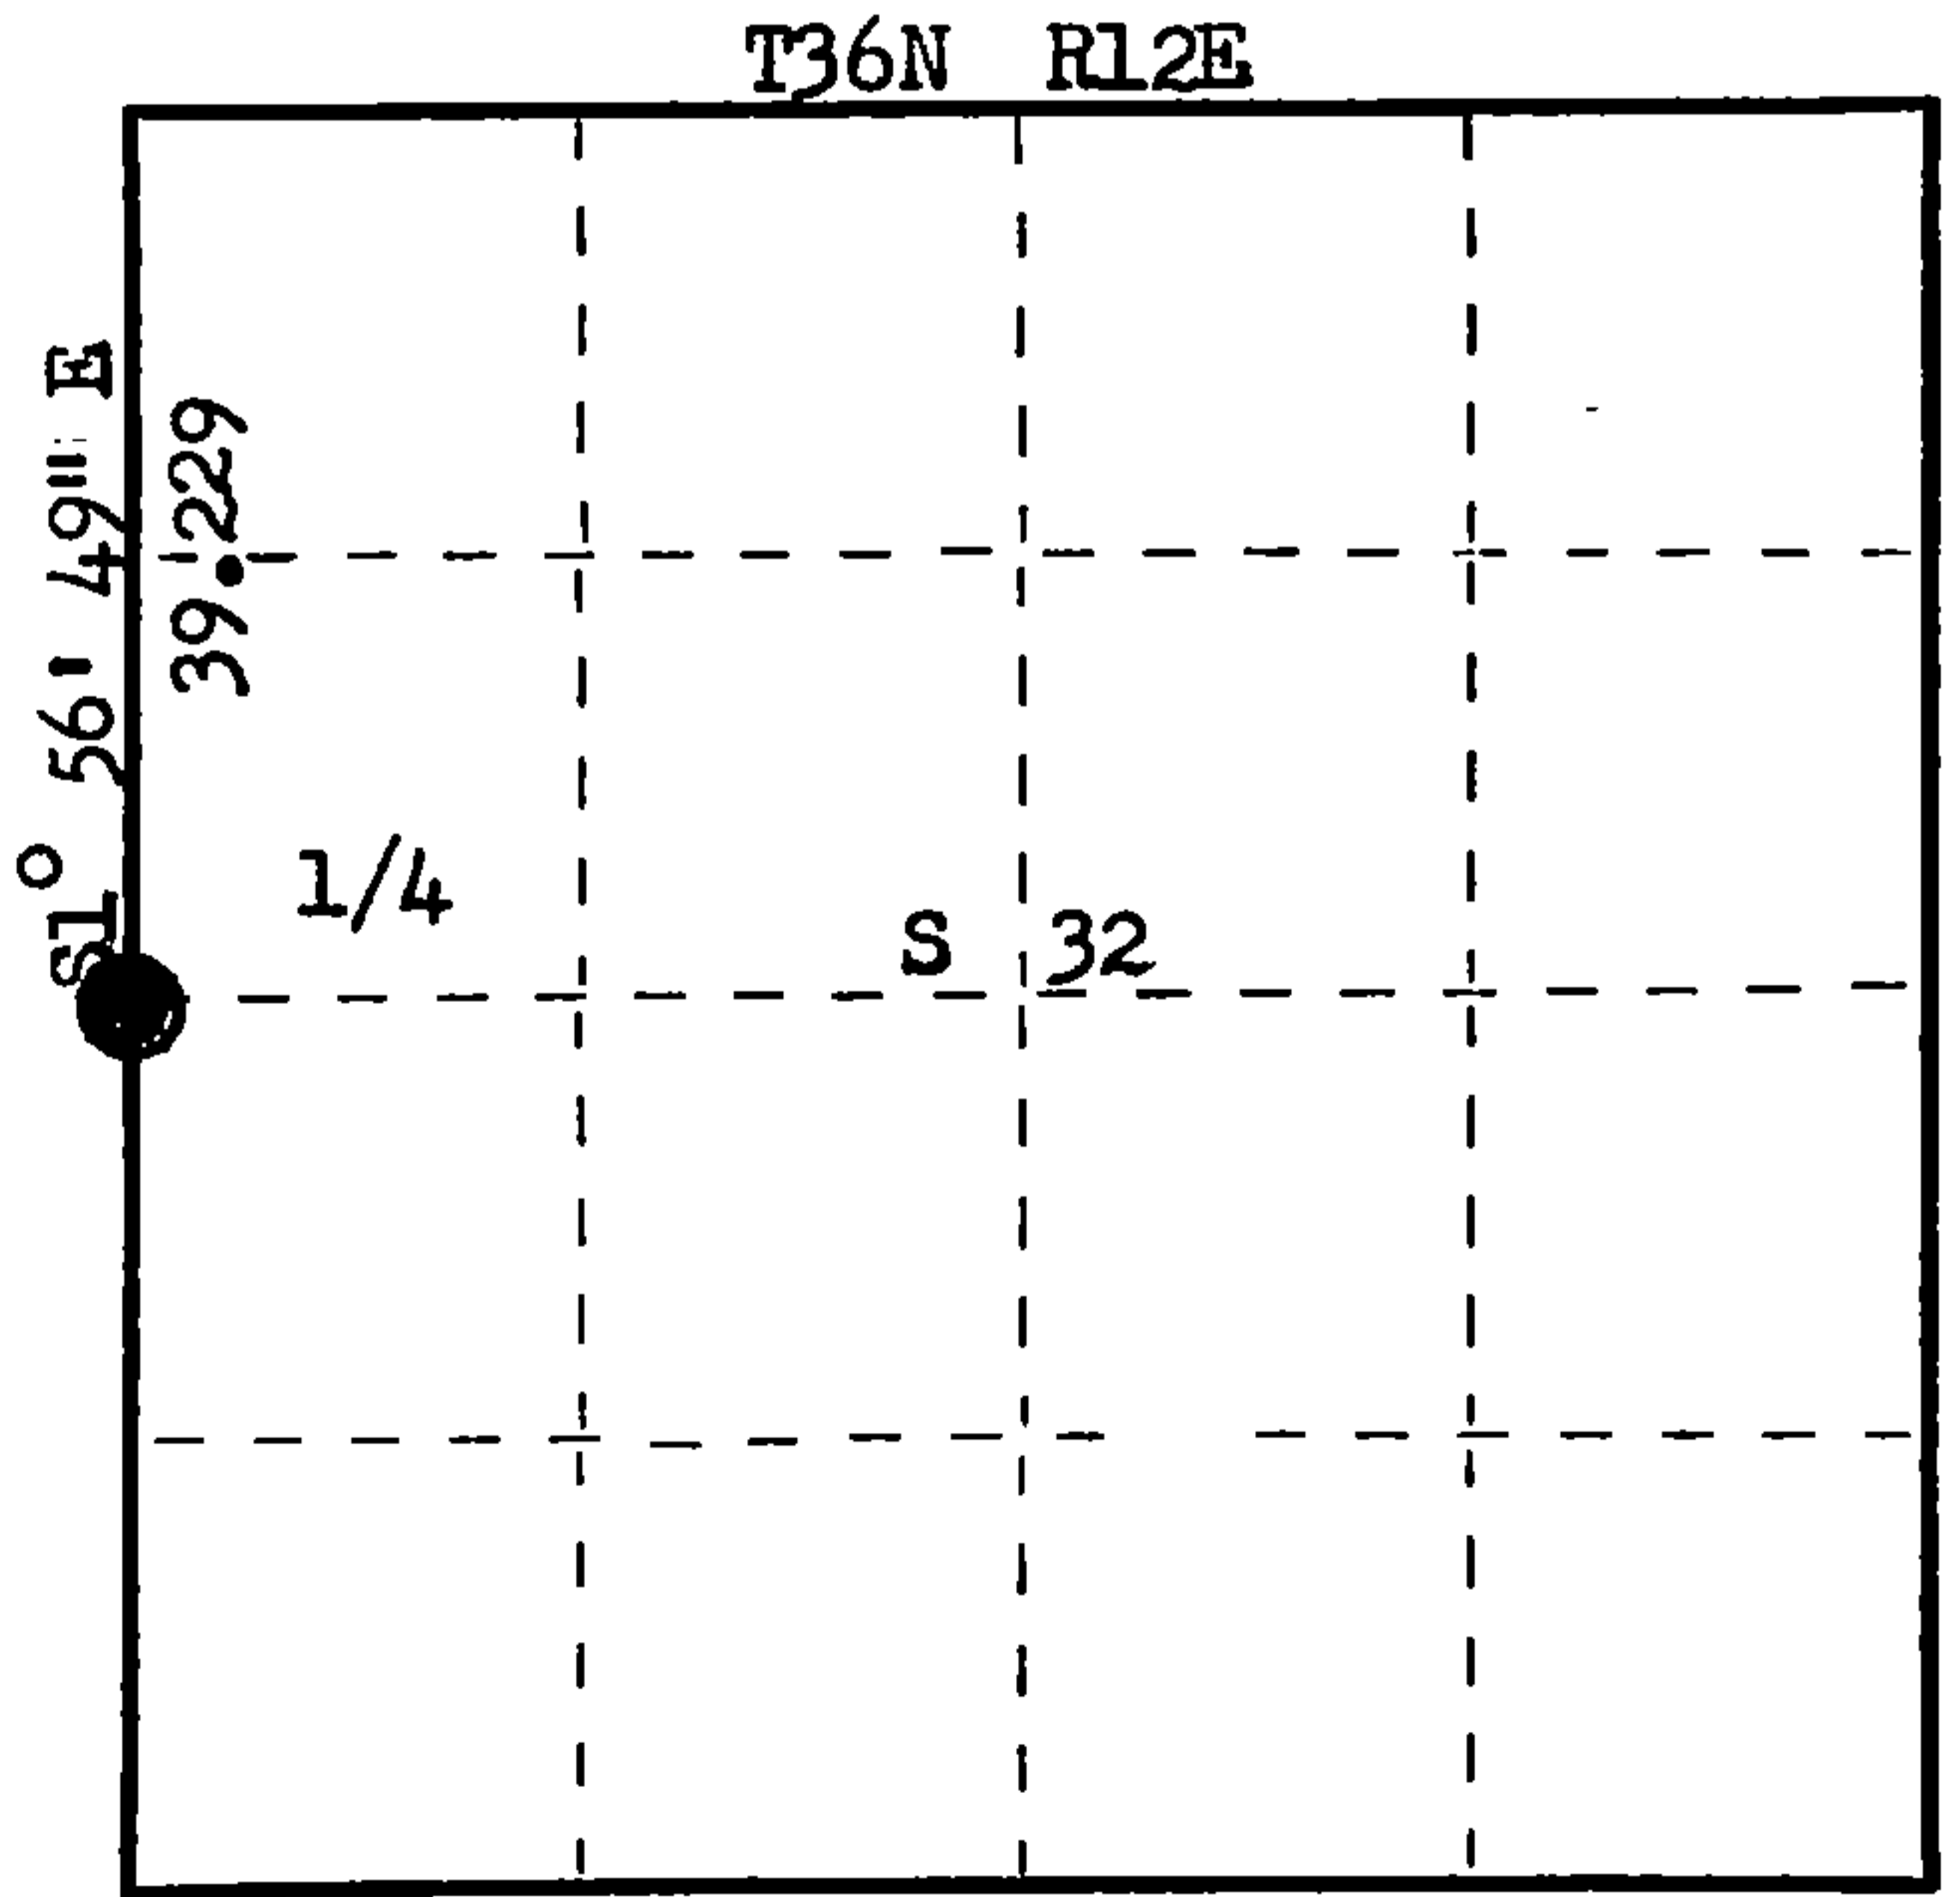

○ = Corner monument restored.

Dated at Rhineland, Wis., this 10th day of August, 1976

Signature Philip T. Hansen Title Registered Land Surveyor Registration No. S-498
(County Surveyor, Registered Land Surveyor, or other duly authorized official)

Office of Register of Deeds, County of Forest, I hereby certify that the within instrument was filed in this office for record on the 8th day of September, 1976 at 10 o'clock A. M.

Eugene Stutzman
(Register of Deeds)
By _____ Deputy

DOCUMENT NUMBER
110104

43012312000