

CERTIFIED LAND CORNER RESTORATION

Index No. Y-9

State of Wisconsin }
County of Forest } ss.


I Philip T. Hansen, do hereby
certify that on the 29th day
of June, 1976, I ~~found~~
~~recovered~~ established
corner of the S 1/16
corner of Section 32 and 33
Township 36, North, Range
12 East, Fourth Principal Meridian,
as described hereon; and that from this evidence
I established a new monument and accessories
as described hereon to perpetuate the original
location of this corner.

Resident witnesses:


Glen Barker

Jim Claflin

Herb Wagoner

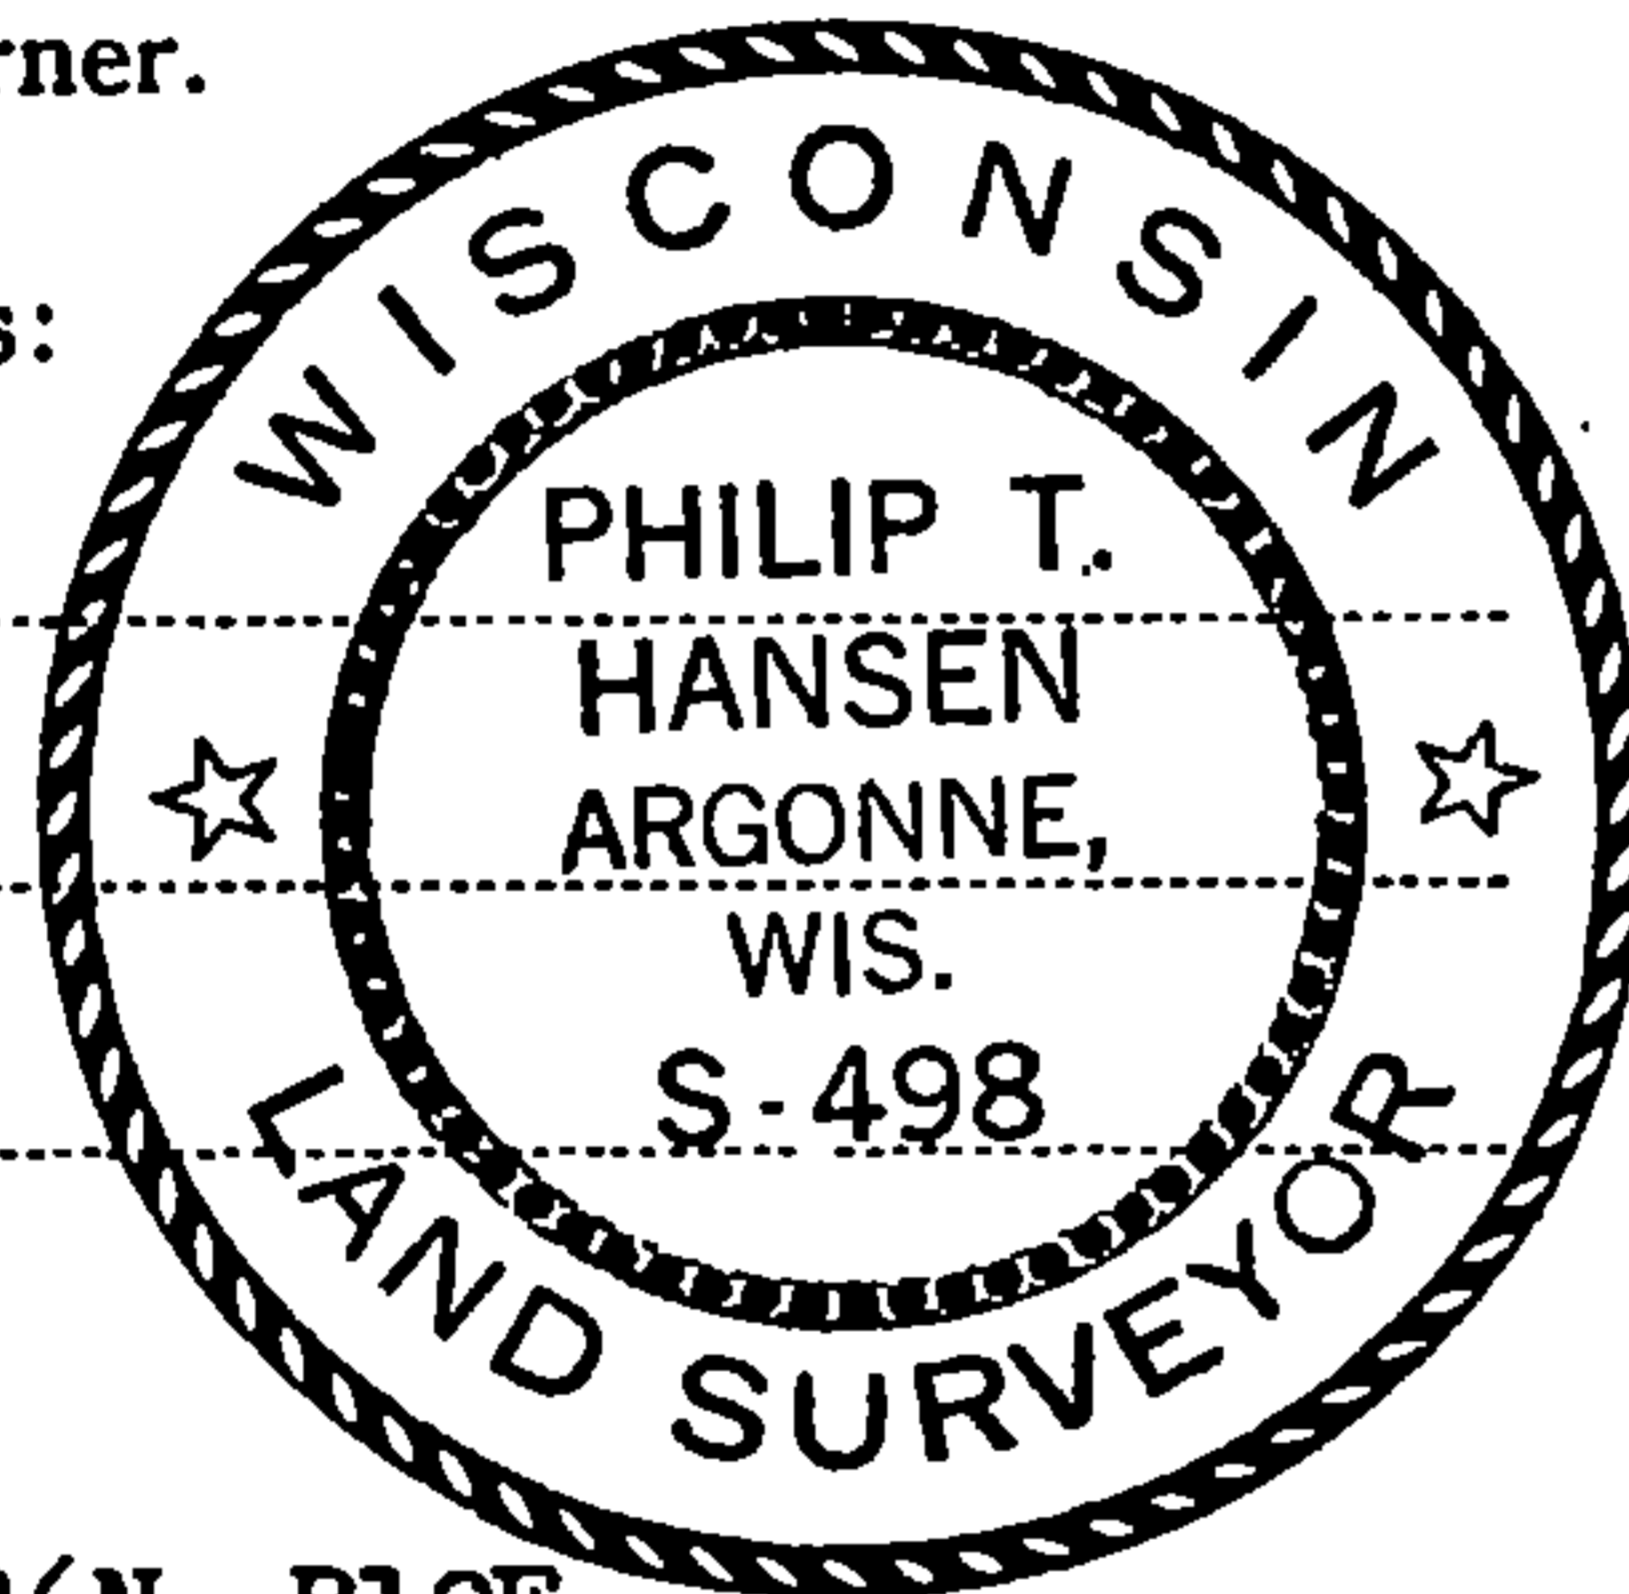

T36N R12E

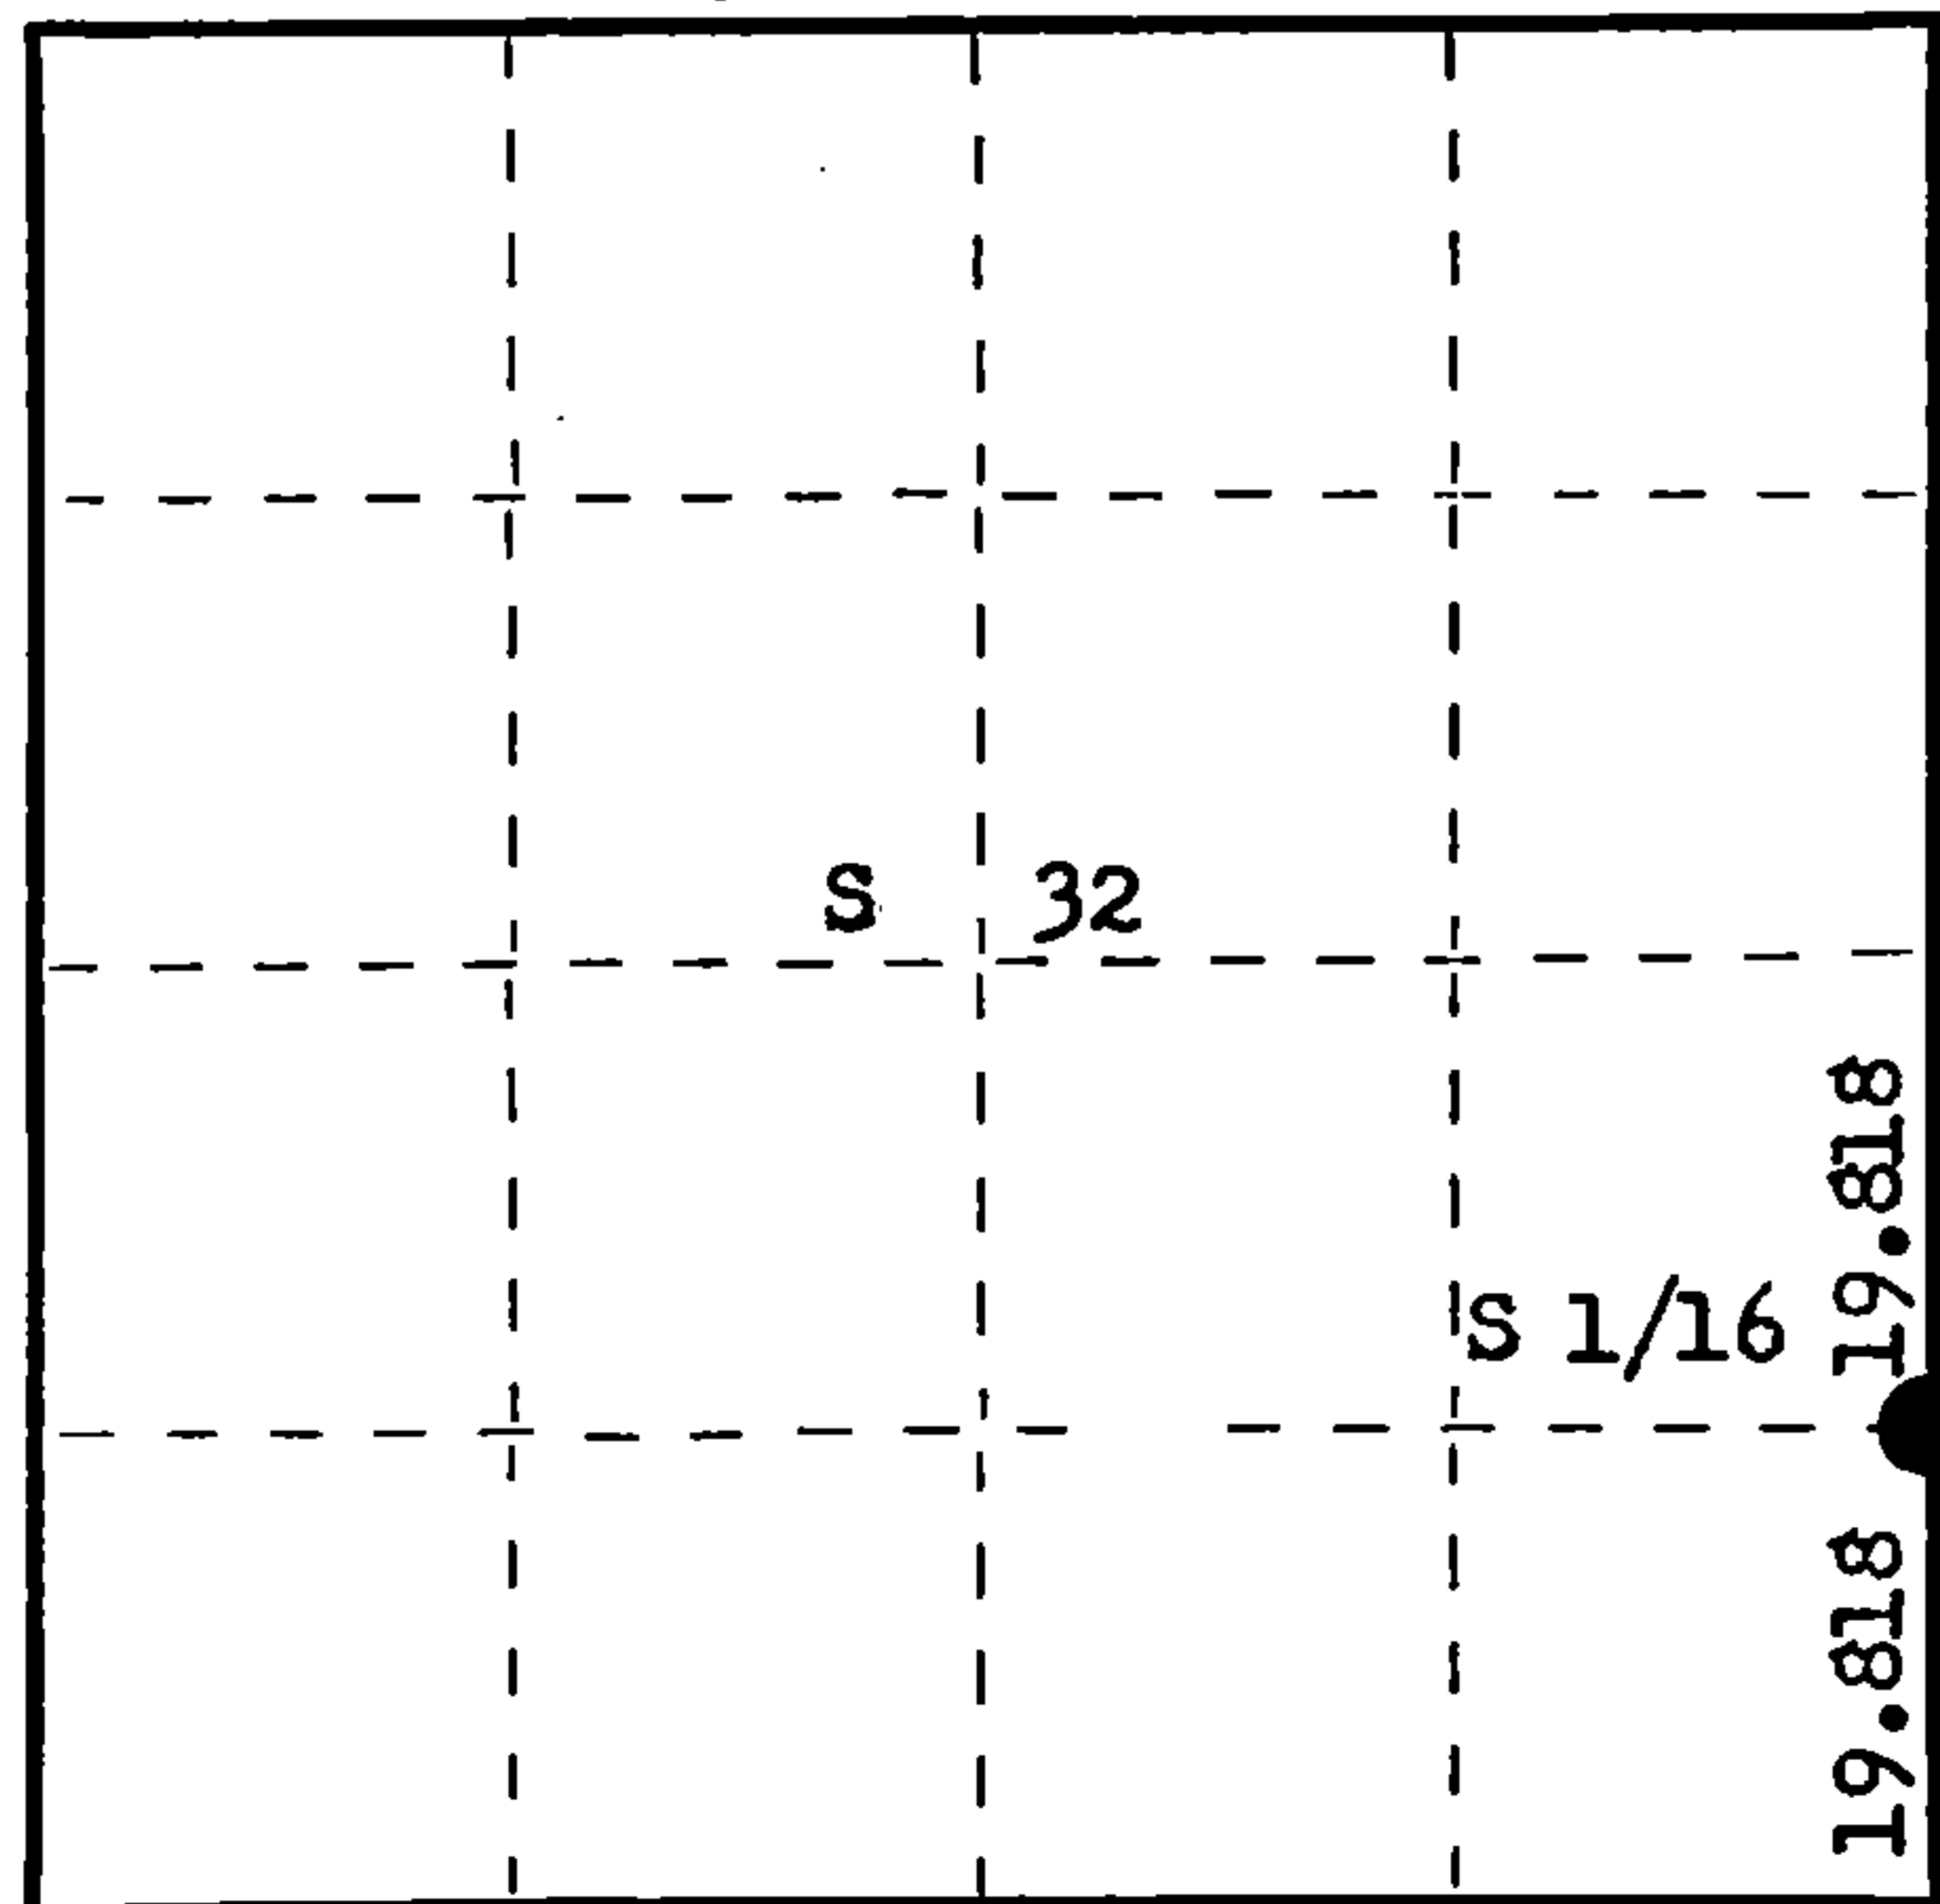

○ = Corner monument restored.

History of original corner establishment:

No records of any previous survey on file.

Description of corner evidence found: Unable to recover any evidence of any corner present.
Established Corner by proportional measurement between Section Corner 4, 5, 32 and 33
and Section Corner 28, 29, 32 and 33. Ran traverse line between said corners, computed
distance 79.272 chains, computed bearing N 2° 22' 55" E.

Set corner 19.818 chains, equidistant between 1/4 corner and Section Corner 32, 33, 5 and 4.

Description of monument and accessories I established to perpetuate the original location of this corner.
Set 1 1/2" iron pipe with 2" brass cap. Pipe projects 18" above ground. Cap stamped.

NBTs - Maple 6" N 3° E 115.5 lks, scribed 1/16 BT.
Maple 7" N 20° W 89.7 lks, scribed 1/16 BT.

S498
T36N R12E
S 1/16 32 | 33
CPI - 1976

Dated at Rhineland, Wis., this 6th day of July, 1976

Signature _____ Title Registered Land Surveyor Registration No. S-498
(County Surveyor, Registered Land Surveyor, or other duly authorized official)

Office of Register of Deeds, County of Forest, I hereby certify that the within
instrument was filed in this office for record on the 23rd day of July, 1976
at 3:00 o'clock P. M.

EUGENE STATEZNY

(Register of Deeds)

DOCUMENT NUMBER

109755

By Eileen Schmidt Deputy

FORM 985 H. C. MILLER CO., MILWAUKEE

43612321000