

CERTIFIED LAND CORNER RESTORATION

Index No. Y-7

State of Wisconsin }
County of Forest } ss.


I Philip T. Hansen, do hereby certify that on the 22nd day of March, 1977, I ~~found~~ established SC 1/16 corner of Section 32 Township 36, North, Range 12 East, Fourth Principal Meridian, as described hereon; and that from this evidence I established a new monument and accessories as described hereon to perpetuate the original location of this corner.

Resident witnesses:


Glen Barker

Jim Claflin

Herb Wagoner

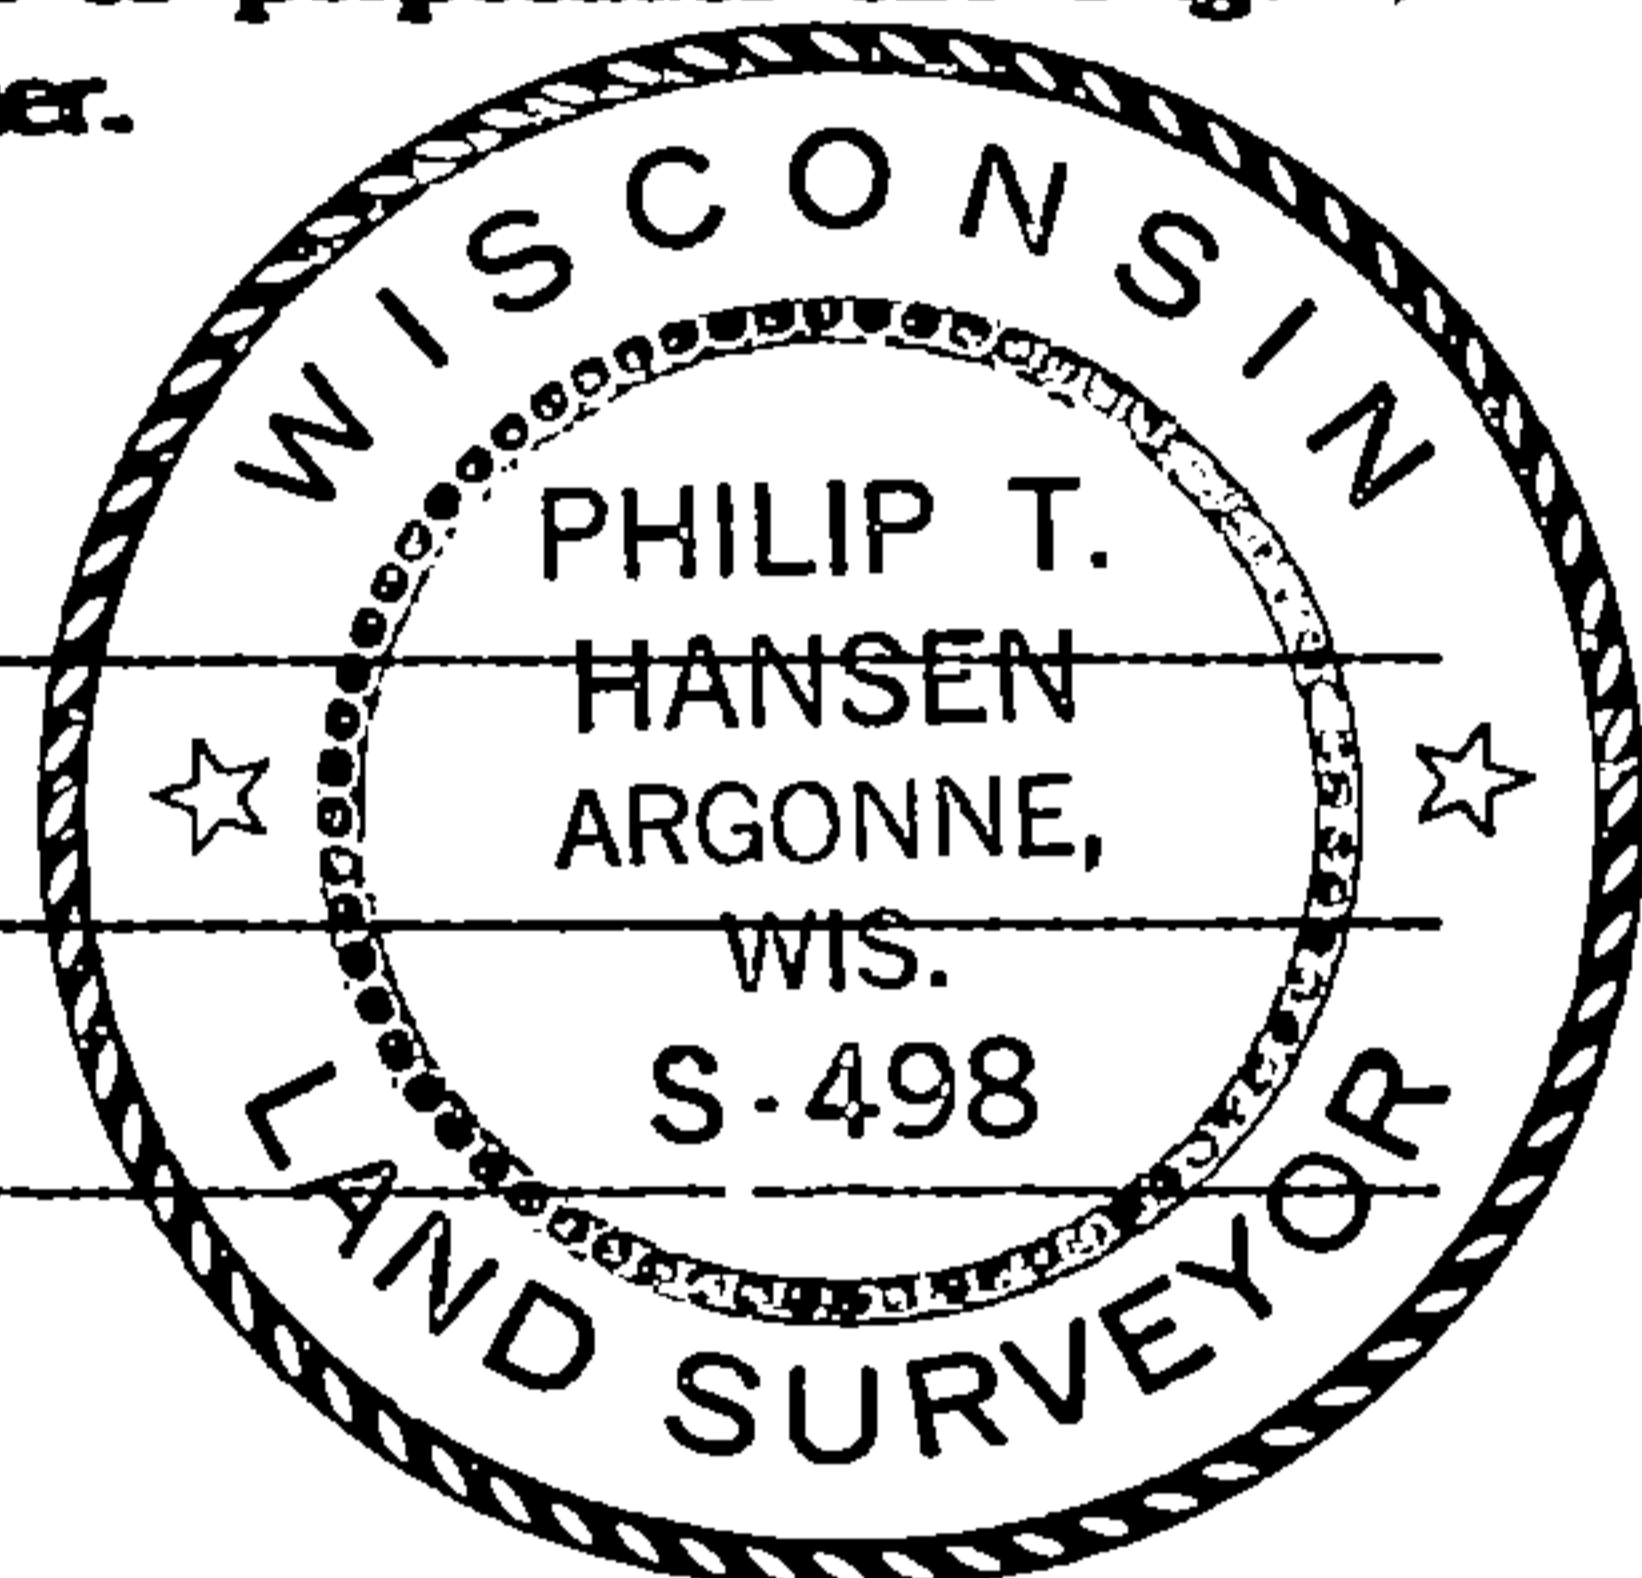

FORM 885
Wisconsin Land Surveyors & Engineers, Inc.
Madison, Wisconsin

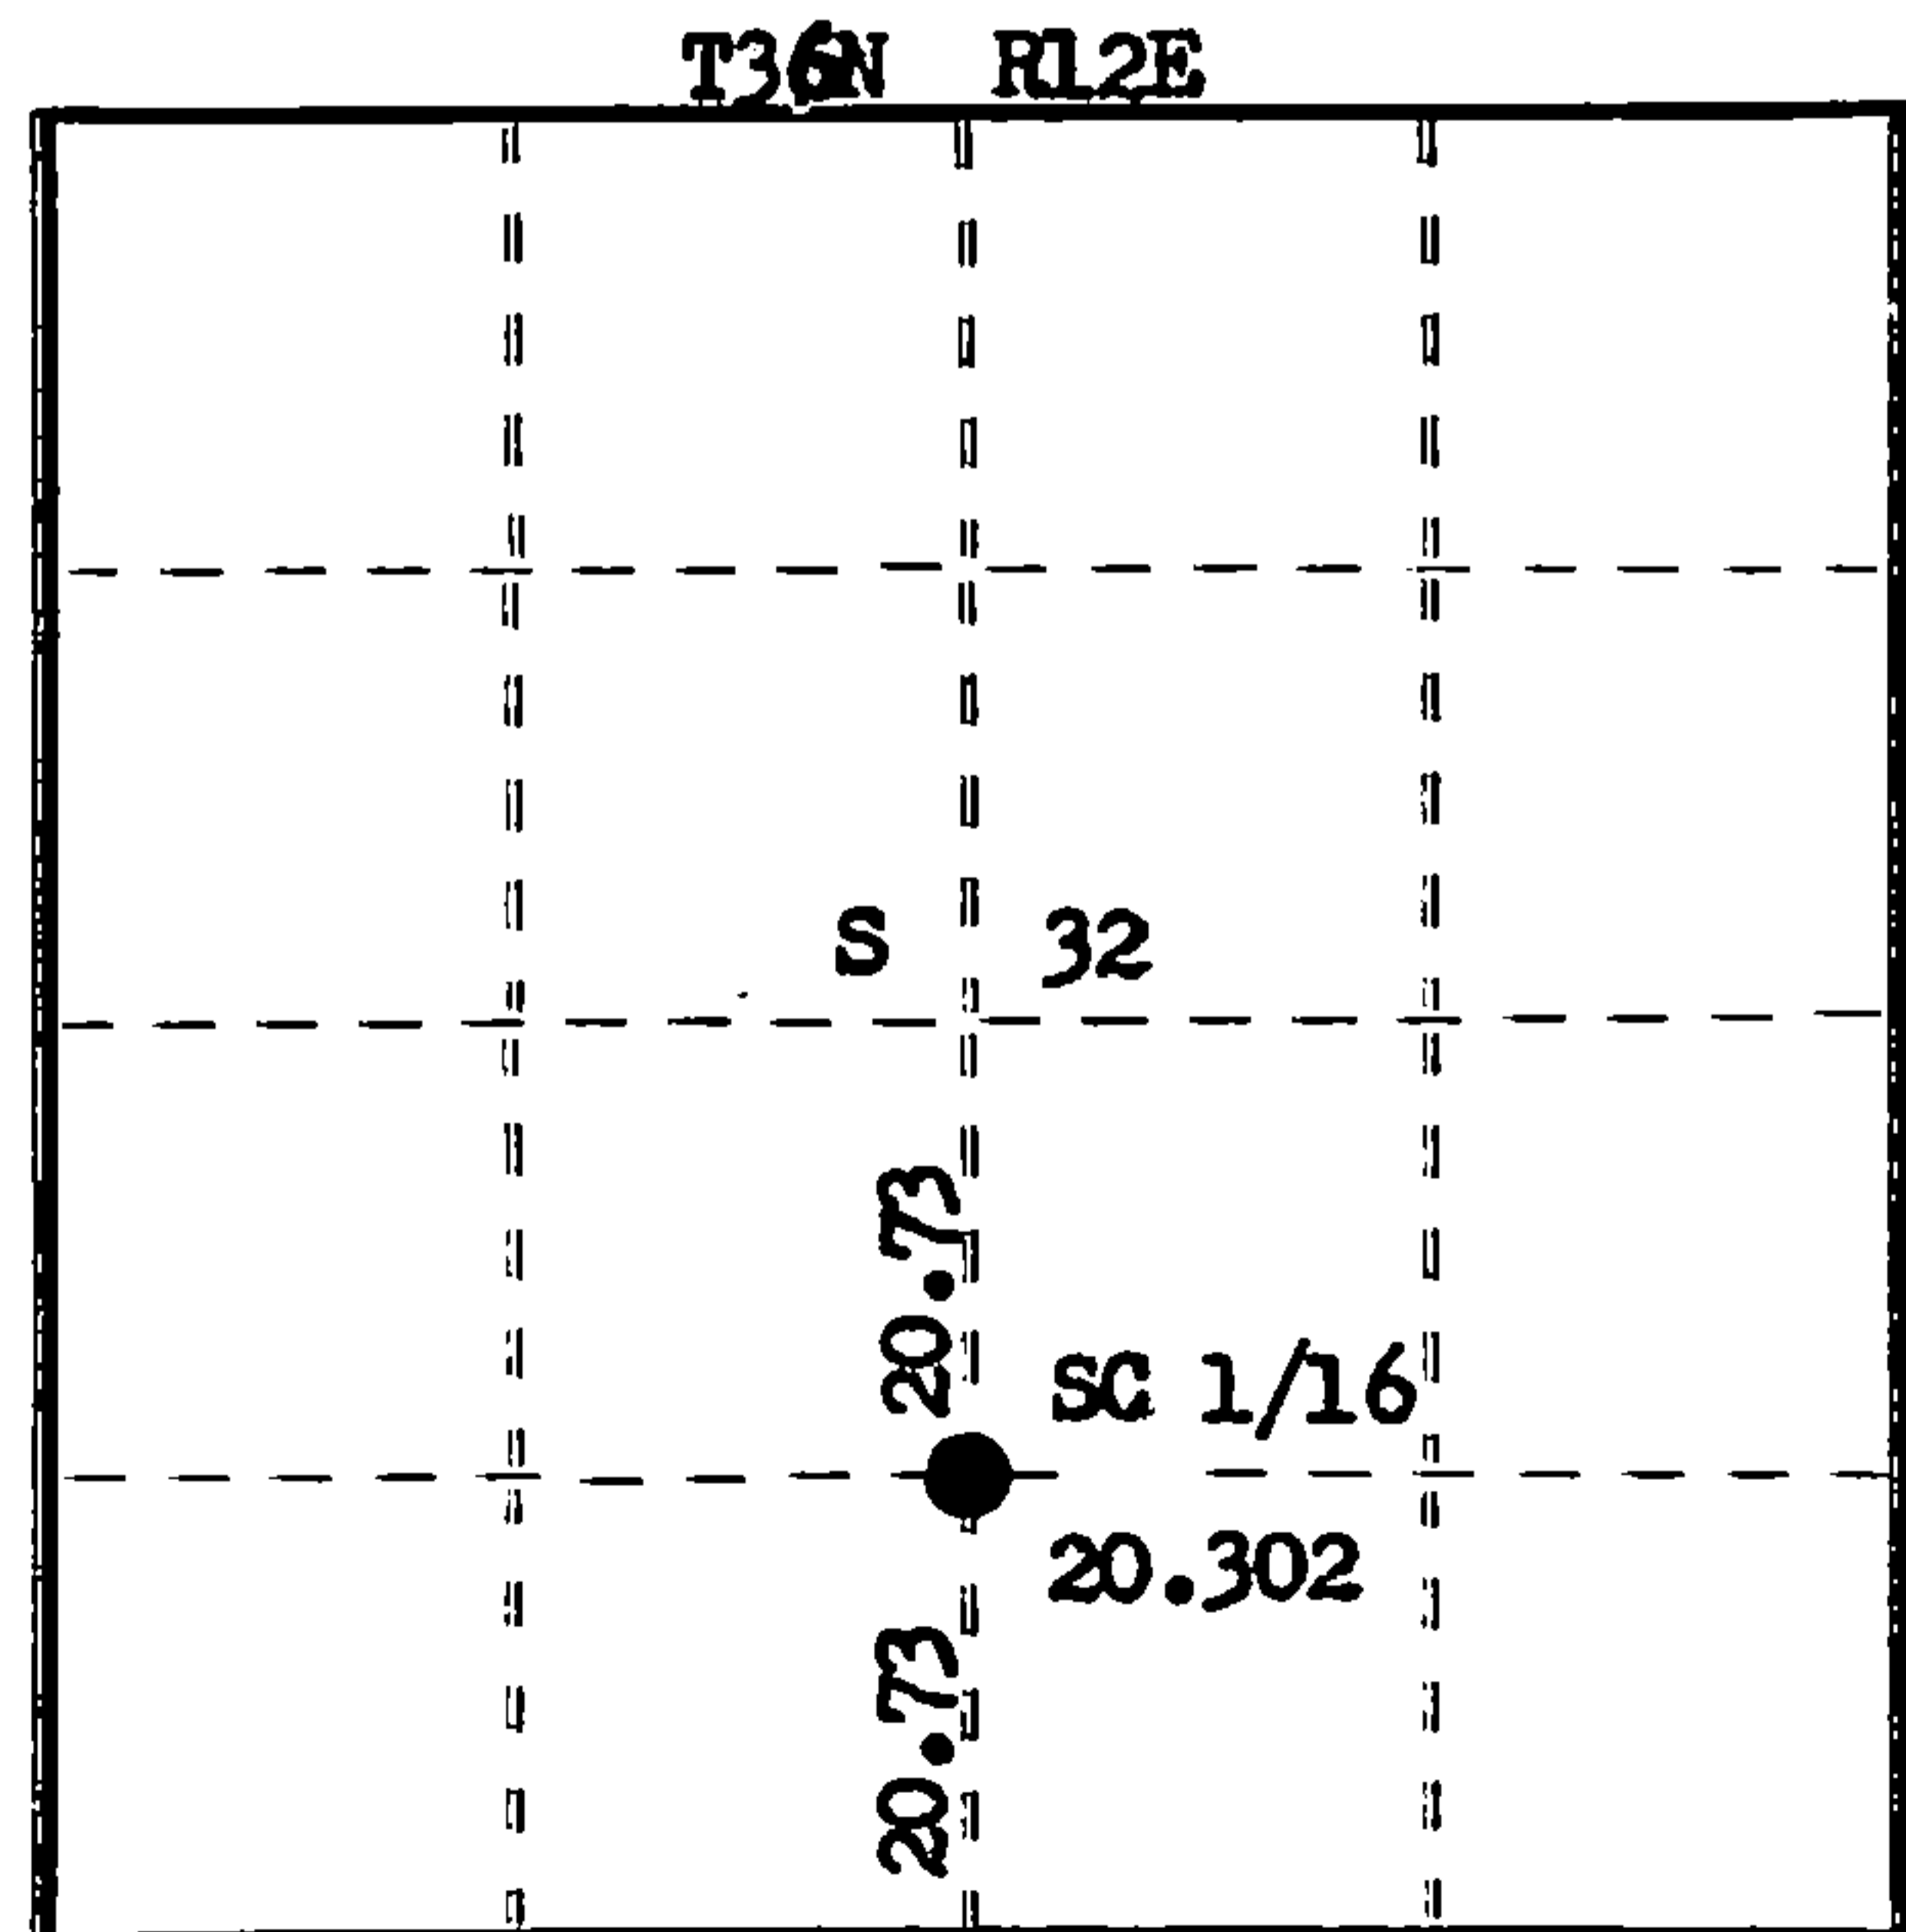

○ = Corner monument restored.

History of original corner establishment:

No record or evidence of this corner having been previously established.

Description of corner evidence found:

Corner established by traverse and computation from previously established E 1/16 and W 1/16 and N-S 1/4 line. Set SC 1/16 corner at 20.43 chains S 0° 33' 28" W from C 1/4 corner, equidistant to S 1/4 corner.

Description of monument and accessories I established to perpetuate the original location of this corner.

Set 1 1/2" iron pipe with brass cap stamped:
Monument projects 24" above ground.

Marked NBTs - Sugar 12" N46°W, 34.8 links, scribed 1/16 BT.
Sugar 8" S43°W, 18.8 links, scribed 1/16 BT.

S498
T36N R12E
SC 1/16 S | 32
CPI-1977

Dated at Rhineland, Wis., this 6th day of April, 1977.

Signature Philip T. Hansen Title Registered Land Surveyor Registration No. S-498
(County Surveyor, Registered Land Surveyor, or other duly authorized official)

Office of Register of Deeds, County of Forest, I hereby certify that the within instrument was filed in this office for record on the 5th day of May, 1977 at 4:00 o'clock P. M.

Eugene J. Statensky
(Register of Deeds)
By _____ Deputy

DOCUMENT NUMBER
111372

H3612321020