

CERTIFIED LAND CORNER RESTORATION

Index No. WX-6

State of Wisconsin }  
County of Forest } ss.

History of original corner establishment:

No records of any corner having been previously established.

I Philip T. Hansen, do hereby certify that on the 17th day of March, 1977, I ~~found~~ established ~~location~~ of the SC 1/32 corner of N-S 1/4 line - NW 1/4 Sec. 32 Township 36, North, Range 12 East, Fourth Principal Meridian, as described hereon; and that from this evidence I established a new monument and accessories as described hereon to perpetuate the original location of this corner.

Description of corner evidence found:


Established corner by traverse and computation of proportionate distance between WC 1/16 corner and NW 1/16 corner.  
Set corner at 9.833 chains, N 0° 41' 19" W of WC 1/16 corner and 9.833 chains S 0° 41' 19" E of the NW 1/16 corner.

Resident witnesses:

Glen Barker

Jim Claflin

Herb Wagoner

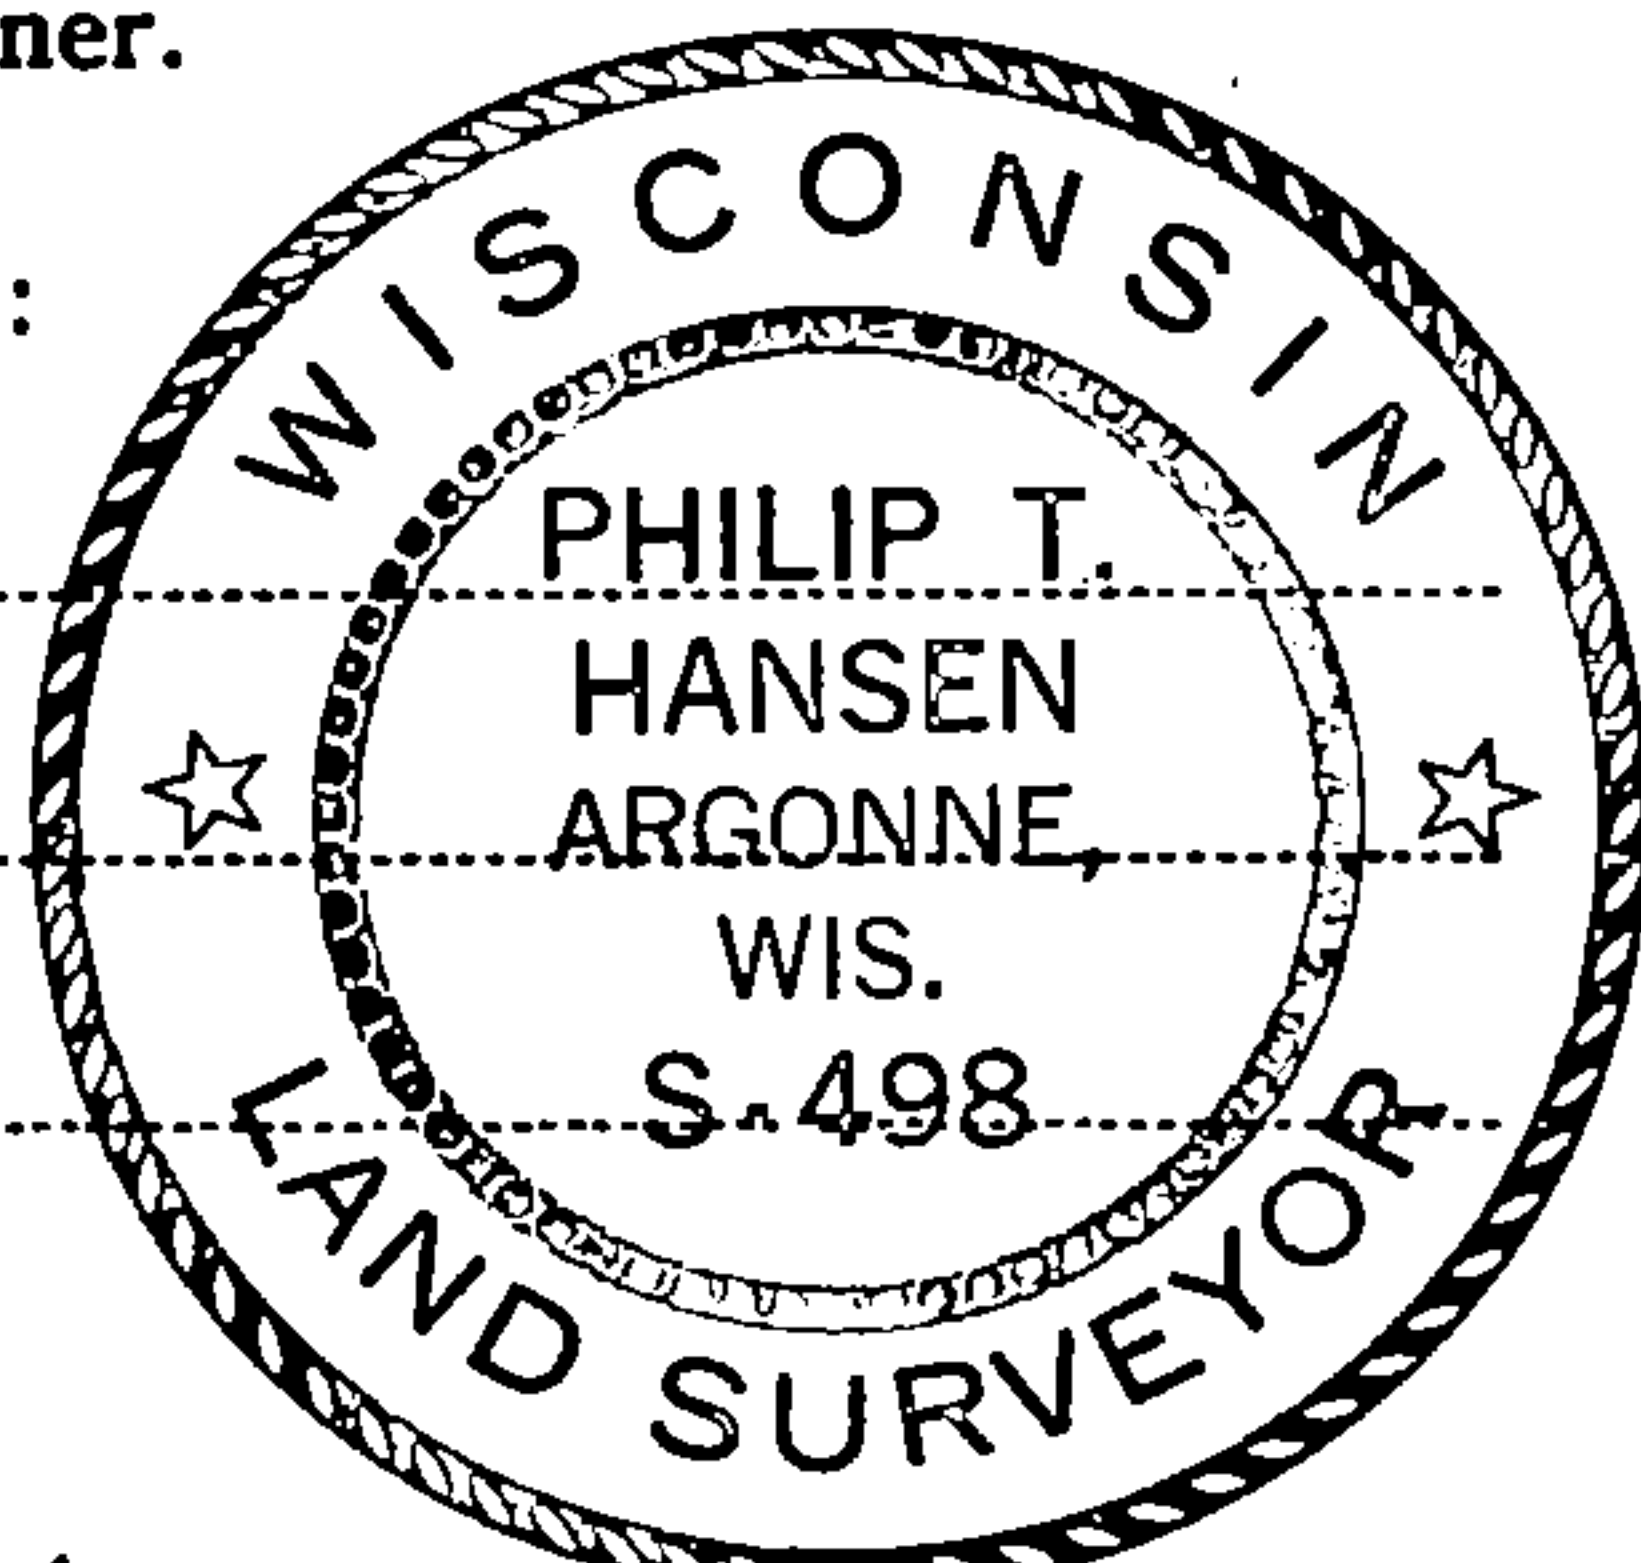


Description of monument and accessories I established to perpetuate the original location of this corner.

Set 1 1/2" iron pipe with 2" brass cap, stamped:  
Monument projects 8" above ground.  
Marked NBTs - Sugar 7" N 14° E, 18.3 links, scribed 1/32 BT.  
Sugar 6" S 36° E, 18.8 links, scribed 1/32 BT.

S498  
T36N RL2E  
1/32 S | 32  
CPI-1977

FORM 985

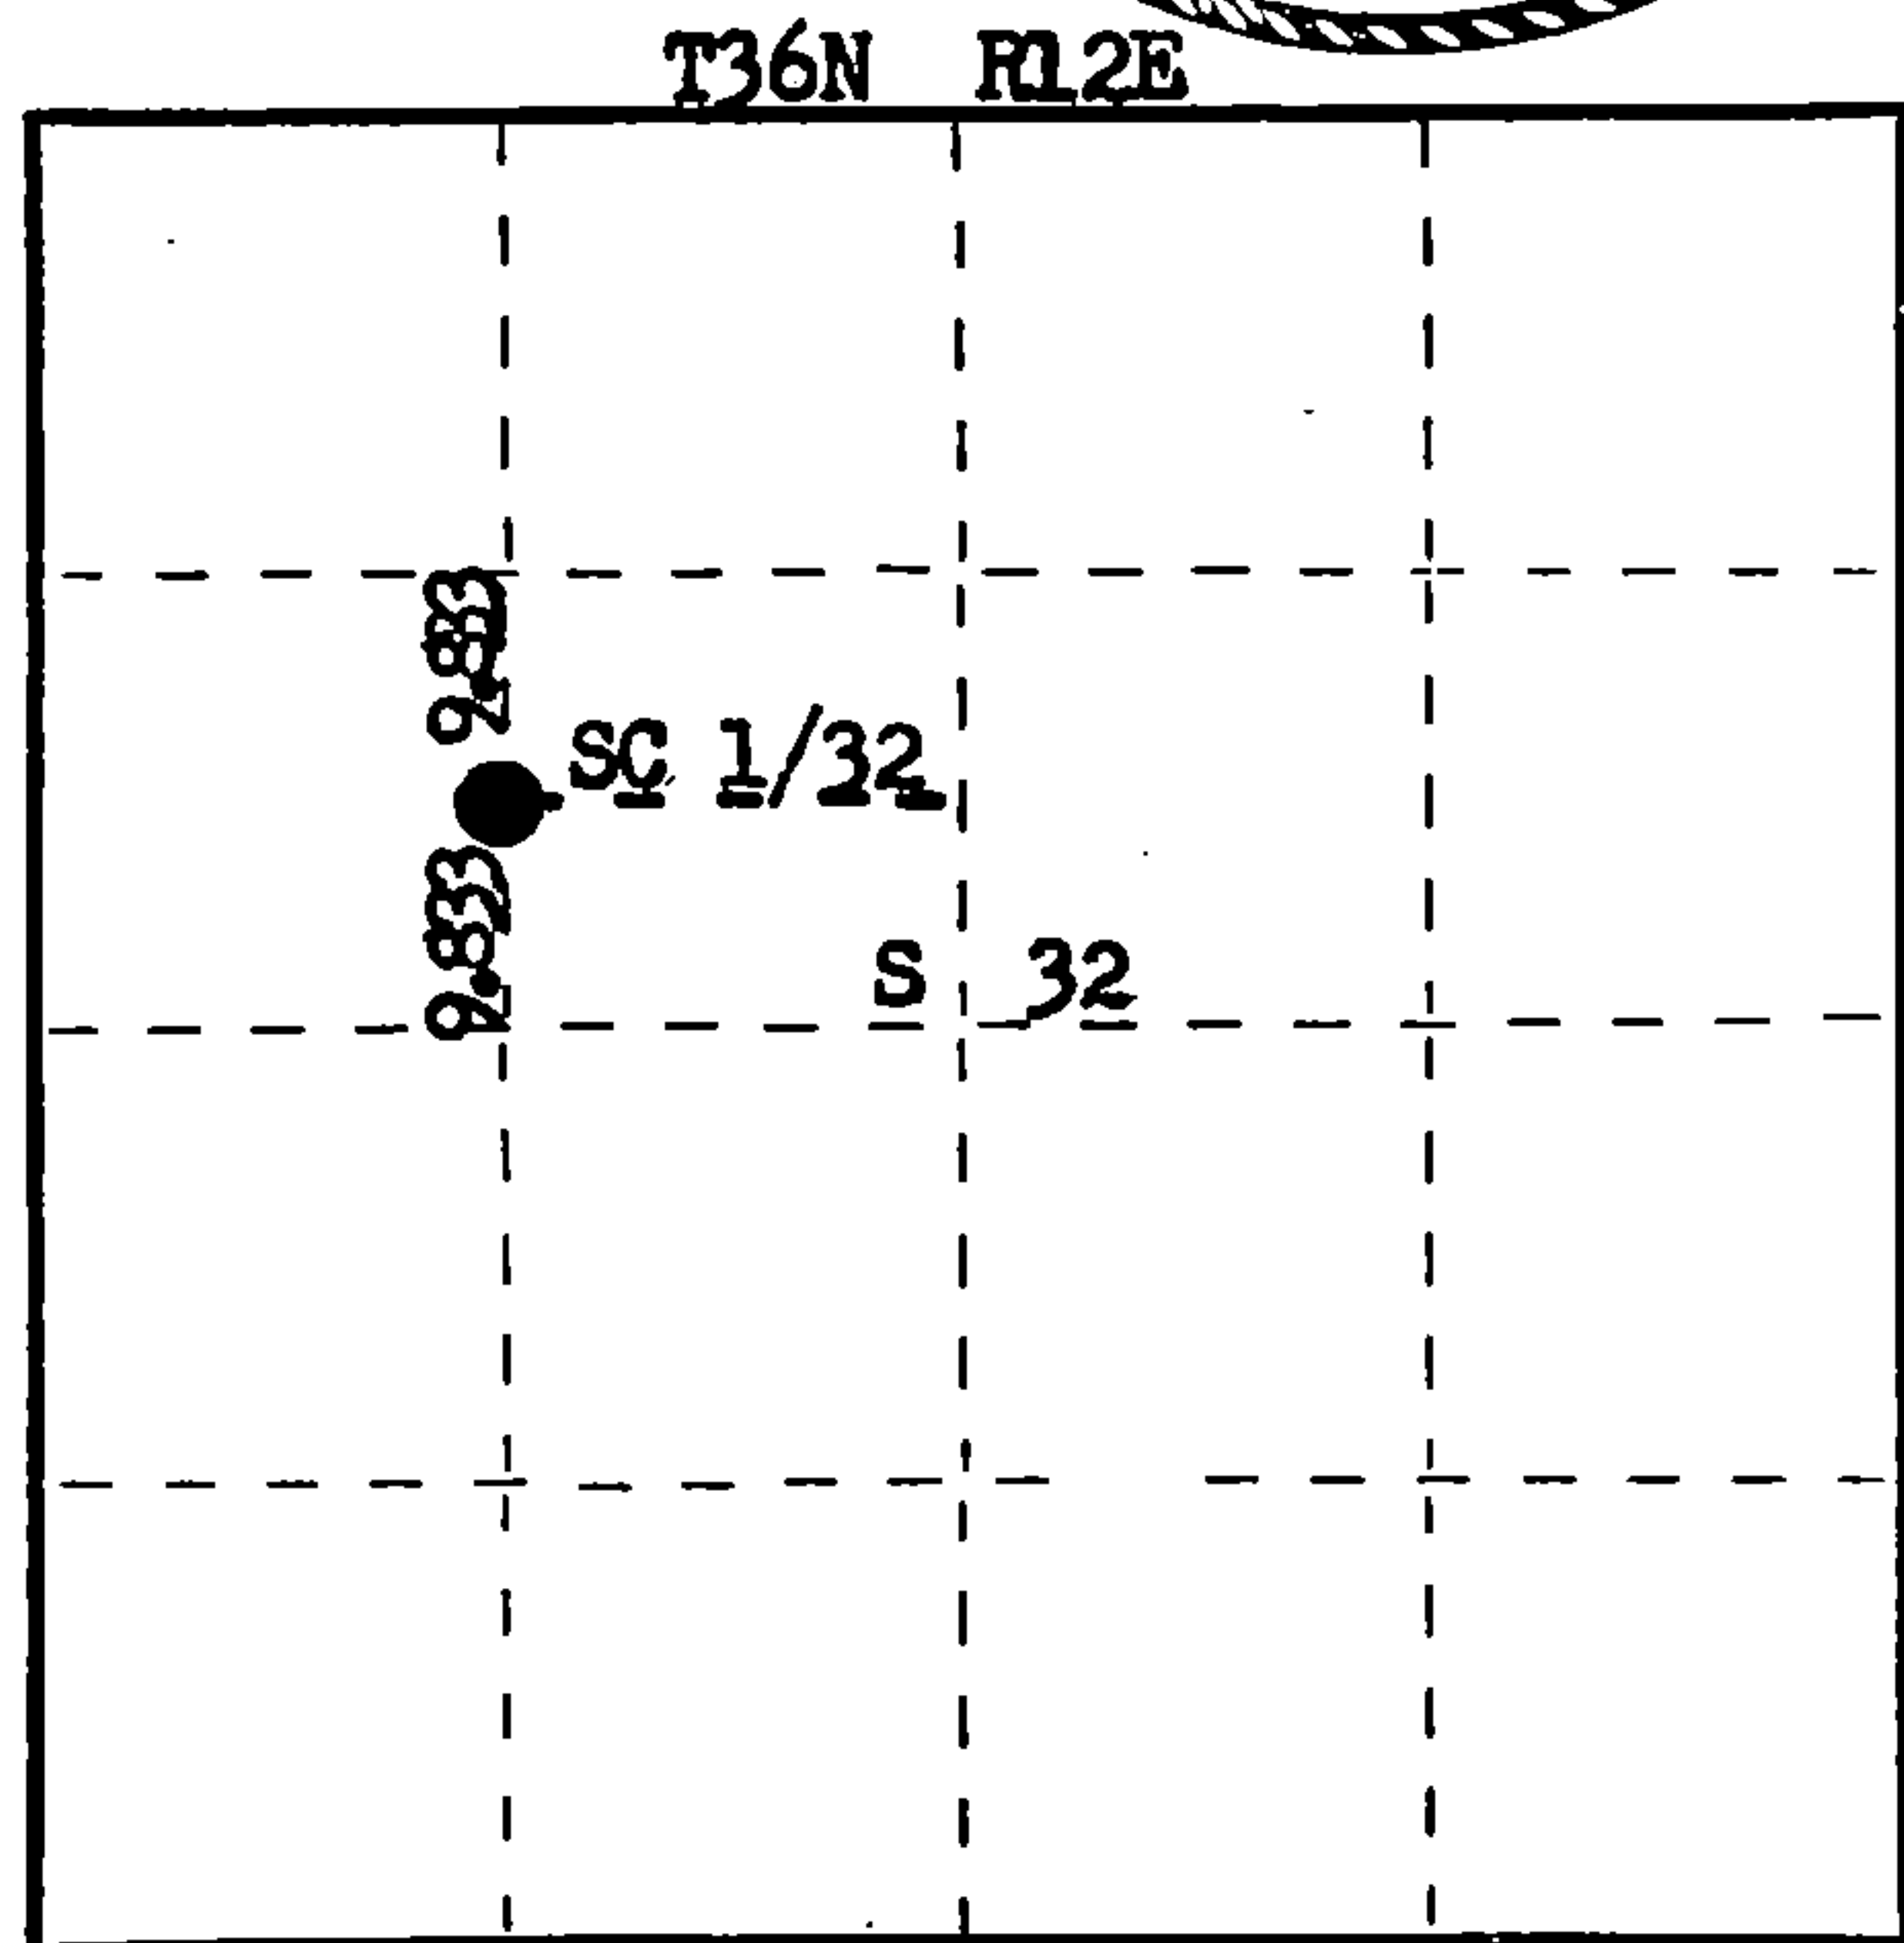

○ = Corner monument restored.

Dated at Rhineland, Wis., this 25th day of April, 1977

Signature Philip T. Hansen Title Registered Land Surveyor Registration No. S-498  
(County Surveyor, Registered Land Surveyor, or other duly authorized official)

Office of Register of Deeds, County of Forest, I hereby certify that the within instrument was filed in this office for record on the 5th day of May, 1977 at 4:00 o'clock P. M.

Eugene Steatman  
(Register of Deeds)

DOCUMENT NUMBER **111367**

By.....Deputy

43612322530