

CERTIFIED LAND CORNER RESTORATION

Index No. A-12

State of Wisconsin }
County of Forest } ss.

History of original corner establishment:

No evidence or records of any survey establishing this corner.


I Philip T. Hansen, do hereby certify that on the 28th day of February, 19 77, I ~~found~~ established ~~corner~~ of the E 1/16 corner of Section 4 & 33 Township 35 & 36, North, Range 12 East, Fourth Principal Meridian, as described hereon; and that from this evidence I established a new monument and accessories as described hereon to perpetuate the original location of this corner.

Resident witnesses:

Glen Barker

Jim Claflin

Herb Wagoner

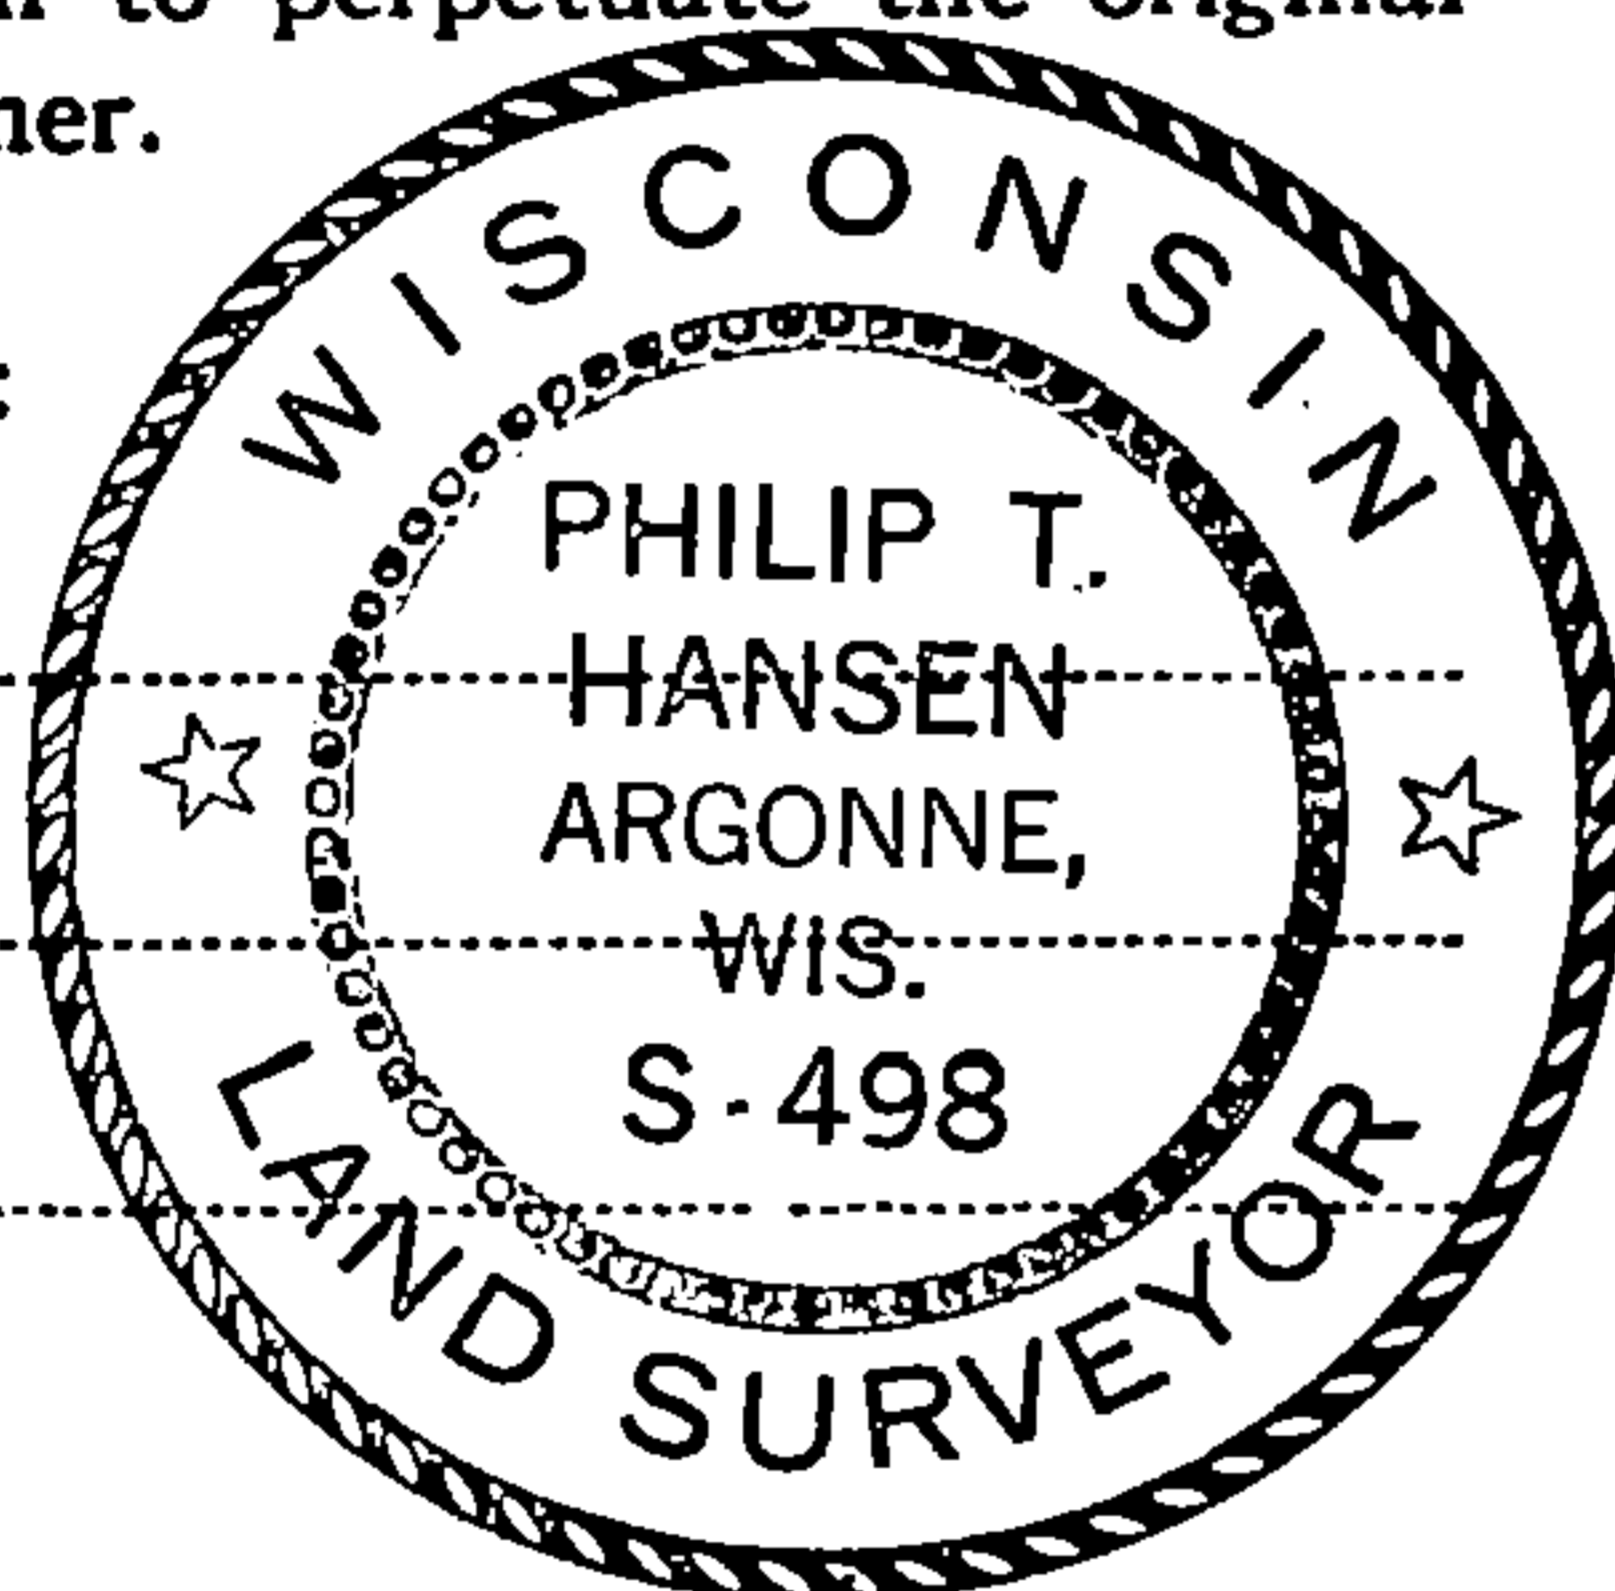

Description of corner evidence found:

Corner established by proportionate measurement. Ran traverse from Section Corner 33, 34, 3 & 4 to Section Corner 32, 33, 5 & 4. Computed distance 78.976 chains at bearing S 88° 57' 41" W. Set E 1/16 corner at 19.744 chains S 88° 57' 41" W of Section Corner 33, 34, 3 & 4, intermediate to quarter corner.


Description of monument and accessories I established to perpetuate the original location of this corner.

Set 1 1/2" iron pipe with 2" brass cap, projecting 30" above ground. Cap stamped:

Marked NBTs - Sugar 8" S73°W, 74.2 links
Sugar 6" S11°E, 96.9 links, scribed 1/16 BT.

S498
T36N R12E
E 1/16 S | 33
 S | 4
T35N R12E
CPI-1977

FORM 985 Wisconsin Planning Library Co.

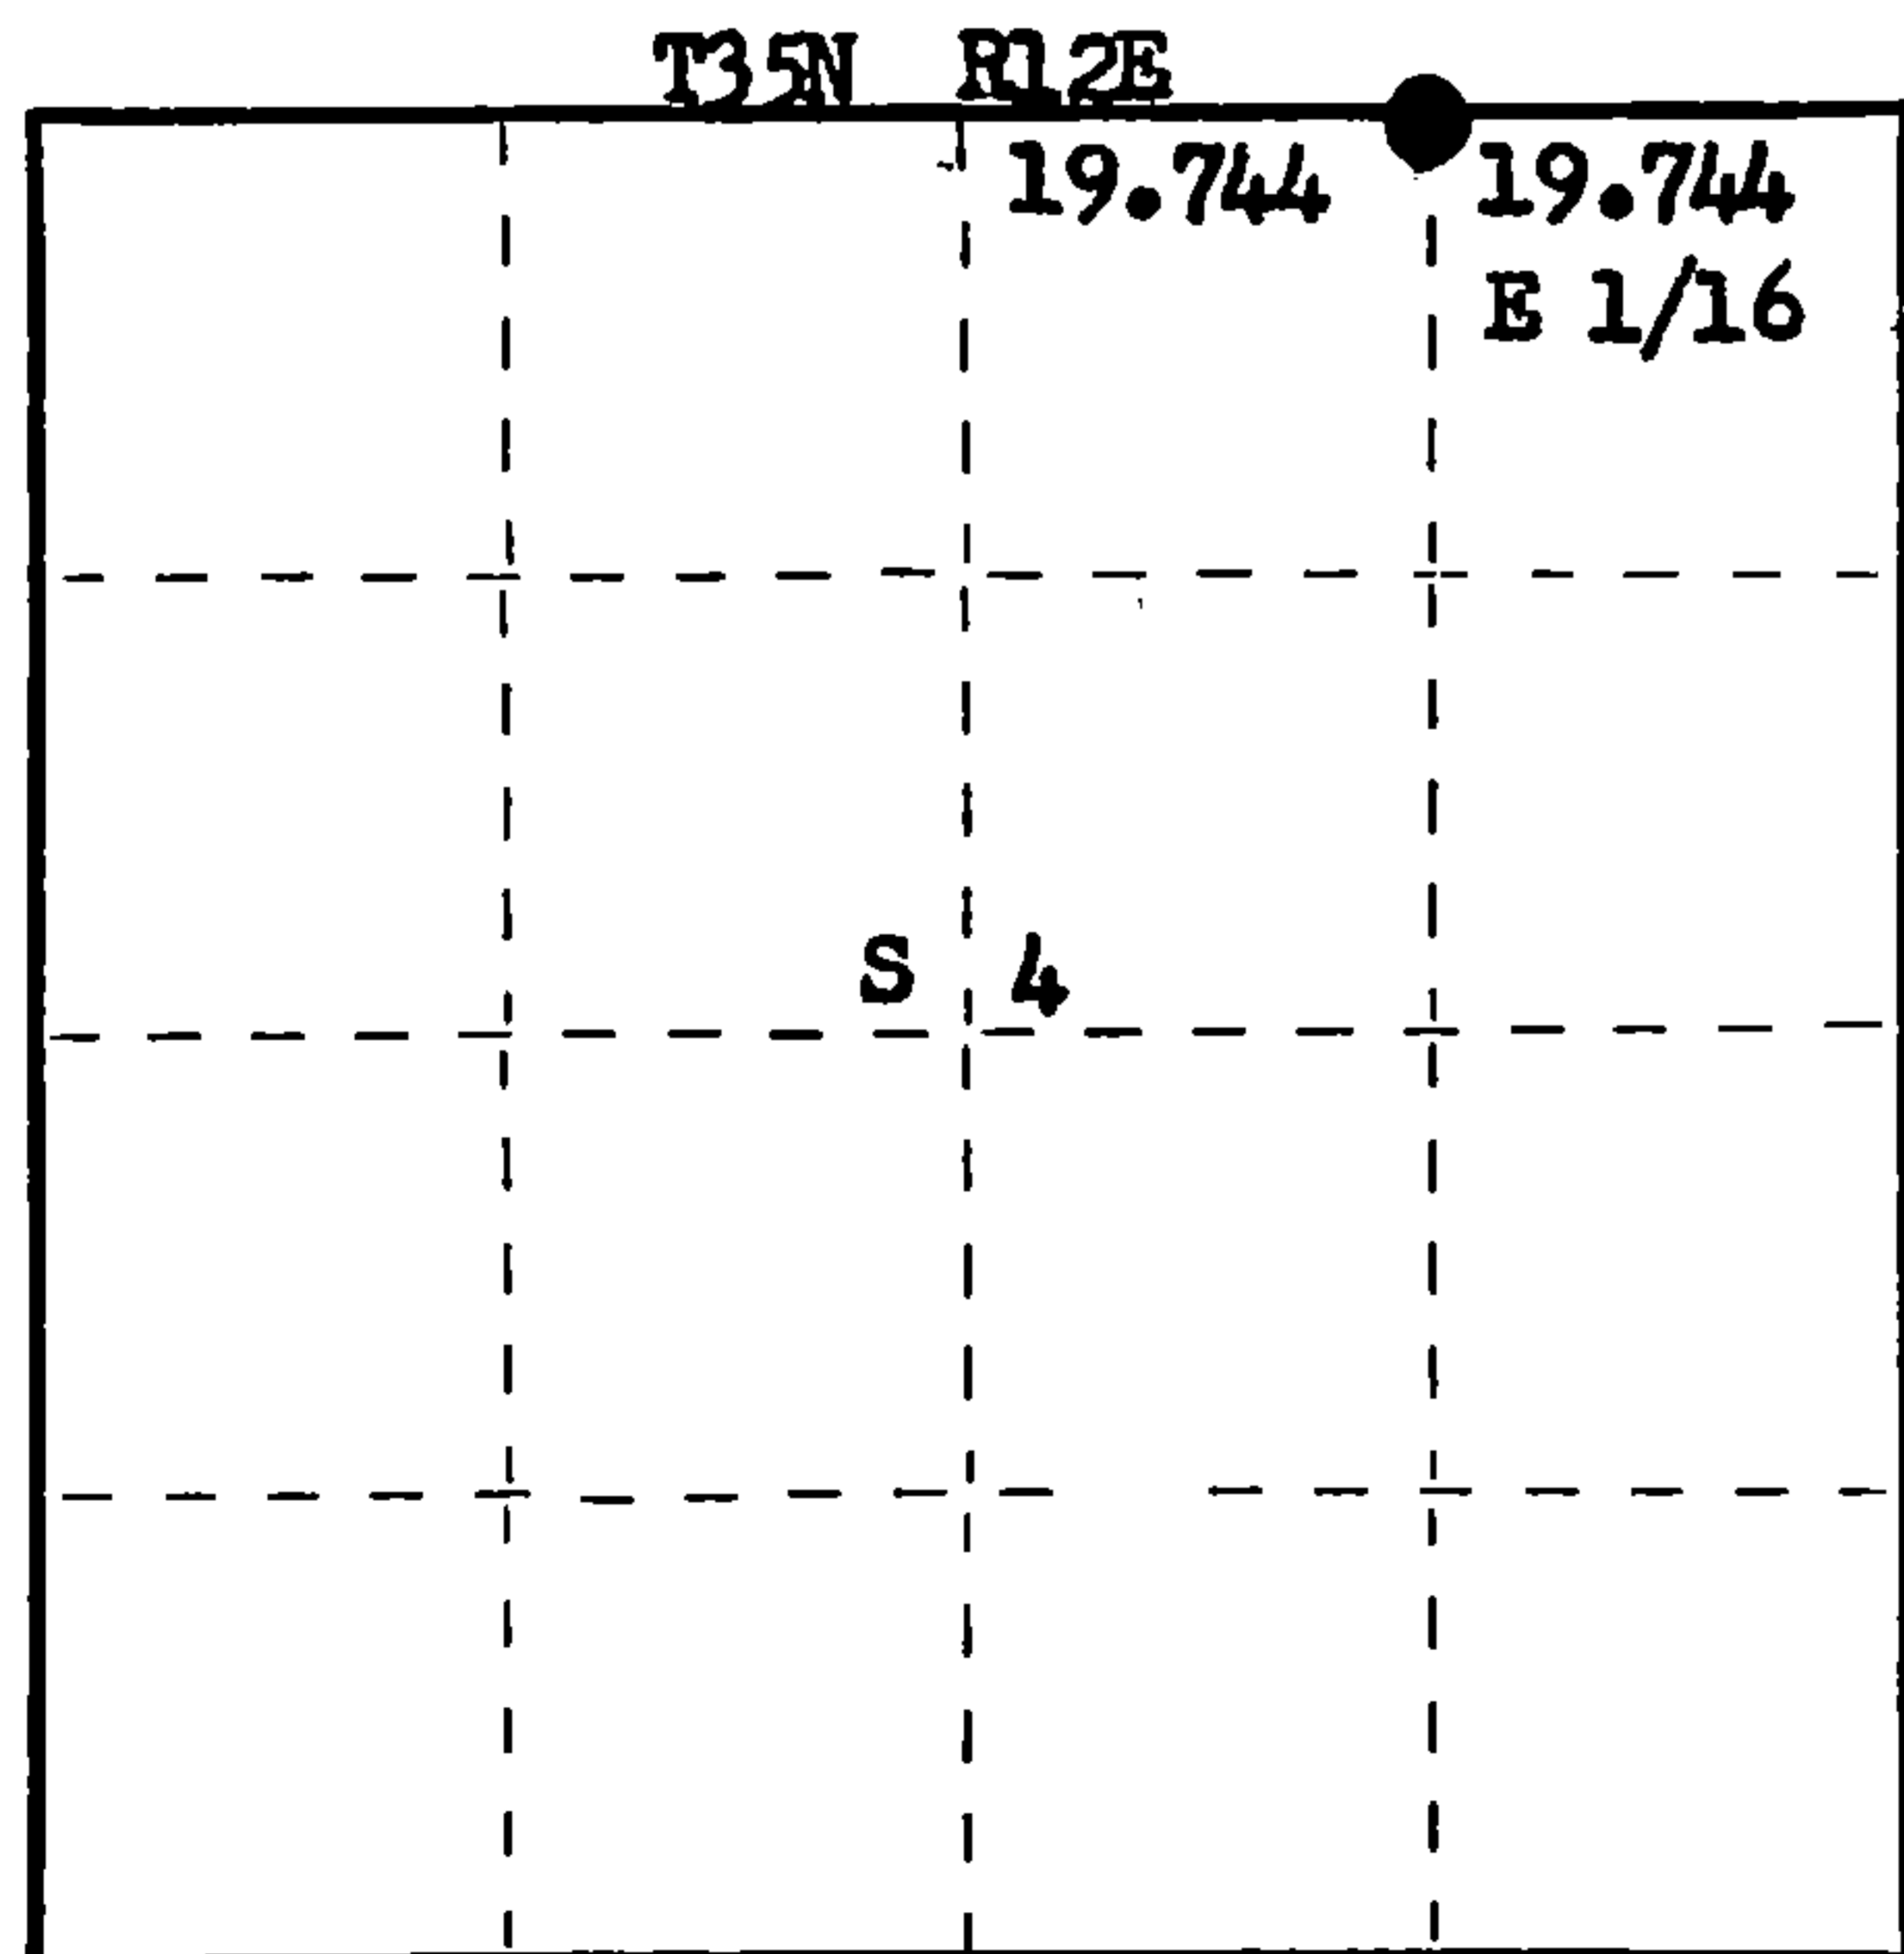

○ = Corner monument restored.

Dated at Rhineland, Wis., this 5th day of April, 19 77.

Signature Philip T. Hansen Title Registered Land Surveyor Registration No. S-498
(County Surveyor, Registered Land Surveyor, or other duly authorized official)

Office of Register of Deeds, County of Forest, I hereby certify that the within instrument was filed in this office for record on the 5th day of MAY, 19 77 at 4:00 o'clock P. M.

Eugene Stetson
(Register of Deeds)
By _____ Deputy

DOCUMENT NUMBER
111365

43612330010