

CERTIFIED LAND CORNER RESTORATION

Index No. A-10

State of Wisconsin }
County of Forest } ss.


I Philip T. Hansen, do hereby certify that on the 28th day of February, 1977, I ~~found~~ **established** ~~the~~ W 1/16 corner of Section 4 & 33 Township 35 & 36, North, Range 12 East, Fourth Principal Meridian, as described hereon; and that from this evidence I established a new monument and accessories as described hereon to perpetuate the original location of this corner.

Resident witnesses:


Glen Barker

Jim Claflin

Herb Wagoner

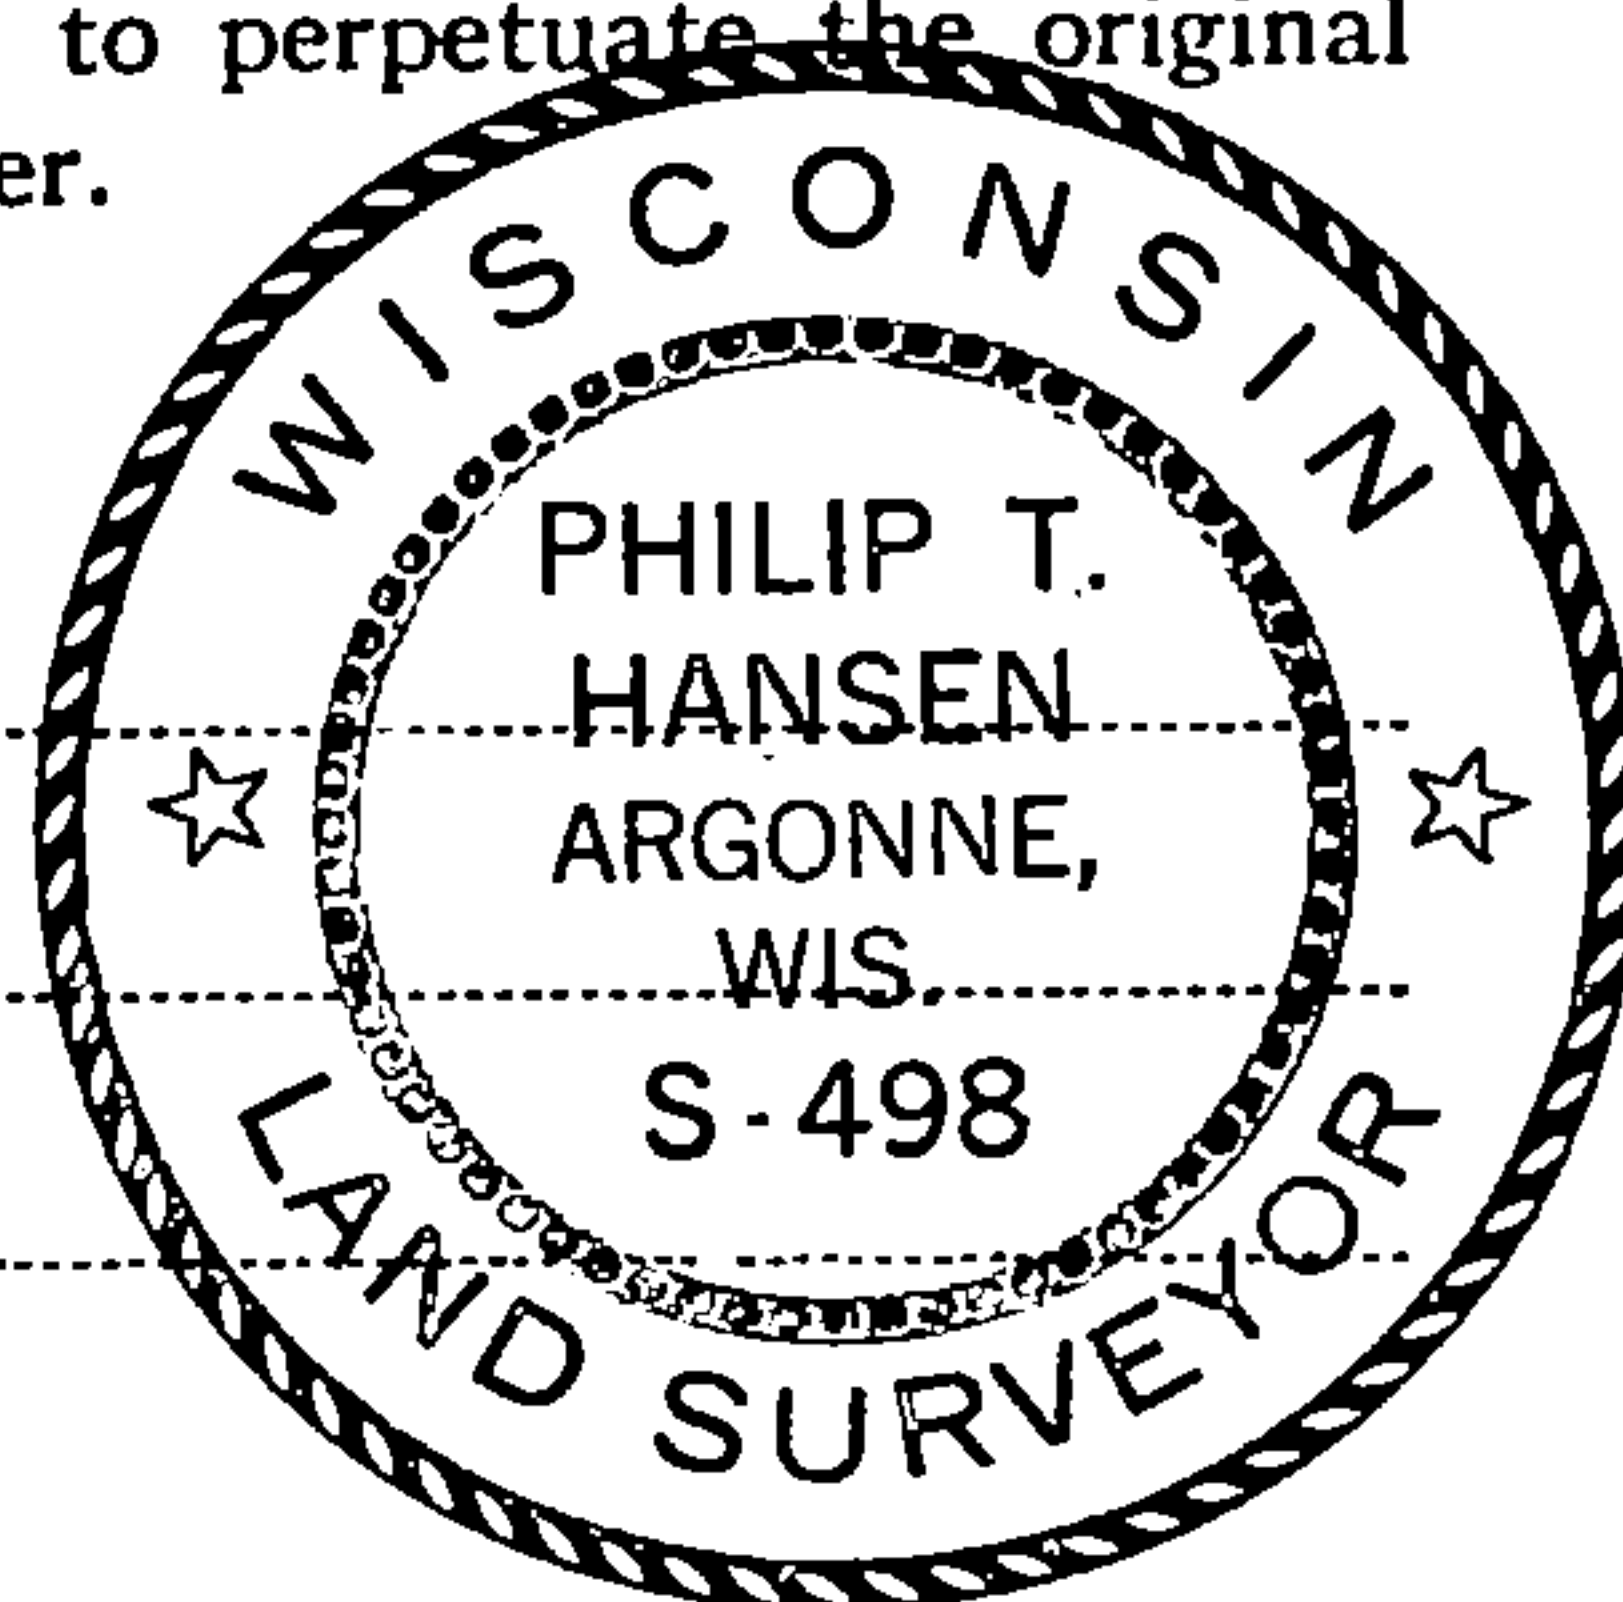

FORM 985 H. C. MILLER CO., MILWAUKEE

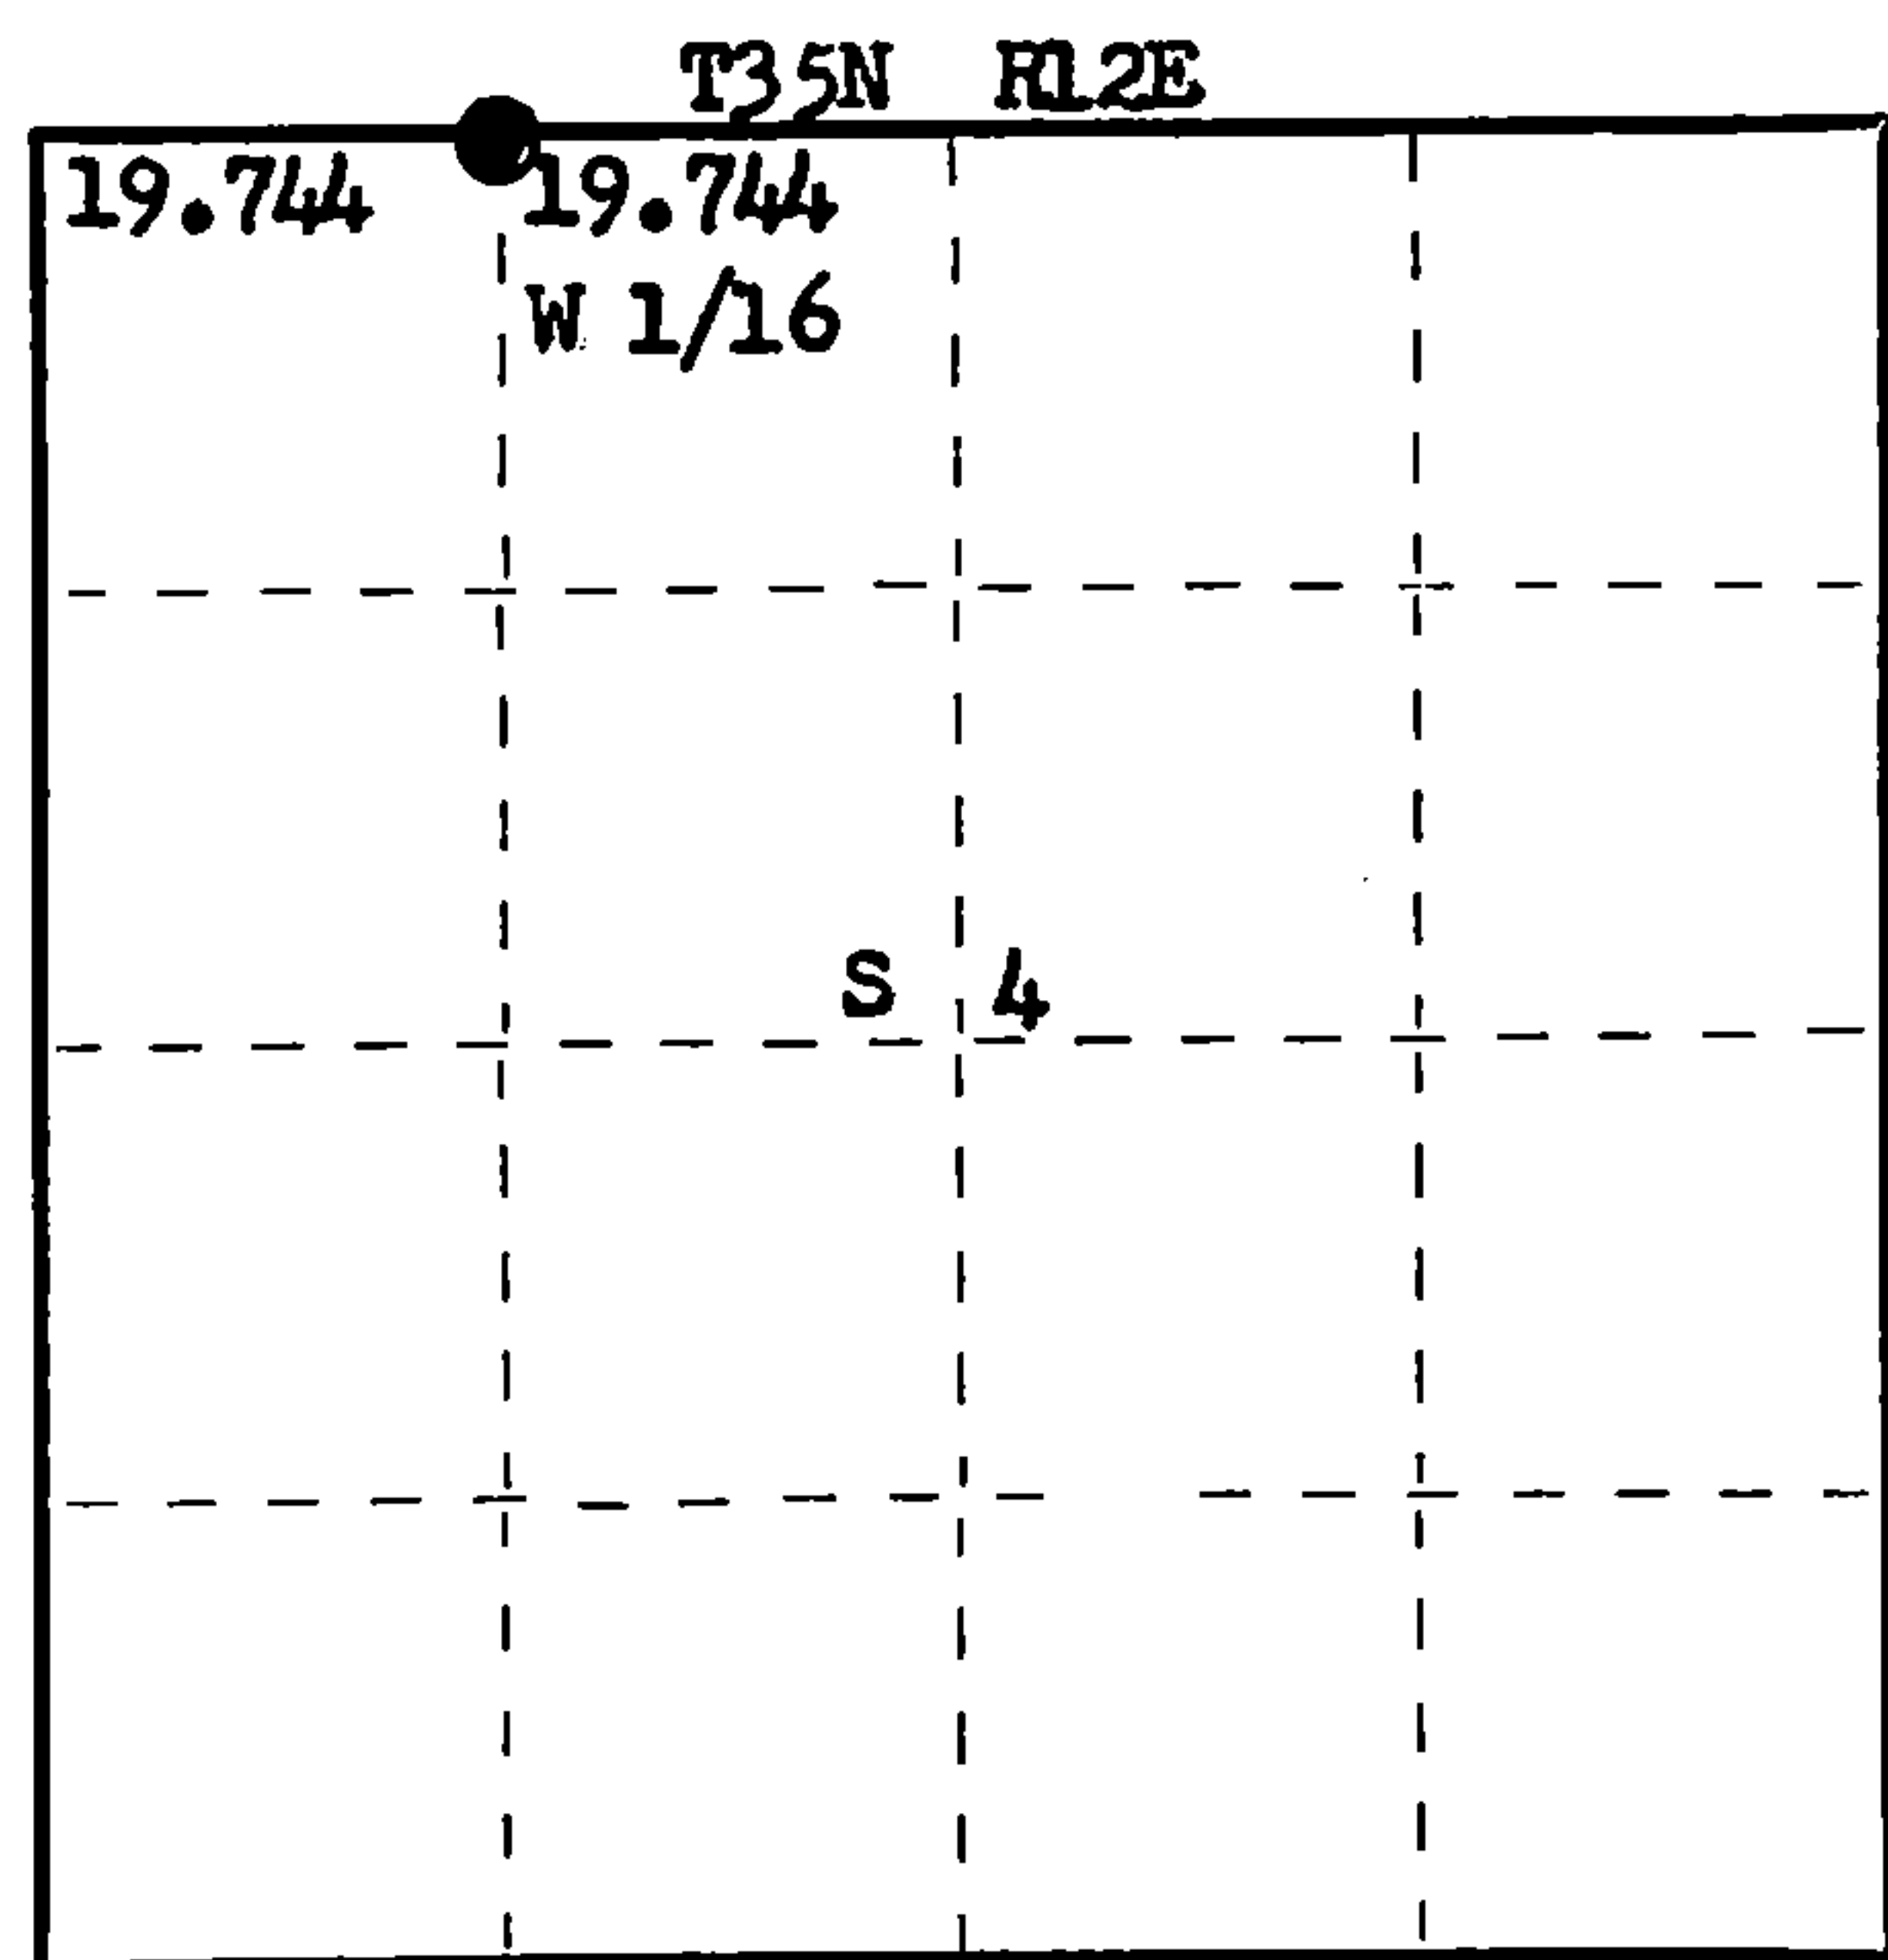

○ = Corner monument restored.

History of original corner establishment:

No evidence or record of any survey establishing this corner.

Description of corner evidence found:

Corner established by proportion. Ran traverse from Section Corner 33, 34, 3 & 4 to Section Corner 32, 33, 5 and 4. Computed distance 78.976 chains at bearing S88° 57' 41" W. Established 1/4 corner at 39.488 chains intermediate. Set W 1/16 corner at 19.744 chains intermediate between 1/4 corner and Section Corner 32, 33, 4 and 5.

Description of monument and accessories I established to perpetuate the original location of this corner.

Set 1 1/2" iron pipe with 2" brass cap, projecting 24" above ground. Cap stamped:

**Marked NBTs - Sugar 10" N11°W, 75.2 links.
Sugar 8" N64°W, 115.5 links, scribed 1/16 BT.**

S498
T36N R12E
W 1/16 S 33
S 4
T35N R12E
CPL-1977

43612330030

Dated at Rhineland, Wis., this 5th day of April, 1977

Signature Philip T. Hansen Title Registered Land Surveyor Registration No. S-498
(County Surveyor, Registered Land Surveyor, or other duly authorized official)

Office of Register of Deeds, County of Forest, I hereby certify that the within instrument was filed in this office for record on the 5th day of May, 1977 at 4:00 o'clock P. M.

Eugene Staszny
(Register of Deeds)

DOCUMENT NUMBER
111364

By..... Deputy