

CERTIFIED LAND CORNER RESTORATION

Index No. Y-15

State of Wisconsin }
County of Forest } ss.


I, Philip T. Hansen, do hereby certify that on the 30th day of August, 1977, I ~~found~~ established ~~evidence of~~ the SC 1/16 corner of Section 34 Township 36, North, Range 12 East, Fourth Principal Meridian, as described hereon; and that from this evidence I established a new monument and accessories as described hereon to perpetuate the original location of this corner.

Resident witnesses:

Glen Barker

Jim Claflin

Herb Wagoner

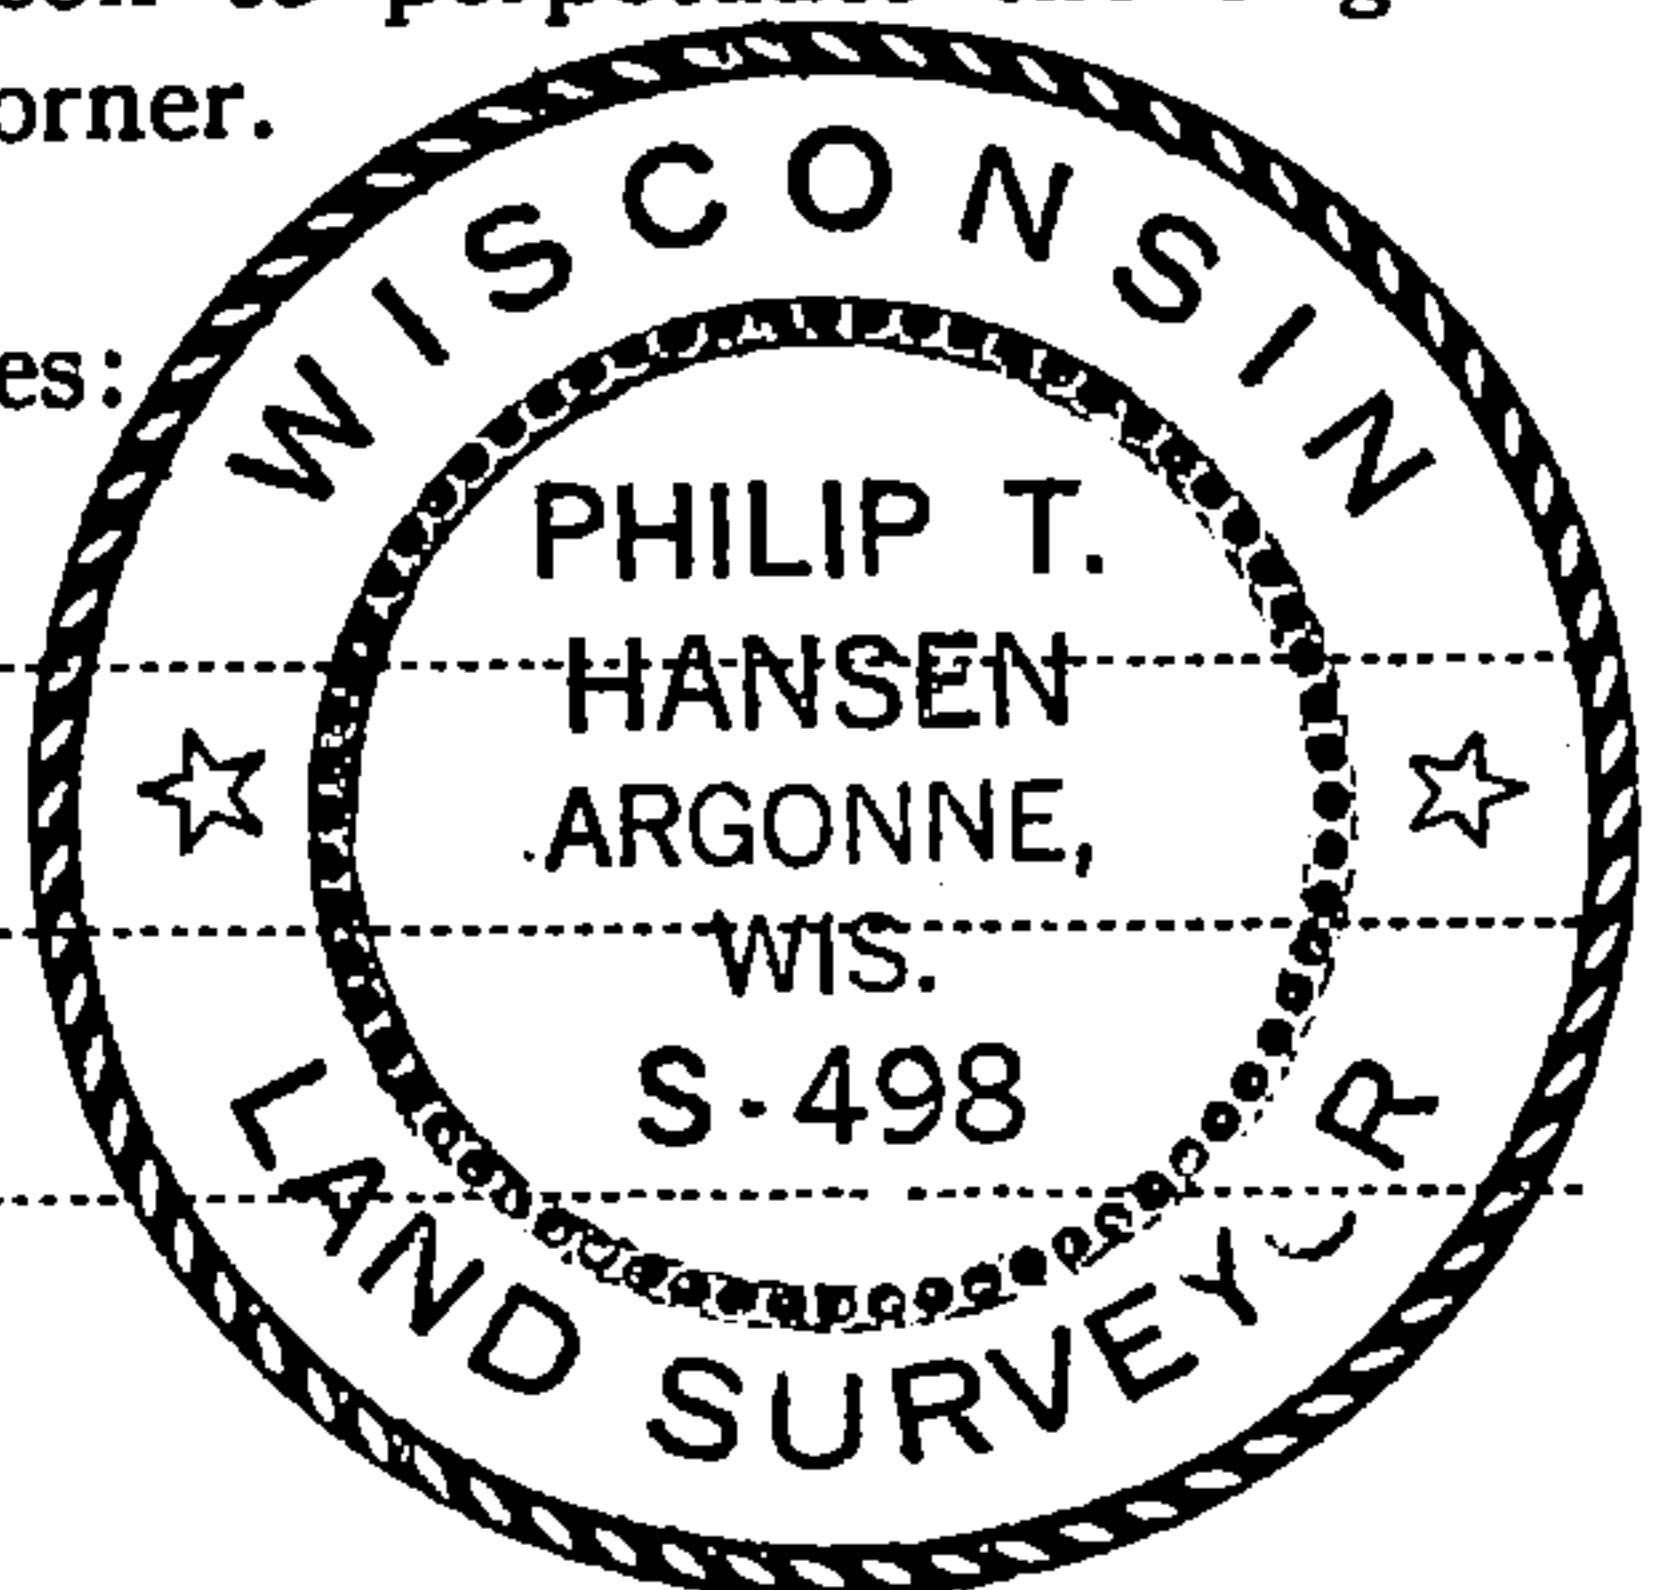

History of original corner establishment:
No records of any previous survey.


Description of corner evidence found:

No evidence of any corner recovered.
Corner established by traverse and computations of entire section. Corner set by proportion between established C 1/4 and S 1/4 corner. Computed distance is 2921.8746 ft. (44.27 chains). Set SC 1/16 at 22.14 chains intermediate.

Description of monument and accessories I established to perpetuate the original location of this corner.
Set 1 1/2" iron pipe with 2" brass cap projecting 24" above ground. Cap stamped: Marked NBTs - Sugar 10" S76°W, 15 links, scribed 1/16 BT.
Sugar 6" S50°E, 16.7 links, scribed 1/16 BT.

S498
T36N R12E
SC 1/16 S 34
CPI-1977

FORM 985 H. C. MILLER CO., MILWAUKEE

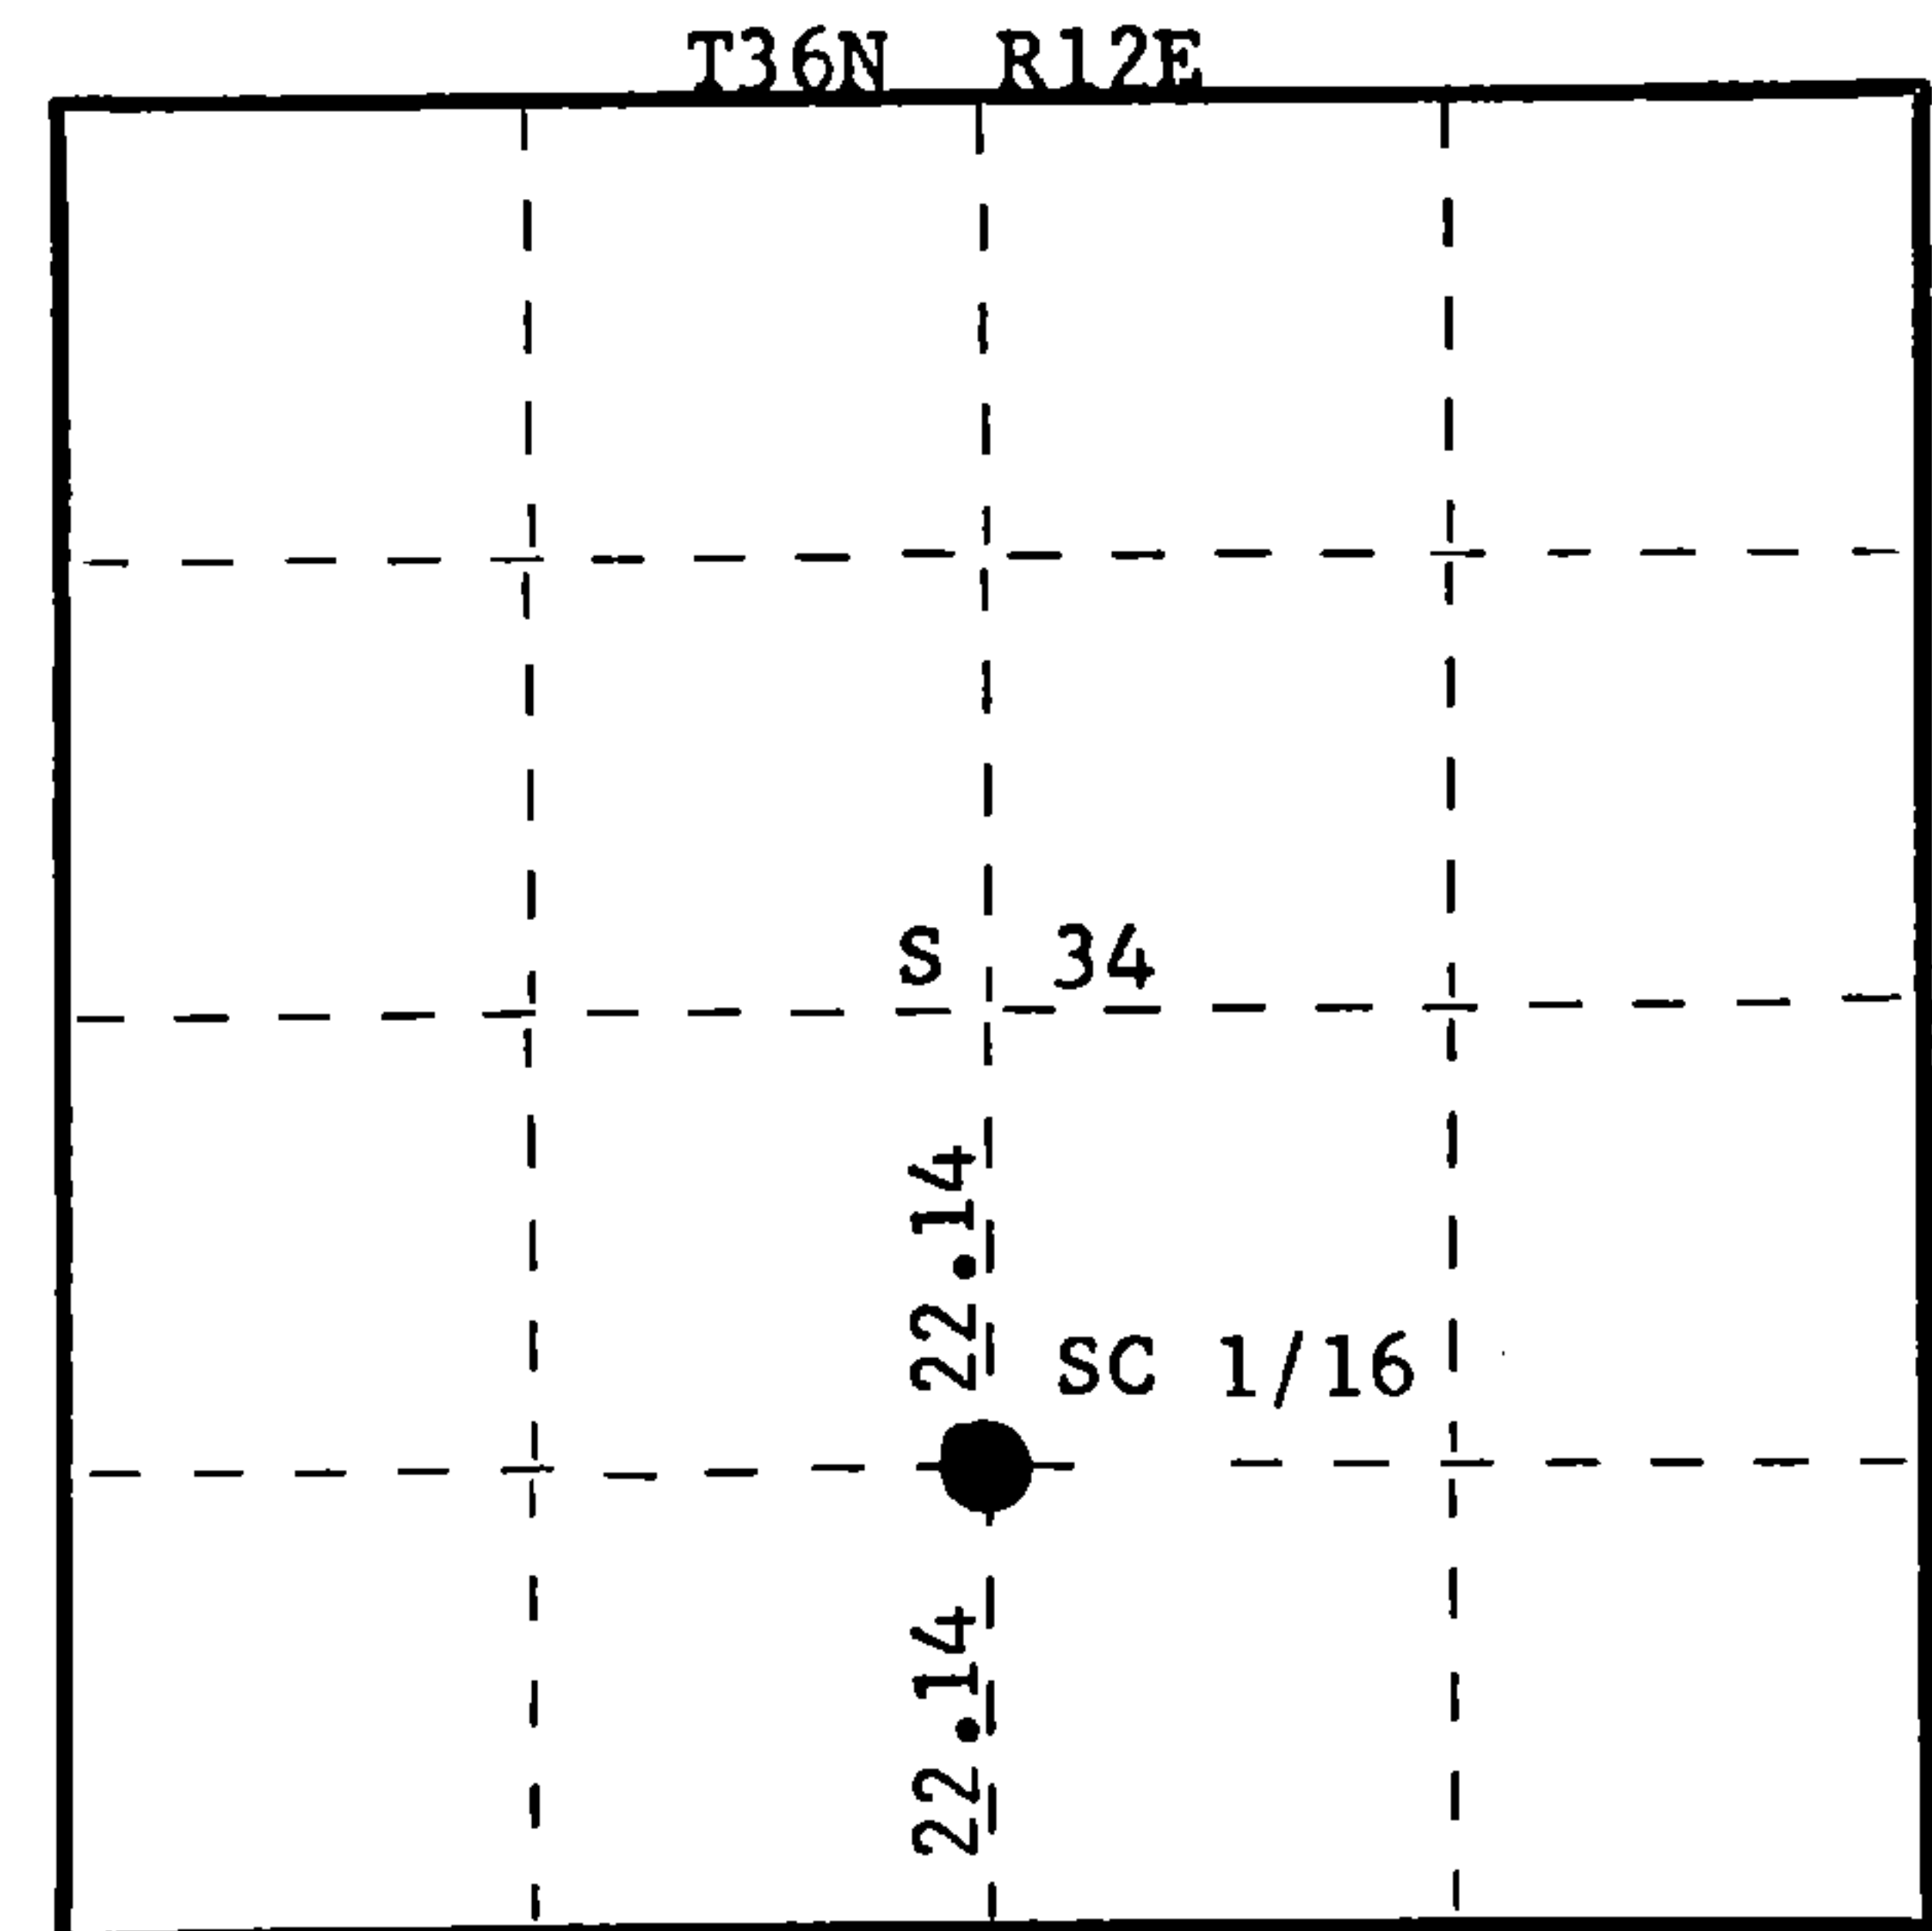

○ = Corner monument restored.

Dated at Rhineland, Wis., this 1st day of September, 1977.

Signature Philip T. Hansen Title Registered Land Surveyor Registration No. S-498
(County Surveyor, Registered Land Surveyor, or other duly authorized official)

Office of Register of Deeds, County of Forest, I hereby certify that the within instrument was filed in this office for record on the 8th day of September, 1977 at 4:00 o'clock P. M.

Eugene Stutzman
(Register of Deeds)
By _____ Deputy

DOCUMENT NUMBER 112303

43612341020