

CERTIFIED LAND CORNER RESTORATION

Index No. X-17

State of Wisconsin }
County of Forest } ss.


I Philip T. Hansen, do hereby certify that on the 17th day of August, 1977, I ~~found~~ established ~~the~~ Quarter corner of Section 34 & 35 Township 36, North, Range 12 East, Fourth Principal Meridian, as described hereon; and that from this evidence I established a new monument and accessories as described hereon to perpetuate the original location of this corner.

Resident witnesses:


Glen Barker

Jim Claflin

Herb Wagoner

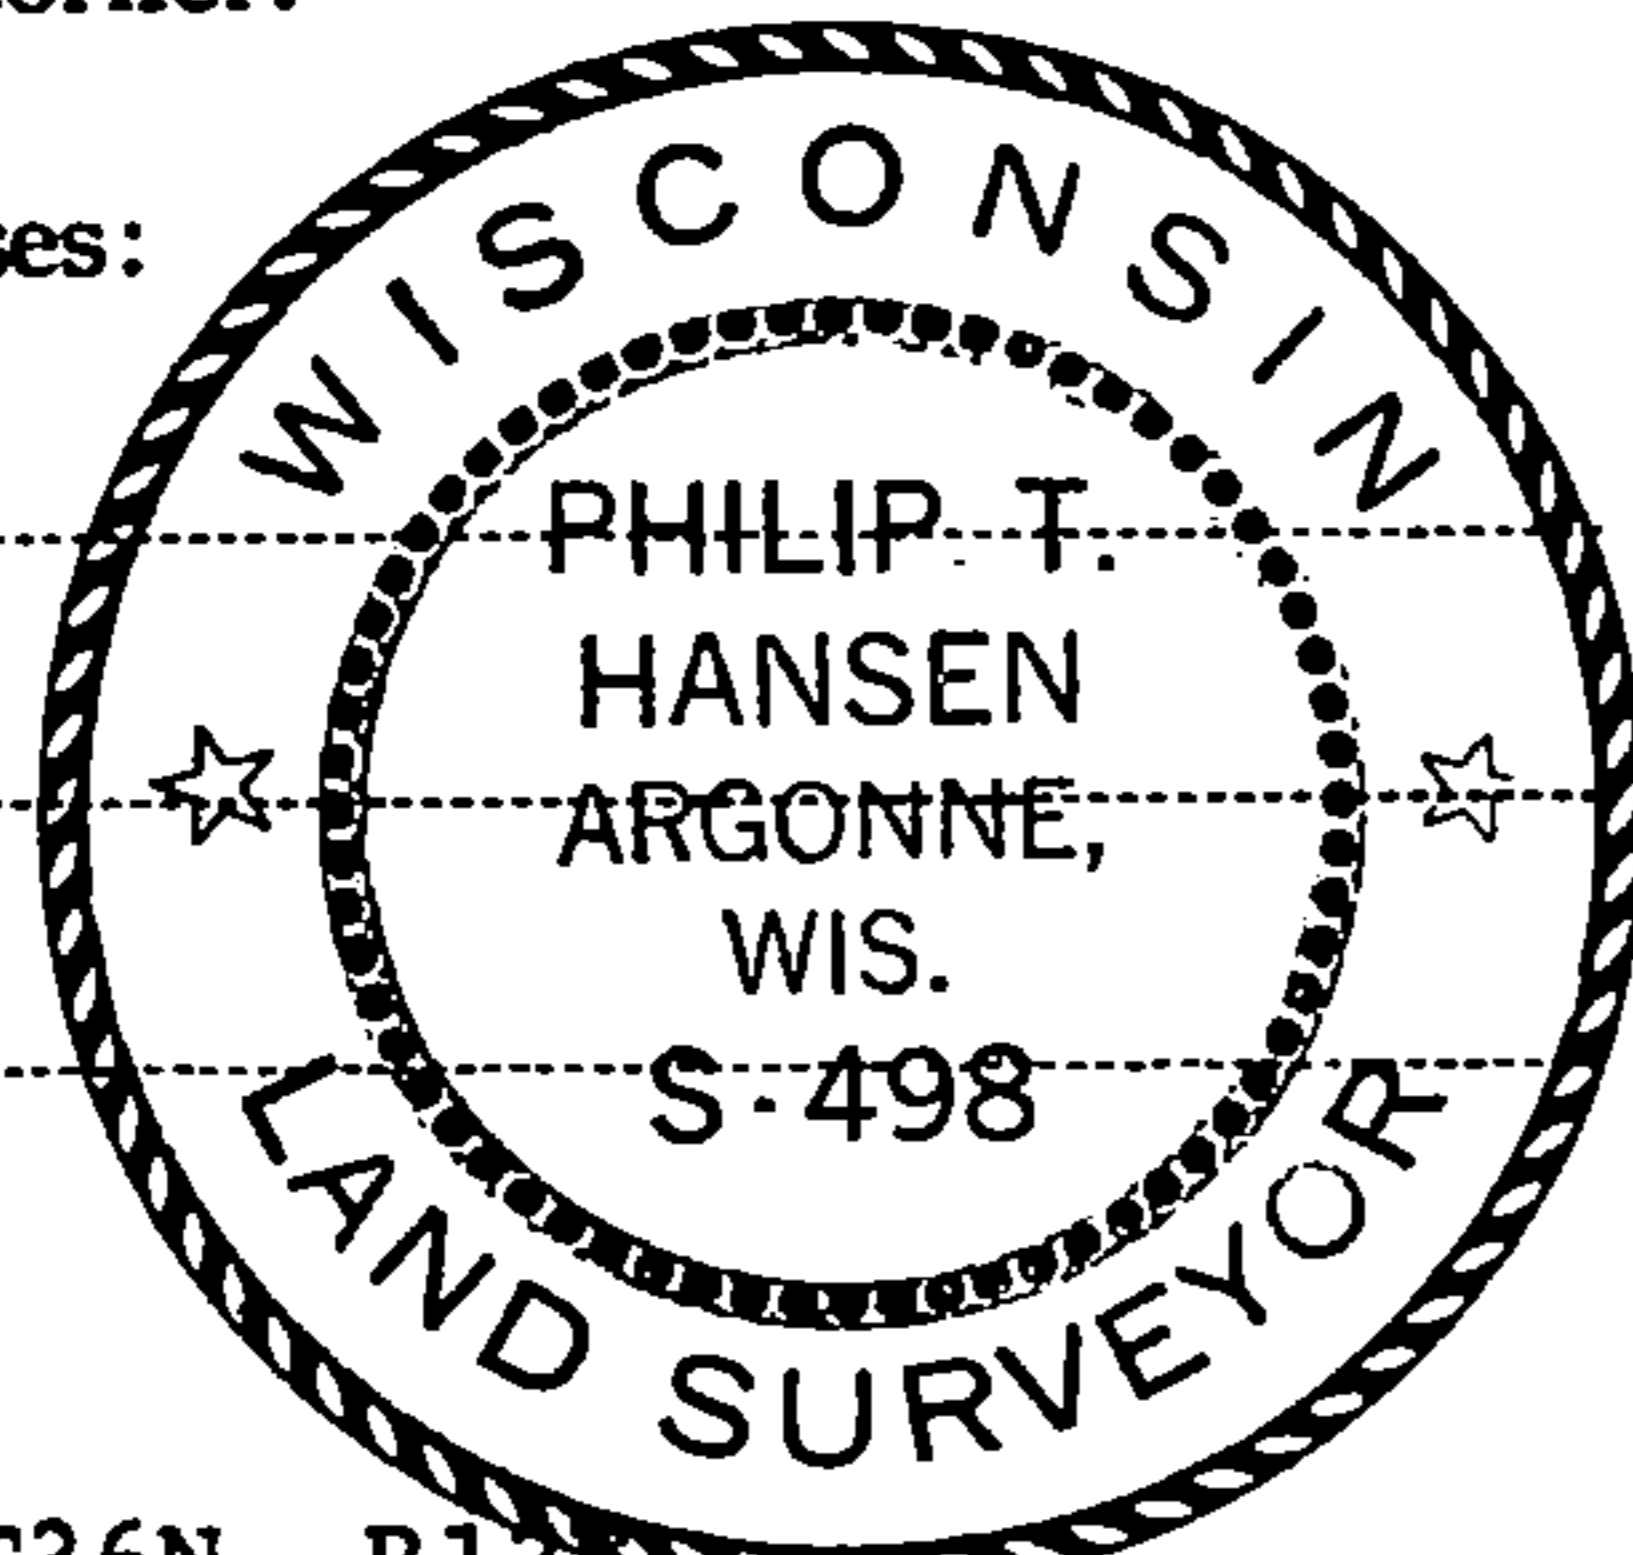

FORM 985 H. C. MILLER CO., MILWAUKEE

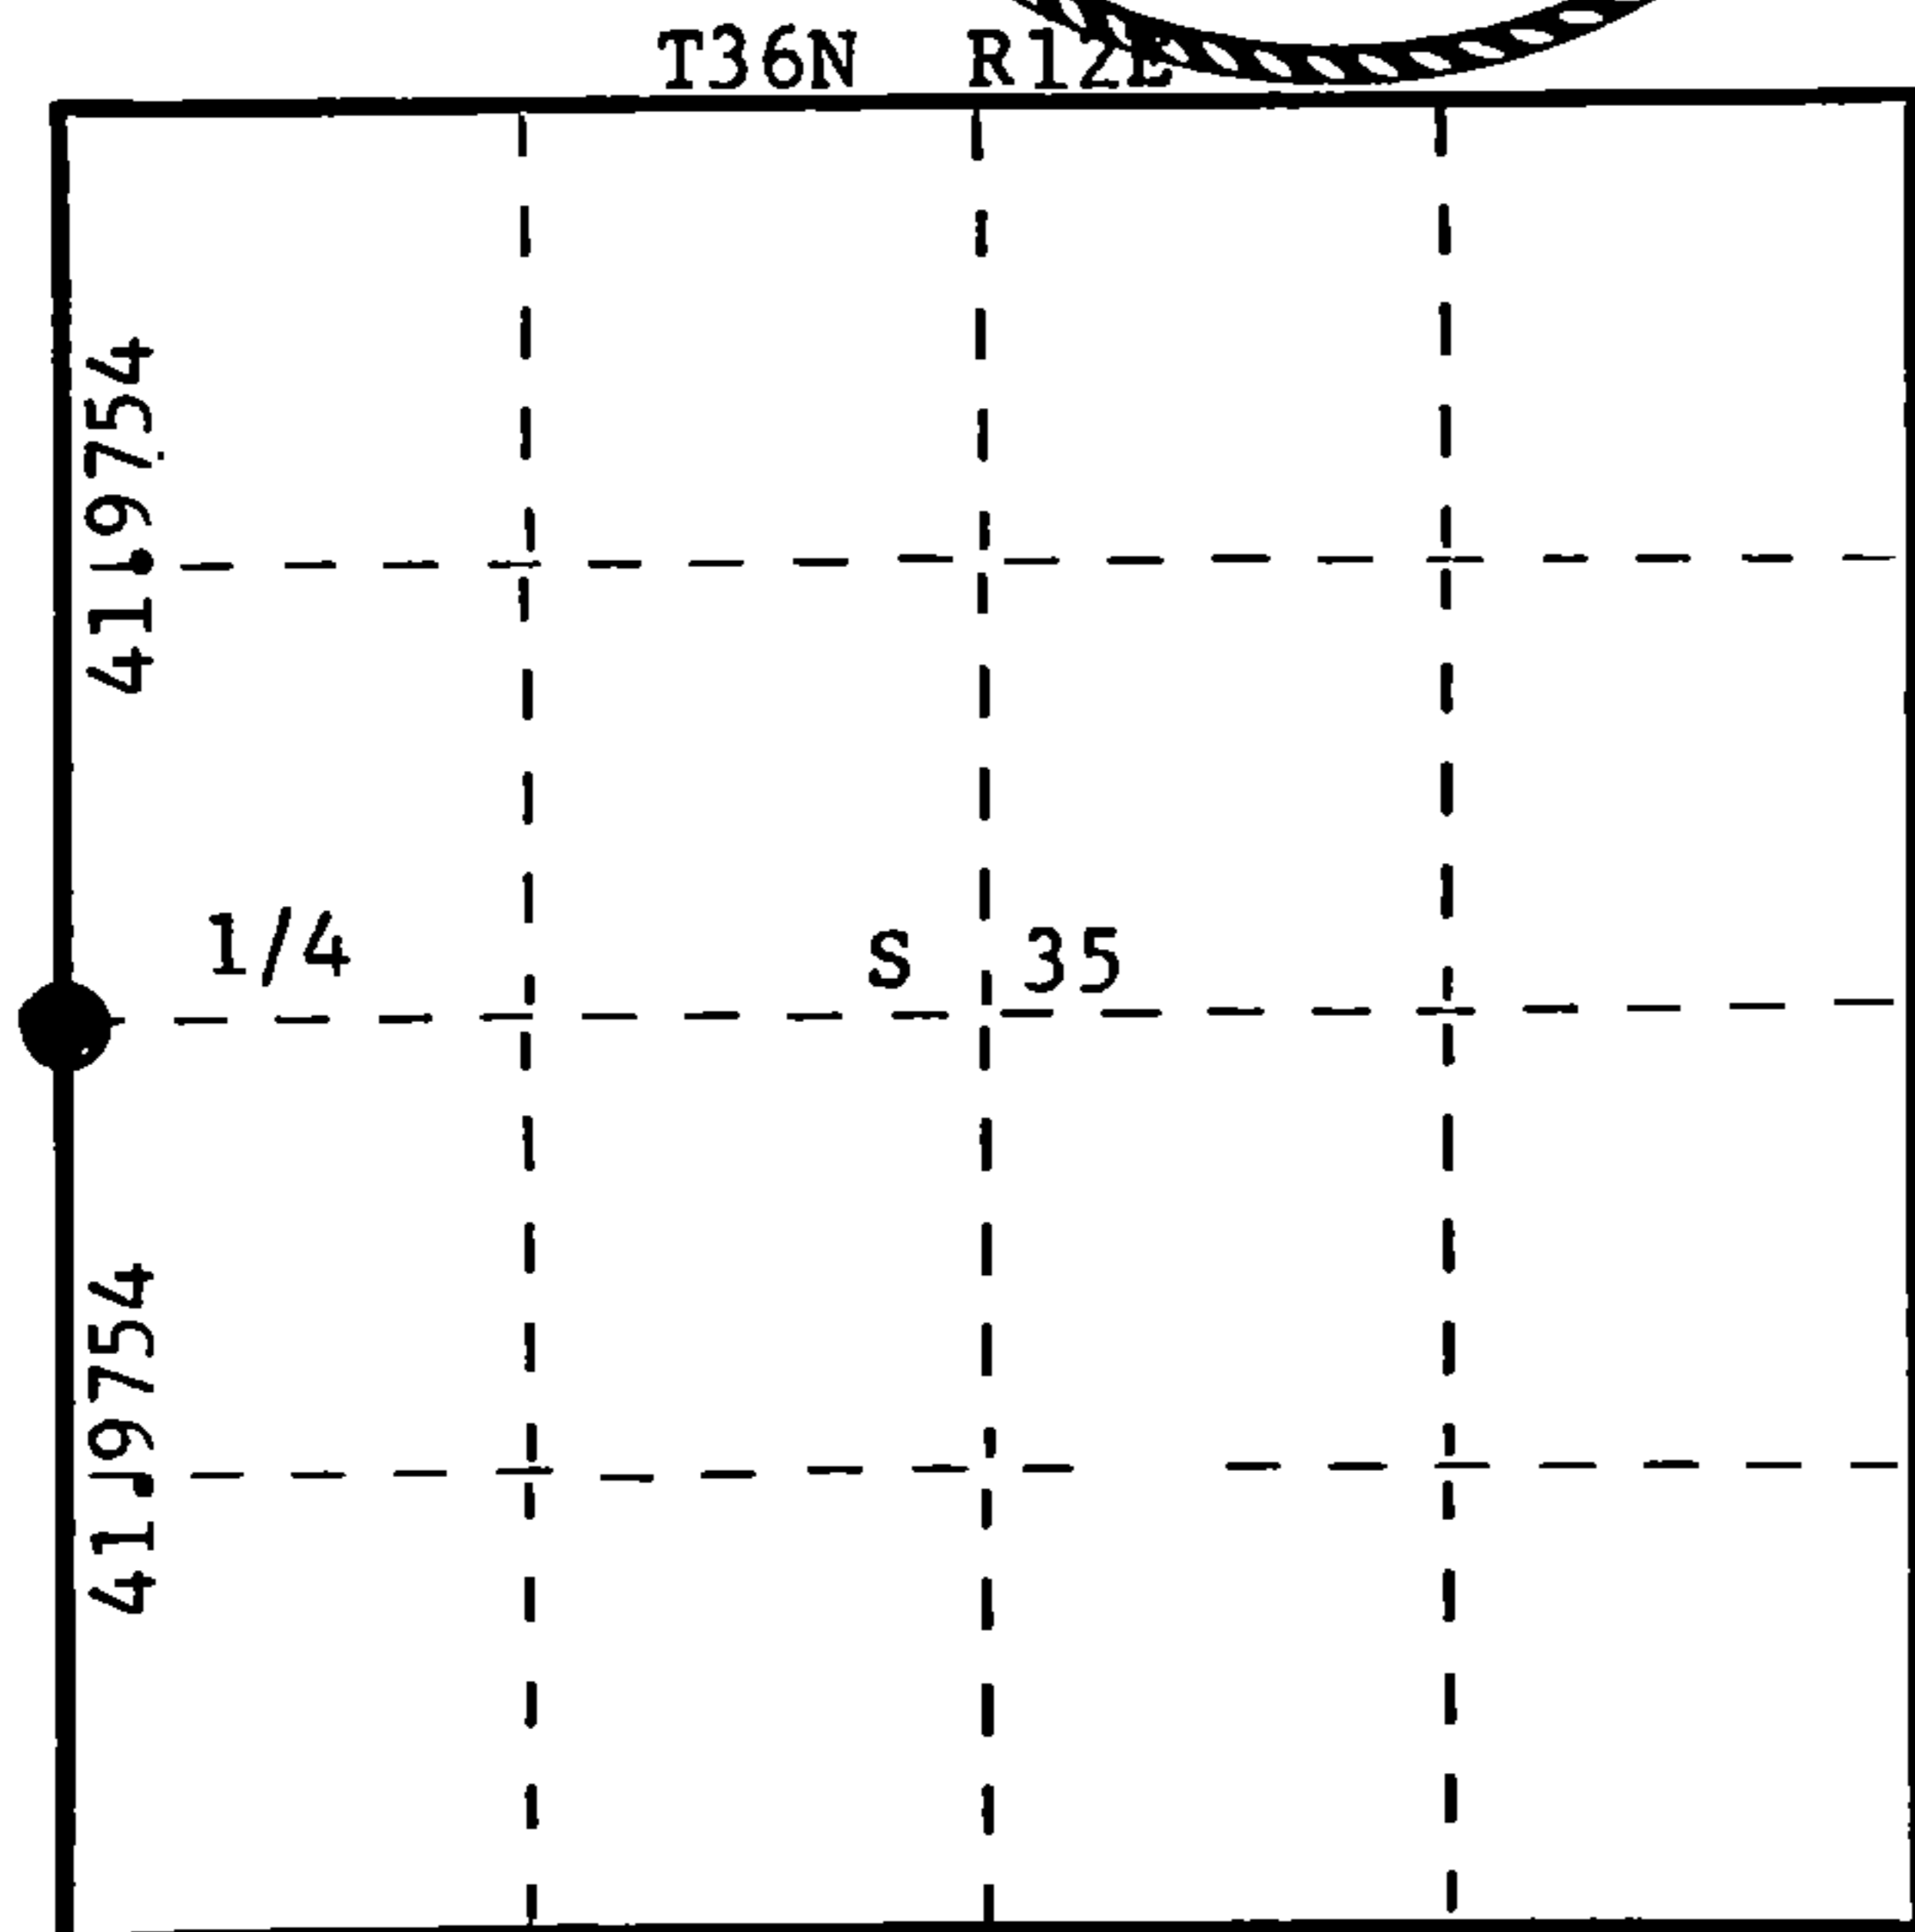

○ = Corner monument restored.

History of original corner establishment:

Corner established by J.L. Nowlin, Deputy Surveyor, in 1859, from which Birch 12" bears S69°E, 23 links; Sugar 20" bears N18°W, 15 links. No records of any subsequent survey.

Description of corner evidence found:

No evidence of any corner recovered. Corner established by proportion. Ran traverse south from Section Corner 26, 27, 34, 35 to Section Corner 34,35, 3 & 2 previously established. Computed distance 5540.757 feet (83.951 chains) at bearing S 2° 41' 29" W. Set 1/4 corner at 2770.3785 feet (41.9754 chains) intermediate.

Description of monument and accessories I established to perpetuate the original location of this corner.

Set 2-1/2" Berntsen A-1 Federal Monument, aluminum with magnet installed in cap and base, projecting 1' above ground. Cap stamped:

Marked NBTs - Sugar 8" N58°W, 12.8 links, scribed 1/4 BT.
Sugar 8" N44°E, 17.2 links, scribed 1/4 BT.
Sugar 7" S32°E, 15.8 links, scribed 1/4 BT.

T36N R12E
1/4 S34+S35
S498-1977

Dated at Rhineland, Wis., this 19th day of August, 1977

Signature Philip T. Hansen Title Registered Land Surveyor Registration No. S-498
(County Surveyor, Registered Land Surveyor, or other duly authorized official)

Office of Register of Deeds, County of Forest, I hereby certify that the within instrument was filed in this office for record on the 22nd day of AUGUST, 1977 at 3:30 o'clock P. M.

Eugene Stutzman
(Register of Deeds)
By _____ Deputy

DOCUMENT NUMBER **112164**

43612342000