

CERTIFIED LAND CORNER RESTORATION

Index No. X-16

State of Wisconsin }  
County of Forest } ss.


I Philip T. Hansen, do hereby certify that on the 1st day of September, 1977, I ~~found~~ established ~~evidence of~~ the EC 1/16 corner of Section 34 Township 36, North, Range 12 East, Fourth Principal Meridian, as described hereon; and that from this evidence I established a new monument and accessories as described hereon to perpetuate the original location of this corner.

Resident witnesses:


Glen Barker

Jim Claflin

Herb Wagoner

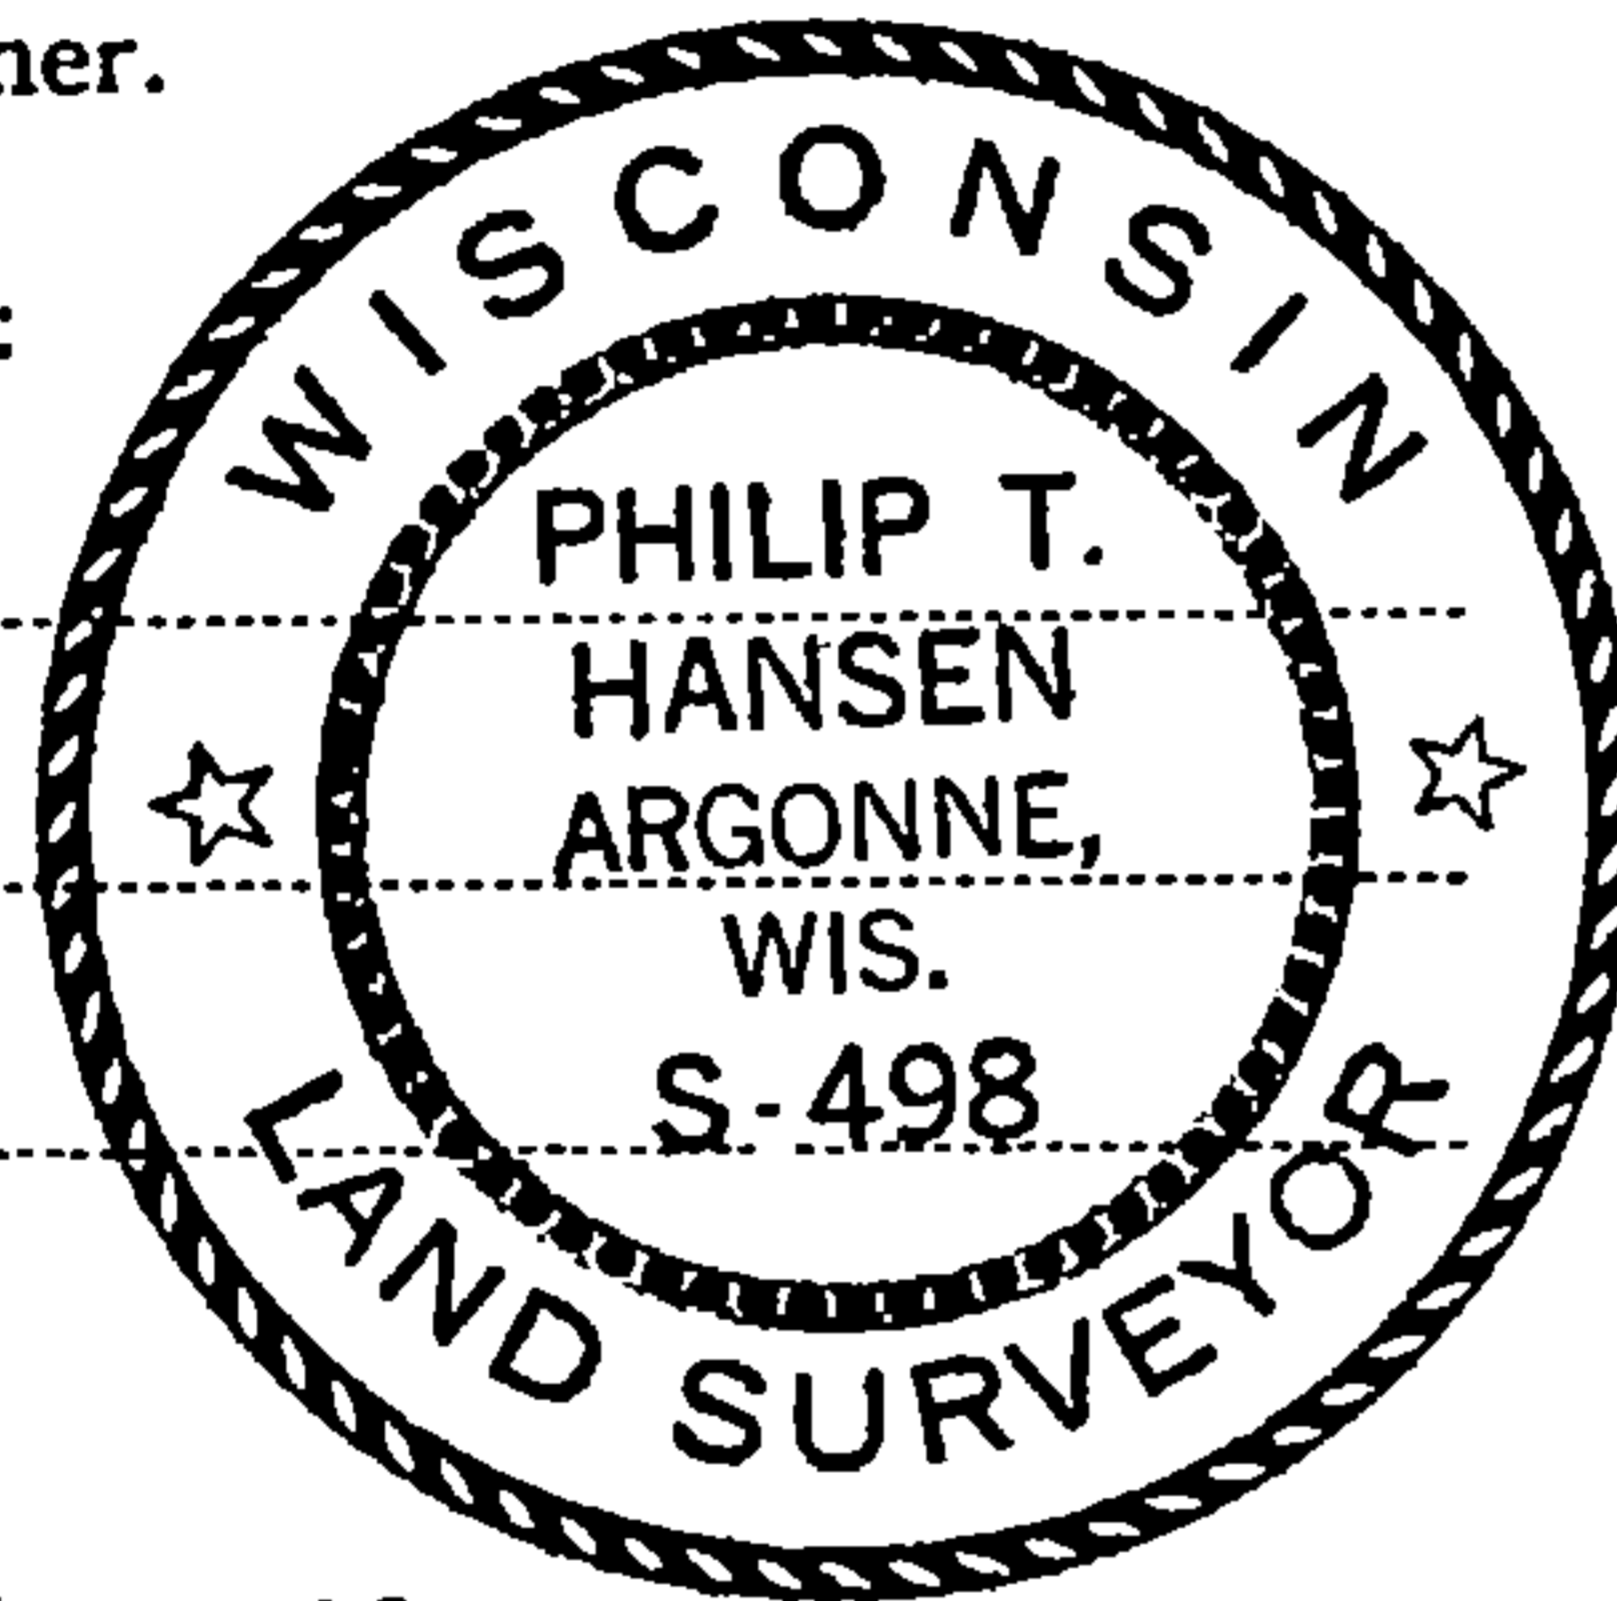

T36N R12E

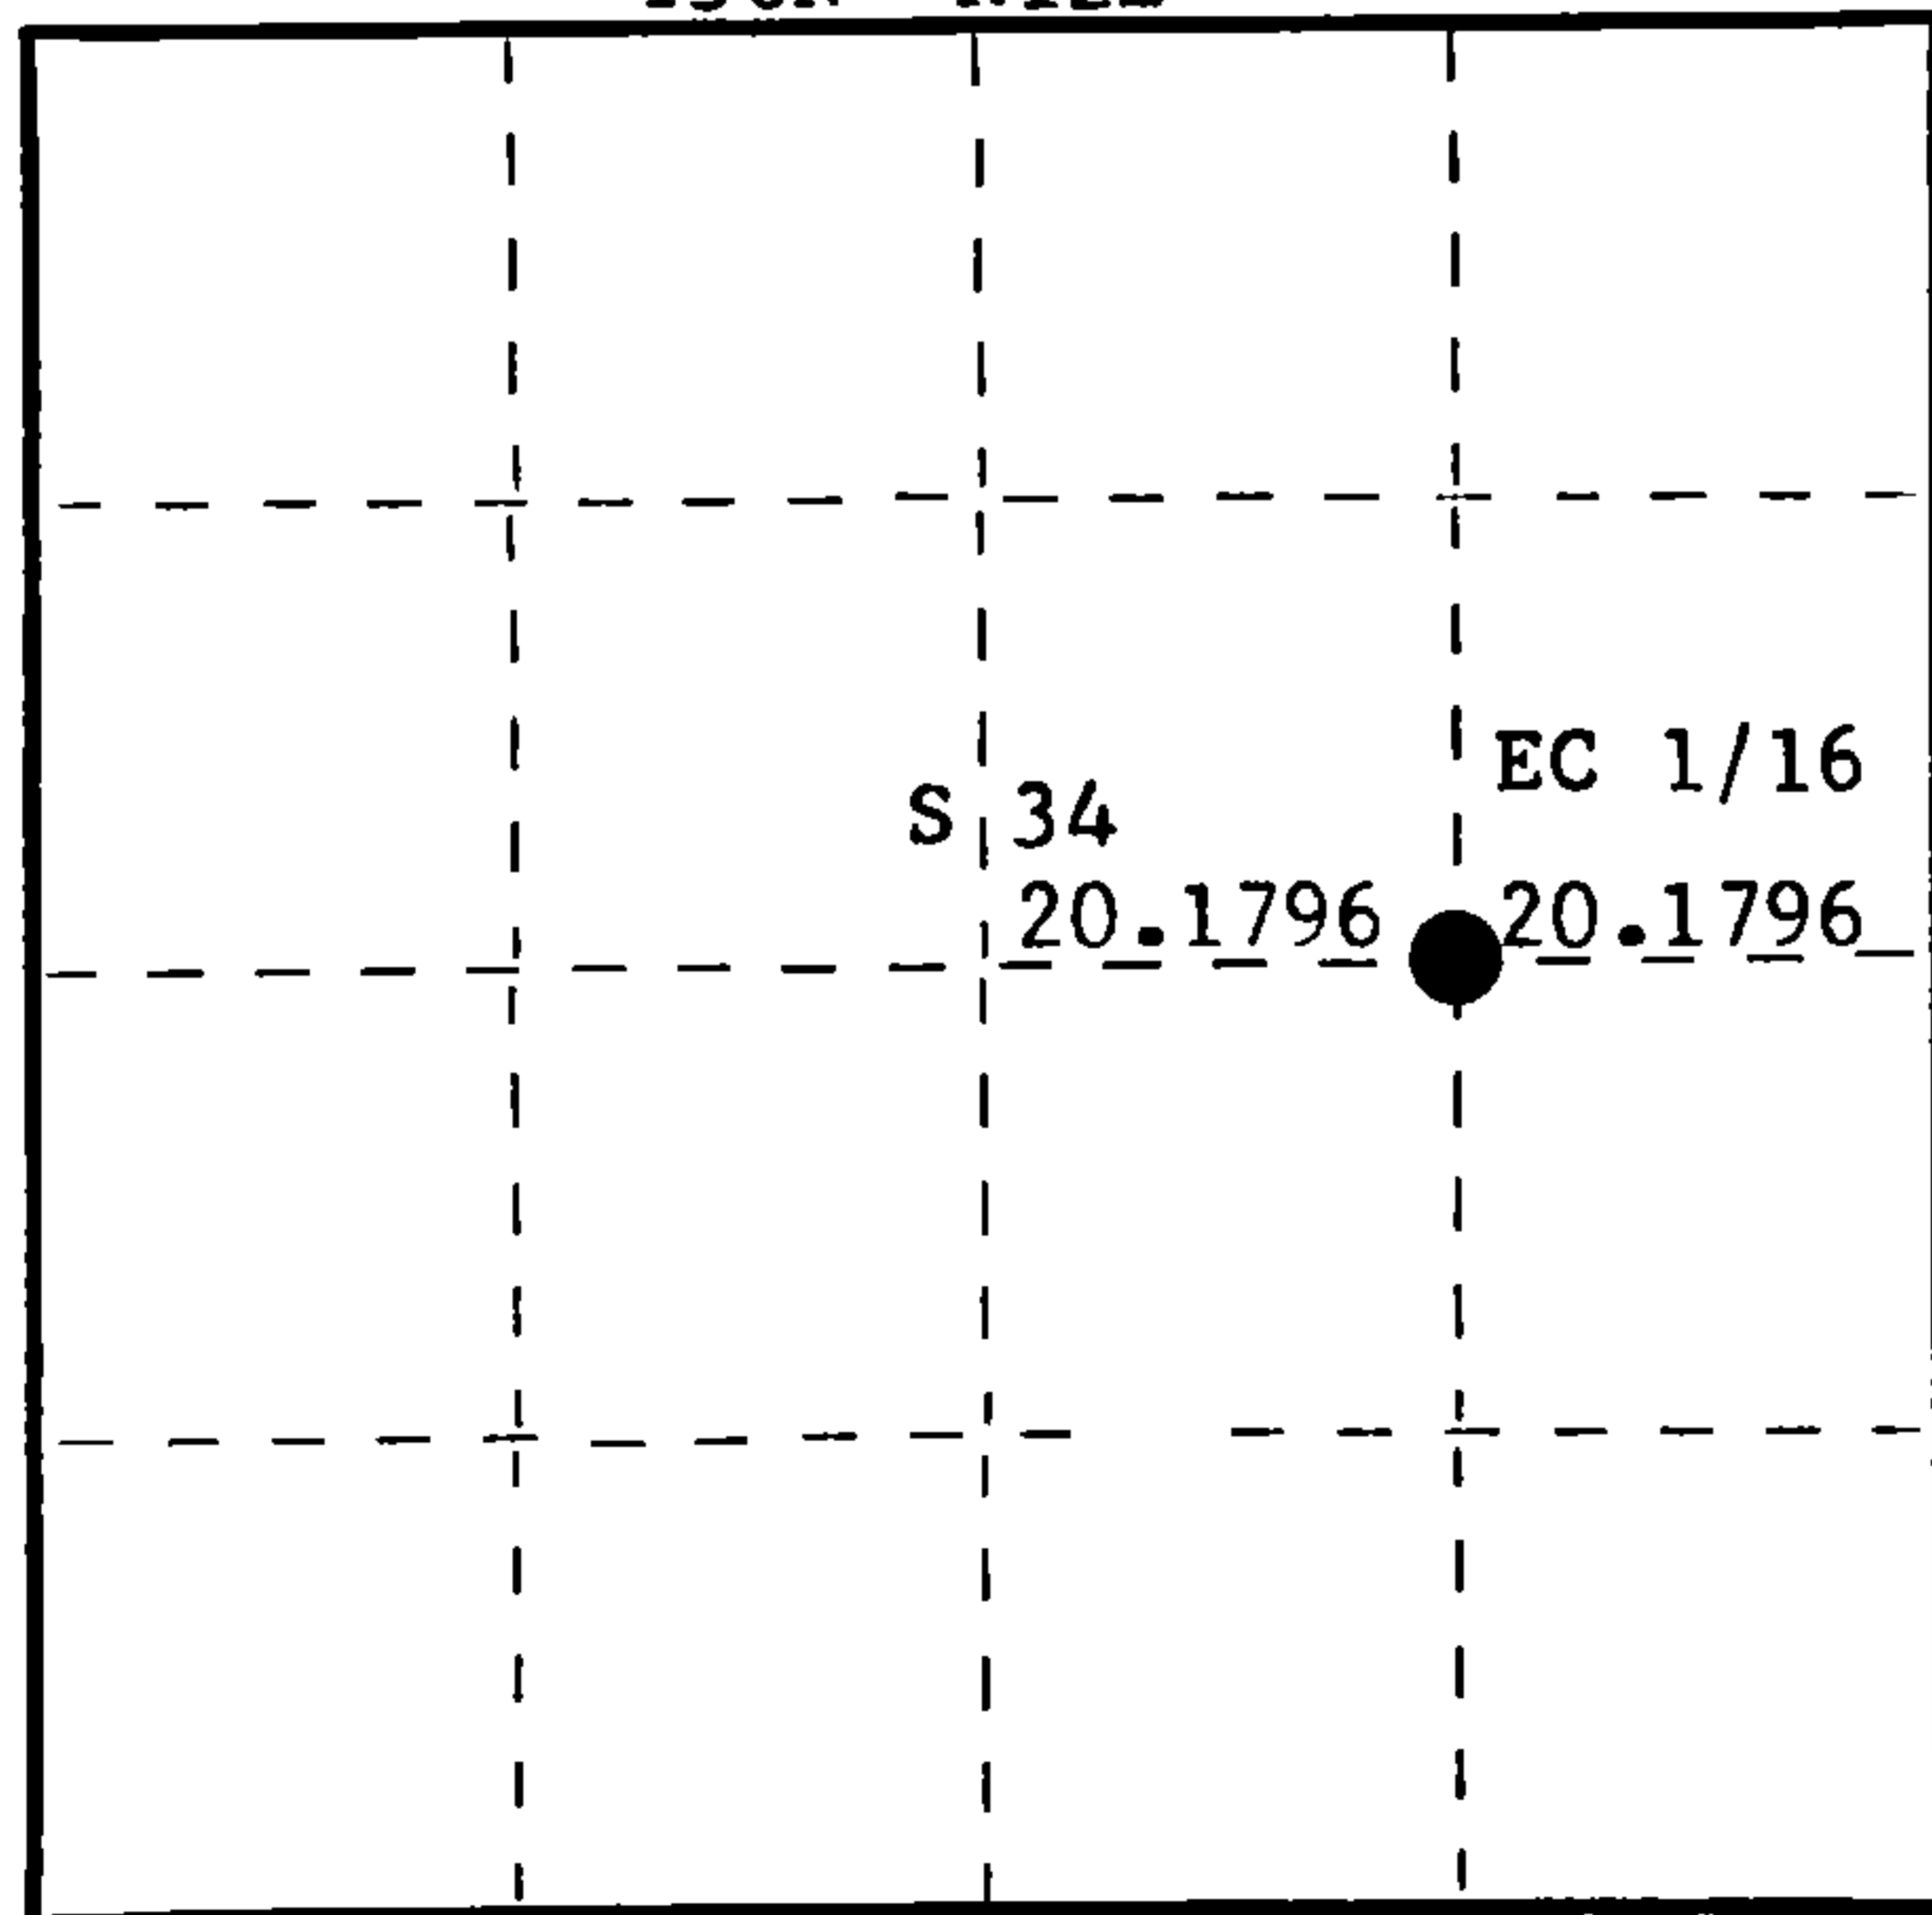

○ = Corner monument restored.

History of original corner establishment:

No records of any previous survey.

Description of corner evidence found:

No evidence of any corner recovered.

Corner established by proportional measurement intermediate between previously established C 1/4 corner and E 1/4 corner, total distance 2663.7058 ft. (40.3591 chains) at bearing S 87° 43' 16" E.

Set EC 1/16 at 20.1796 chains intermediate.

Description of monument and accessories I established to perpetuate the original location of this corner.

Set 1 1/2" iron pipe with 2" brass cap projecting 12" above ground. Cap stamped: Corner sets on the west edge of old N-S rock fence.

Marked NBTs - Sugar 6" N70° E, 19 links

Sugar 6" S26° E, 42.5 links, scribed 1/16 BT.

S498  
T36N R12E  
EC 1/16 S<sup>34</sup>  
CPI-1977

Dated at Rhineland, Wis., this 6th day of September, 1977

Signature Philip T. Hansen Title Registered Land Surveyor Registration No. S-498  
(County Surveyor, Registered Land Surveyor, or other duly authorized official)

Office of Register of Deeds, County of Forest, I hereby certify that the within instrument was filed in this office for record on the 7TH day of September, 1977 at 2:30 o'clock P. M.

Eugene Stagny  
(Register of Deeds)  
By \_\_\_\_\_ Deputy

DOCUMENT NUMBER **112287**

FORM 985 H. C. MILLER CO., MILWAUKEE

43612342010