

CERTIFIED LAND CORNER RESTORATION

Index No. X-14

State of Wisconsin }
County of Forest } ss.


I Philip T. Hansen, do hereby certify that on the 30th day of August, 1977, I ~~found~~ established evidence of the WC 1/16 corner of Section 34 Township 36, North, Range 12 East, Fourth Principal Meridian, as described hereon; and that from this evidence I established a new monument and accessories as described hereon to perpetuate the original location of this corner.

Resident witnesses:


Glen Barker

Jim Claflin

Herb Wagoner

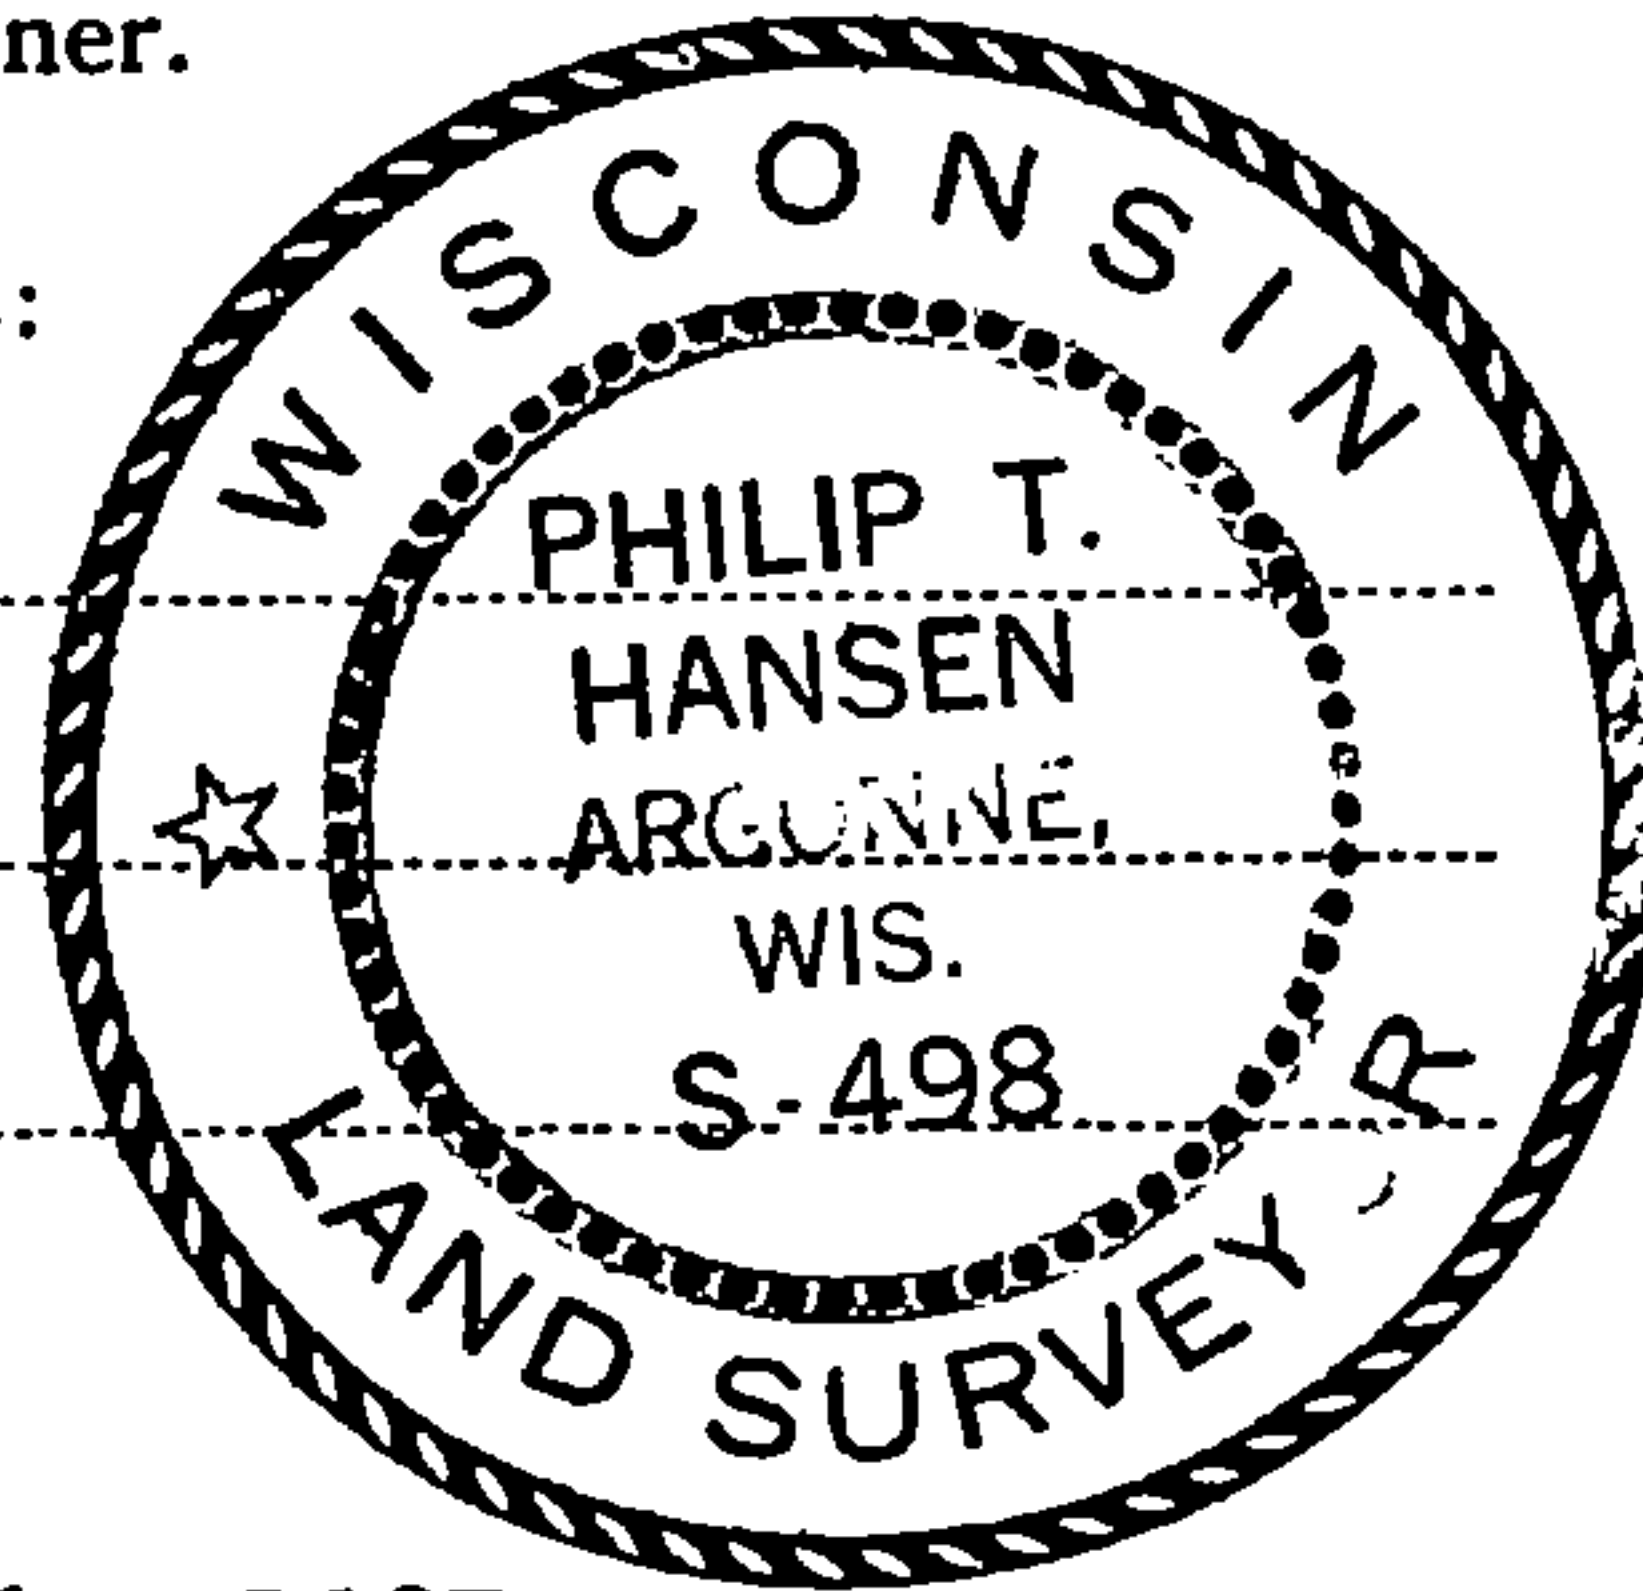

FORM 985 H. C. MILLER CO., MILWAUKEE

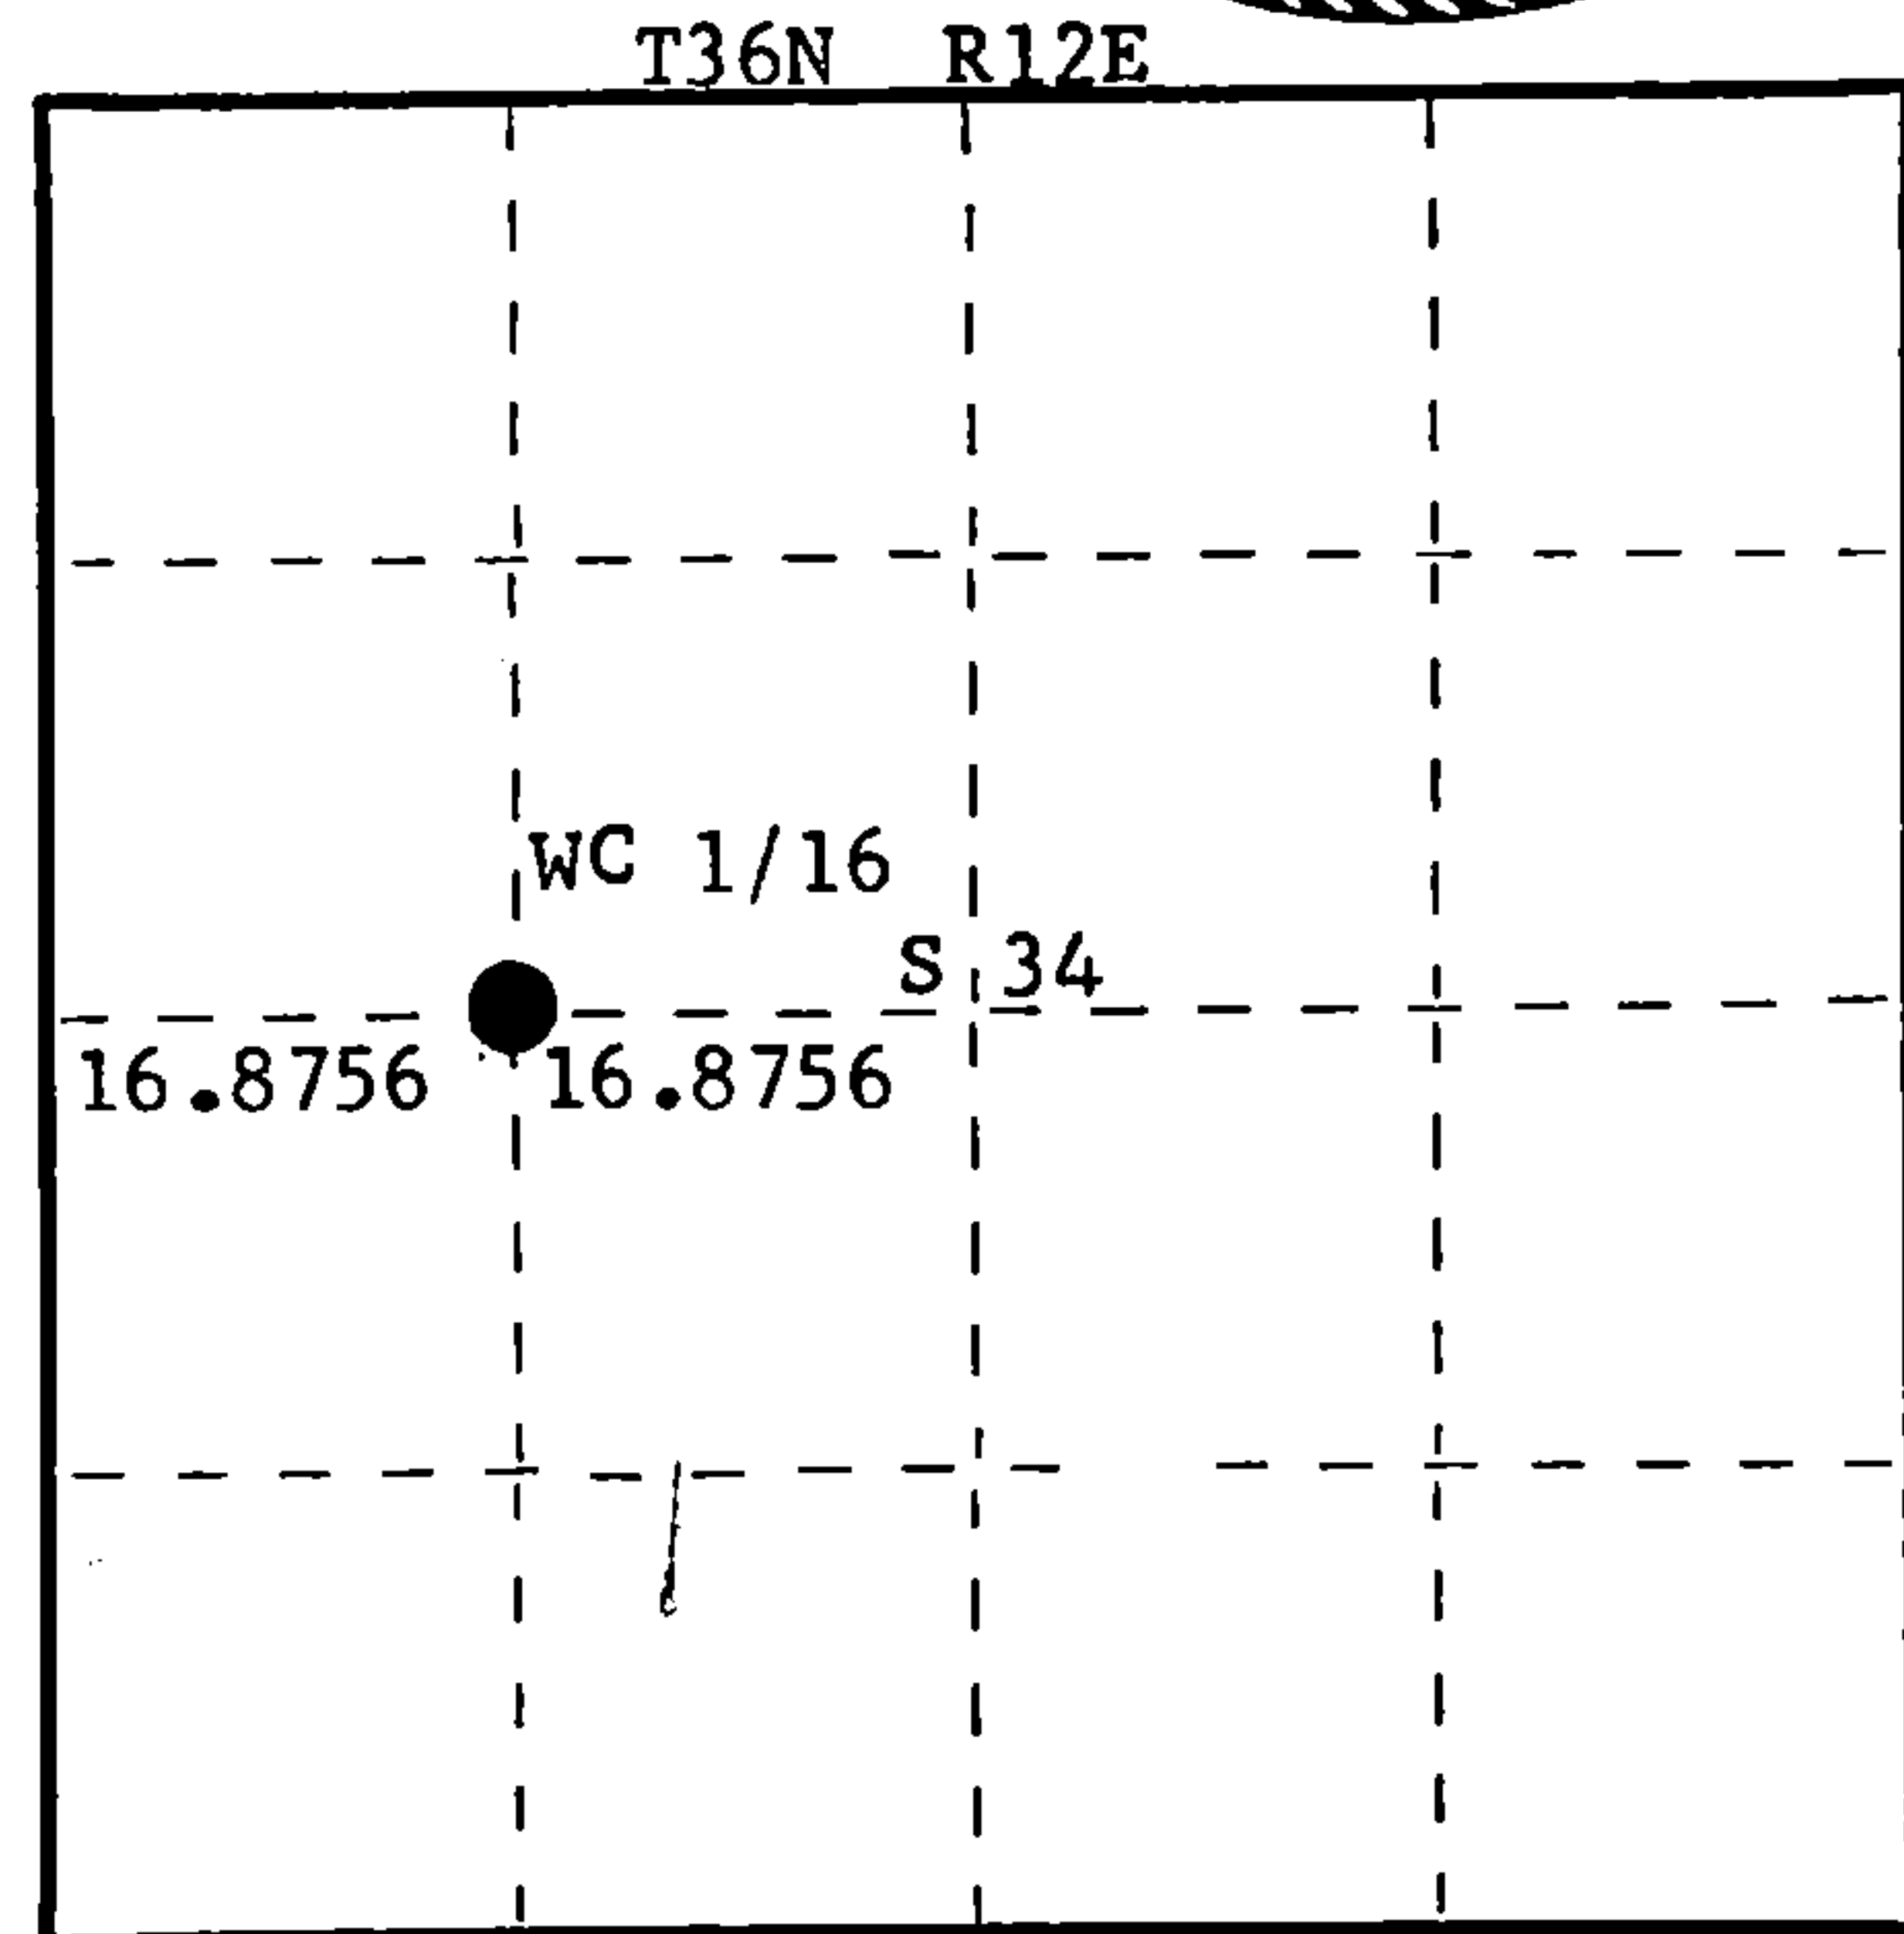

○ = Corner monument restored.

History of original corner establishment:
No records of any previous survey.

Description of corner evidence found:

No evidence of any corner recovered.
Corner established by traverse and computations of entire section corner set by proportion between established C 1/4 corner and W 1/4 corner. Computed distance 33.75 chains at bearing S 87° 43' 16" E. Corner established at 16.8756 chains intermediate.

Description of monument and accessories I established to perpetuate the original location of this corner.

Set 1 1/2" iron pipe with 2" brass cap projecting 18" above ground. Cap stamped:
Marked NBTs - Tamarack 5" N6°W, 108.1 links, scribed 1/16 BT.
Tamarack 4" N3°E, 70.3 links, scribed 1/16 BT.

S498
T36N R12E
WC 1/16 S 34
CPI-1977

43012342030

Dated at Rhinelander, Wis., this 1st day of September, 1977

Signature Philip T. Hansen Title Registered Land Surveyor Registration No. S-498
(County Surveyor, Registered Land Surveyor, or other duly authorized official)

Office of Register of Deeds, County of Forest, I hereby certify that the within instrument was filed in this office for record on the 8th day of September, 1977 at 4:00 o'clock P. M.

Eugene Stagny
(Register of Deeds)
By _____ Deputy

DOCUMENT NUMBER -- 112301