

CERTIFIED LAND CORNER RESTORATION

Index No. W-15

State of Wisconsin }  
County of Forest } ss.


I Philip T. Hansen, do hereby certify that on the 1st day of September, 19 77, I found evidence of the NC 1/16 corner of Section 34 Township 36, North, Range 12 East, Fourth Principal Meridian, as described hereon; and that from this evidence I established a new monument and accessories as described hereon to perpetuate the original location of this corner.

Resident witnesses:


Glen Barker

Jim Claflin

Herb Wagoner

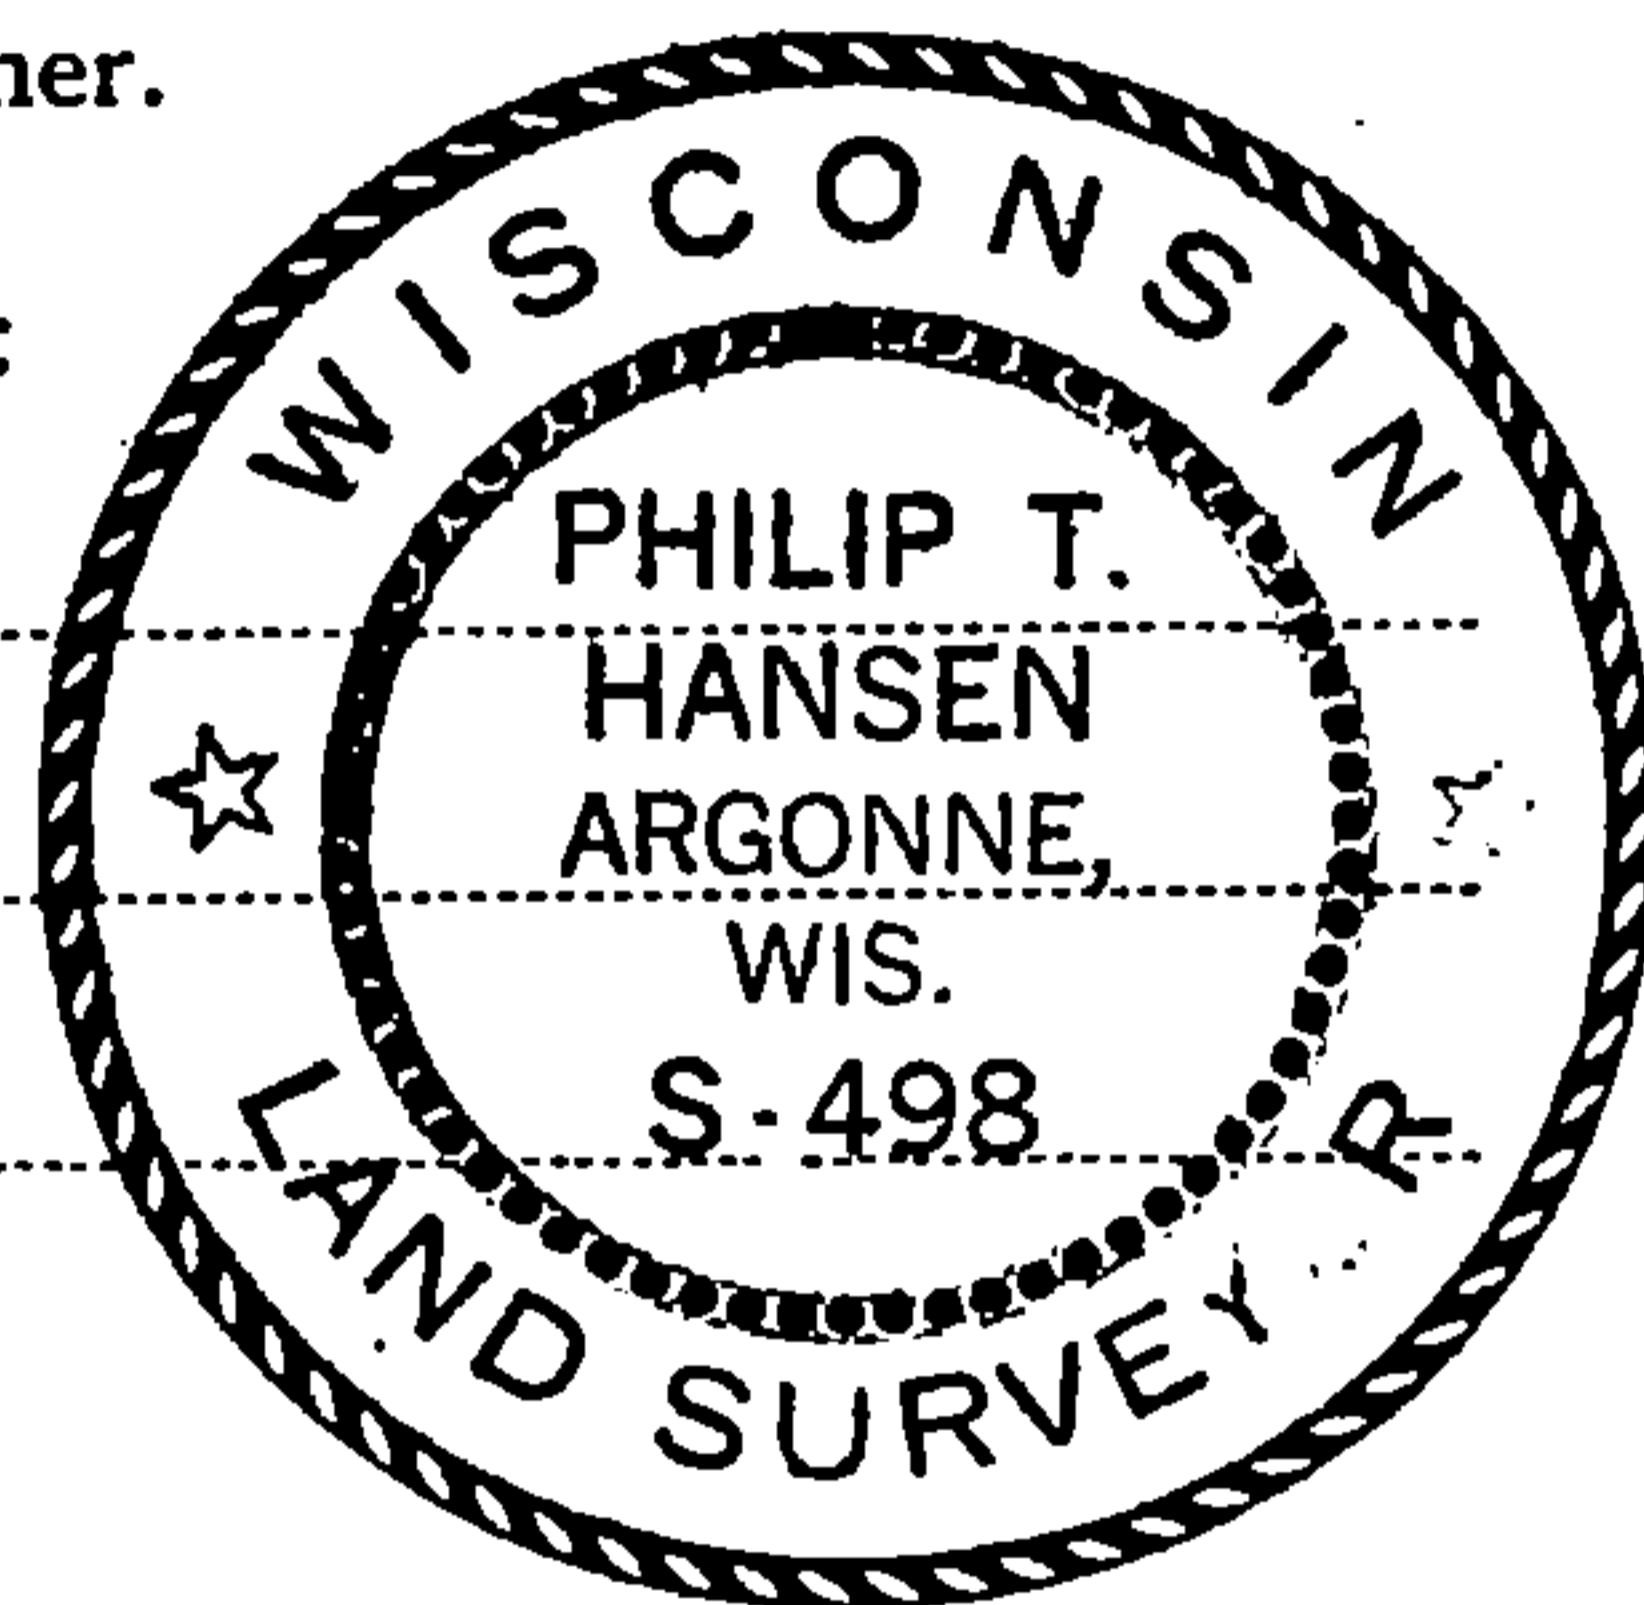

FORM 985 H. C. MILLER CO., MILWAUKEE

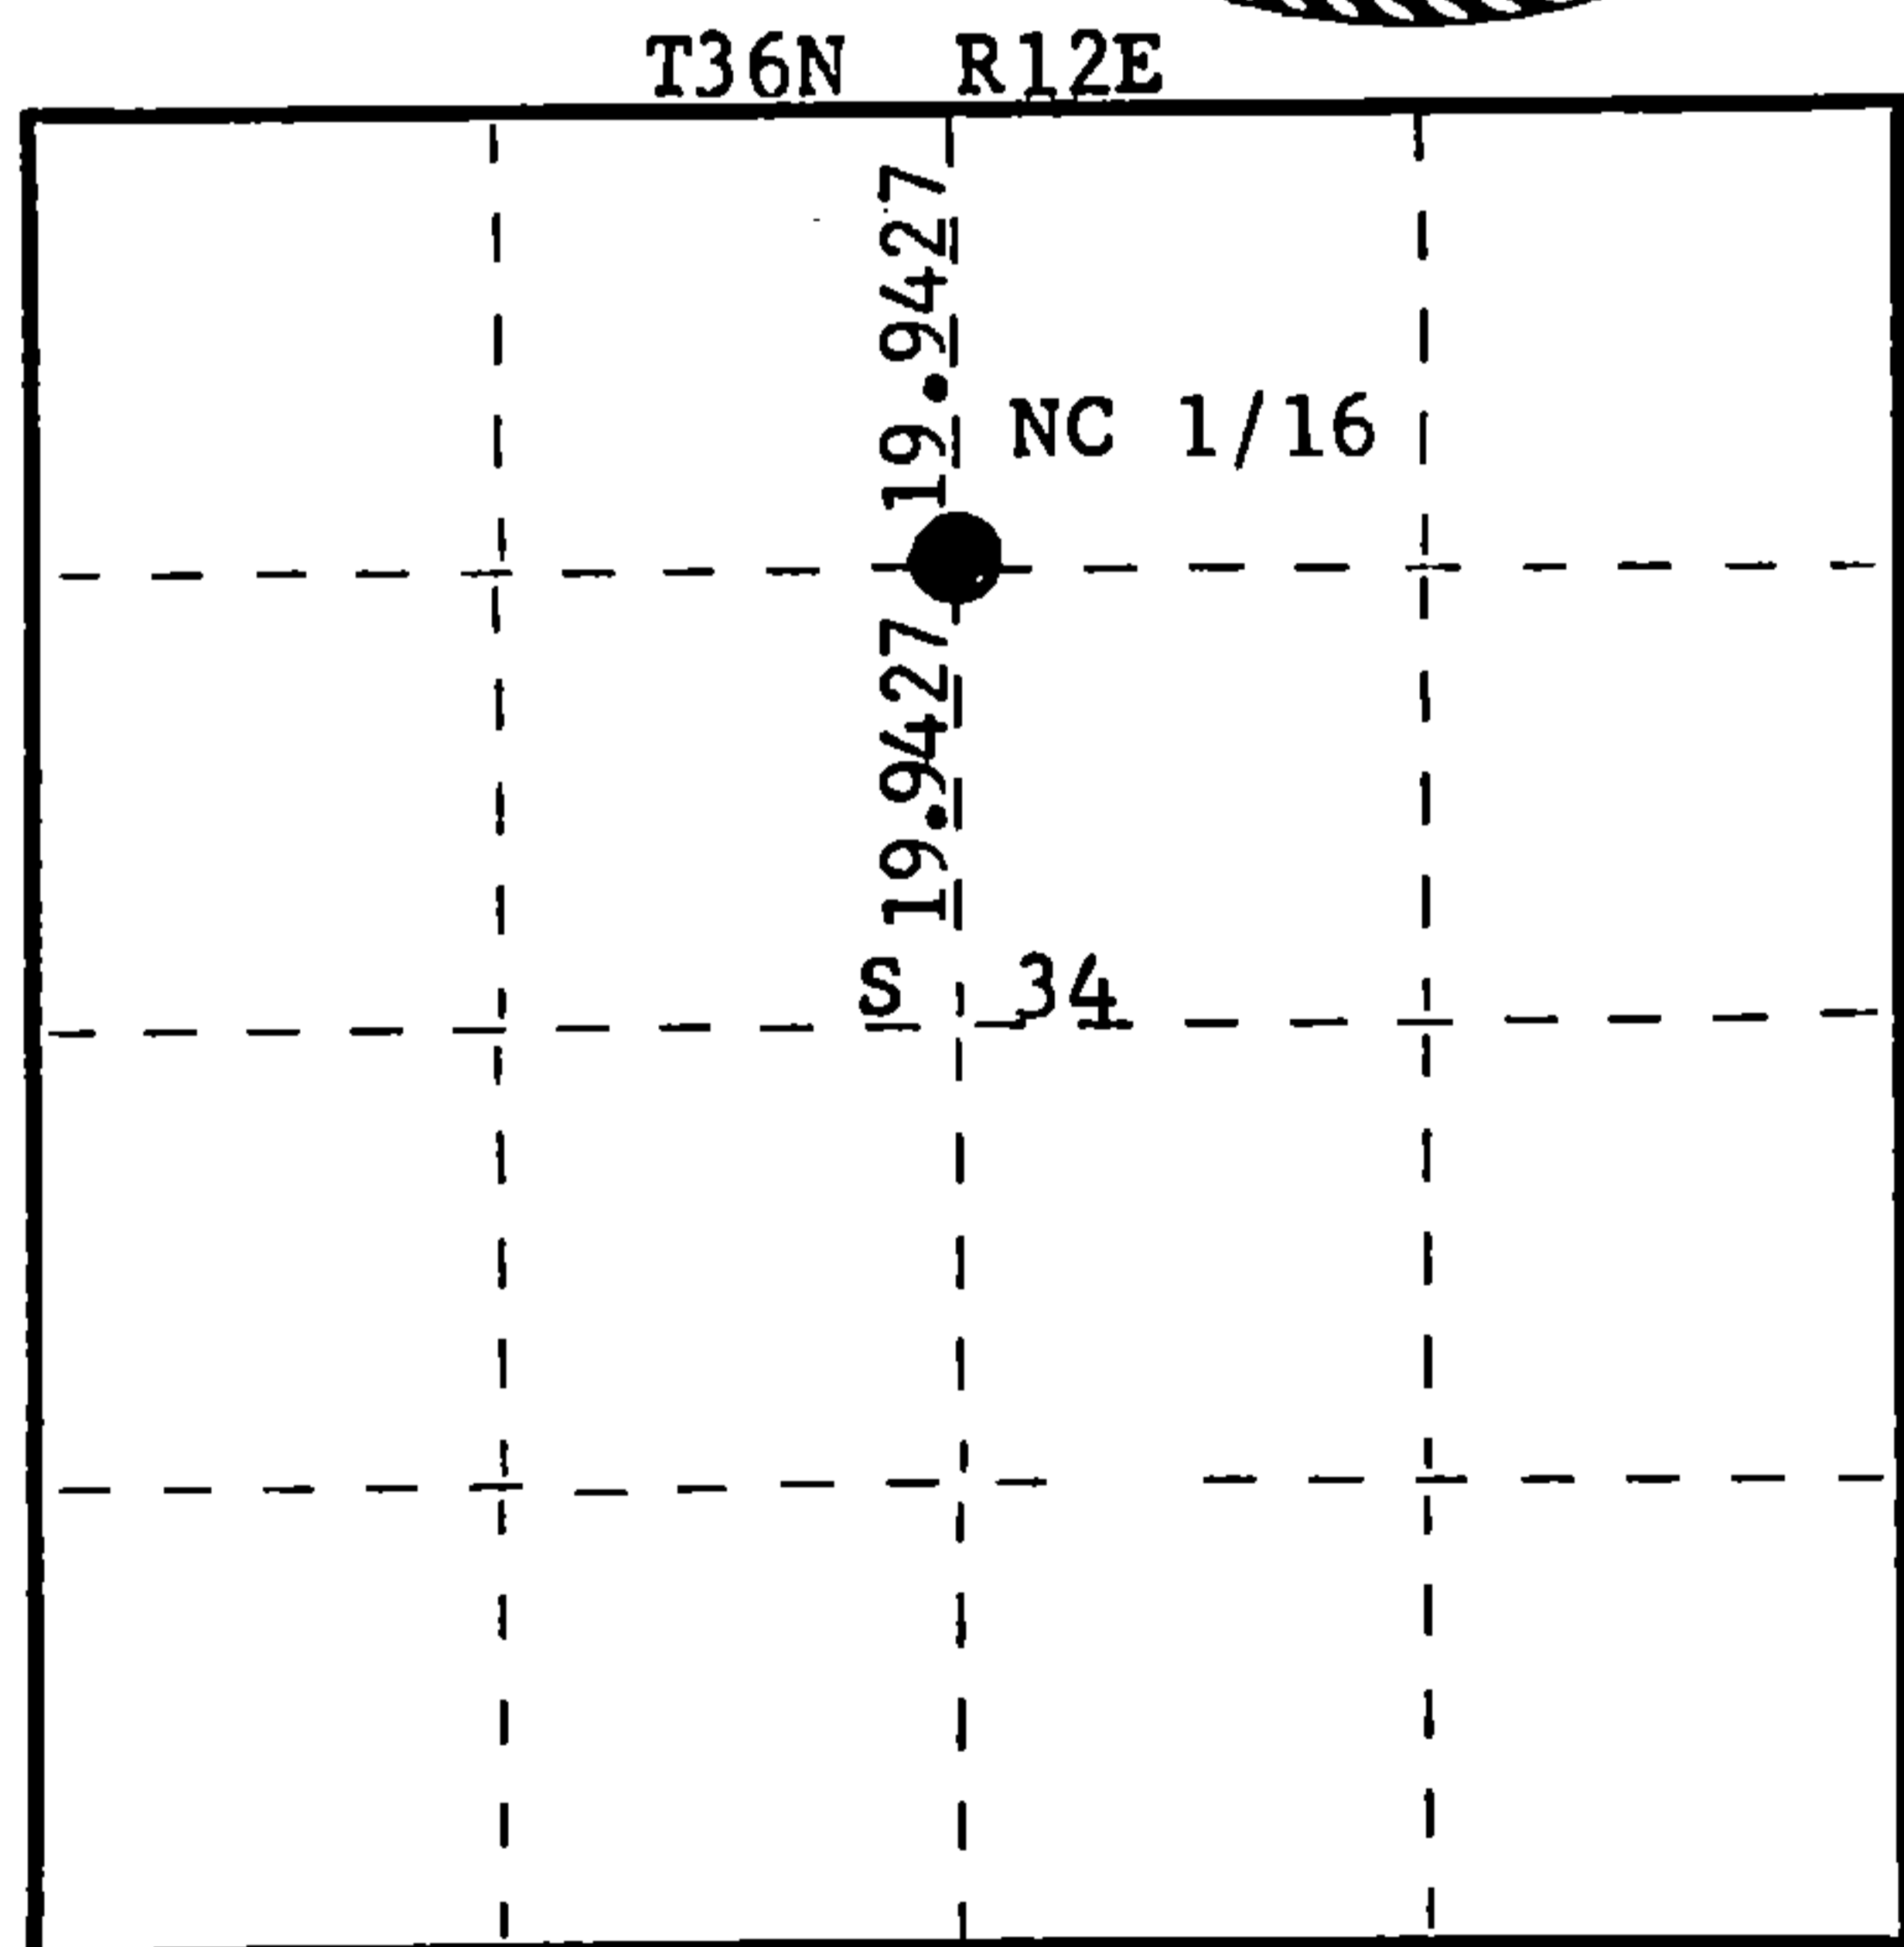

○ = Corner monument restored.

History of original corner establishment:  
No records of any previous survey.

Description of corner evidence found:

No evidence of any corner recovered.  
Corner set by proportion from previously established N 1/4 corner and C 1/4 corner established by traverse and computation.  
Computed distance above 39.885 chains at bearing N 02° 02' 38" E.

Description of monument and accessories I established to perpetuate the original location of this corner.

Set NC 1/16 at S 2° 02' 38" W at 19.9427 chains intermediate.  
Set 1 1/2" iron pipe with 2" brass cap projecting 24" above ground. Cap stamped:  
Marked NBTs - Sugar 6" S81° E, 36.7 links.  
Sugar 6" S26° W, 20.2 links, scribed 1/16 BT.

S498  
T36N R12E  
NC 1/16 S 34  
CPI-1977

Dated at Rhineland, Wis., this 6th day of September, 1977.

Signature Philip T. Hansen Title Registered Land Surveyor Registration No. S-498  
(County Surveyor, Registered Land Surveyor, or other duly authorized official)

Office of Register of Deeds, County of Forest, I hereby certify that the within instrument was filed in this office for record on the 7th day of September, 1977 at 2:30 o'clock P. M.

Eugene Staszny  
(Register of Deeds)  
By \_\_\_\_\_ Deputy

DOCUMENT NUMBER --- **112284**

43612 34 3020