

CERTIFIED LAND CORNER RESTORATION

Index No. W-14

State of Wisconsin }  
County of Forest } ss.


I Philip T. Hansen, do hereby certify that on the 2nd day of September, 1977, I found evidence of the NW 1/16 corner of Section 34 Township 36, North, Range 12 East, Fourth Principal Meridian, as described hereon; and that from this evidence I established a new monument and accessories as described hereon to perpetuate the original location of this corner.

Resident witnesses:


Glen Barker

Jim Claflin

Herb Wagoner

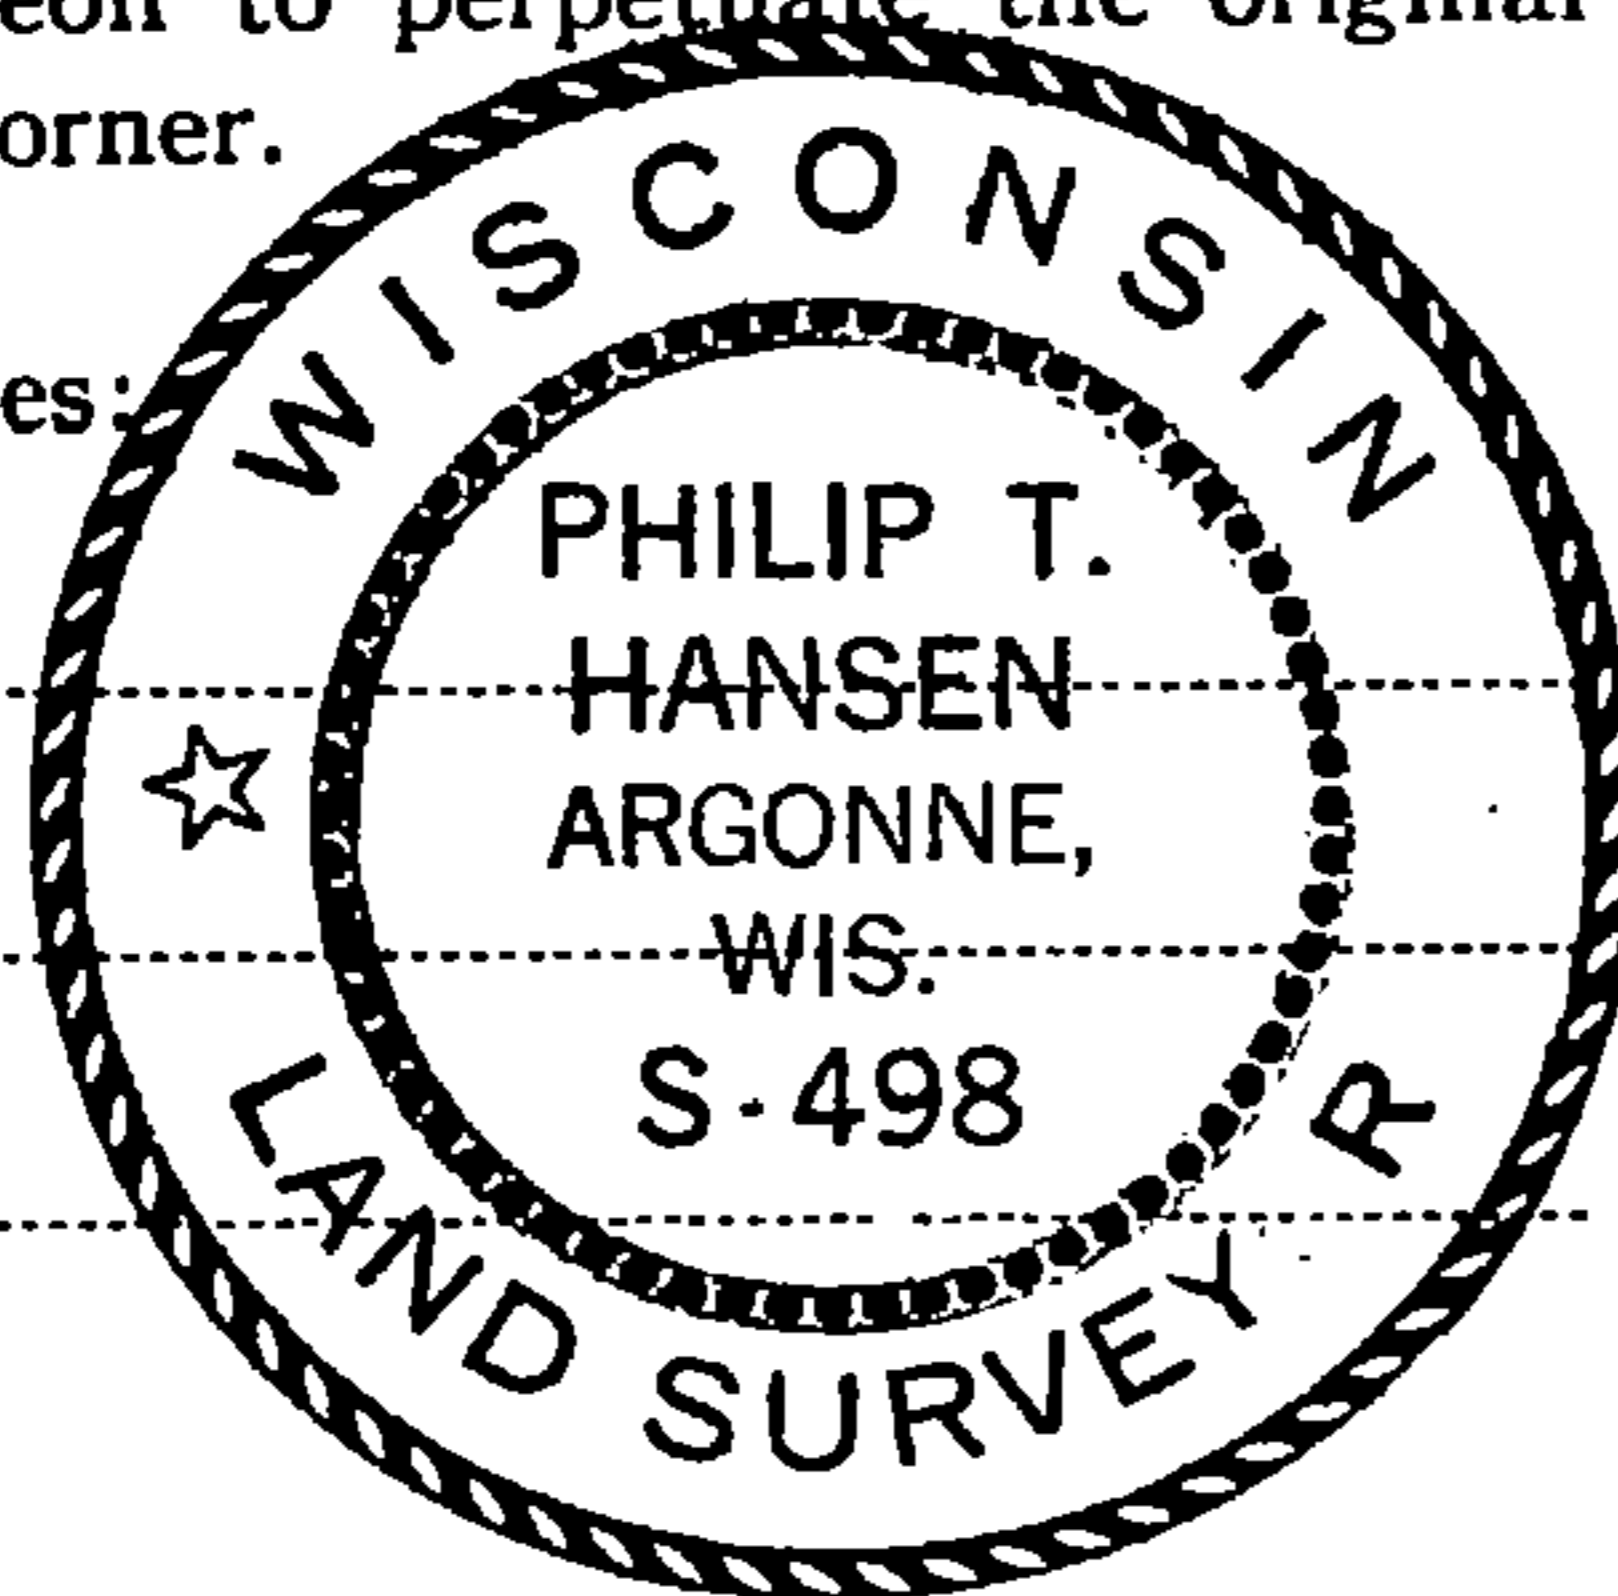

T36N R12E

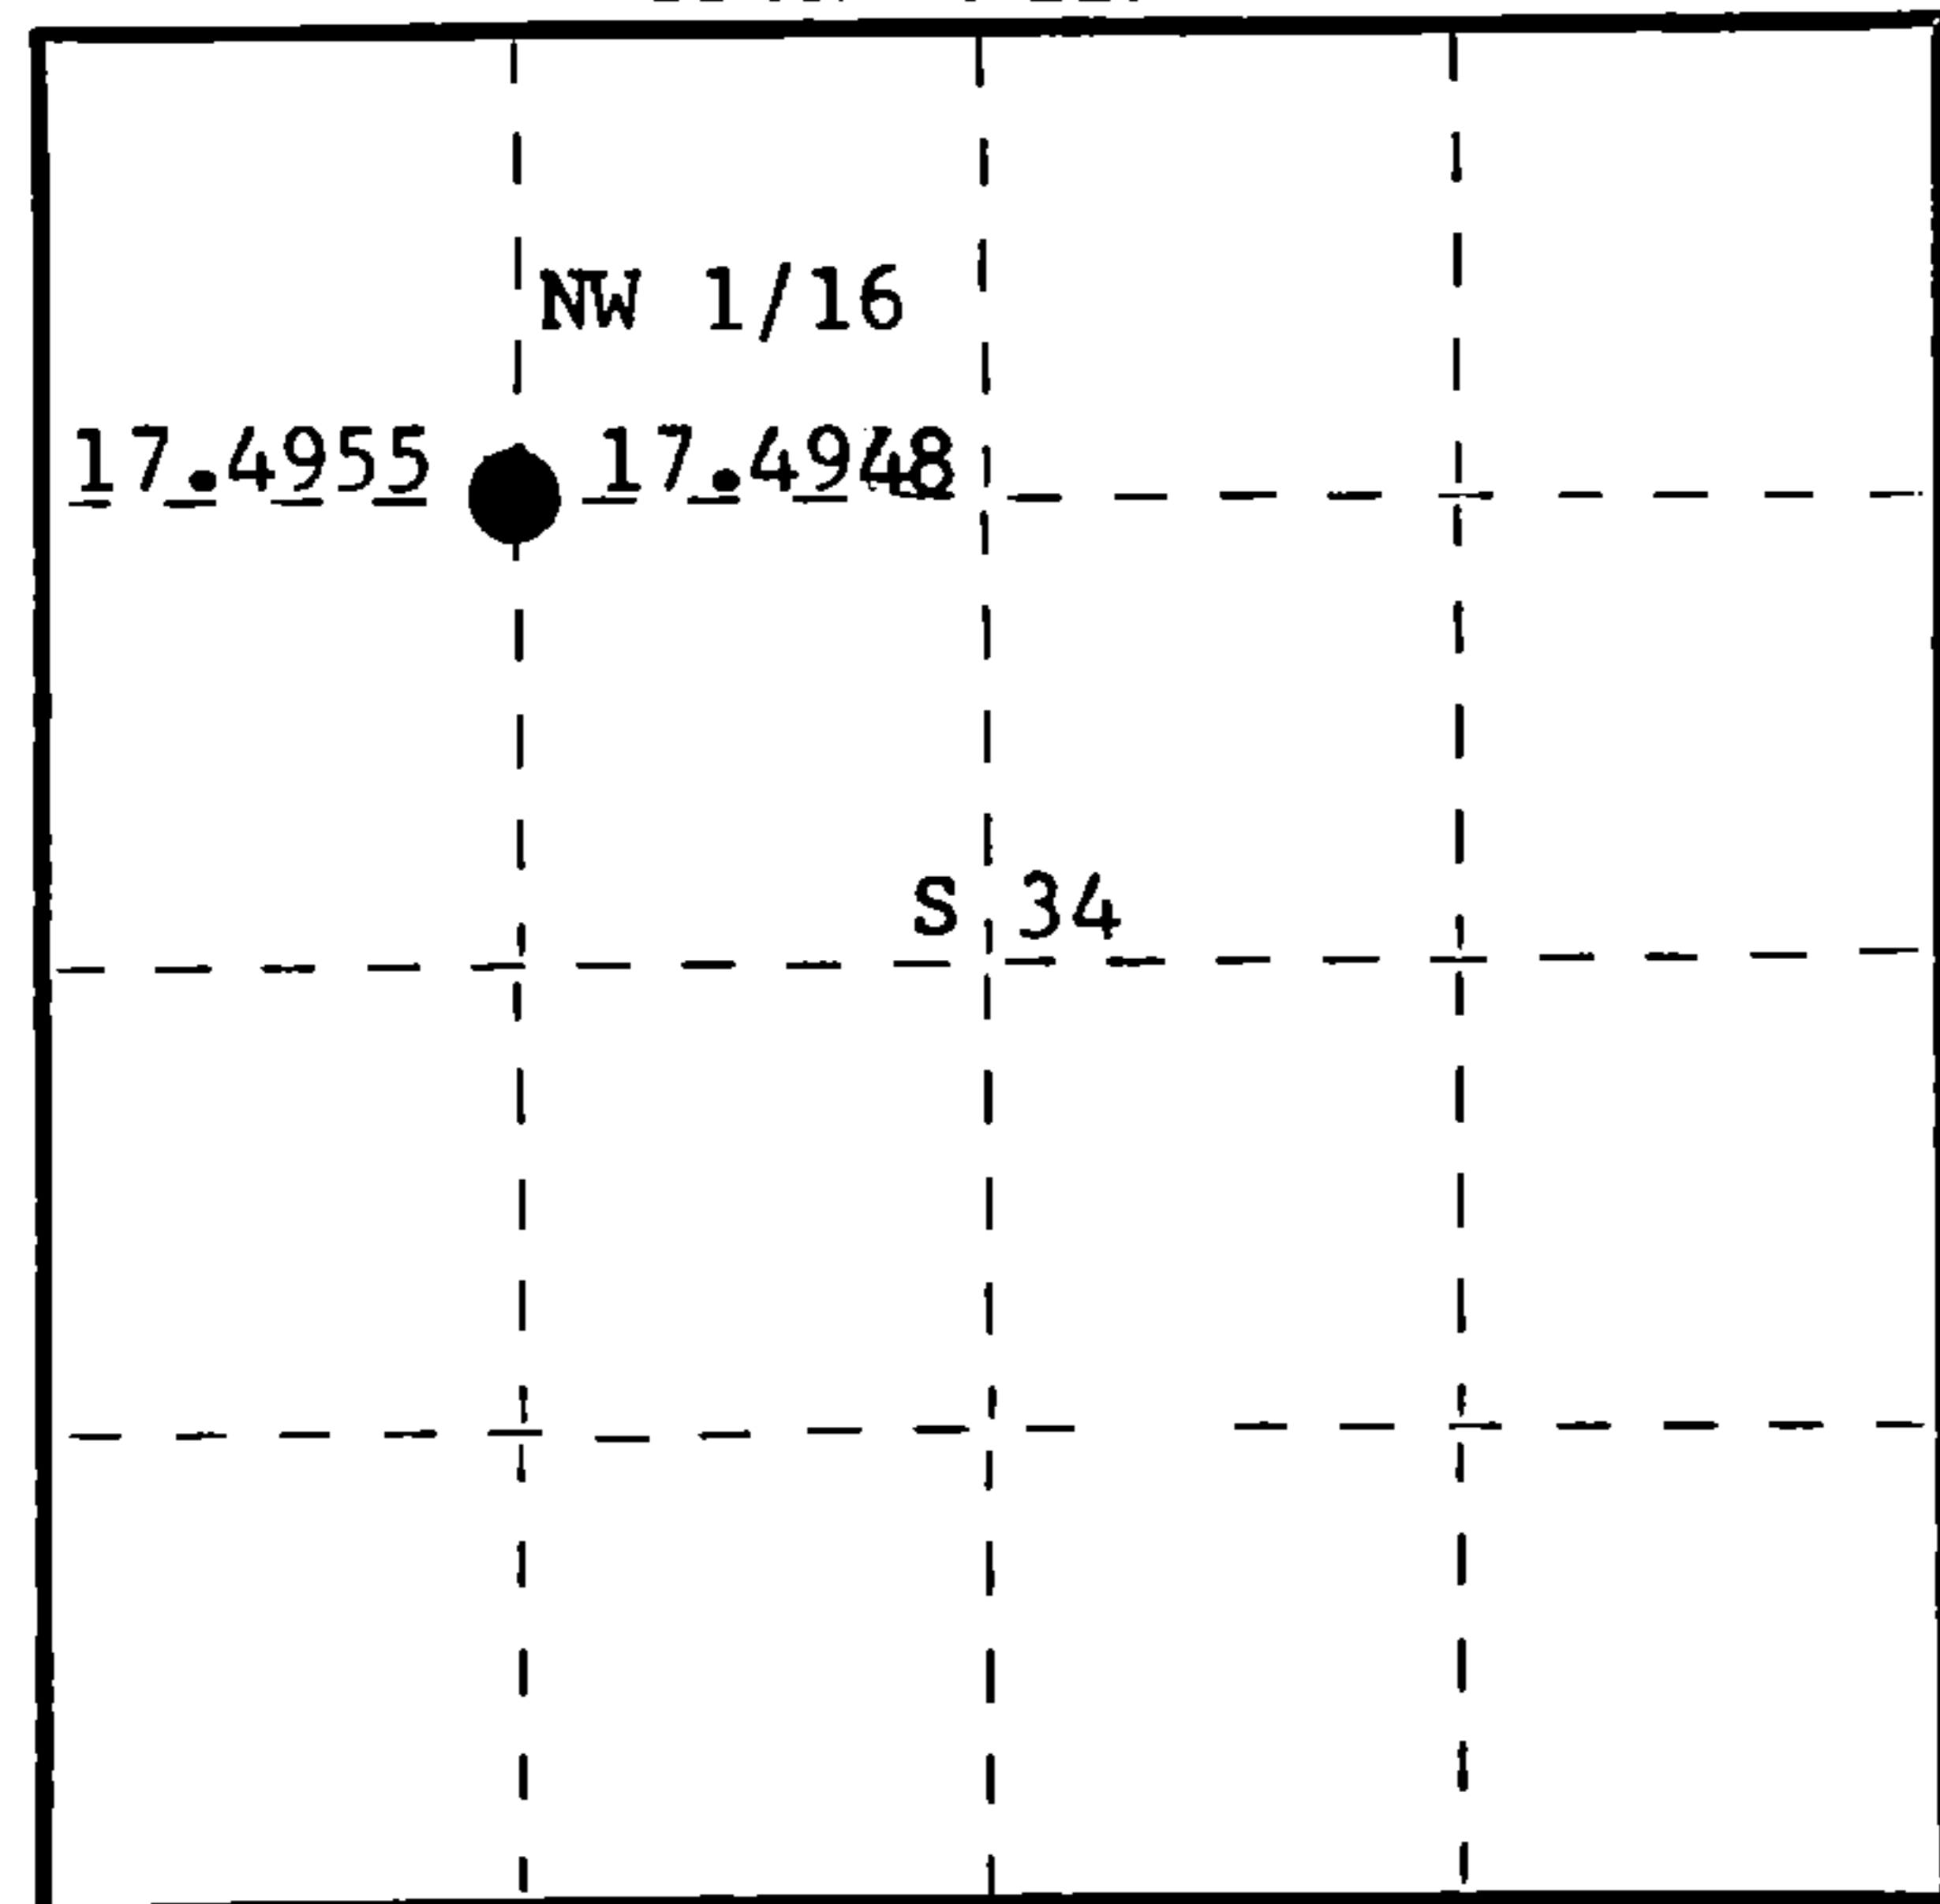

○ = Corner monument restored.

History of original corner establishment:  
No record of any survey.

Description of corner evidence found:

No evidence of any corners recovered.

Corner established by traverse and computation. Computed distance between N 1/16 and NC 1/16 corner 34.991 chains at bearing S 87° 05' 30" E.

Computed location of NW 1/16 at 17.4955 chains S 87° 08' 35" E of N 1/16 and 17.4948 chains N 87° 08' 35" W of NC 1/16 corner.

Description of monument and accessories I established to perpetuate the original location of this corner.

Set 1½" iron pipe with 2" brass cap, projecting 18" above ground. Built rock cairn around base of monument. Cap stamped:

Marked NBTs - Sugar 10" N21°E, 14.6 links.

Sugar 7" S27°E, 45.7 links, scribed 1/16 BT.

S498  
T36N R12E  
NW 1/16 S<sup>34</sup>  
CPI-1977

Dated at Rhineland, Wis., this 6th day of September, 1977.

Signature Philip T. Hansen Title Registered Land Surveyor Registration No. S-498  
(County Surveyor, Registered Land Surveyor, or other duly authorized official)

Office of Register of Deeds, County of Forest I hereby certify that the within instrument was filed in this office for record on the 7th day of September, 1977 at 2:30 o'clock P. M.

Eugene Stetson  
(Register of Deeds)  
By \_\_\_\_\_ Deputy

DOCUMENT NUMBER --- **112283**

FORM 985 R. C. MILLER CO., MILWAUKEE

43612343030