

CERTIFIED LAND CORNER RESTORATION

Index No. A-18

State of Wisconsin }
County of Forest } ss.


I Philip T. Hansen, do hereby certify that on the 29th day of July, 19 77, I ~~found~~ established ~~the~~ W 1/16 corner of Section 35 & 2 Township 36 & 35, North, Range 12 East, Fourth Principal Meridian, as described hereon; and that from this evidence I established a new monument and accessories as described hereon to perpetuate the original location of this corner.

Resident witnesses:


Glen Barker

Jim Claflin

Herb Wagoner

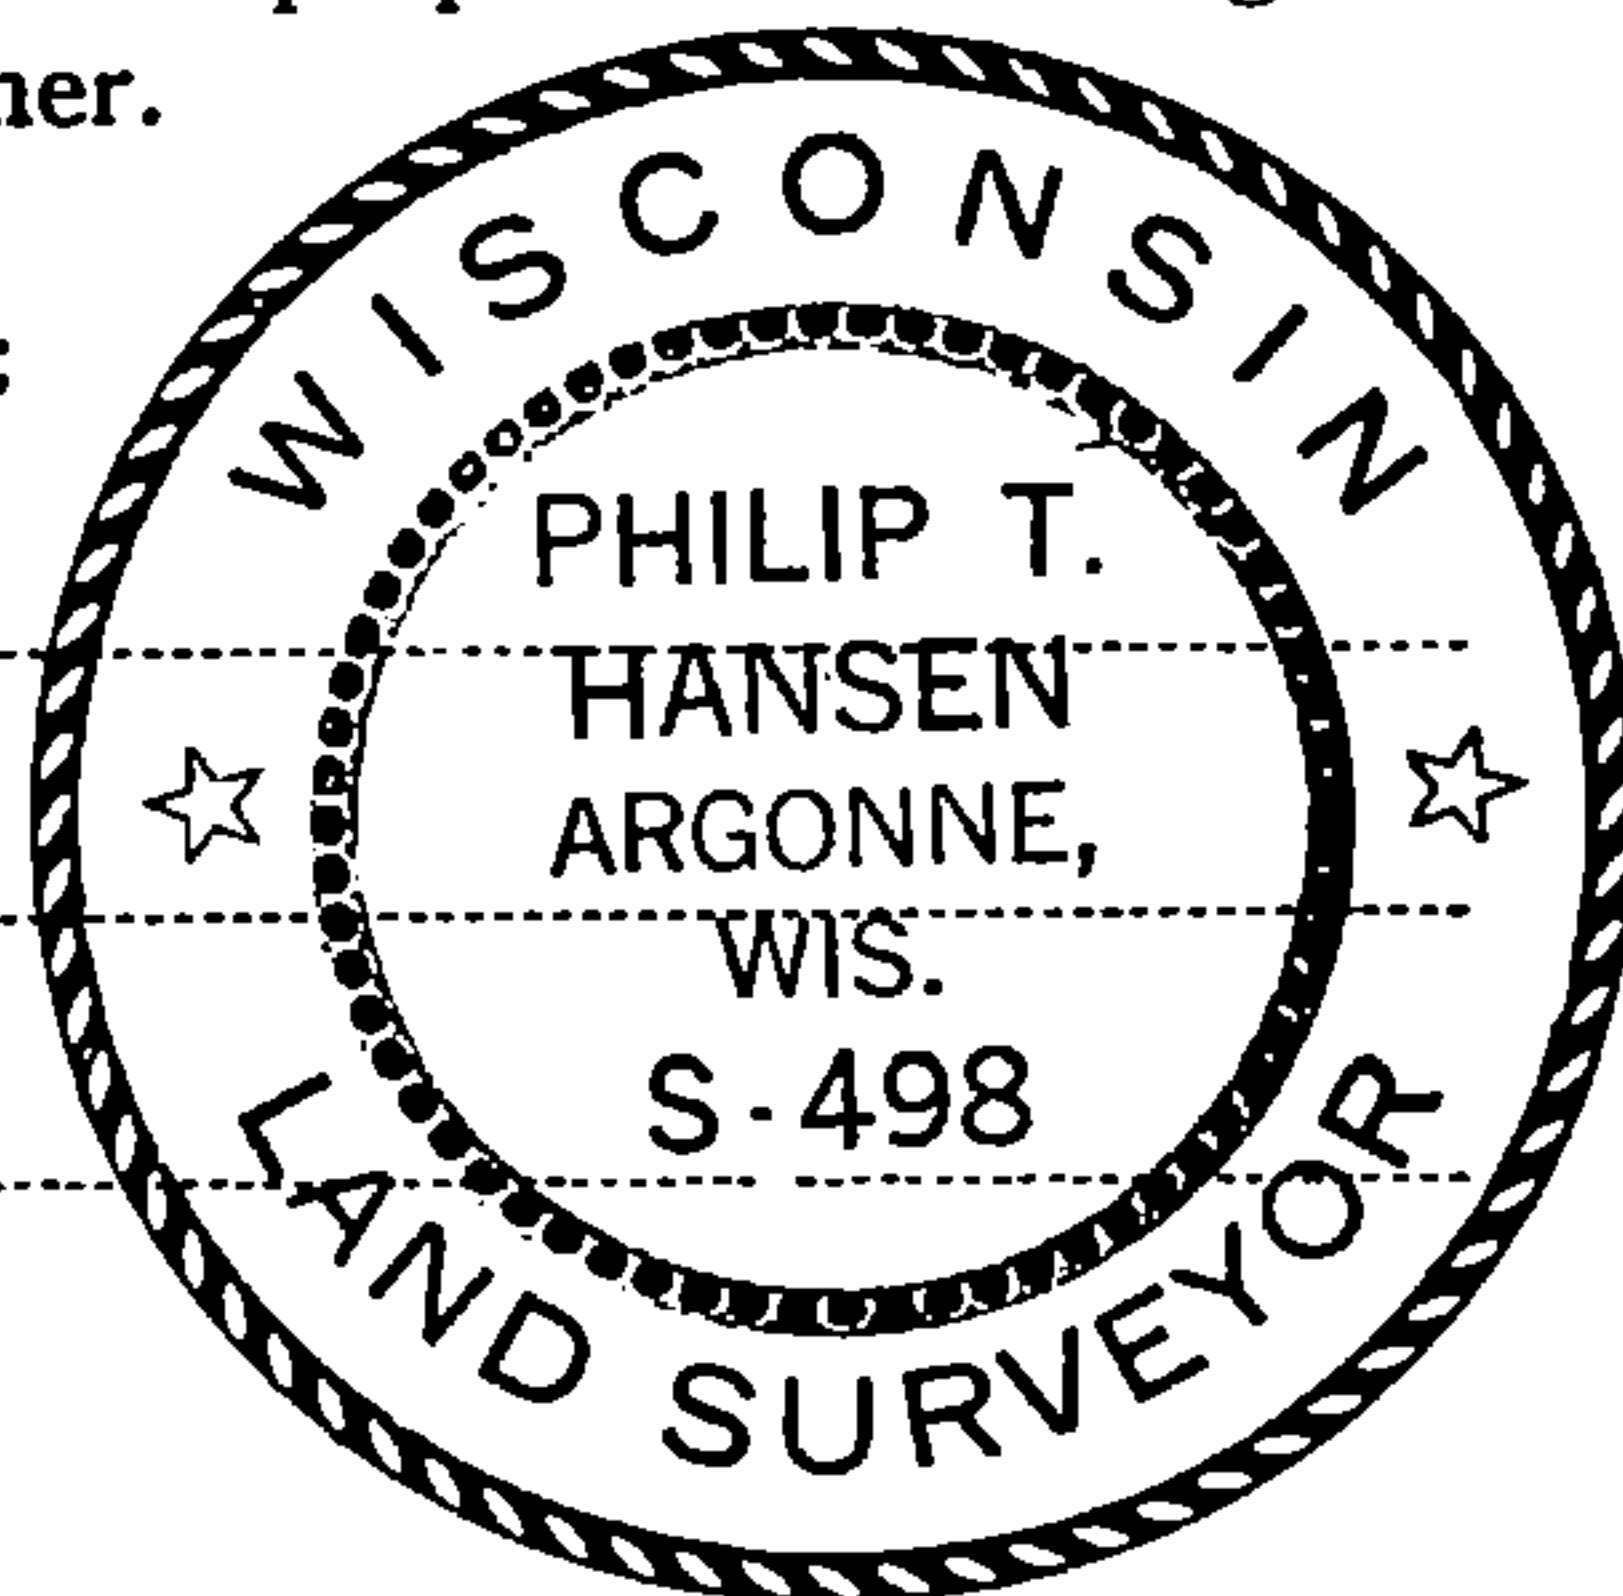

FORM 985 H. C. MILLER CO., MILWAUKEE

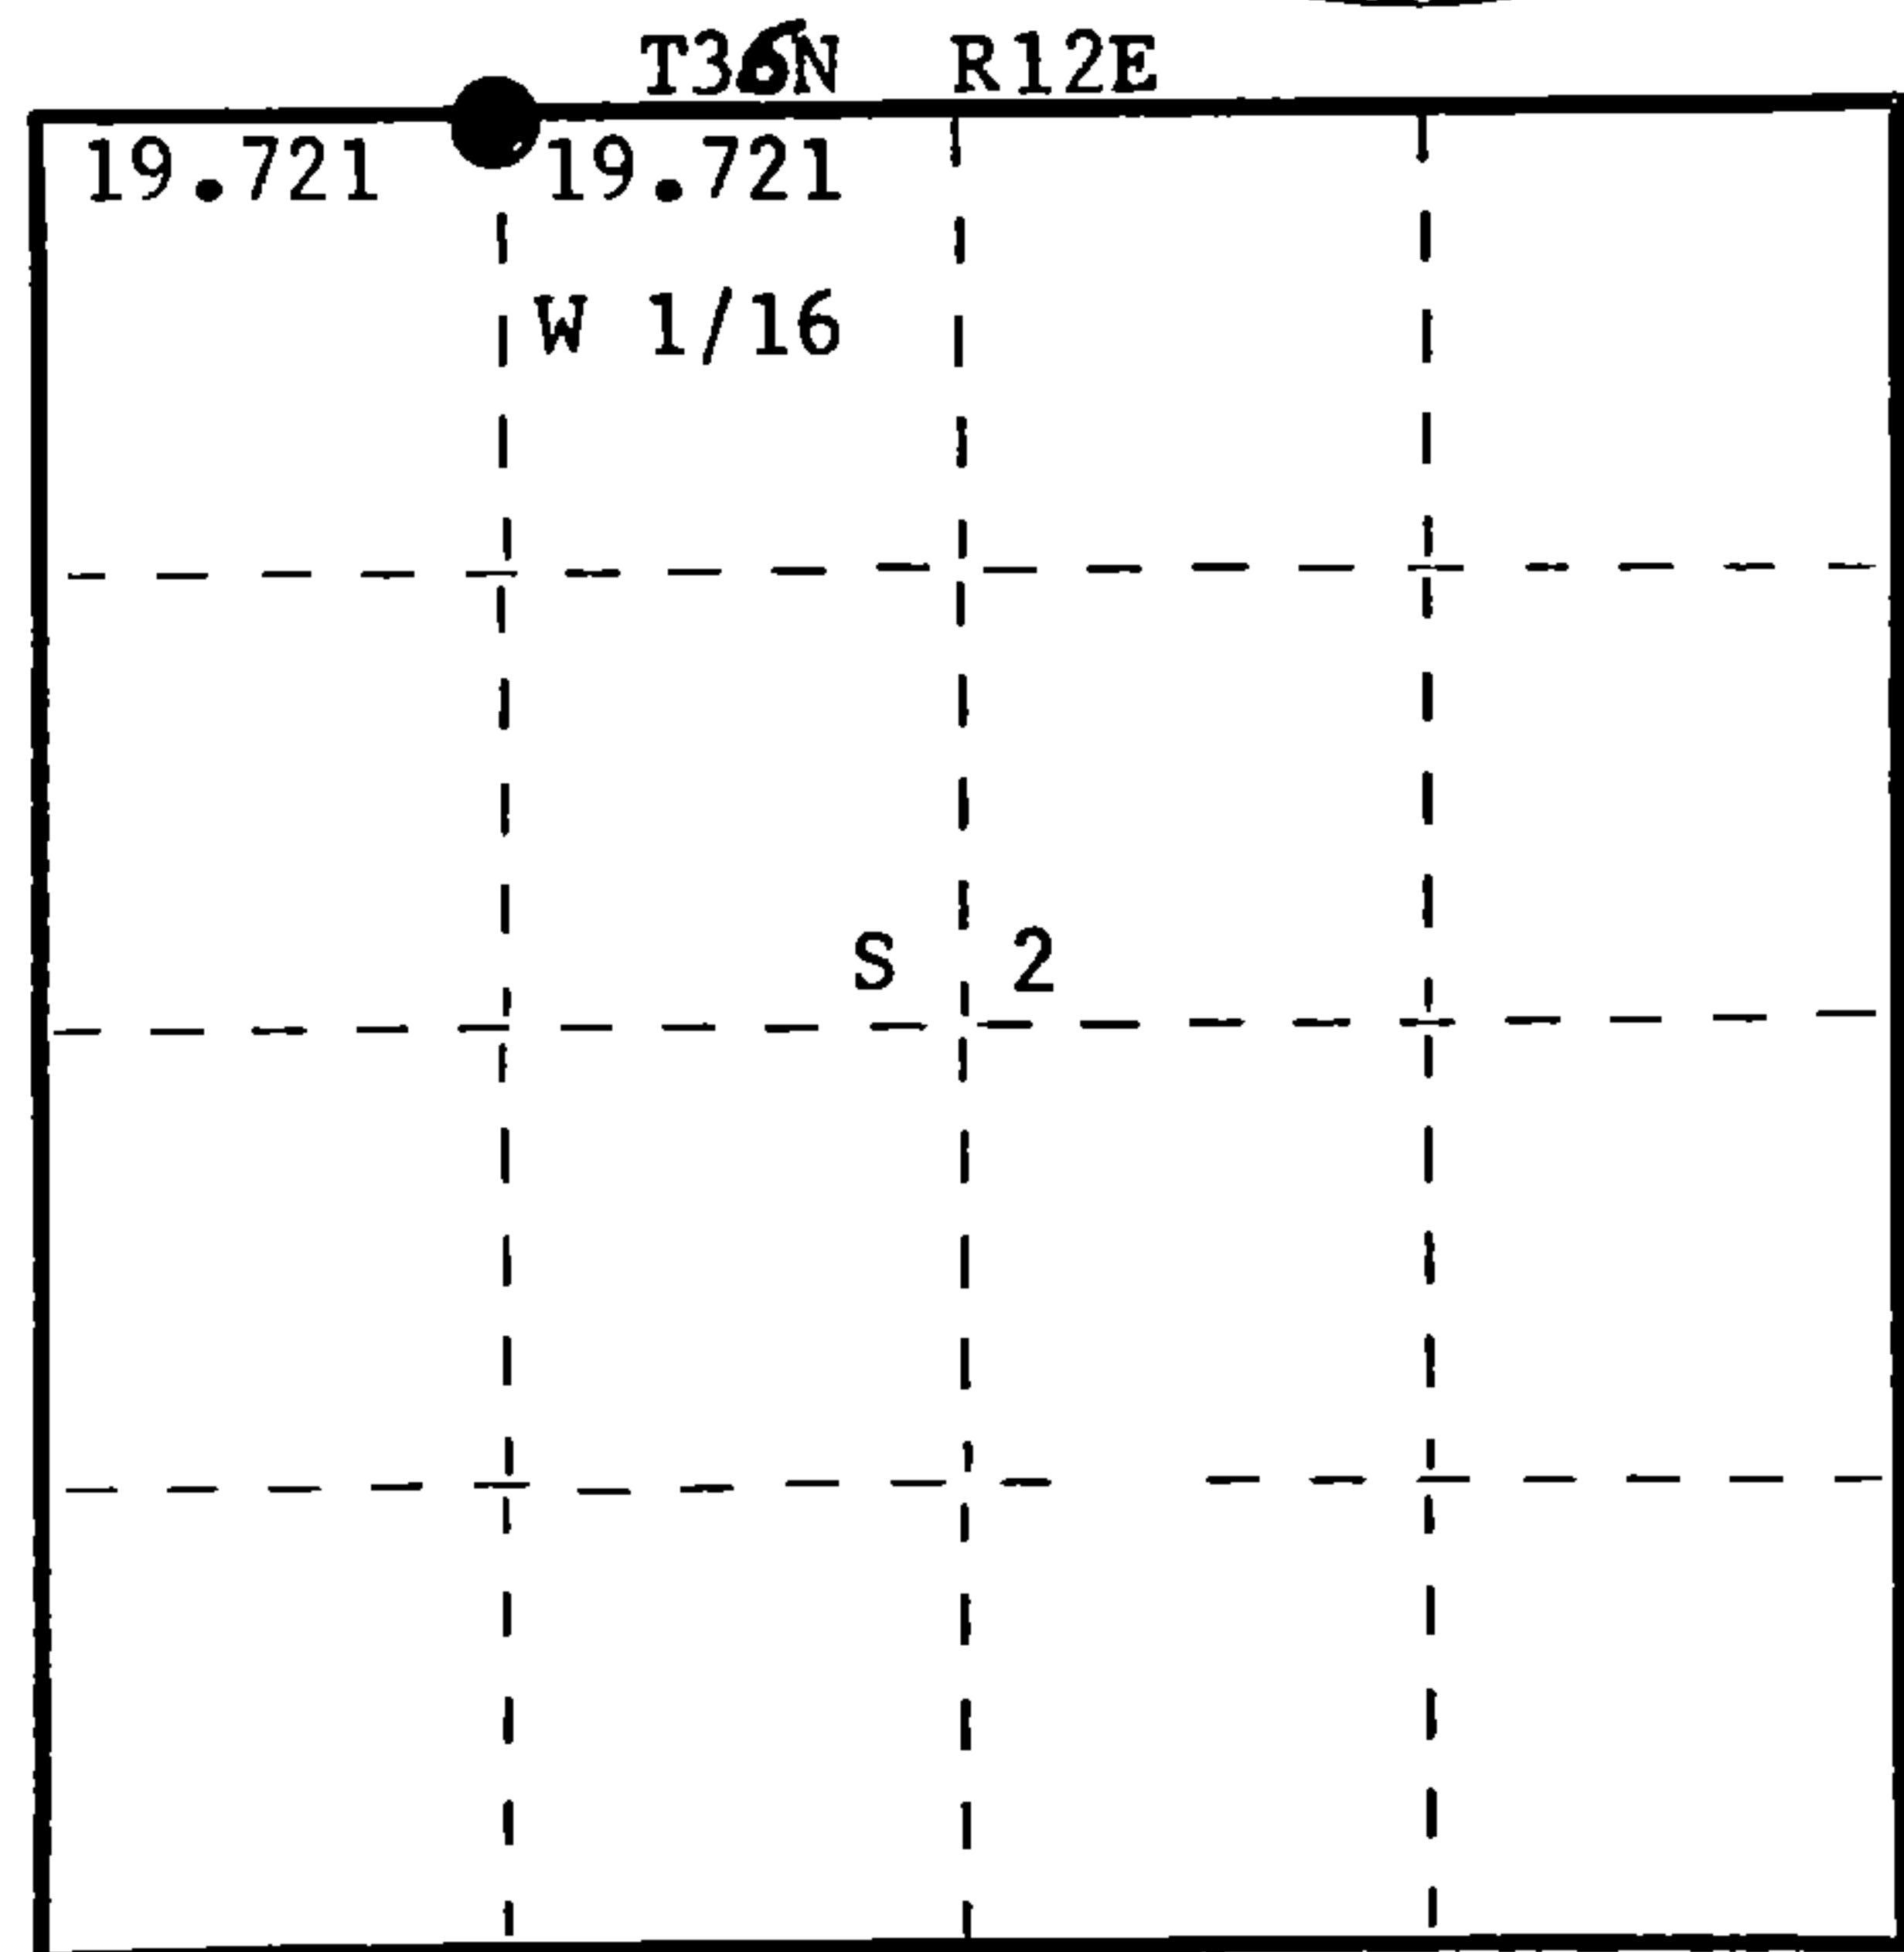

○ = Corner monument restored.

History of original corner establishment:
No records of any previous surveys.

Description of corner evidence found:

Corner established by traverse and computations. Ran traverse from previously established Section Corner 34, 35, 2 & 3 - N 89°00' 07" W to established 1/4 corner between Section 35 and 2. Computed distance 2603.14 feet (39.44 chains). Set W 1/16 corner at 1301.578 feet (19.721 chains) intermediate.

Description of monument and accessories I established to perpetuate the original location of this corner.

Set 1 1/2" x 18" iron pipe for true corner in centerline of Sipple Road 5" below surface.
Set 1 1/2" iron pipe with 2" brass cap 60 links south for witness corner, cap stamped: S498
Monument projects 8" above ground. T36N R12E
Marked BTs - Sugar 8" N24°W, 89 links. W 1/16 S + 35/2 W.C.
Sugar 8" S36°E, 78.8 links, scribed 1/16 BT. N 60 lks
Measurements and bearings taken from true corner. T35N R12E
CPI - 1977

Dated at Rhineland, Wis., this 2nd day of August, 19 77

Signature Philip T. Hansen Title Registered Land Surveyor Registration No. S-498
(County Surveyor, Registered Land Surveyor, or other duly authorized official)

Office of Register of Deeds, County of Forest, I hereby certify that the within instrument was filed in this office for record on the 22nd day of AUGUST, 19 77 at 3:30 o'clock P. M.

Eugene Staszny
(Register of Deeds)

By _____ Deputy

DOCUMENT NUMBER **112151**

43612350030