

CERTIFIED LAND CORNER RESTORATION

Index No. 21-18

W18

State of Wisconsin }
County of Forest } ss.

I Glen Barker, do hereby certify that on the 18th day of August, 1982, I ~~found~~ found evidence of the NW 1/16 corner of Section 35 Township 36, North, Range 12 East, Fourth Principal Meridian, as described hereon; and that from this evidence I established a new monument and accessories as described hereon to perpetuate the original location of this corner.

History of original corner establishment:
No evidence of any previous corner.


Description of corner evidence found:

Corner established by subdivision of the NW 1/4. Location of NW 1/16 is S89-15-44W 1283.71 ft. of N C 1/16 and N2-24-43E 1449.47 ft. of WC 1/16.

Resident witnesses:


J. Claflin

H. Wagoner

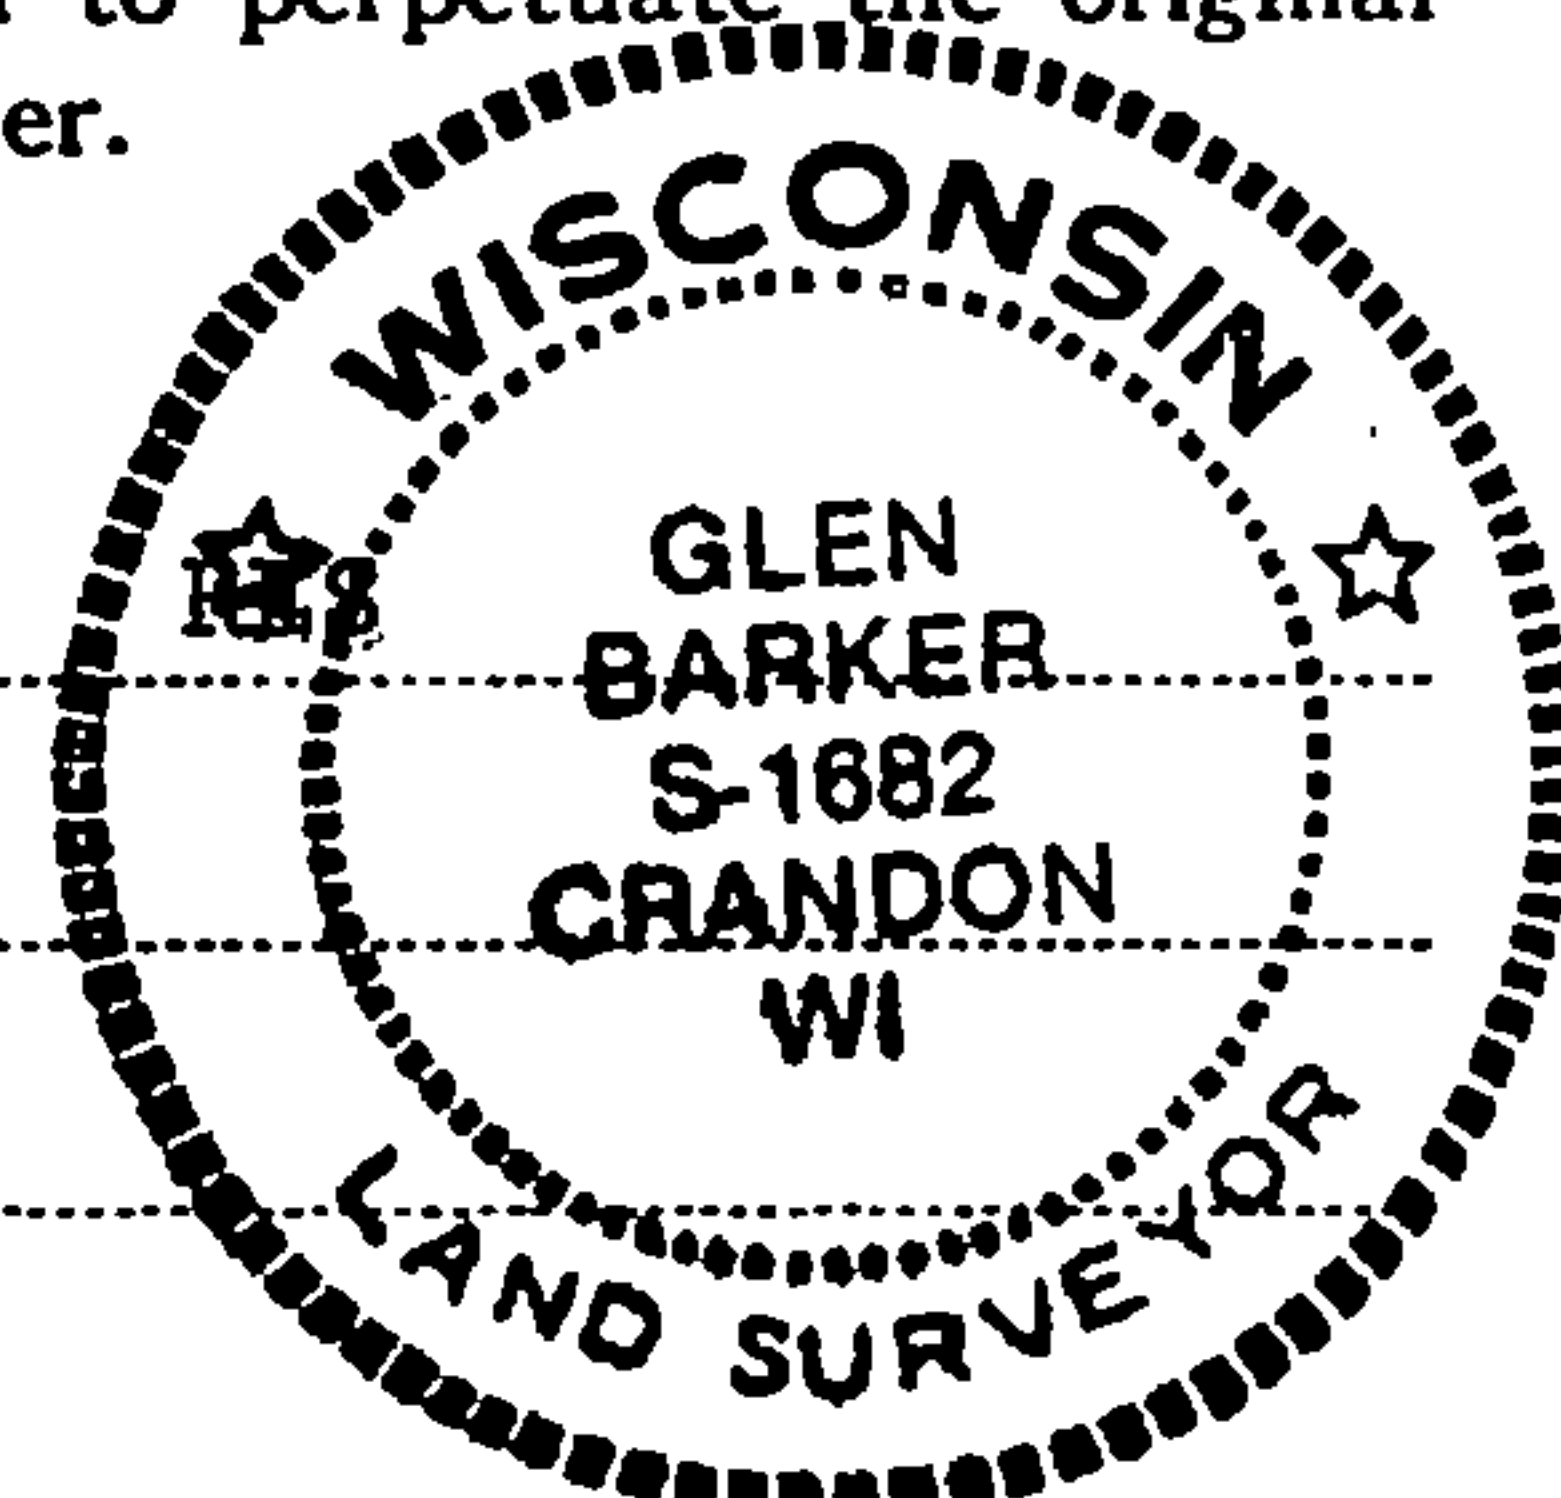

T36N

R12E

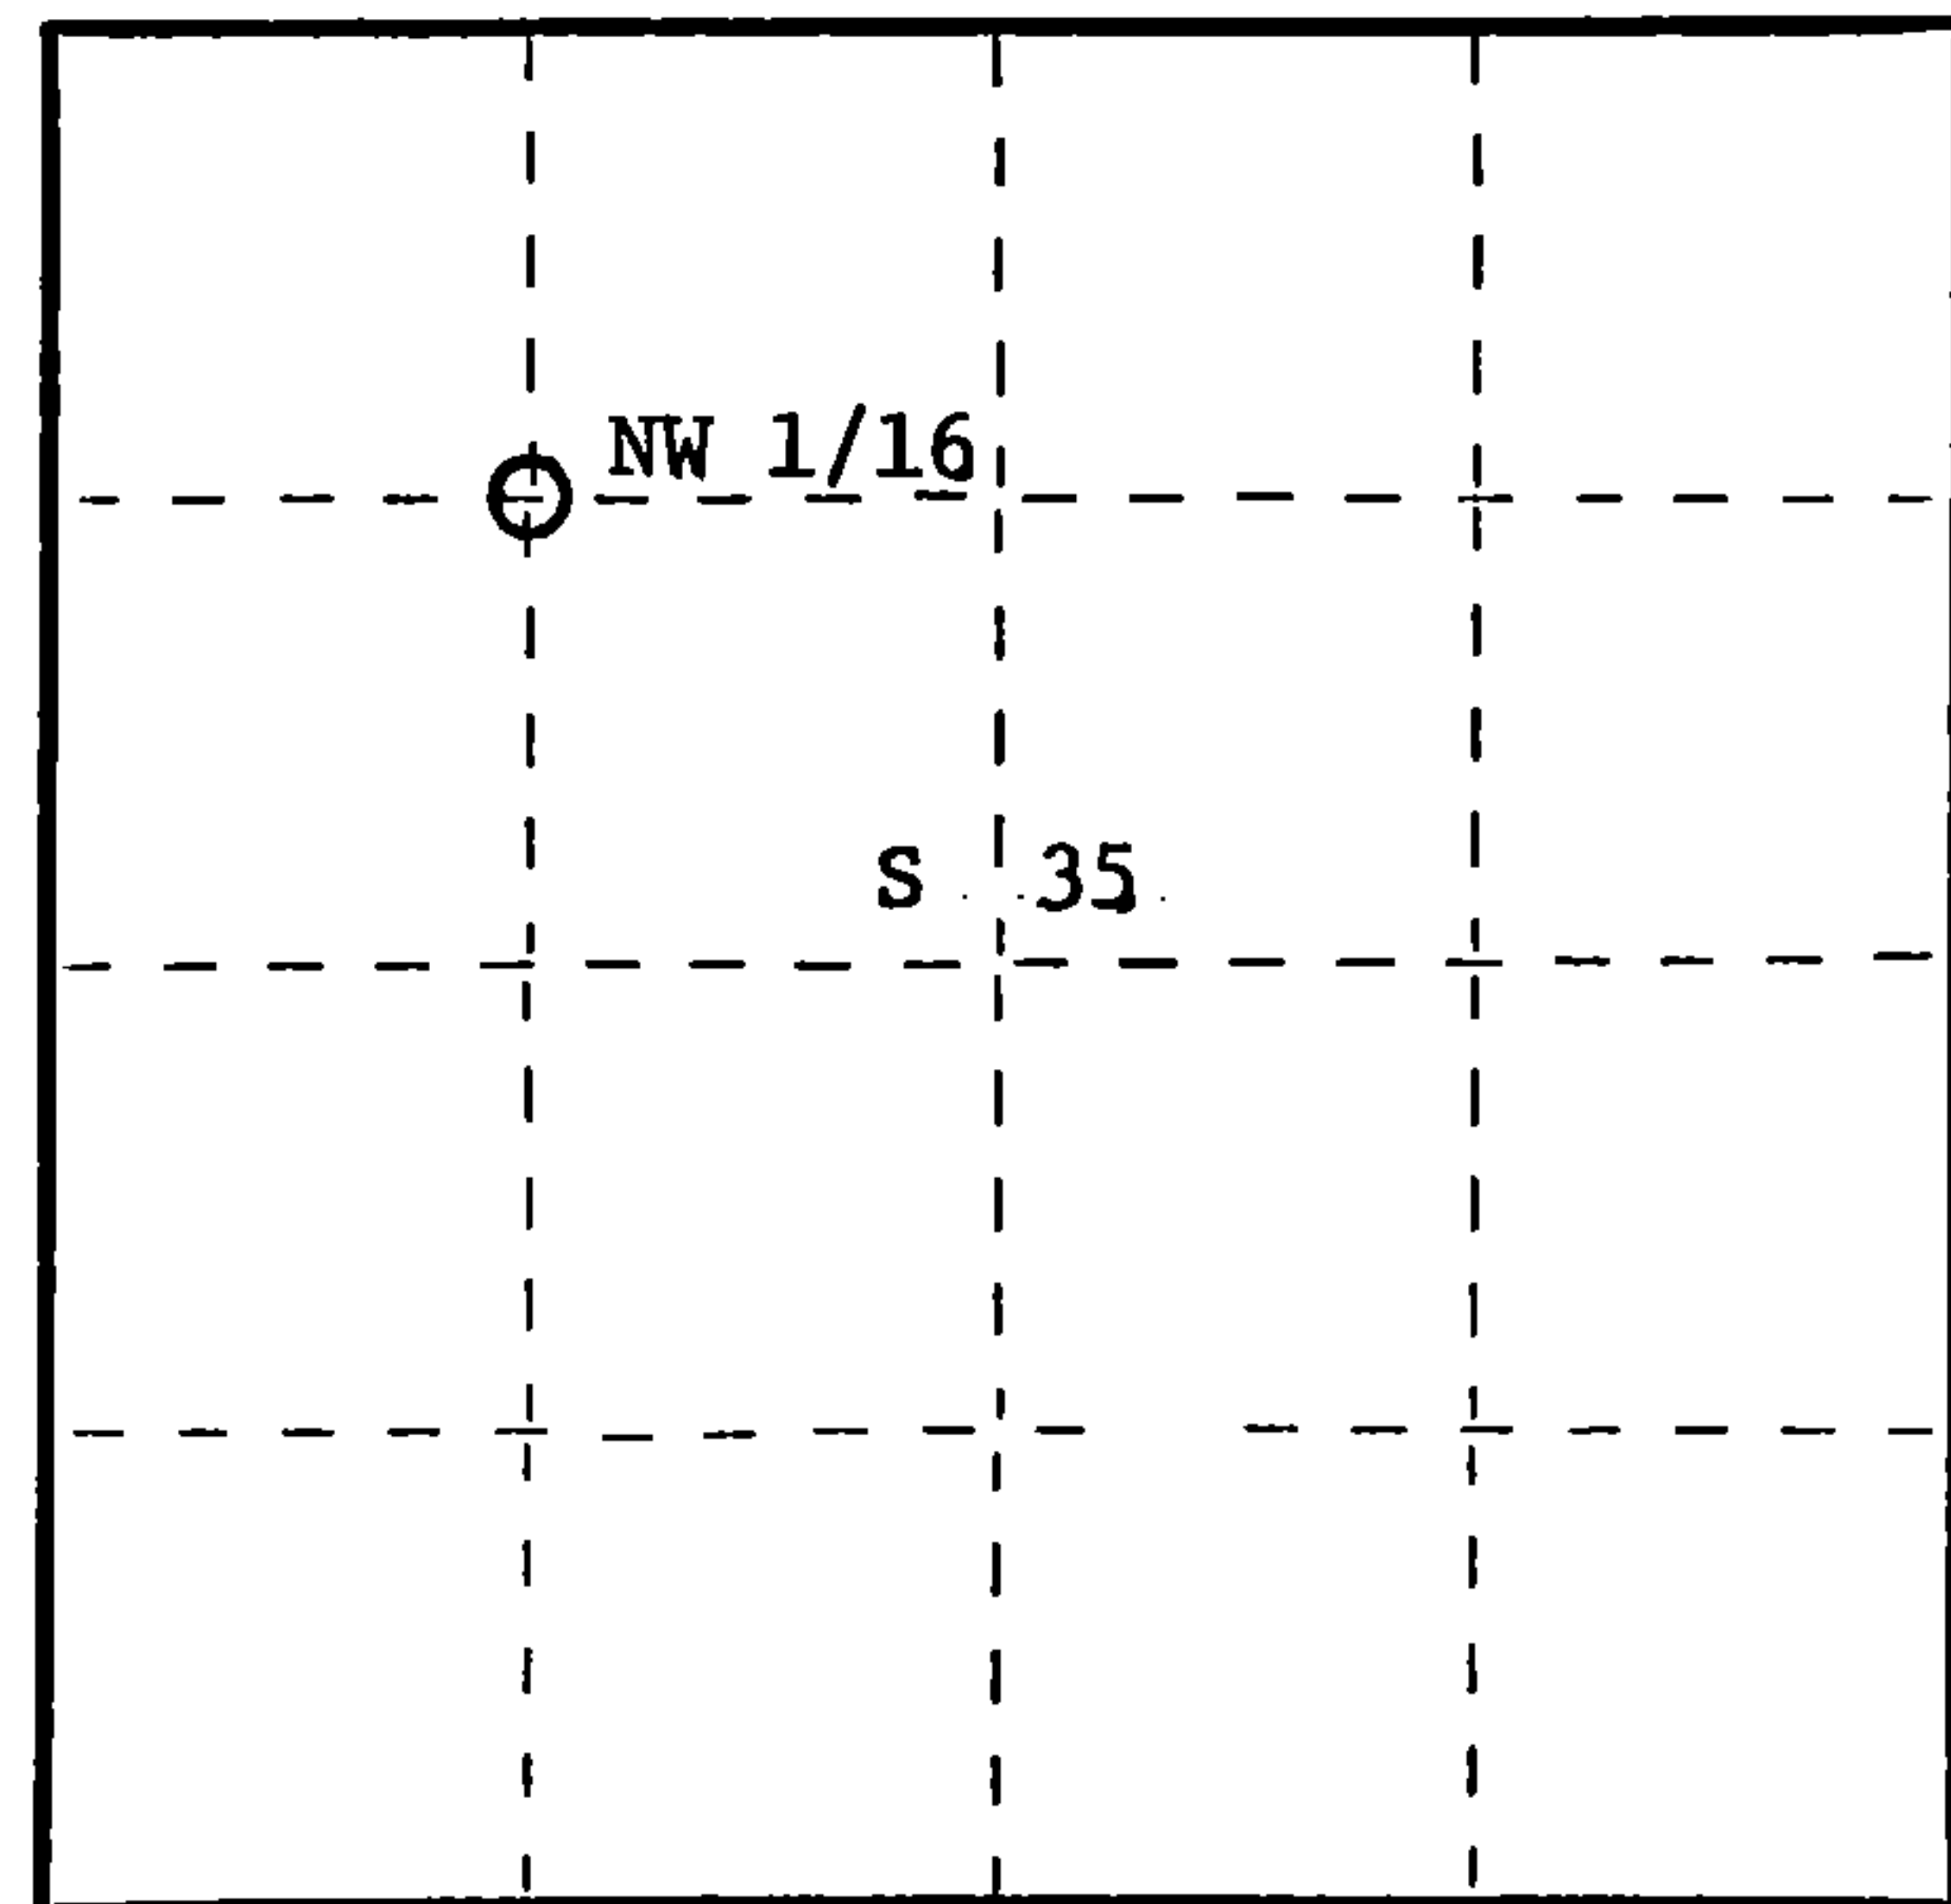

Description of monument and accessories I established to perpetuate the original location of this corner.
Set a 1" iron pipe with 2" alloy cap stamped:
Monument projects 12" above ground. S1682
Marked NBTs: Sugar, 7" S35E 25.94 ft. T36N R12E
Sugar, 6" N81W 33.40 ft. NW 1/16 S 35
Scribed 1/16 - B.T. CPI - 1982

Dated at Rhineland, Wis., this 28th day of October, 1982.

Signature Glen Barker Title Registered Land Surveyor Registration No. S1682
(County Surveyor, Registered Land Surveyor, or other duly authorized official)

Office of Register of Deeds, County of Forest, I hereby certify that the within instrument was filed in this office for record on the 16th day of February, 1983 at 10:30 o'clock A. M.

Eugene Statajny
(Register of Deeds)

DOCUMENT NO. **122919**

By _____ Deputy

○ = Corner monument restored.

FORM 985 H. C. MILLER CO., MILWAUKEE

43012353030