

CERTIFIED LAND CORNER RESTORATION


Index No. **E 13**

State of Wisconsin }  
County of Forest } ss.

I Thomas R. Arnott, do hereby certify that on the 13 Oct. day of Oct., 1976, I found evidence of the Section corner of Sec. 3, 4, 9, & 10 Township 36, North, Range 13 E, Fourth Principal Meridian, as described hereon; and that from this evidence I established a new monument and accessories as described hereon to perpetuate the original location of this corner.

Resident witnesses:

.....  
.....  
.....

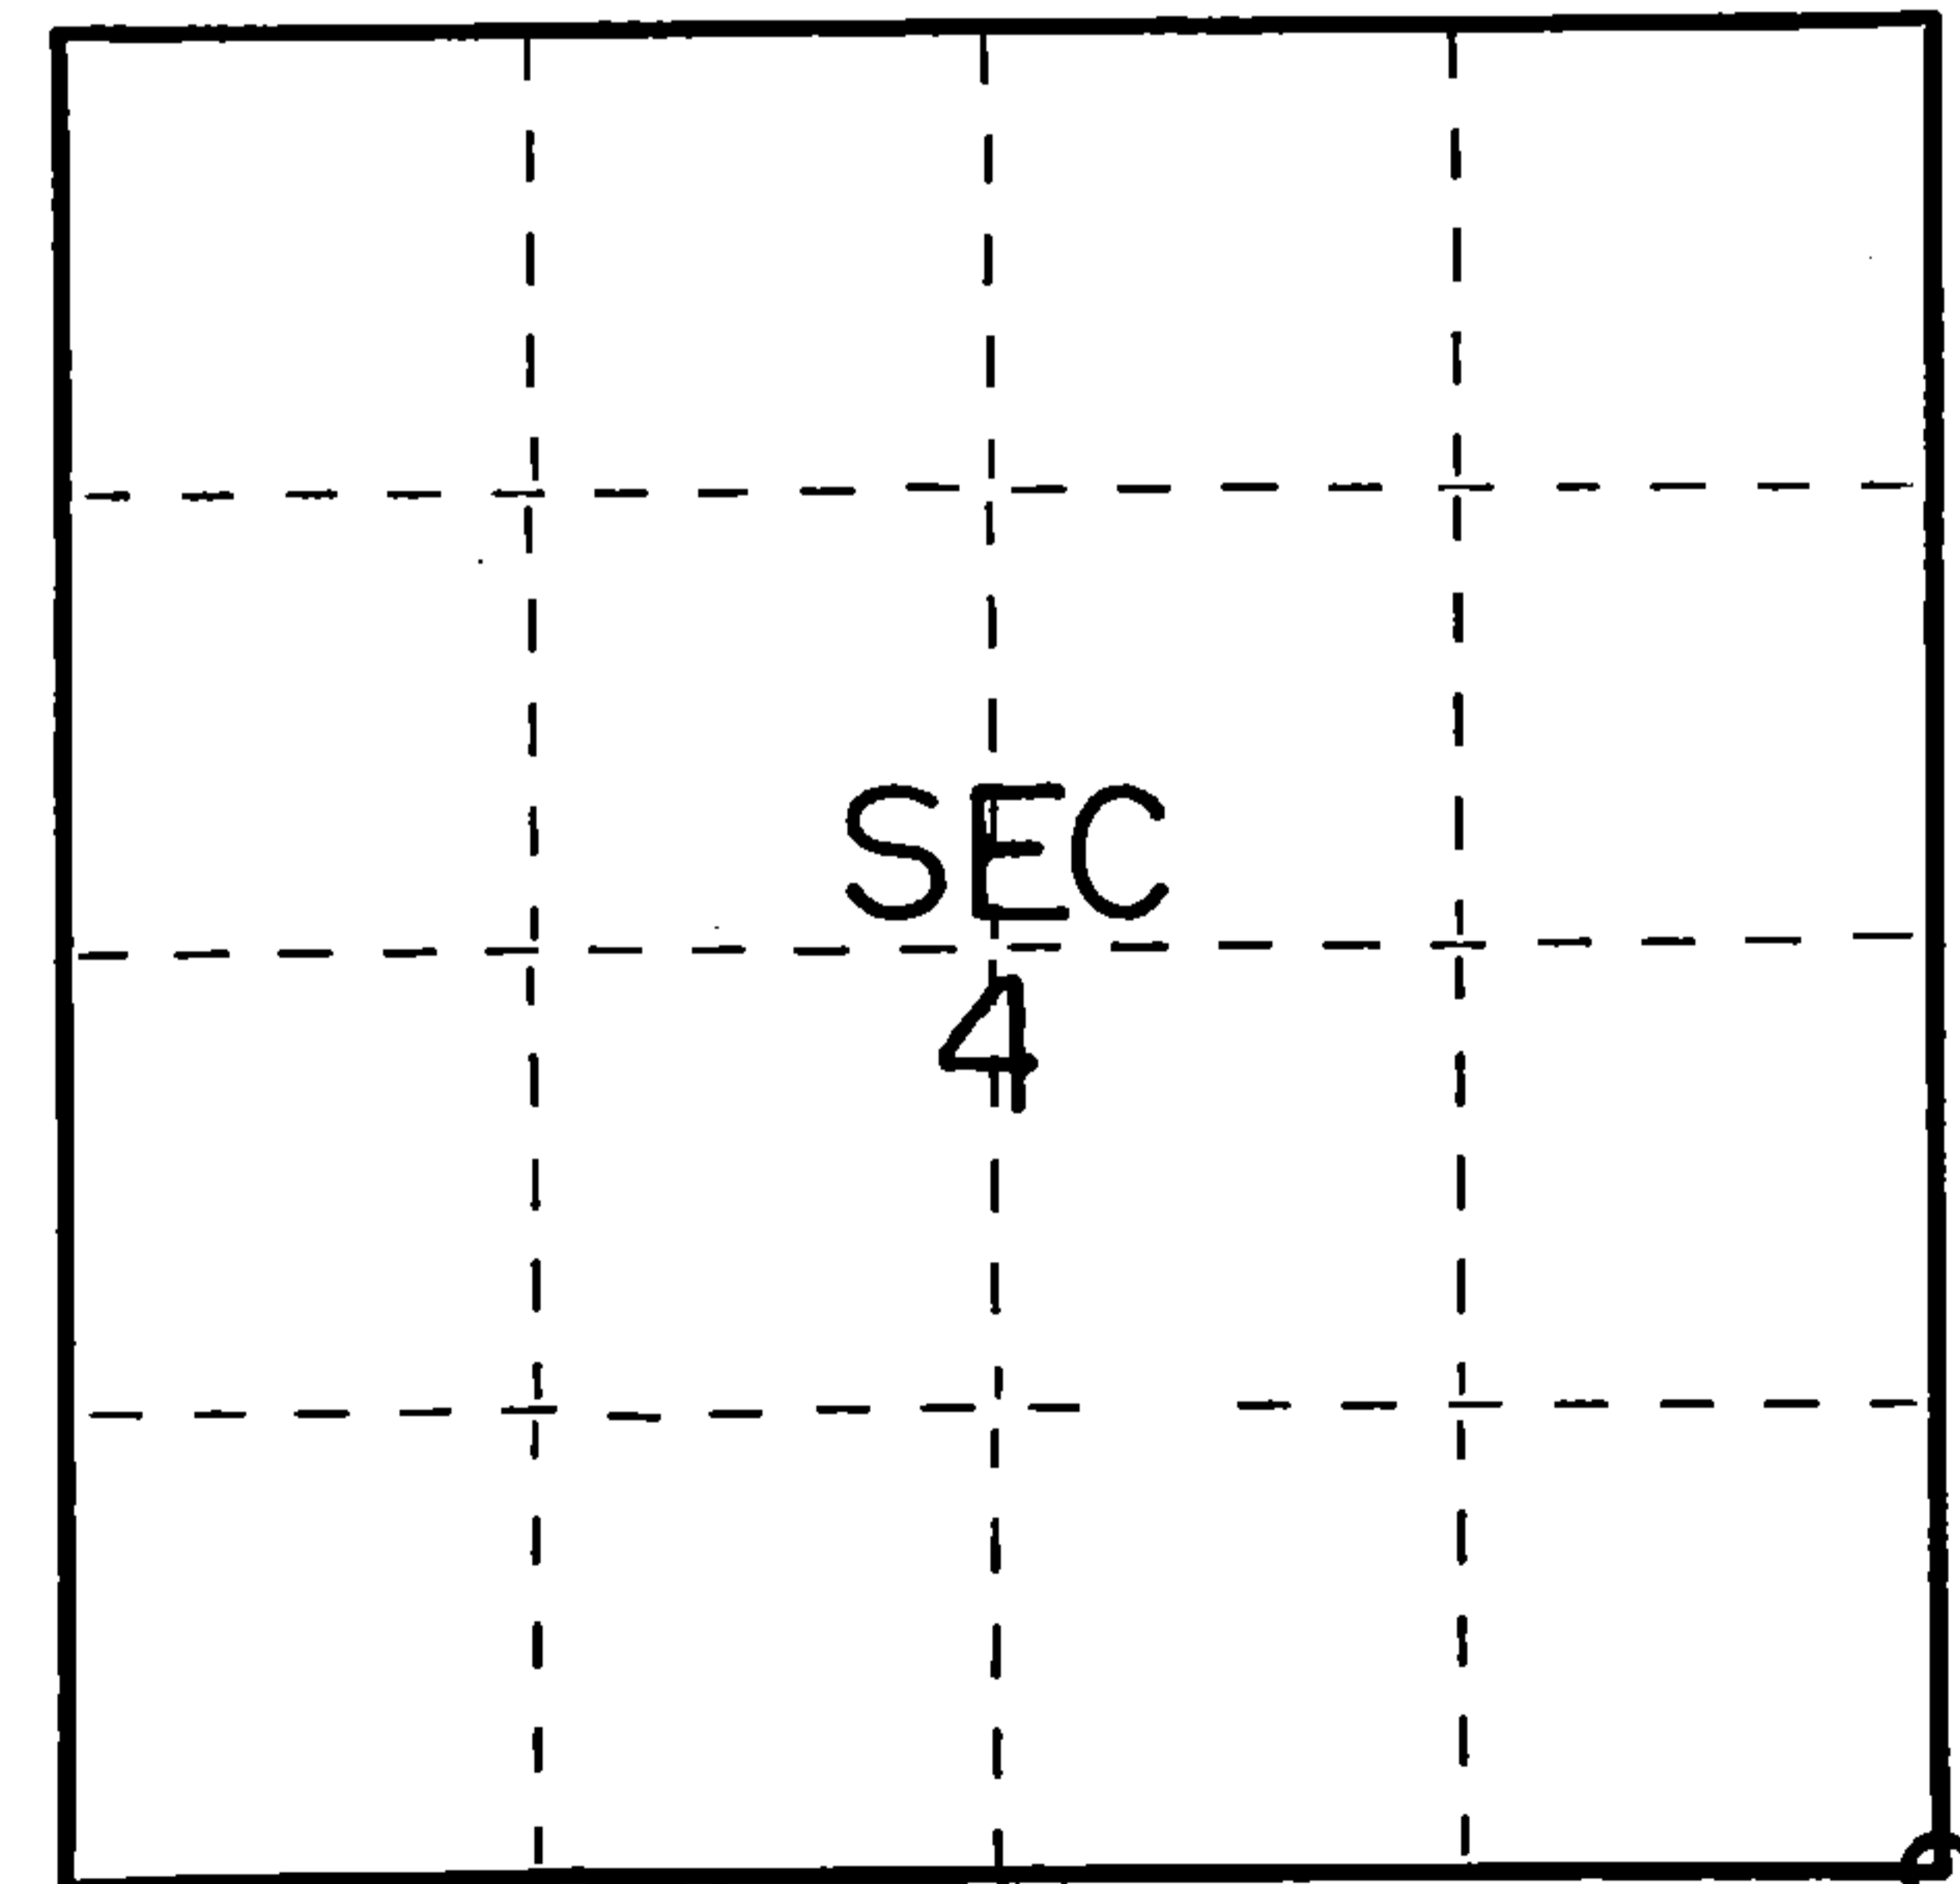

○ = Corner monument restored.

History of original corner establishment:

Original survey done by James L. Nowlin June 2 - June 12, 1865.

Sugar 10 N45W 20 Lks.  
Sugar 12 N85E 25 Lks.

Description of corner evidence found:

2" iron pipe 5' long with brass cap set by C.E.Walker in 1938.

Description of monument and accessories I established to perpetuate the original location of this corner.

Left monument set by Walker.

Ties:

Maple 8 N42E 48.38 feet  
Maple 8 S6W 33.87 feet  
Maple 6 N20W 13.08 feet



43613040000

Dated at Crandon, Wis., this 26 day of Nov., 1976.

Signature Thomas Arnott Title Surveyor Registration No S-887  
(County Surveyor, Registered Land Surveyor, or other duly authorized official)

Office of Register of Deeds, County of Forest, I hereby certify that the within instrument was filed in this office for record on the 26 day of Nov., 1976 at 3:30 o'clock P. M.

EUGENE STATEZNY  
(Register of Deeds)

Document Number **110607**

By Eileen Schmidt Deputy