

CERTIFIED LAND CORNER RESTORATION

Index No. **C-13**


State of Wisconsin }
County of Forest } ss.

I Thomas R. Arnott, do hereby certify that on the 16 day of Nov., 1976, I found evidence of the 1/4 corner of sec. 3 & 4 Township 36, North, Range 13 E, Fourth Principal Meridian, as described hereon; and that from this evidence I established a new monument and accessories as described hereon to perpetuate the original location of this corner.

Resident witnesses:

.....
.....
.....

FORM 985 H. C. MILLER CO., MILWAUKEE

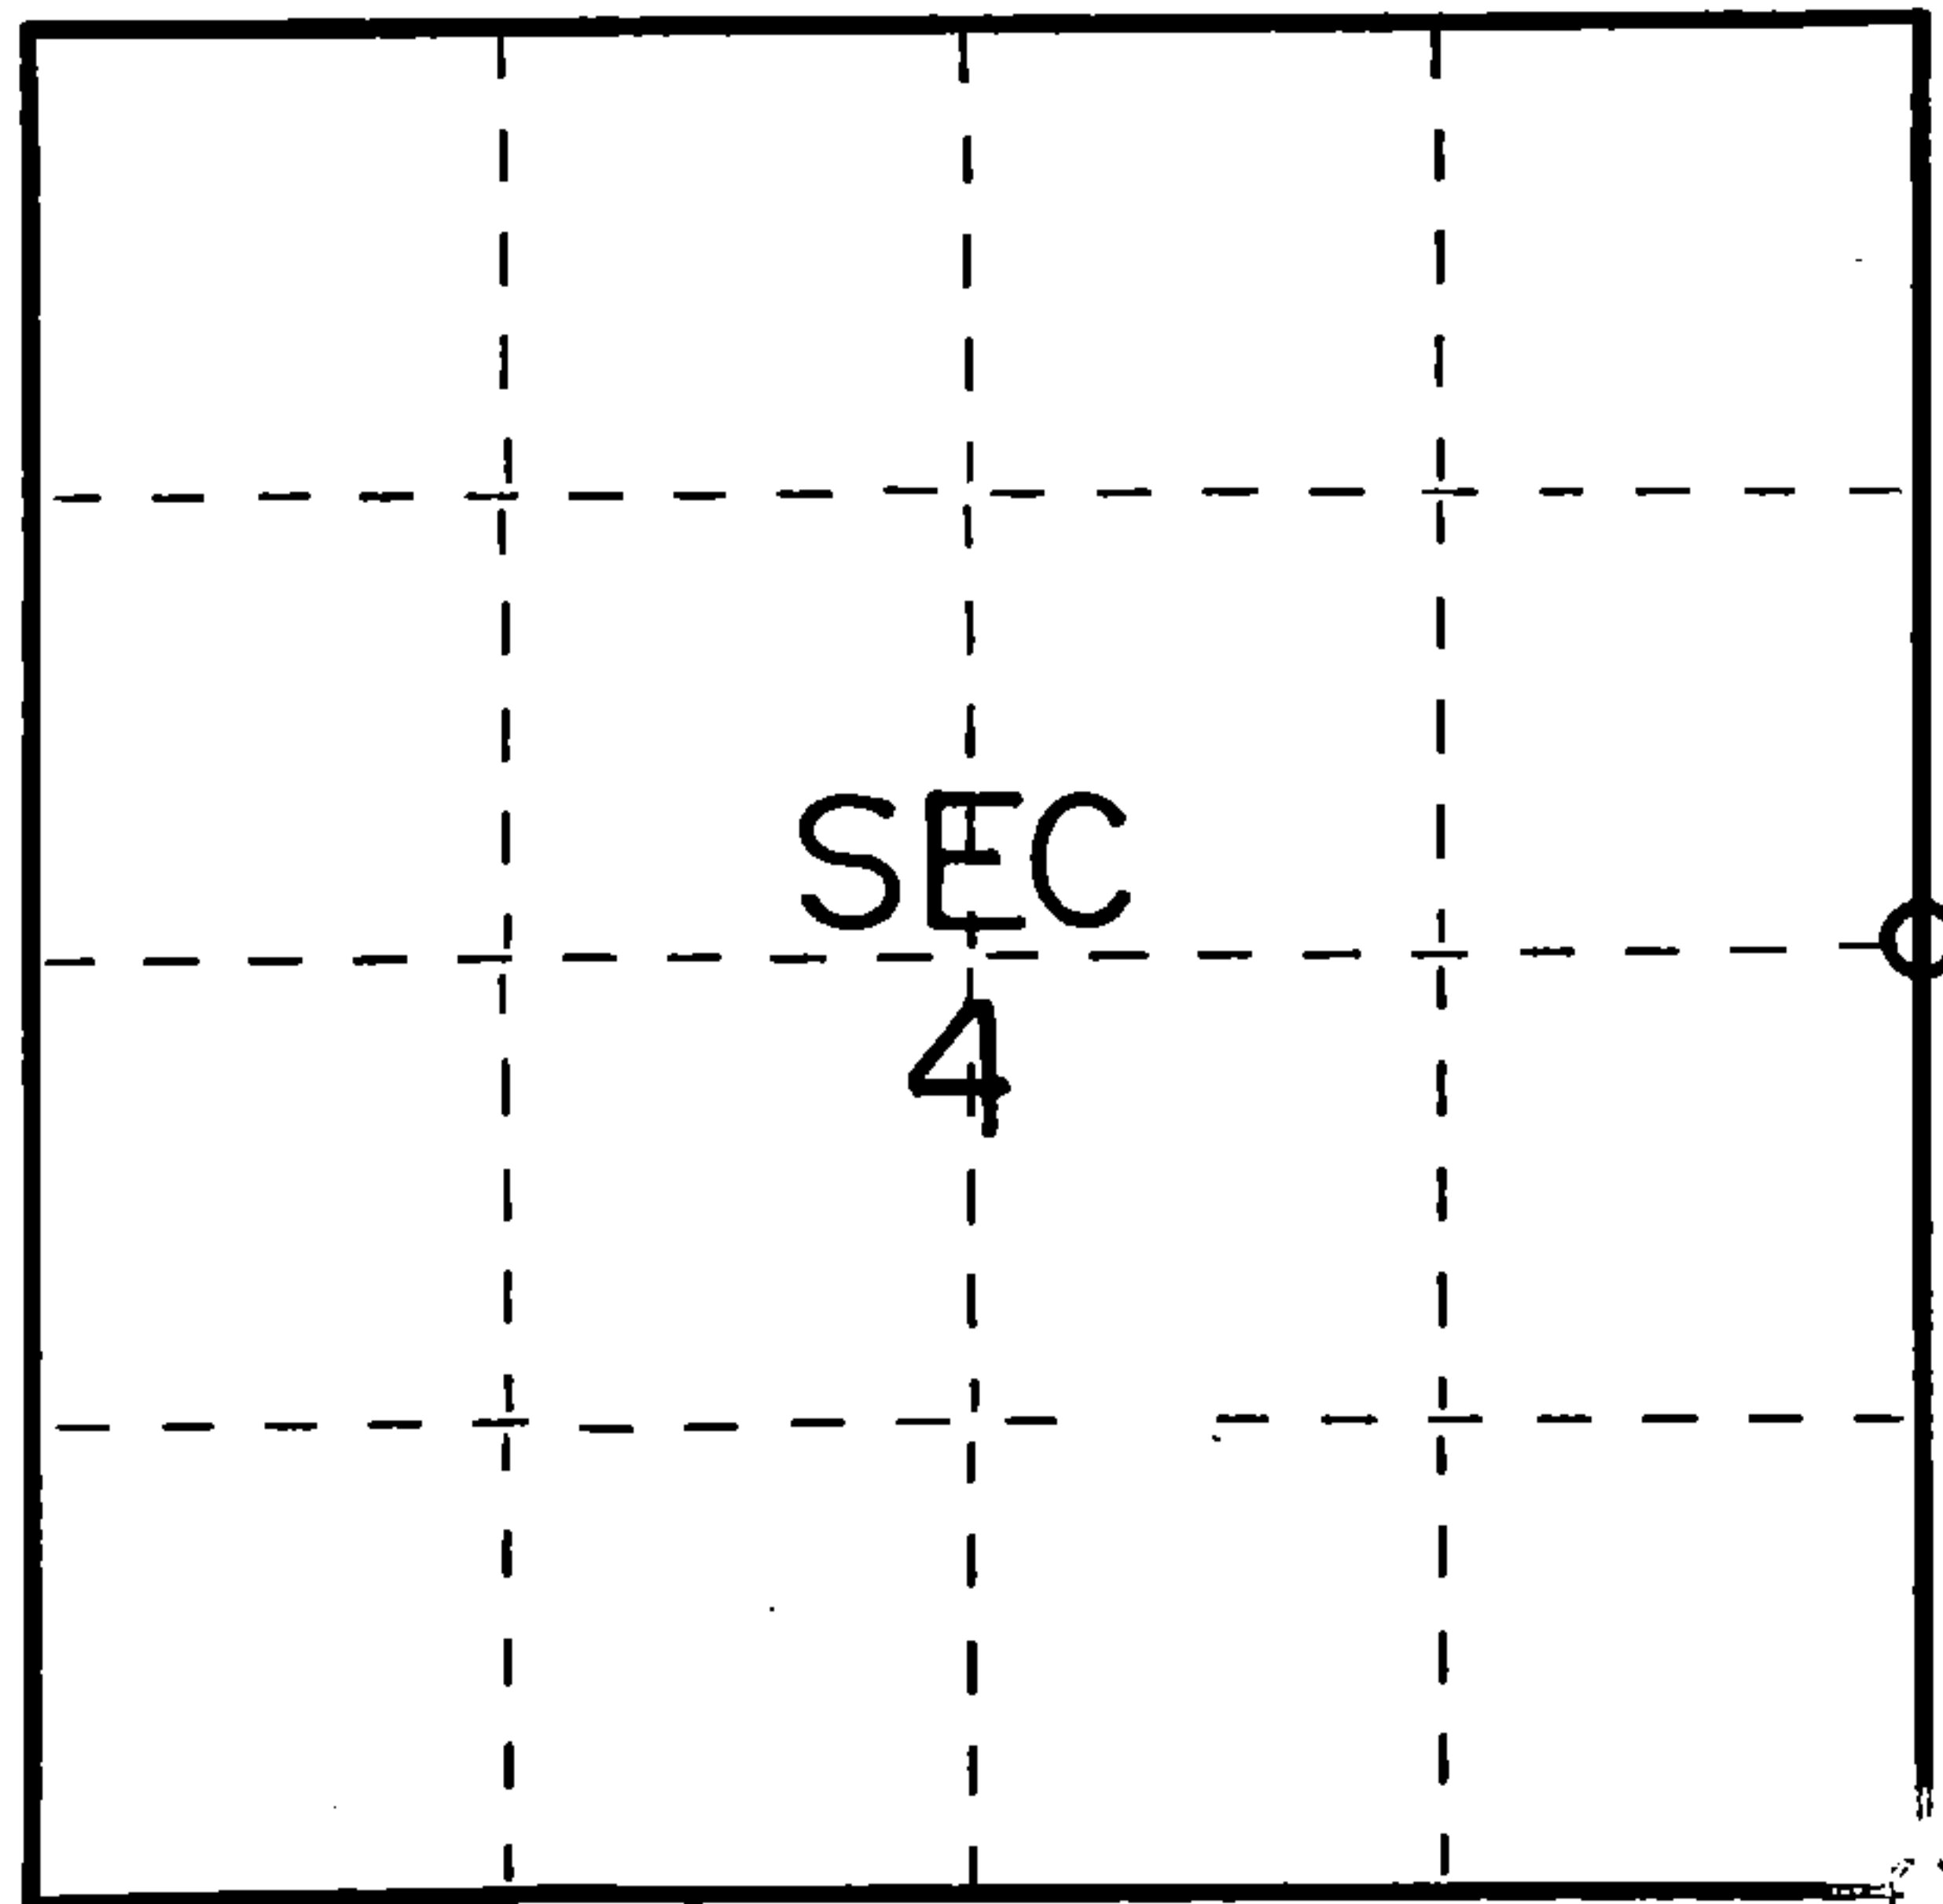

○ = Corner monument restored.

History of original corner establishment:

Original Survey done by James L. Nowlin June 2 - June 12, 1865.

Lind 20 N31E 12 Lks.
Sugar 8 N28W 14 Lks.

Description of corner evidence found:

2" iron pipe 5' Long with brass cap set by C.E.Walker in 1938.

Description of monument and accessories I established to perpetuate the original location of this corner.

Left monument set by Walker.

Ties:

Maple 10 S35E 20.23 feet
Maple 10 S14W 27.15 feet



Dated at Crandon, Wis., this 26 day of Nov., 1976.

Signature Thomas Arnott Title Surveyor Registration No. S-887
(County Surveyor, Registered Land Surveyor, or other duly authorized official)

Office of Register of Deeds, County of Forest, I hereby certify that the within instrument was filed in this office for record on the 26 day of Nov., 1976 at 3:30 o'clock P M.

EUGENE STATEZNY Document Number **110606**
(Register of Deeds)

By Eileen Schmidt Deputy

43013042000