

CERTIFIED LAND CORNER RESTORATION


Index No. **C 9**

State of Wisconsin }
County of Forest } ss.

I Thomas Arnott, do hereby certify that on the 30th day of April, 1976, I found evidence of the 1/4 corner of sections 4 & 5 Township 36, North, Range 13 E, Fourth Principal Meridian, as described hereon; and that from this evidence I established a new monument and accessories as described hereon to perpetuate the original location of this corner.

Resident witnesses:

.....
.....
.....

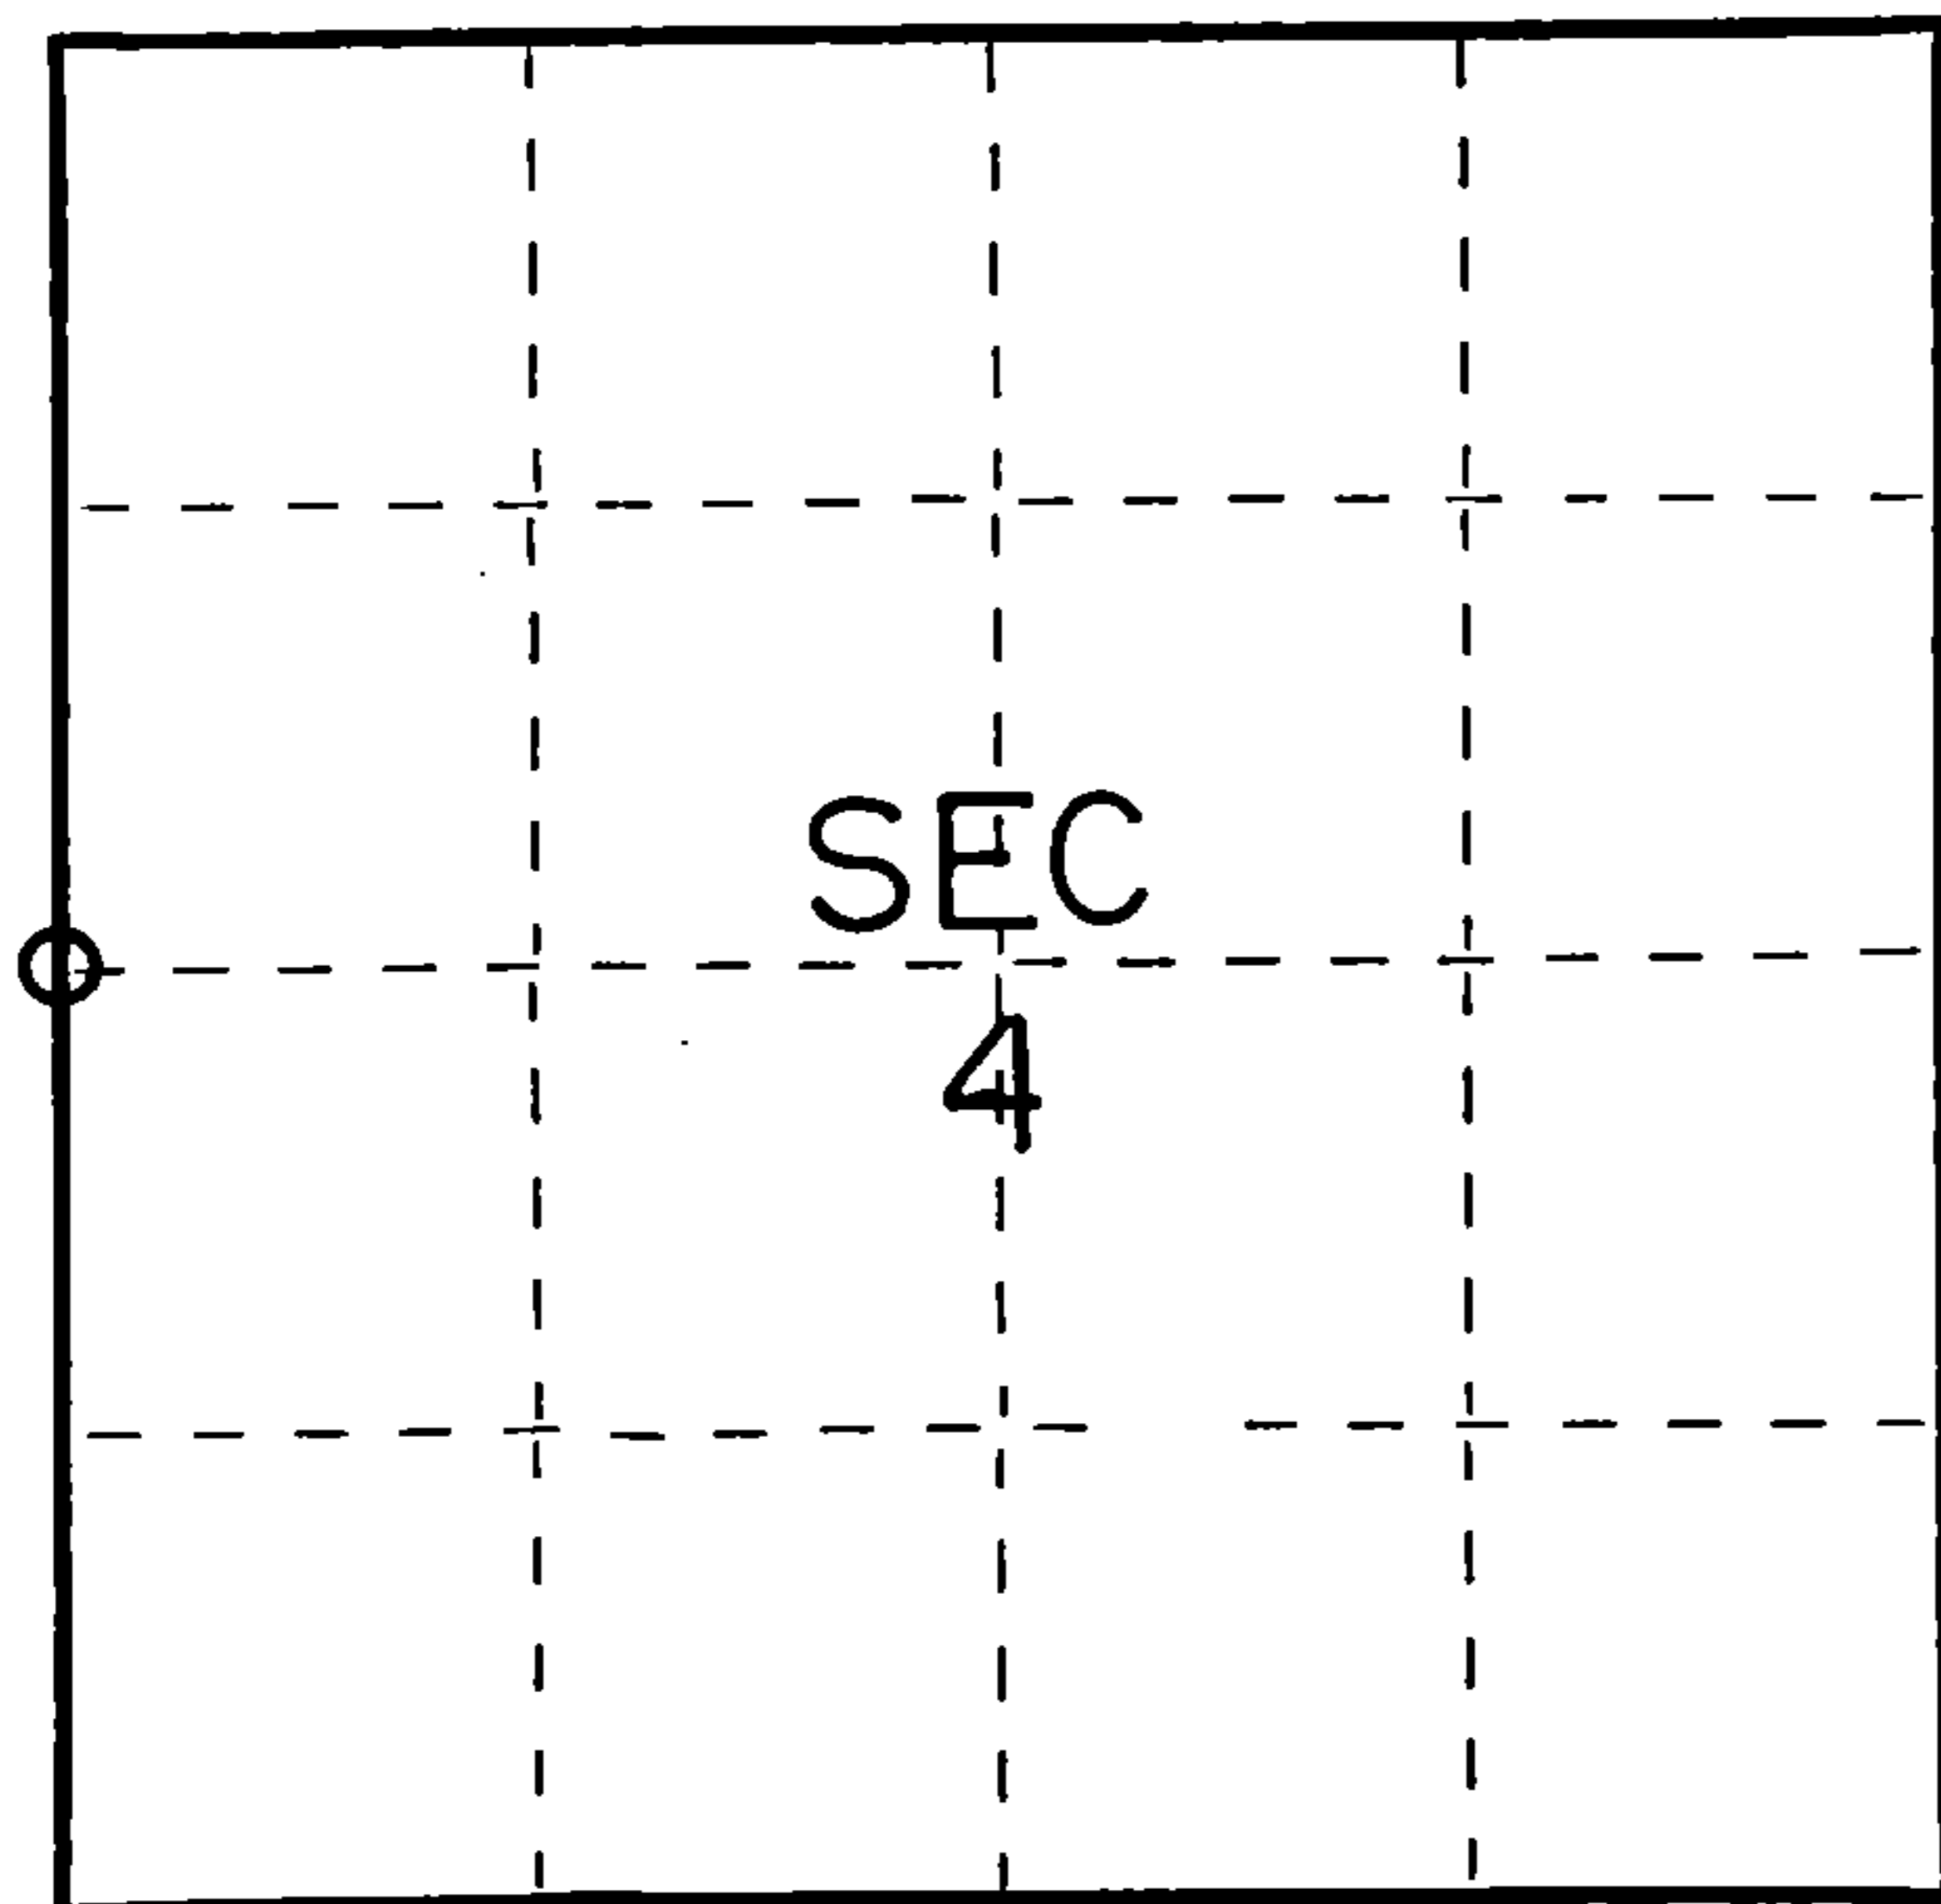

○ = Corner monument restored.

History of original corner establishment:

Original subdivision by James Nowlin 2 June - 12 June, 1865

Elm 20 N27E 100 Lks.
Birch 8 N22W 80 Lks.

Description of corner evidence found:

Found 2" iron pipe 6" below road surface



Description of monument and accessories I established to perpetuate the original location of this corner.

Left 2" iron pipe in place

Ties:

Forest County Aluminum Monument N43W 44.24 feet
Power pole (3613-4W12) N51E 38.63 feet
guy pole S84W 108.92 feet

Dated at Crandon, Wis., this 14th day of May, 1976

Signature Thomas R. Arnott Title Surveyor Registration No. S-887
(County Surveyor, Registered Land Surveyor, or other duly authorized official)

Office of Register of Deeds, County of Forest, I hereby certify that the within instrument was filed in this office for record on the 14th day of May, 1976 at 3 o'clock P.M.

Eugene Staszynski Document No. **109213**
(Register of Deeds)

By _____ Deputy

FORM 985 / H. C. MILLER CO., MILWAUKEE

436 13052.000