

CERTIFIED LAND CORNER RESTORATION

Index No. **G 13**

State of Wisconsin }
County of Forest } ss.

I Thomas R. Arnott, do hereby certify that on the 12 day of Oct., 1976, I found evidence of the 1/4 corner of sec. 9 & 10 Township 36, North, Range 13 E, Fourth Principal Meridian, as described hereon; and that from this evidence I established a new monument and accessories as described hereon to perpetuate the original location of this corner.

Resident witnesses:

History of original corner establishment:

Original survey done by James L. Nowlin June, 2 * June, 12, 1865

Fir 7 N24E 50 Lks.
Birch 12 N45W 10 Lks.

Description of corner evidence found:

2" iron pipe 5' long set by C.E.Walker in 1938.

Description of monument and accessories I established to perpetuate the original location of this corner.


Left monument set by Walker.

Ties:

Poplar 10 North 13.04 feet
Maple 4 S73E 25.70 feet
W. Birch 6 S47W 22.19 feet



FORM 985 H. C. MILLER CO., MILWAUKEE

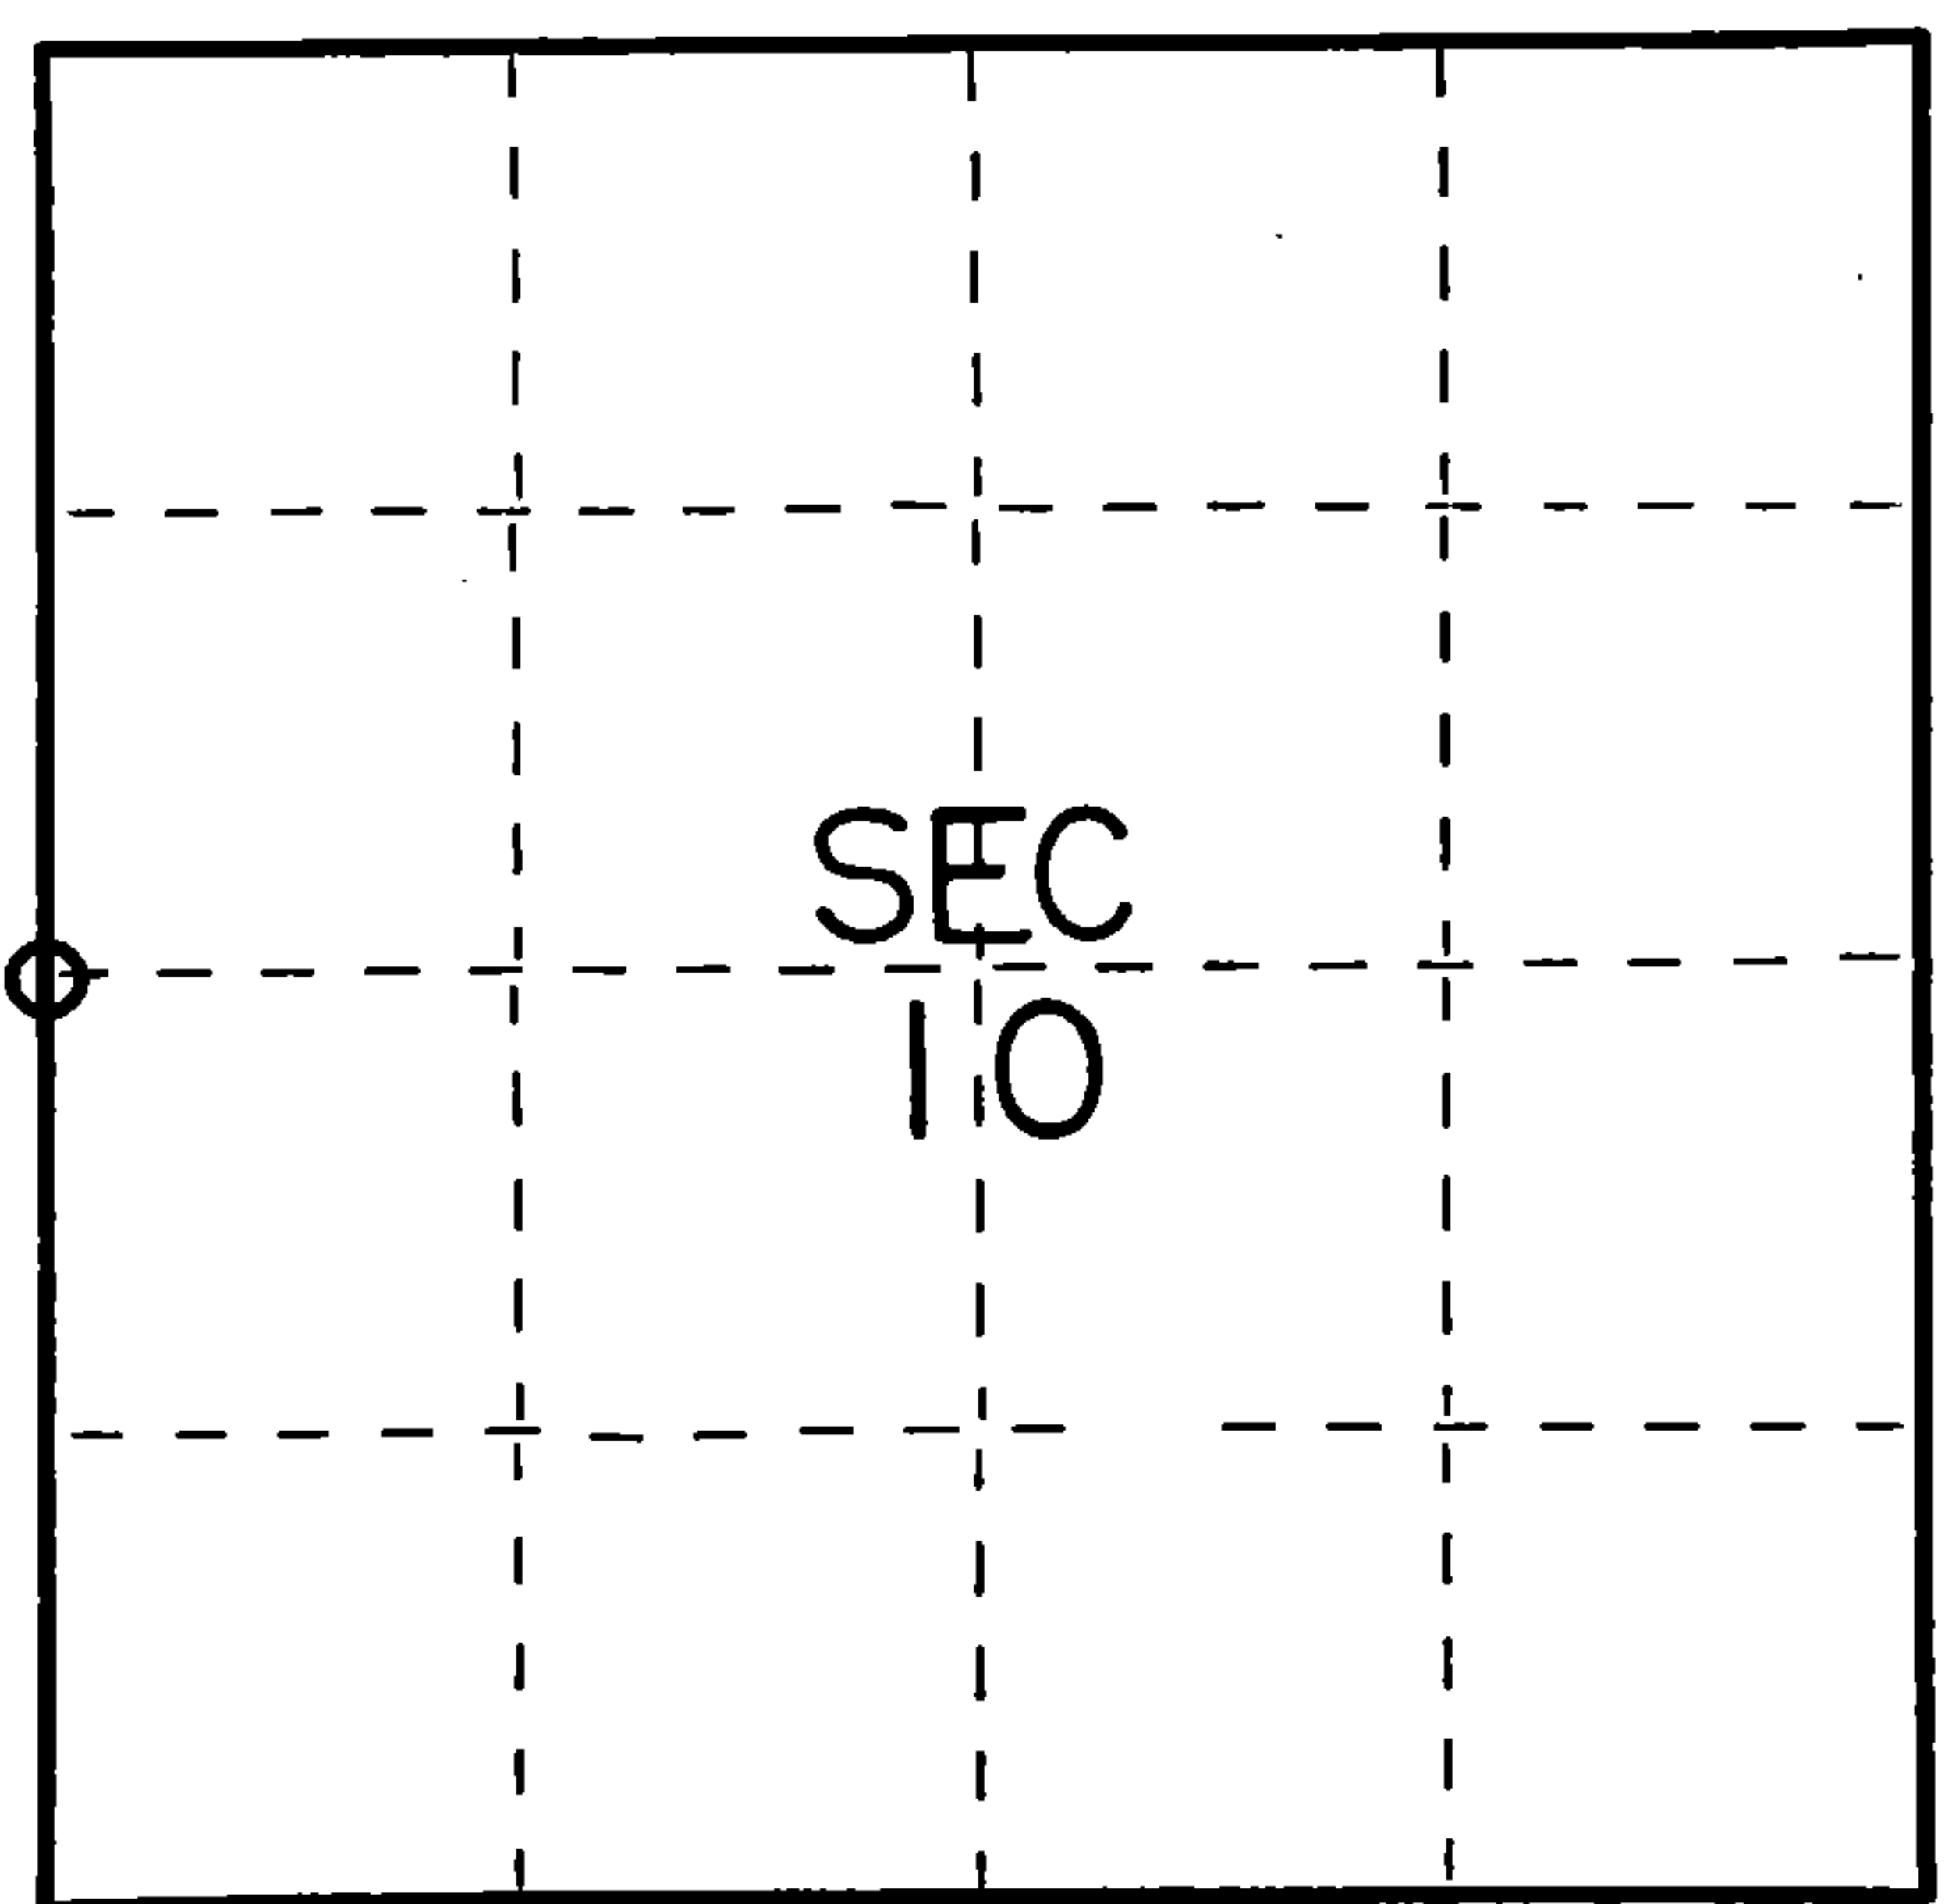

○ = Corner monument restored.

Dated at Crandon, Wis., this 26 day of Nov., 1976.

Signature Thomas R. Arnott Title Surveyor Registration No. S-887
(County Surveyor, Registered Land Surveyor, or other duly authorized official)

Office of Register of Deeds, County of Forest, I hereby certify that the within instrument was filed in this office for record on the 26 day of Nov., 1976. at 3:30 o'clock P. M.

EUGENE STATEZNY Document Number 110608
(Register of Deeds)

By Eileen Schmidt Deputy

H3613092000