

Document Number
180537

REGISTER'S OFFICE
Forest County, Wis. }
Received for record this 29th day
of July A.D., 2003 at
10:50 o'clock A.M., and recorded
in Vol. Corner Restoration
page R-9
Kay Swanson, Deputy
Register of Deeds

U.S. PUBLIC LAND SURVEY MONUMENT RECORD

(As Required by WI Adm. Code)

History of original corner establishment and subsequent restorations and descriptions of any record, monument, occupational, testimonial or other evidence considered:




1865 - James Nowlin, set original corner post and made the following B.T.'s:
Birch, 20°, N 35° W, 20 lks., 13.20 feet.
Birch, 10°, S 80° E, 20 lks., 13.20 feet.

2003 - I found no evidence of the original corner post or accessories.
I found a 2" diameter Forest County Aluminum Monument at a 4 way fence line intersection running North, South, East & West. I accepted the Monument as the best available evidence of the corner position and made the following B.T.'s.

Corner was: (Check All That Apply)

- Restored through acceptance of an obliterated evidence location.
- Restored through acceptance of a found perpetuated location.
- Considered a lost corner and reestablished through lost corner proportionate methods (include a plan view drawing showing distances and directions to other Public Land Survey Corners used for proportioning and determining the corner location).
- Restored or reestablished in a location that differs from a previous restoration or reestablishment (include a plan view drawing and indicate what was set and/or found).

Describe the monument and accessories used to perpetuate the location of this corner (include a plan view drawing and indicate what was set and/or found).

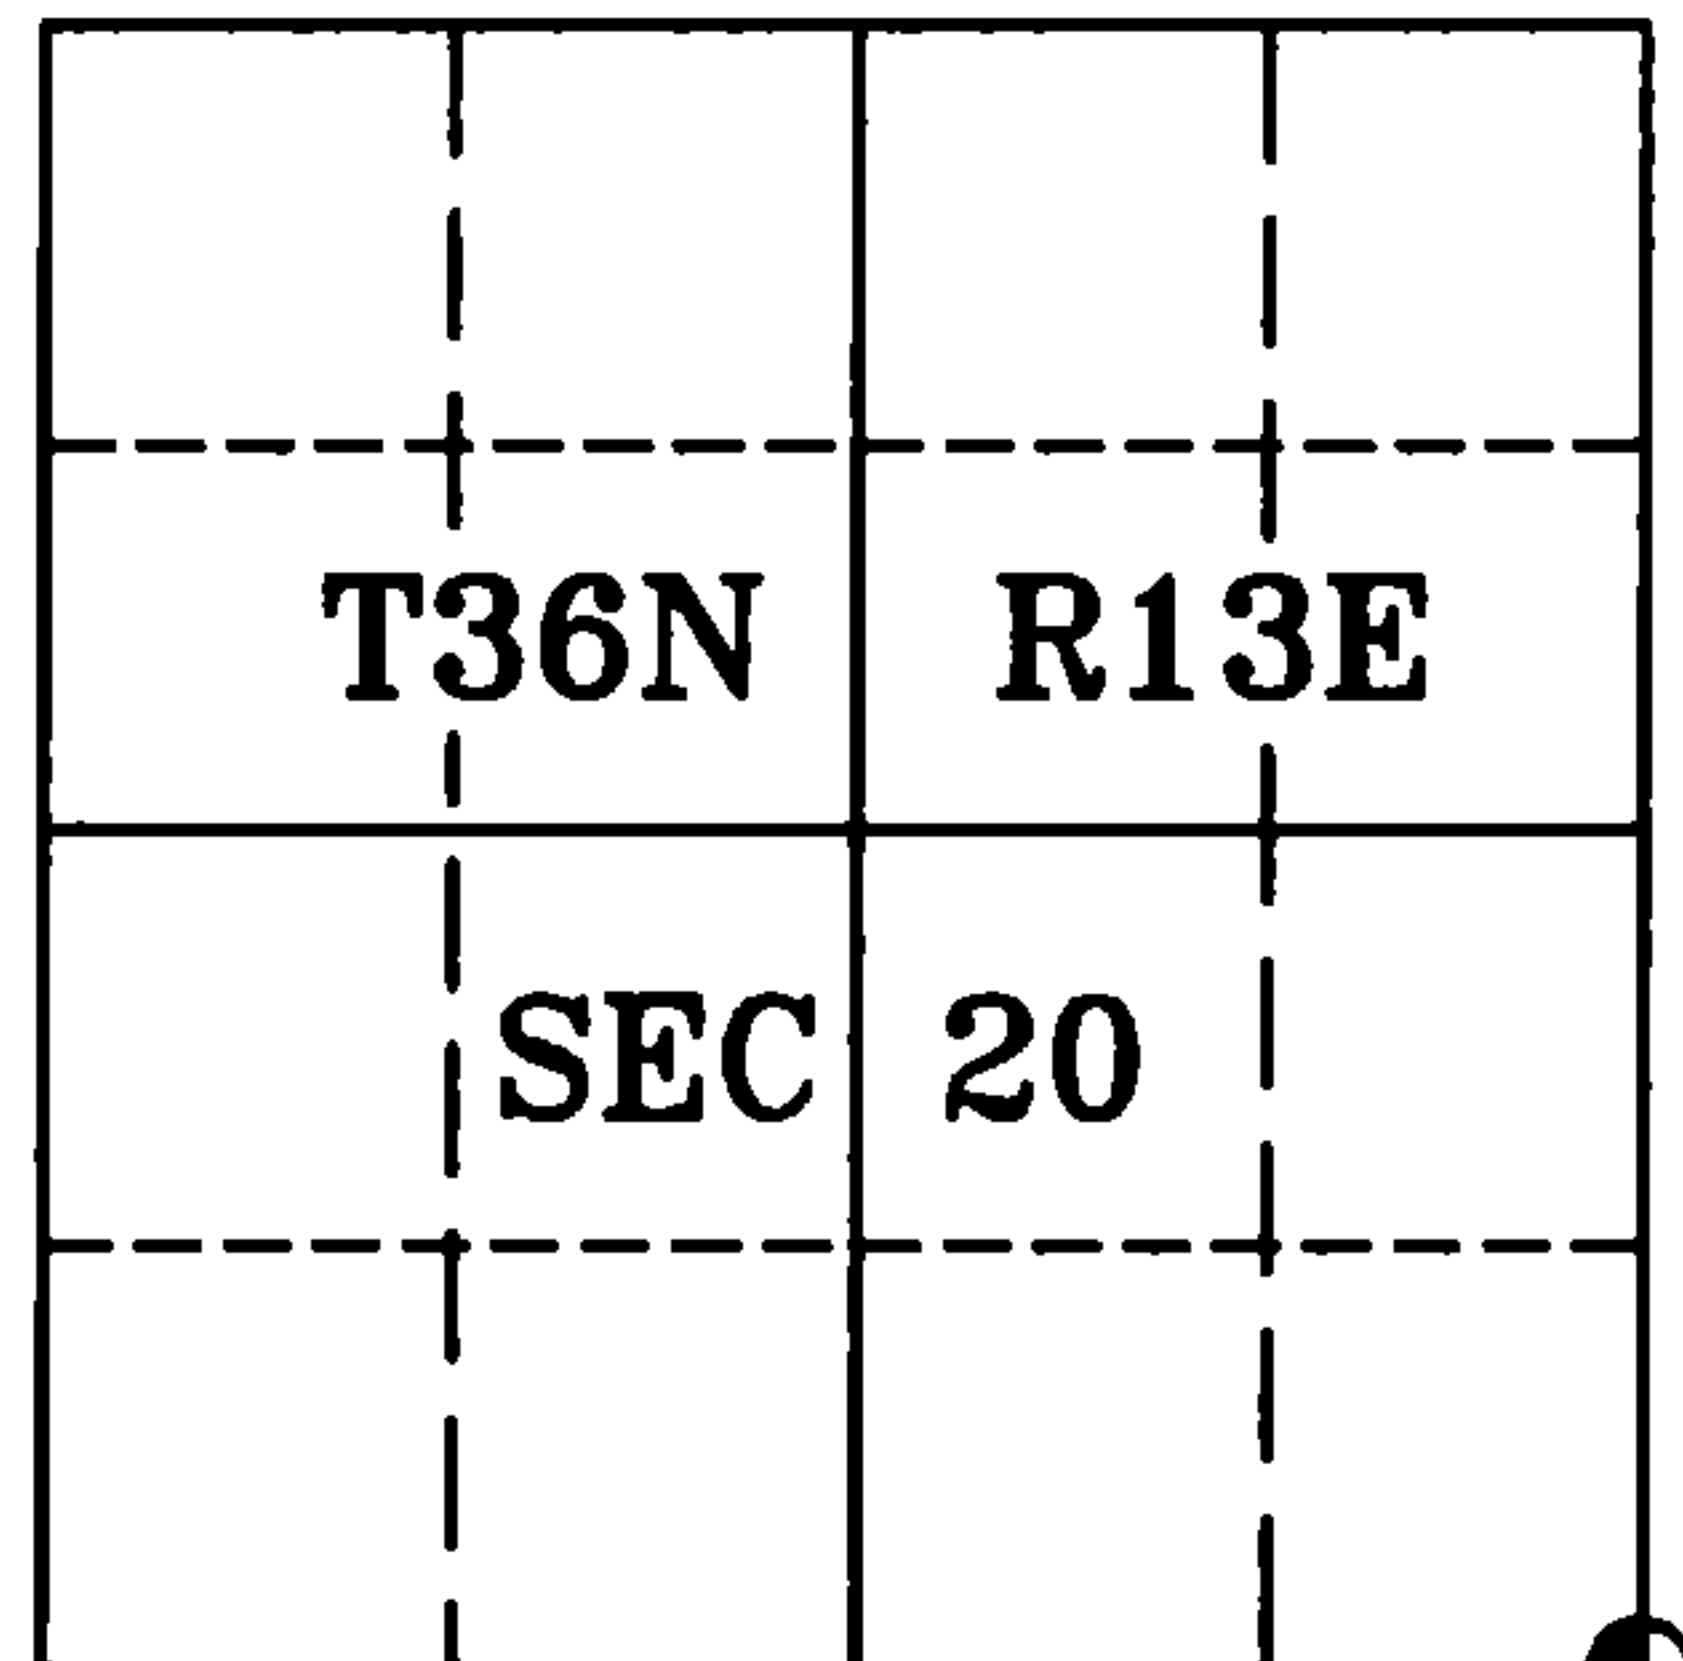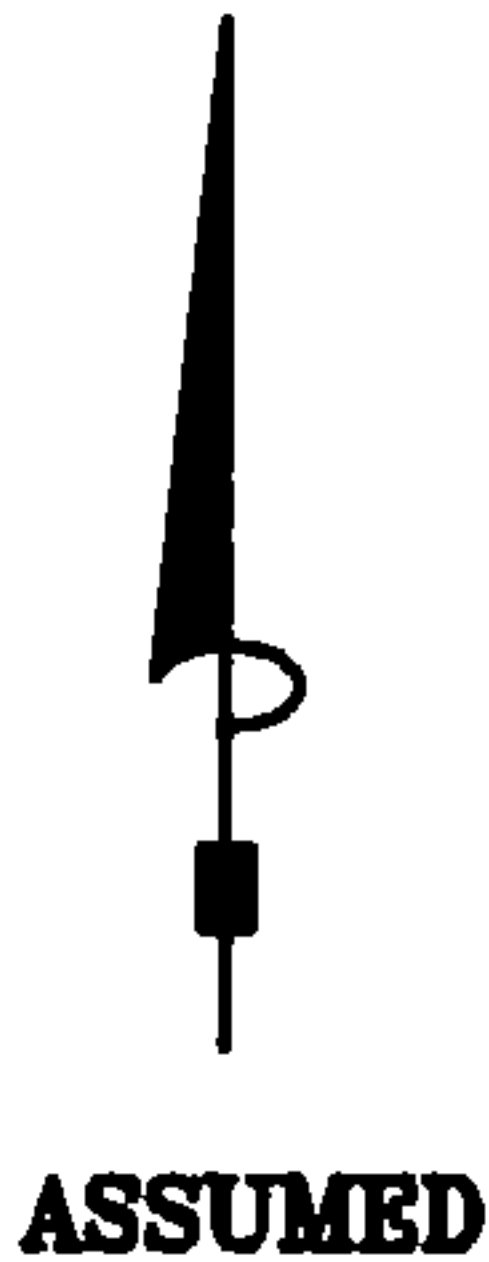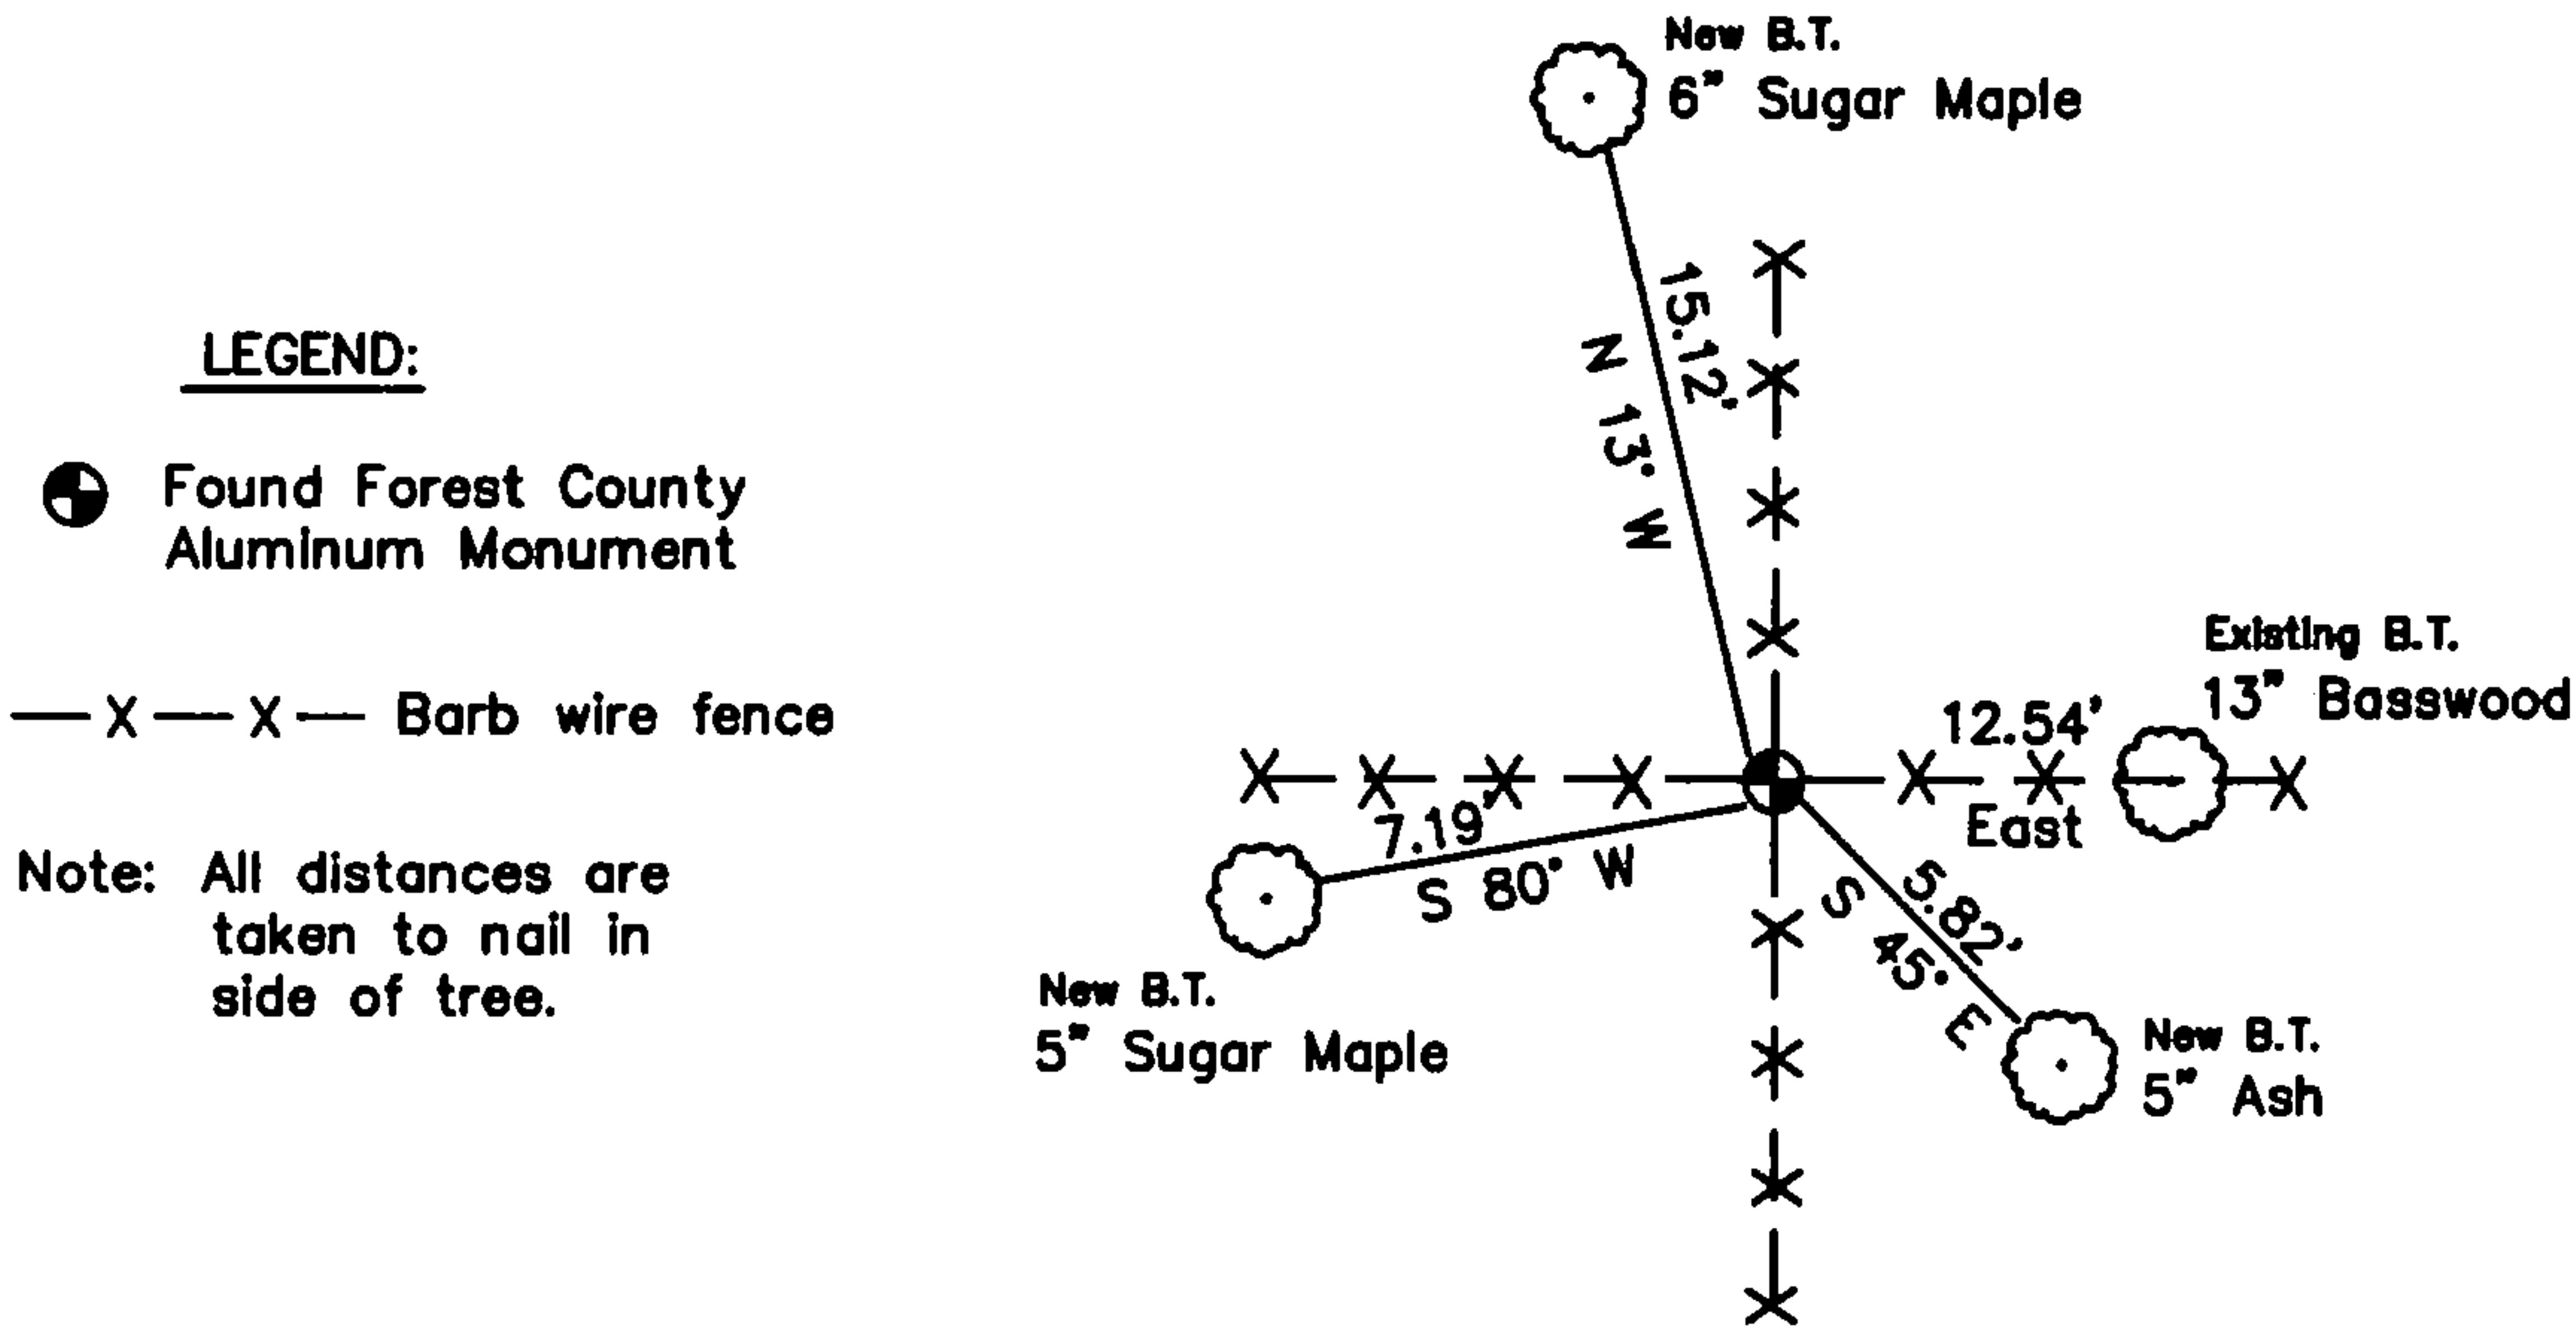

I, Michael A. Tremi, RLS
(type or print name) certify that the corner location shown on this record was determined by me or under my direction and control and that this U.S. Public Land Survey Monument Record is correct and complete to the best of my knowledge and belief.

Michael A. Tremi 7/1/03
Signature Date

The Southeast corner of
Section 20 T. 36 N., R. 13 E.
Forest County, WI

Index No. R-9

4361320000

R-9