

CERTIFIED LAND CORNER RESTORATION

Index No. **R11**


State of Wisconsin }
County of Forest } ss.

I Thomas Arnott, do hereby certify that on the 14th day of May, 1976, I found evidence of the 1/4 corner of Sections 21 & 28 Township 36, North, Range 13 E, Fourth Principal Meridian, as described hereon; and that from this evidence I established a new monument and accessories as described hereon to perpetuate the original location of this corner.

Resident witnesses:

.....
.....
.....

FORM 985 H. G. MILLER CO., MILWAUKEE

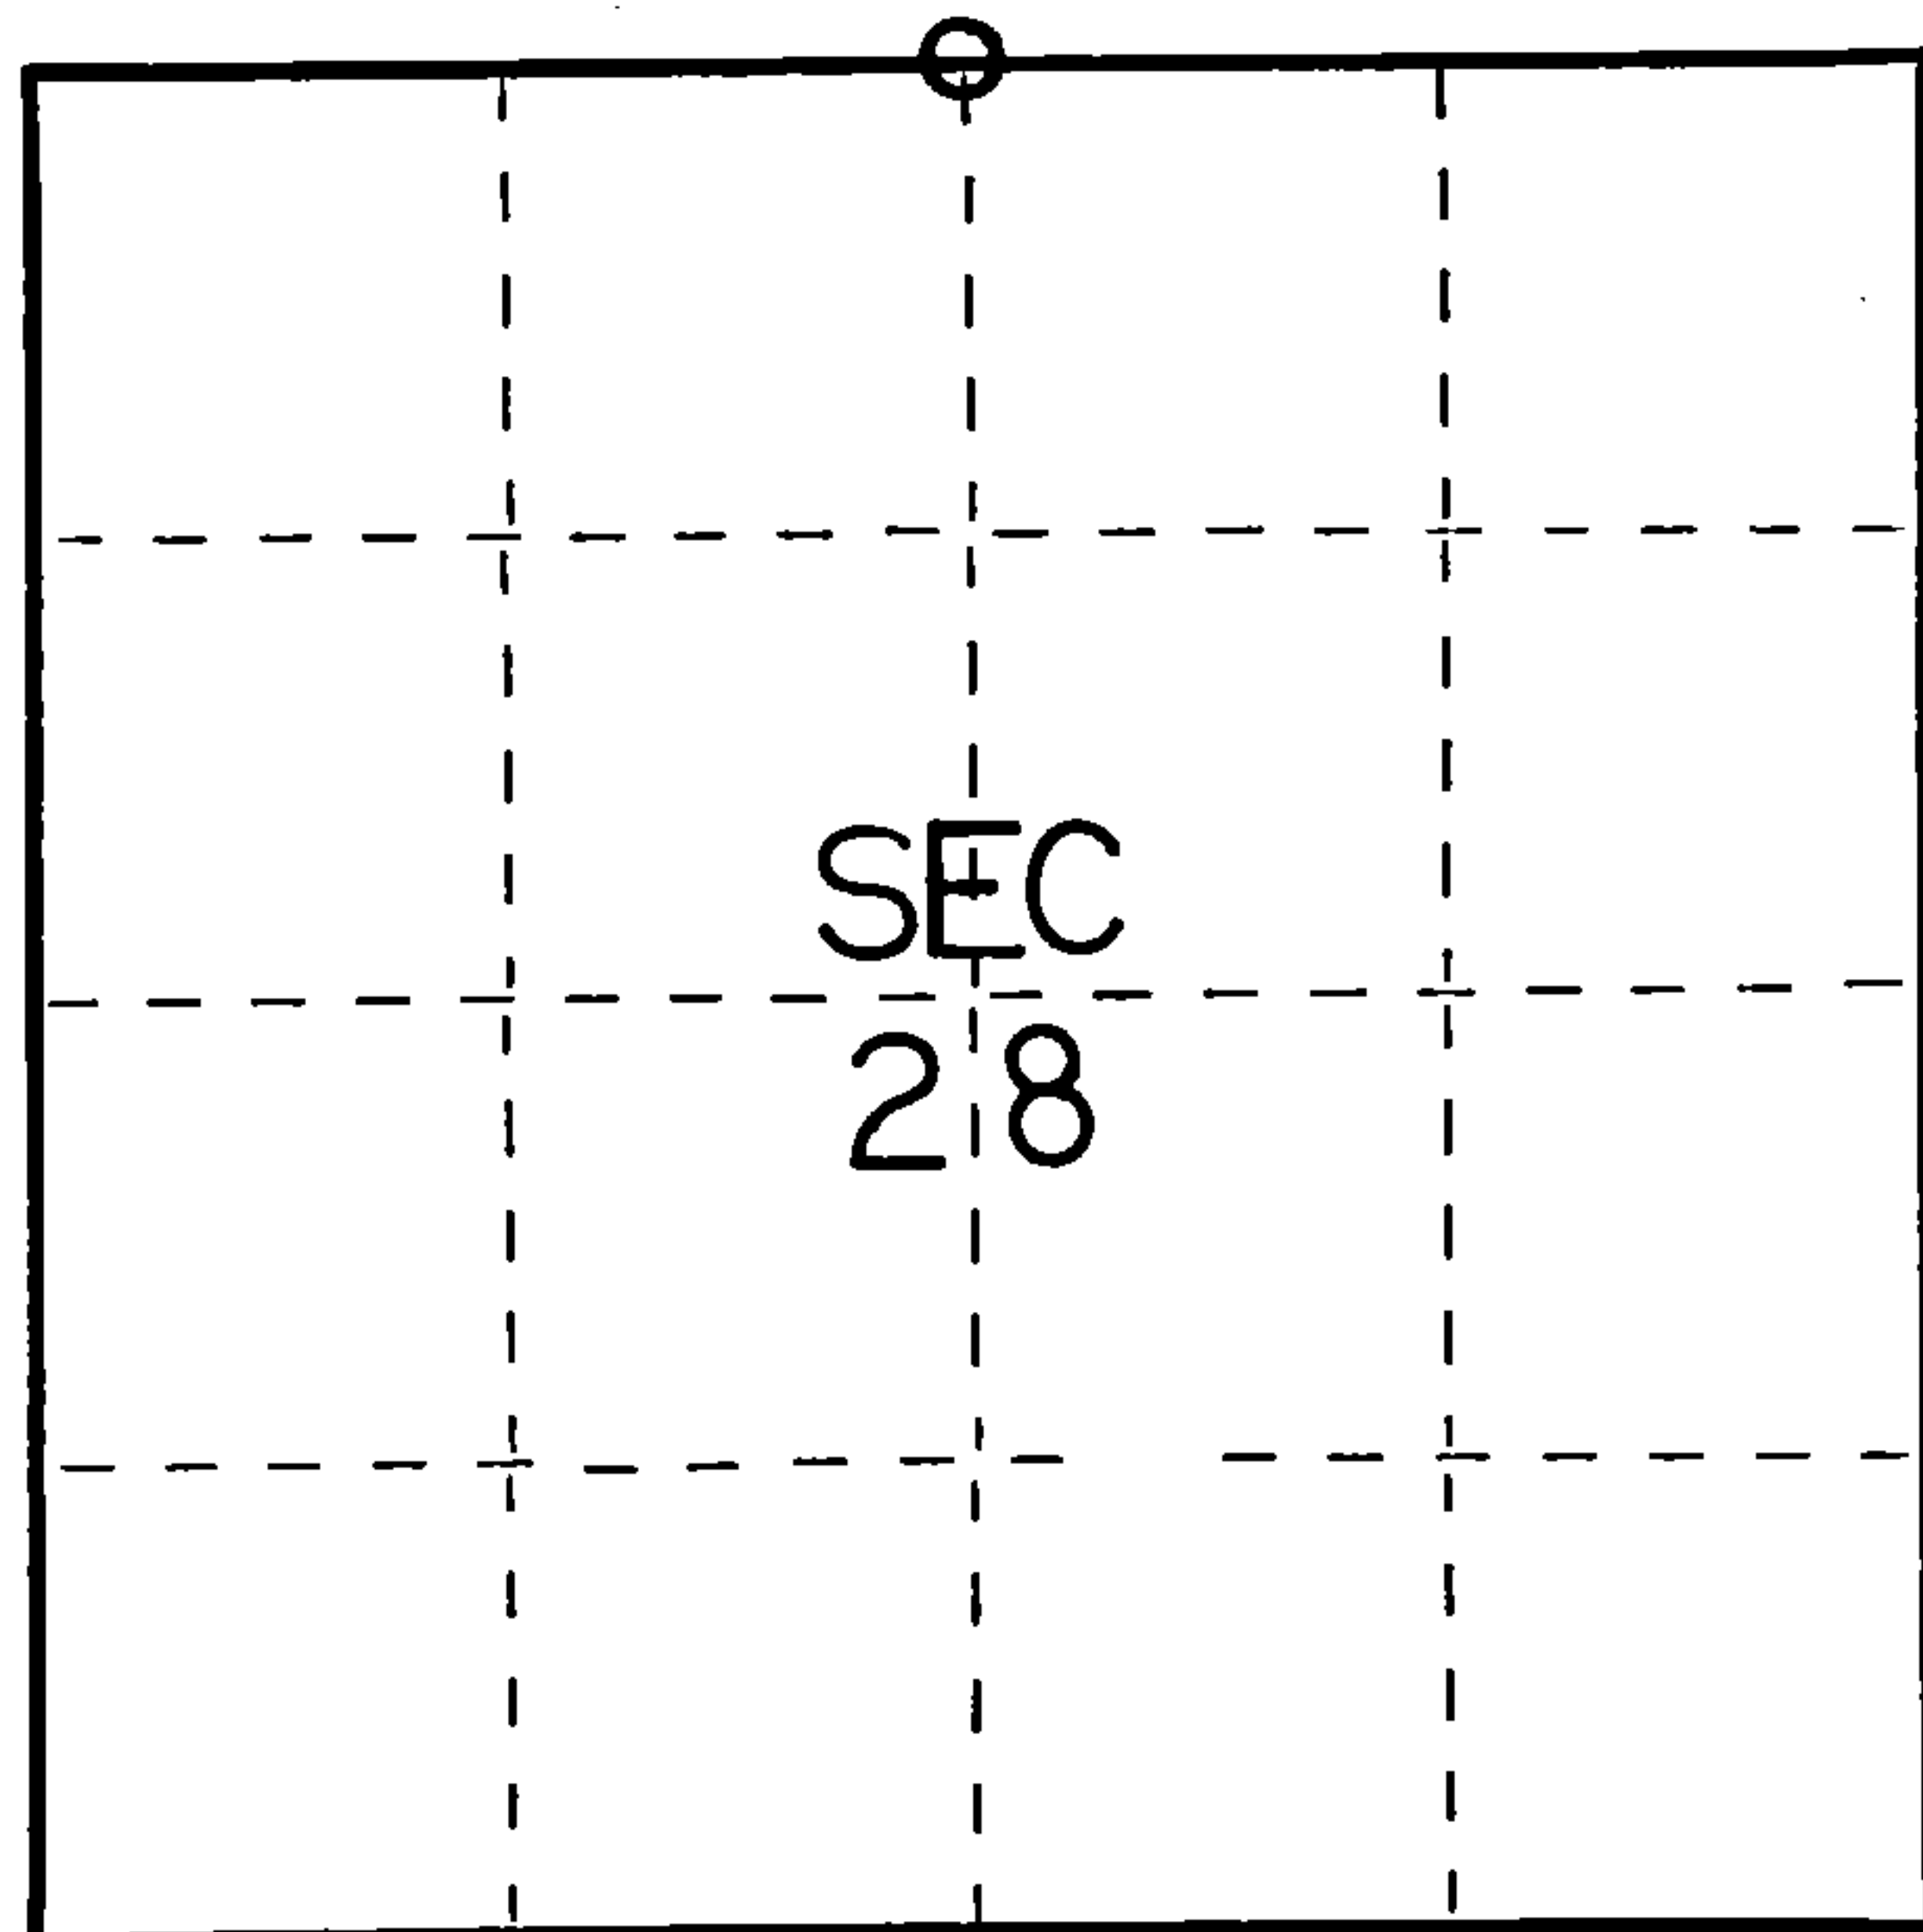

○ = Corner monument restored.

History of original corner establishment:

Original subdivision by James Nowlin 2 June - 12 June, 1865

Birch 20 S20W 18 Lks.
Ironwood 10 N78W 13 Lks.

Description of corner evidence found:


Local testimony of Omer Lundt who saw a iron pin before road was graded and blacktoped

Description of monument and accessories I established to perpetuate the original location of this corner

Set 1 1/2" iron pipe in place were Omer Lundt said he remembered iron pin was

Ties:

Forest County Aluminum monument	N46W	36.07 feet
W. Birch 10	S59E	41.77 feet
power pole (3613-28W8)	S8W	117.16 feet

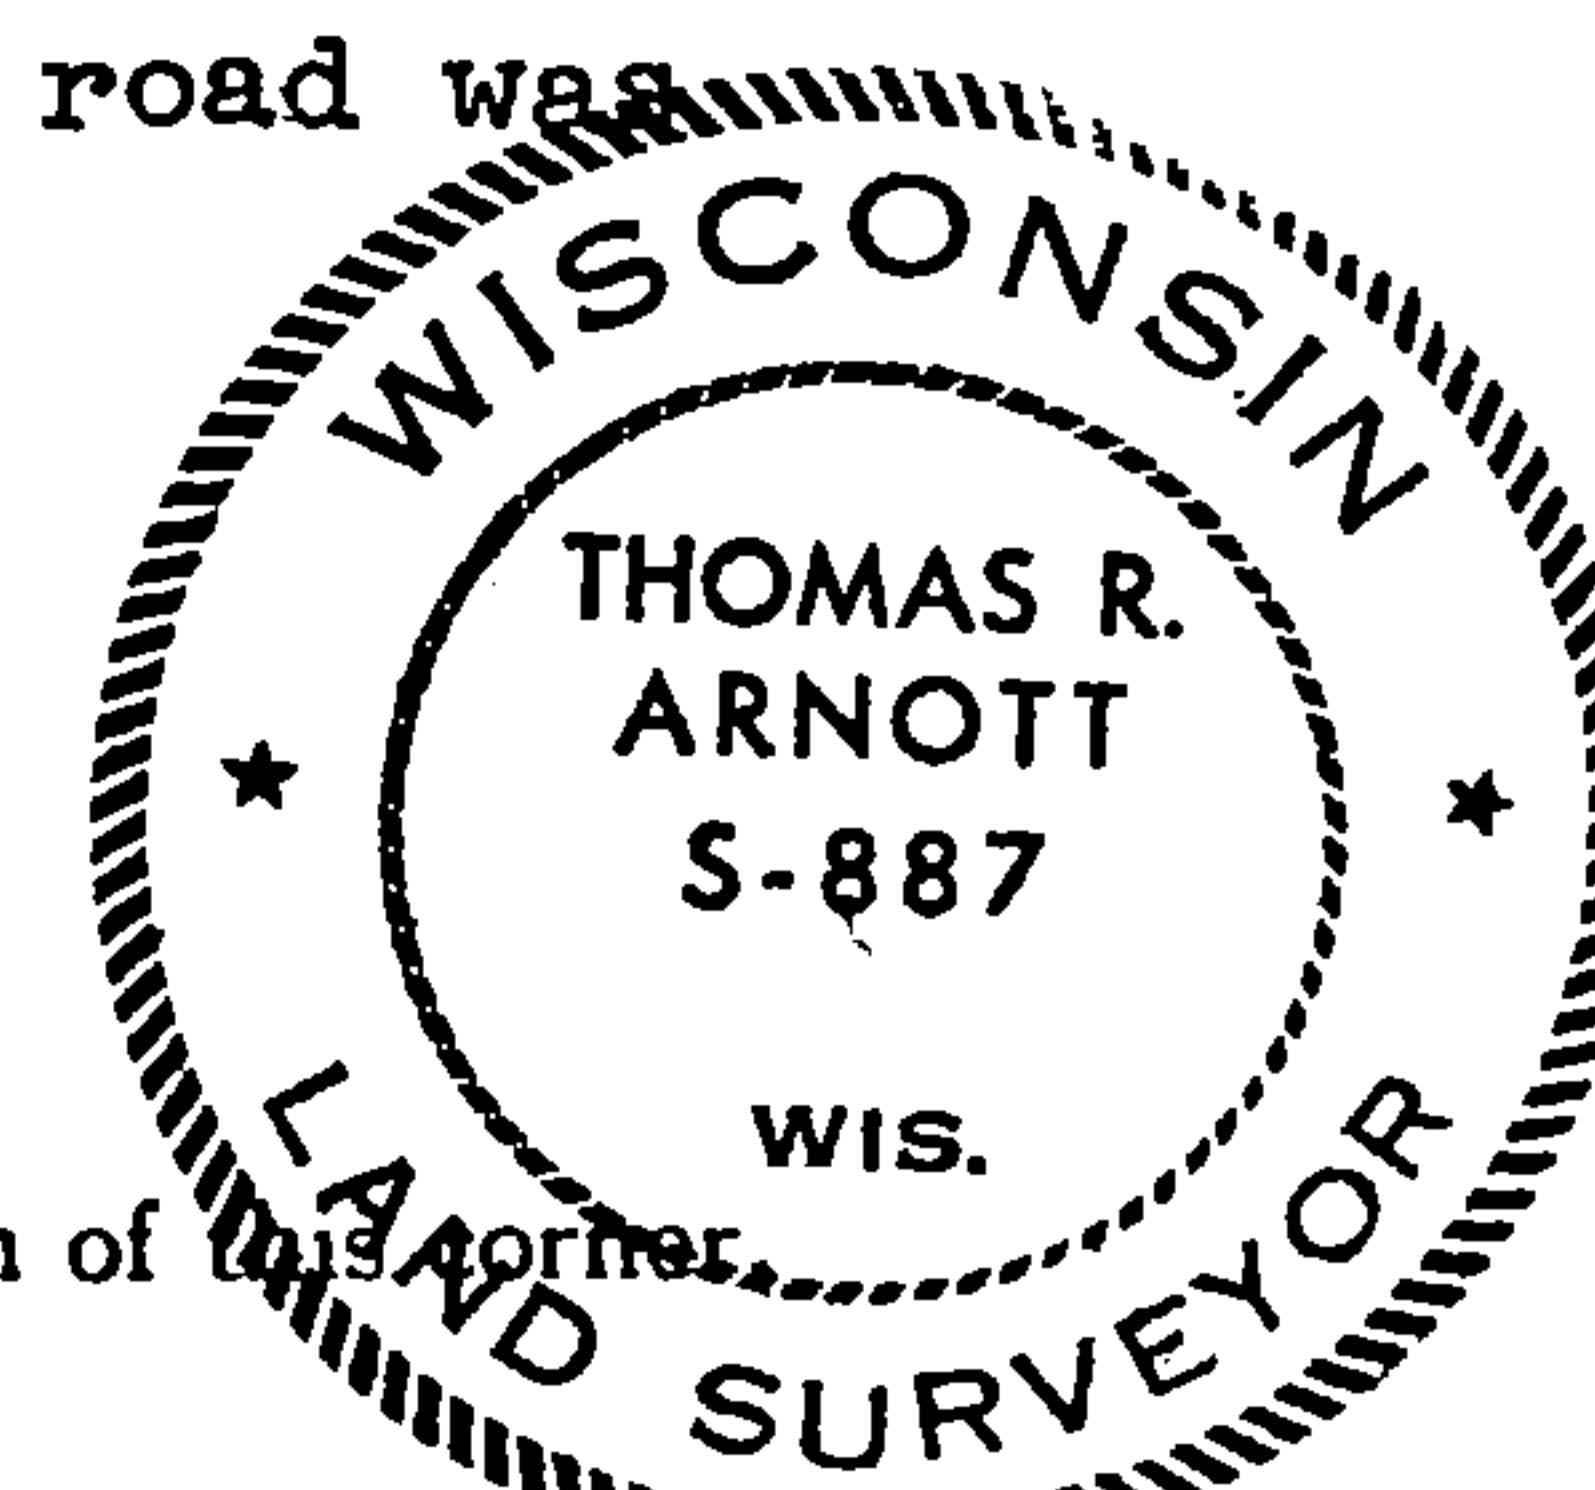

43013210020

Dated at Crandon, Wis., this 14th day of May, 1976

Signature Thomas R. Arnott Title Surveyor Registration No. S-887
(County Surveyor, Registered Land Surveyor, or other duly authorized official)

Office of Register of Deeds, County of Forest, I hereby certify that the within instrument was filed in this office for record on the 14th day of May, 1976 at 3 o'clock P. M.

Eugene Statelyny Document No. **109215**
(Register of Deeds)

By Deputy