

CERTIFIED LAND CORNER RESTORATION


Index No. **V15**

State of Wisconsin }
County of Forest } ss.

I Thomas R. Arnott, do hereby certify that on the 9th day of January, 1976, I found evidence of the 1/4 corner of sections 27 & 34 Township 36, North, Range 13 E, Fourth Principal Meridian, as described hereon; and that from this evidence I established a new monument and accessories as described hereon to perpetuate the original location of this corner.

Resident witnesses:

.....
.....
.....

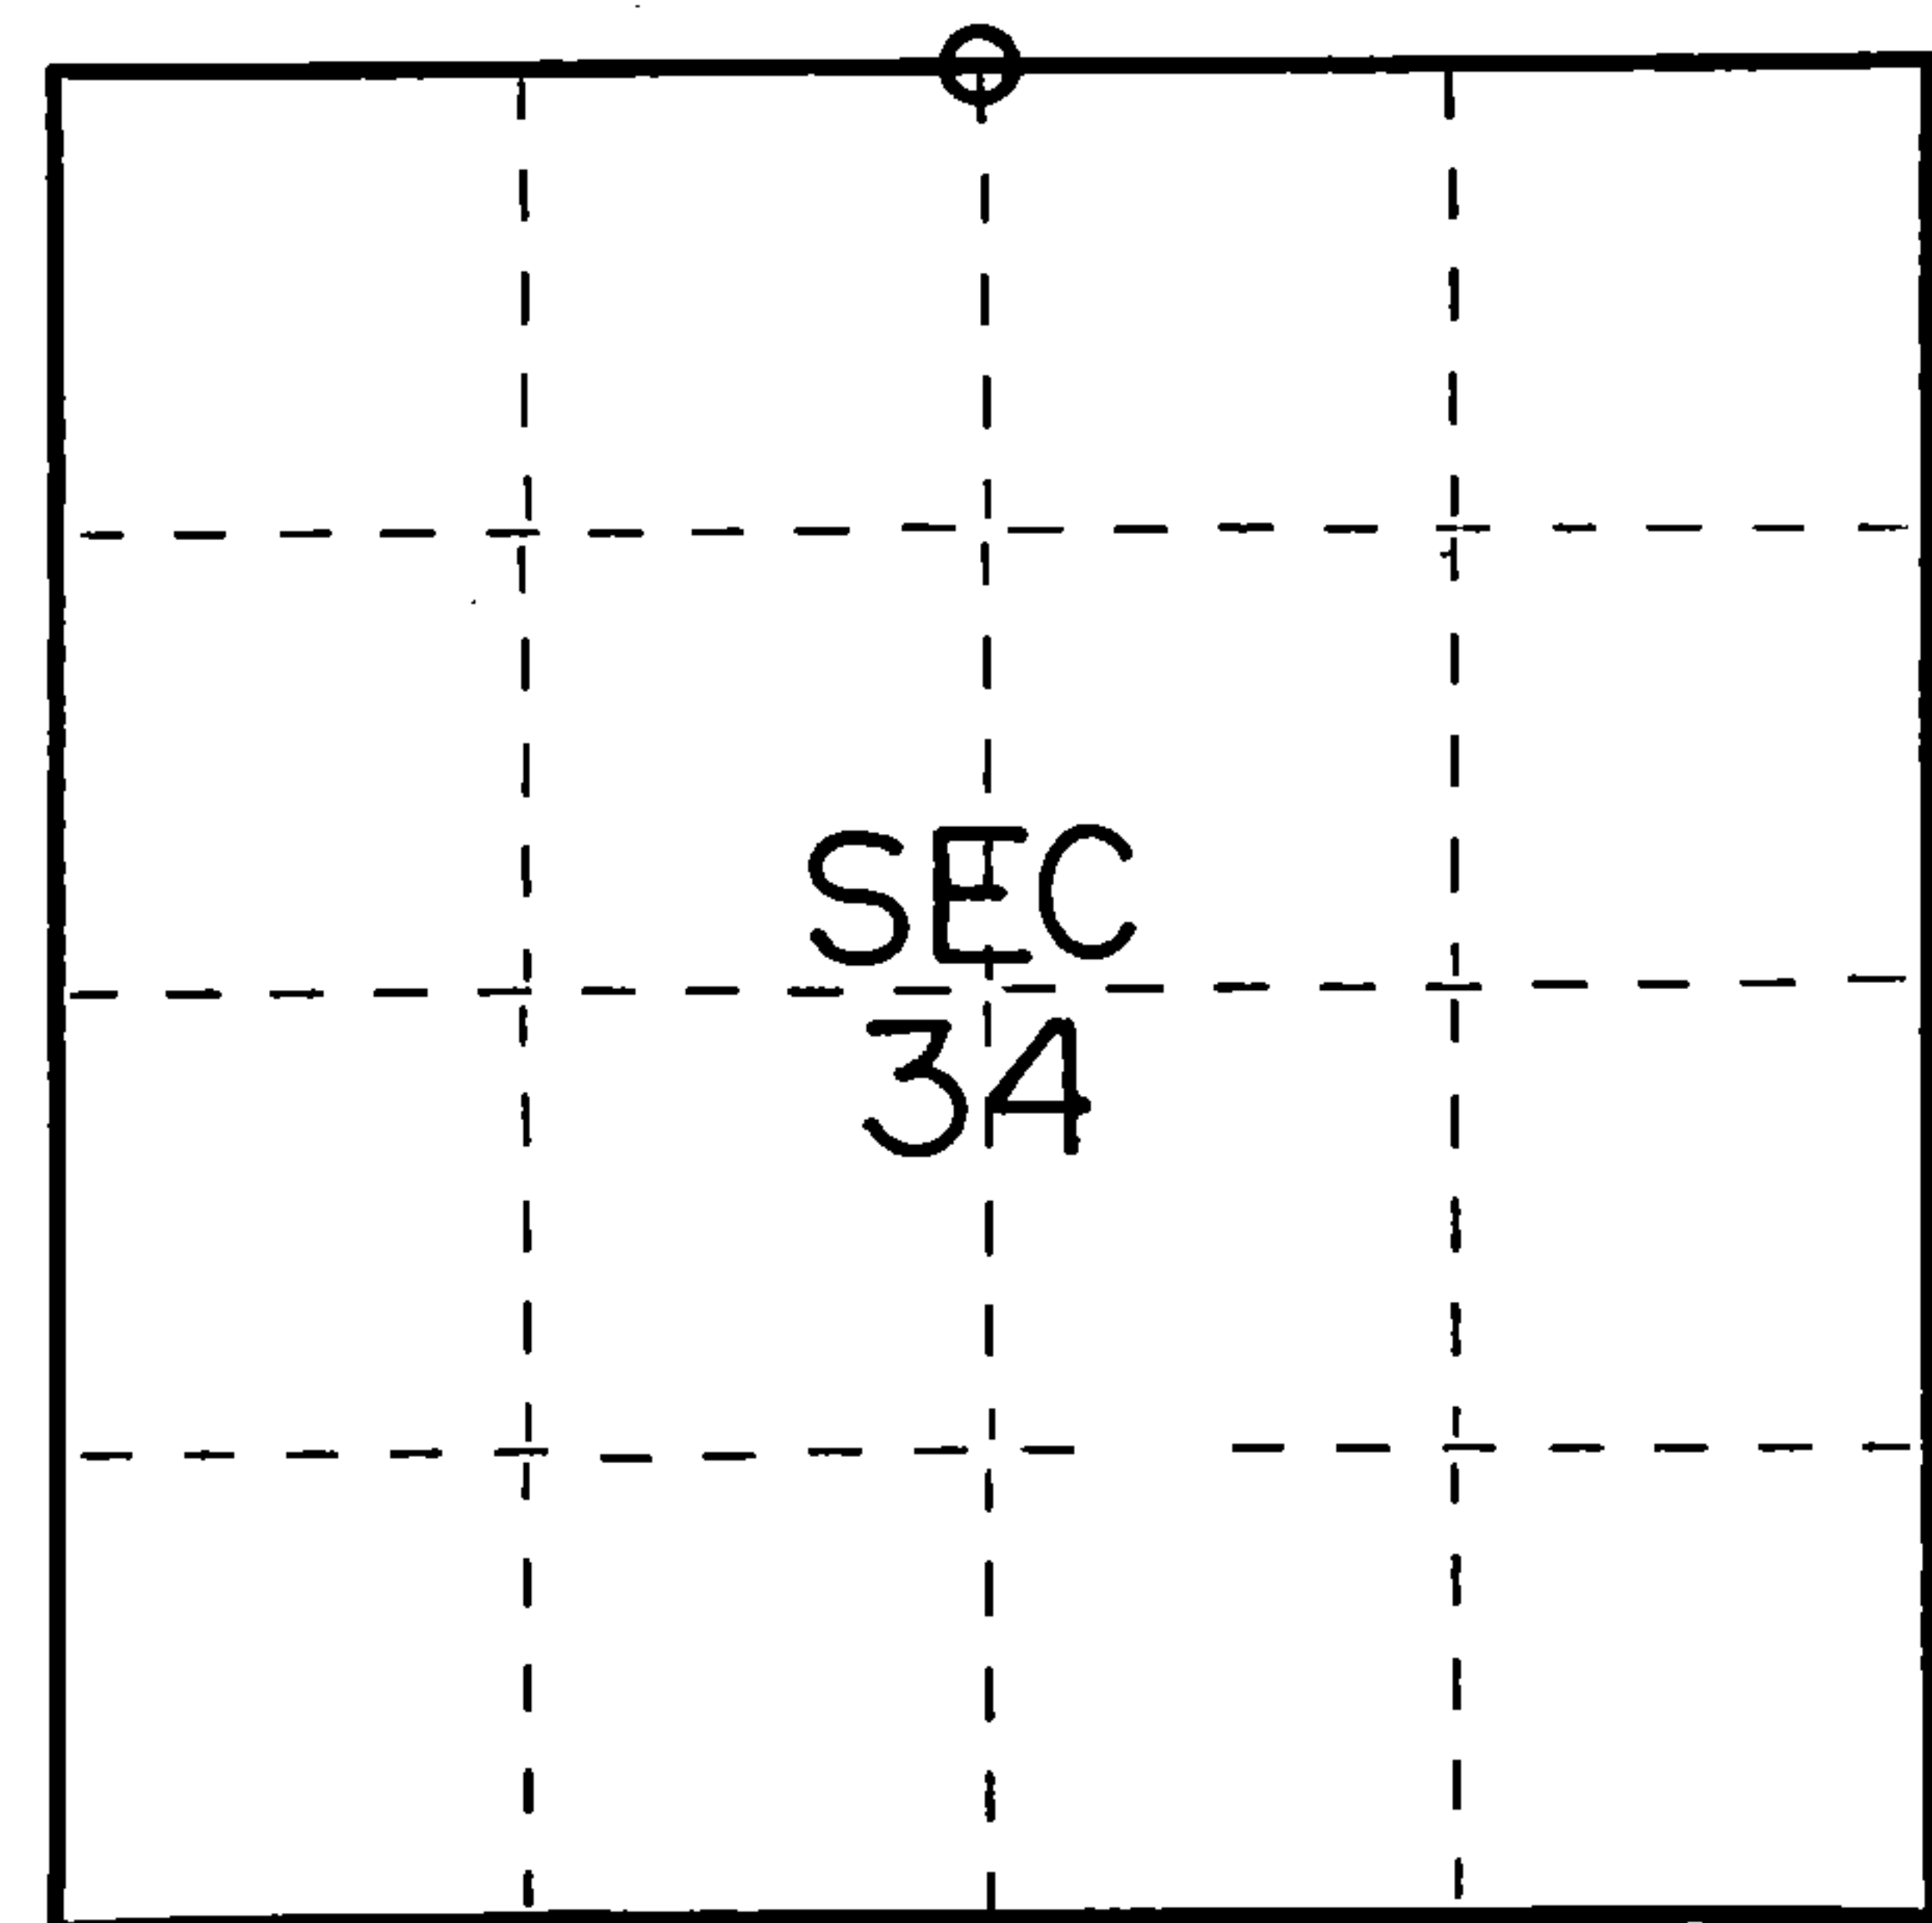

○ = Corner monument restored.

History of original corner establishment:

Original subdivision by James Nowlin June 2 - June 12, 1864

Spruce 4 N10E 5Lks.
Spruce 5 S50E 1 1/4 Lks.

Description of corner evidence found:


2" iron pipe 5' long with brass cap set by C.E. Walker in 1938
Wood post found

Description of monument and accessories I established to perpetuate the original location of this corner.

Left monument set by Walker

Ties:

Spruce 6 N26E 12.11 feet
Spruce 6 S70E 25.22 feet
Spruce 6 N50W 32.20 feet

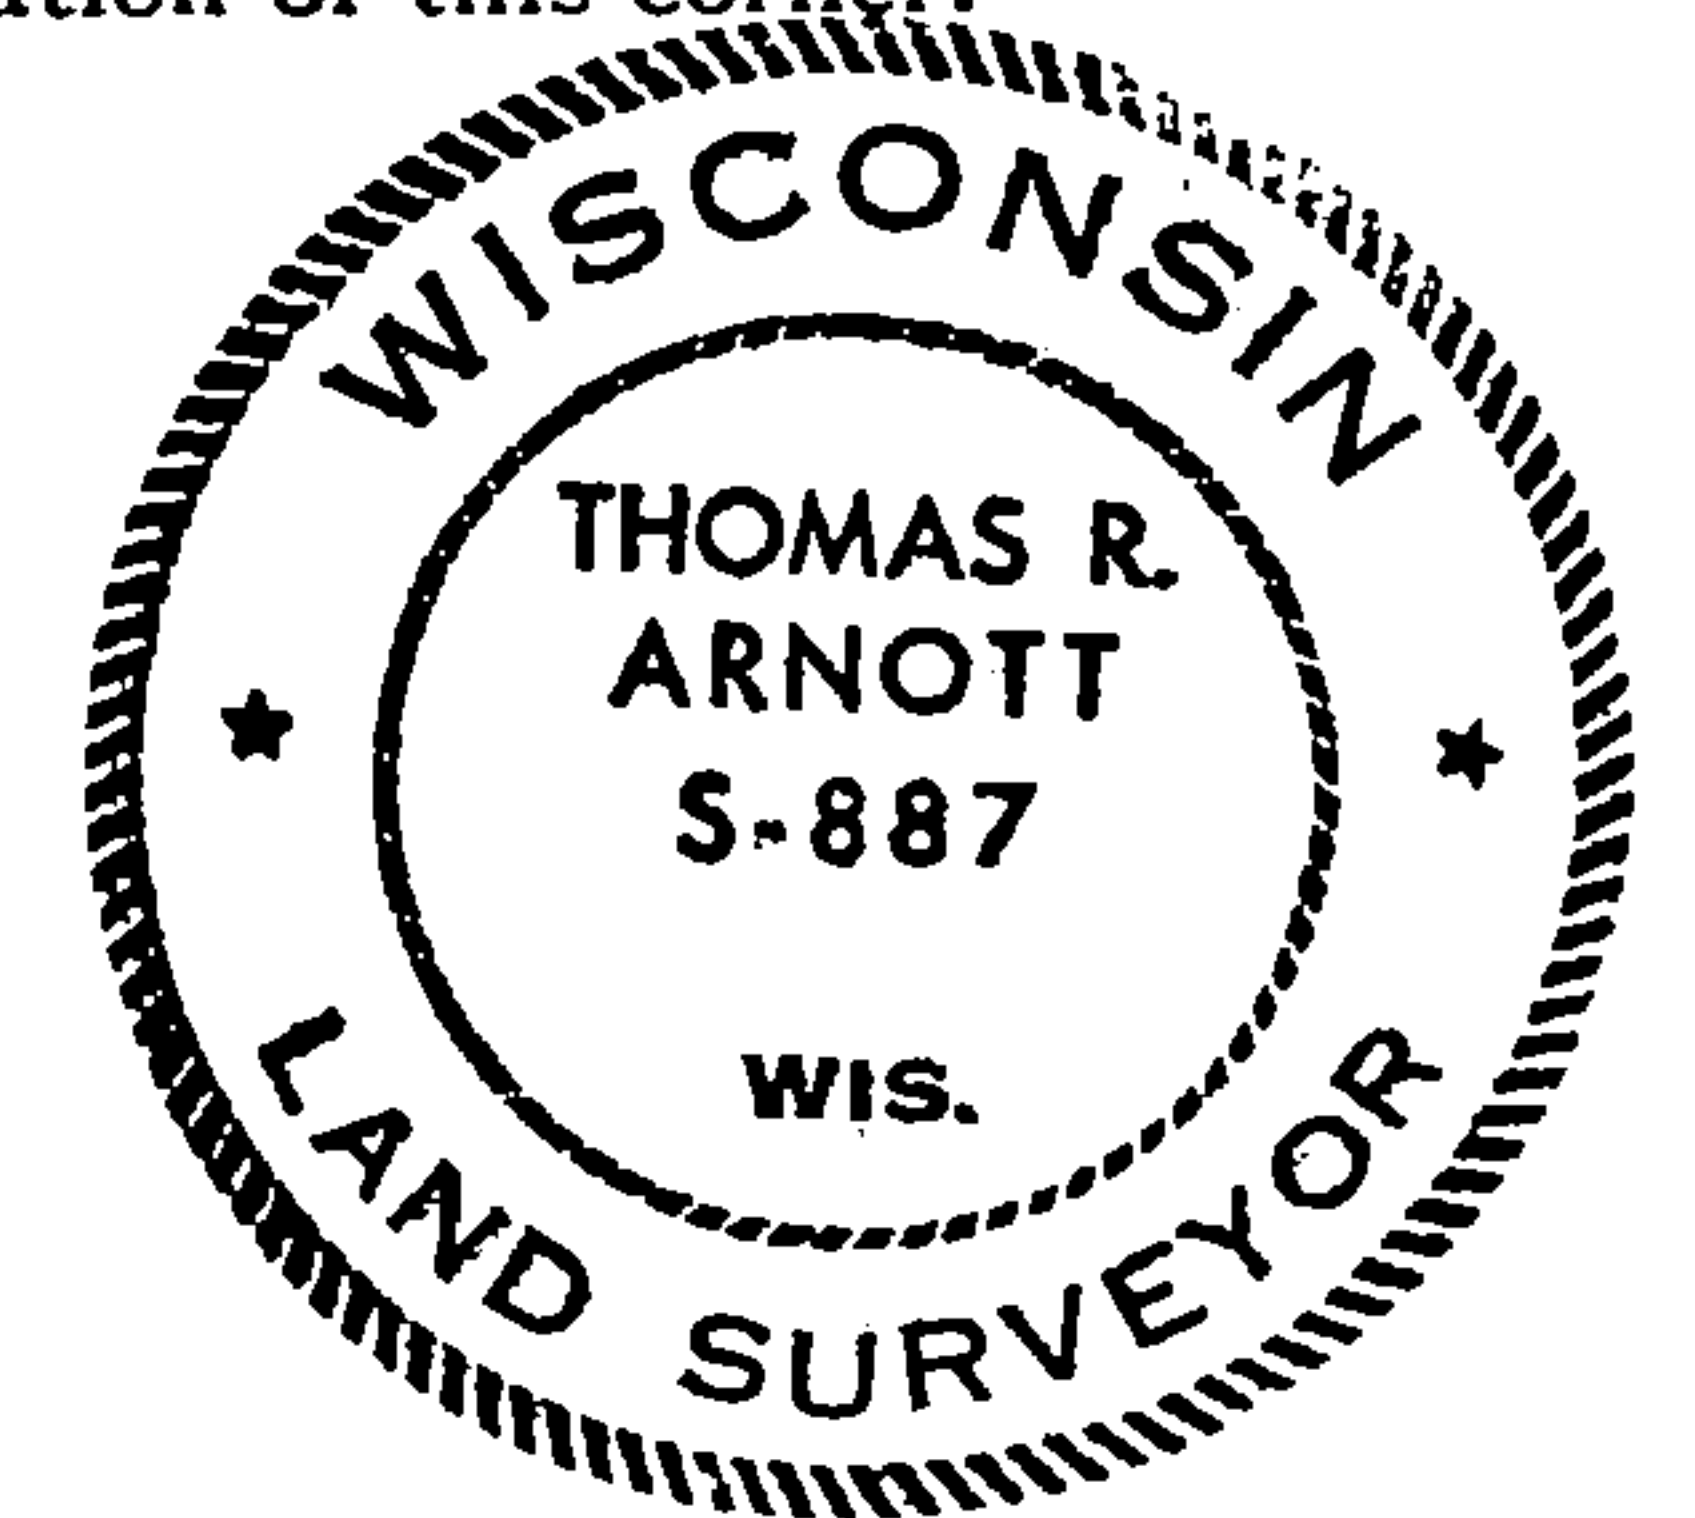

Dated at Crandon, Wis., this 15th day of January, 1976.

Signature Thomas Arnott Title Surveyor Registration No. S-887
(County Surveyor, Registered Land Surveyor, or other duly authorized official)

Office of Register of Deeds, County of Forest, I hereby certify that the within instrument was filed in this office for record on the 15th day of January, 1976 at 3 o'clock P. M.

Eugene Stagny Document Number **108573**
(Register of Deeds)

By Deputy

FORM 985 H. G. MILLER CO., MILWAUKEE

43613270020