

CERTIFIED LAND CORNER RESTORATION

Index No. **V13**


State of Wisconsin }  
County of Forest } ss.

I Thomas R. Arnett, do hereby certify that on the 15th day of September, 19    , I found evidence of the section corner of sections 27, 28, 33 & 34 Township 36, North, Range 13 E, Fourth Principal Meridian, as described hereon; and that from this evidence I established a new monument and accessories as described hereon to perpetuate the original location of this corner.

Resident witnesses:

Herbert Wagoner  
.....  
.....  
.....

FORM 985 H. C. MILLER CO., MILWAUKEE

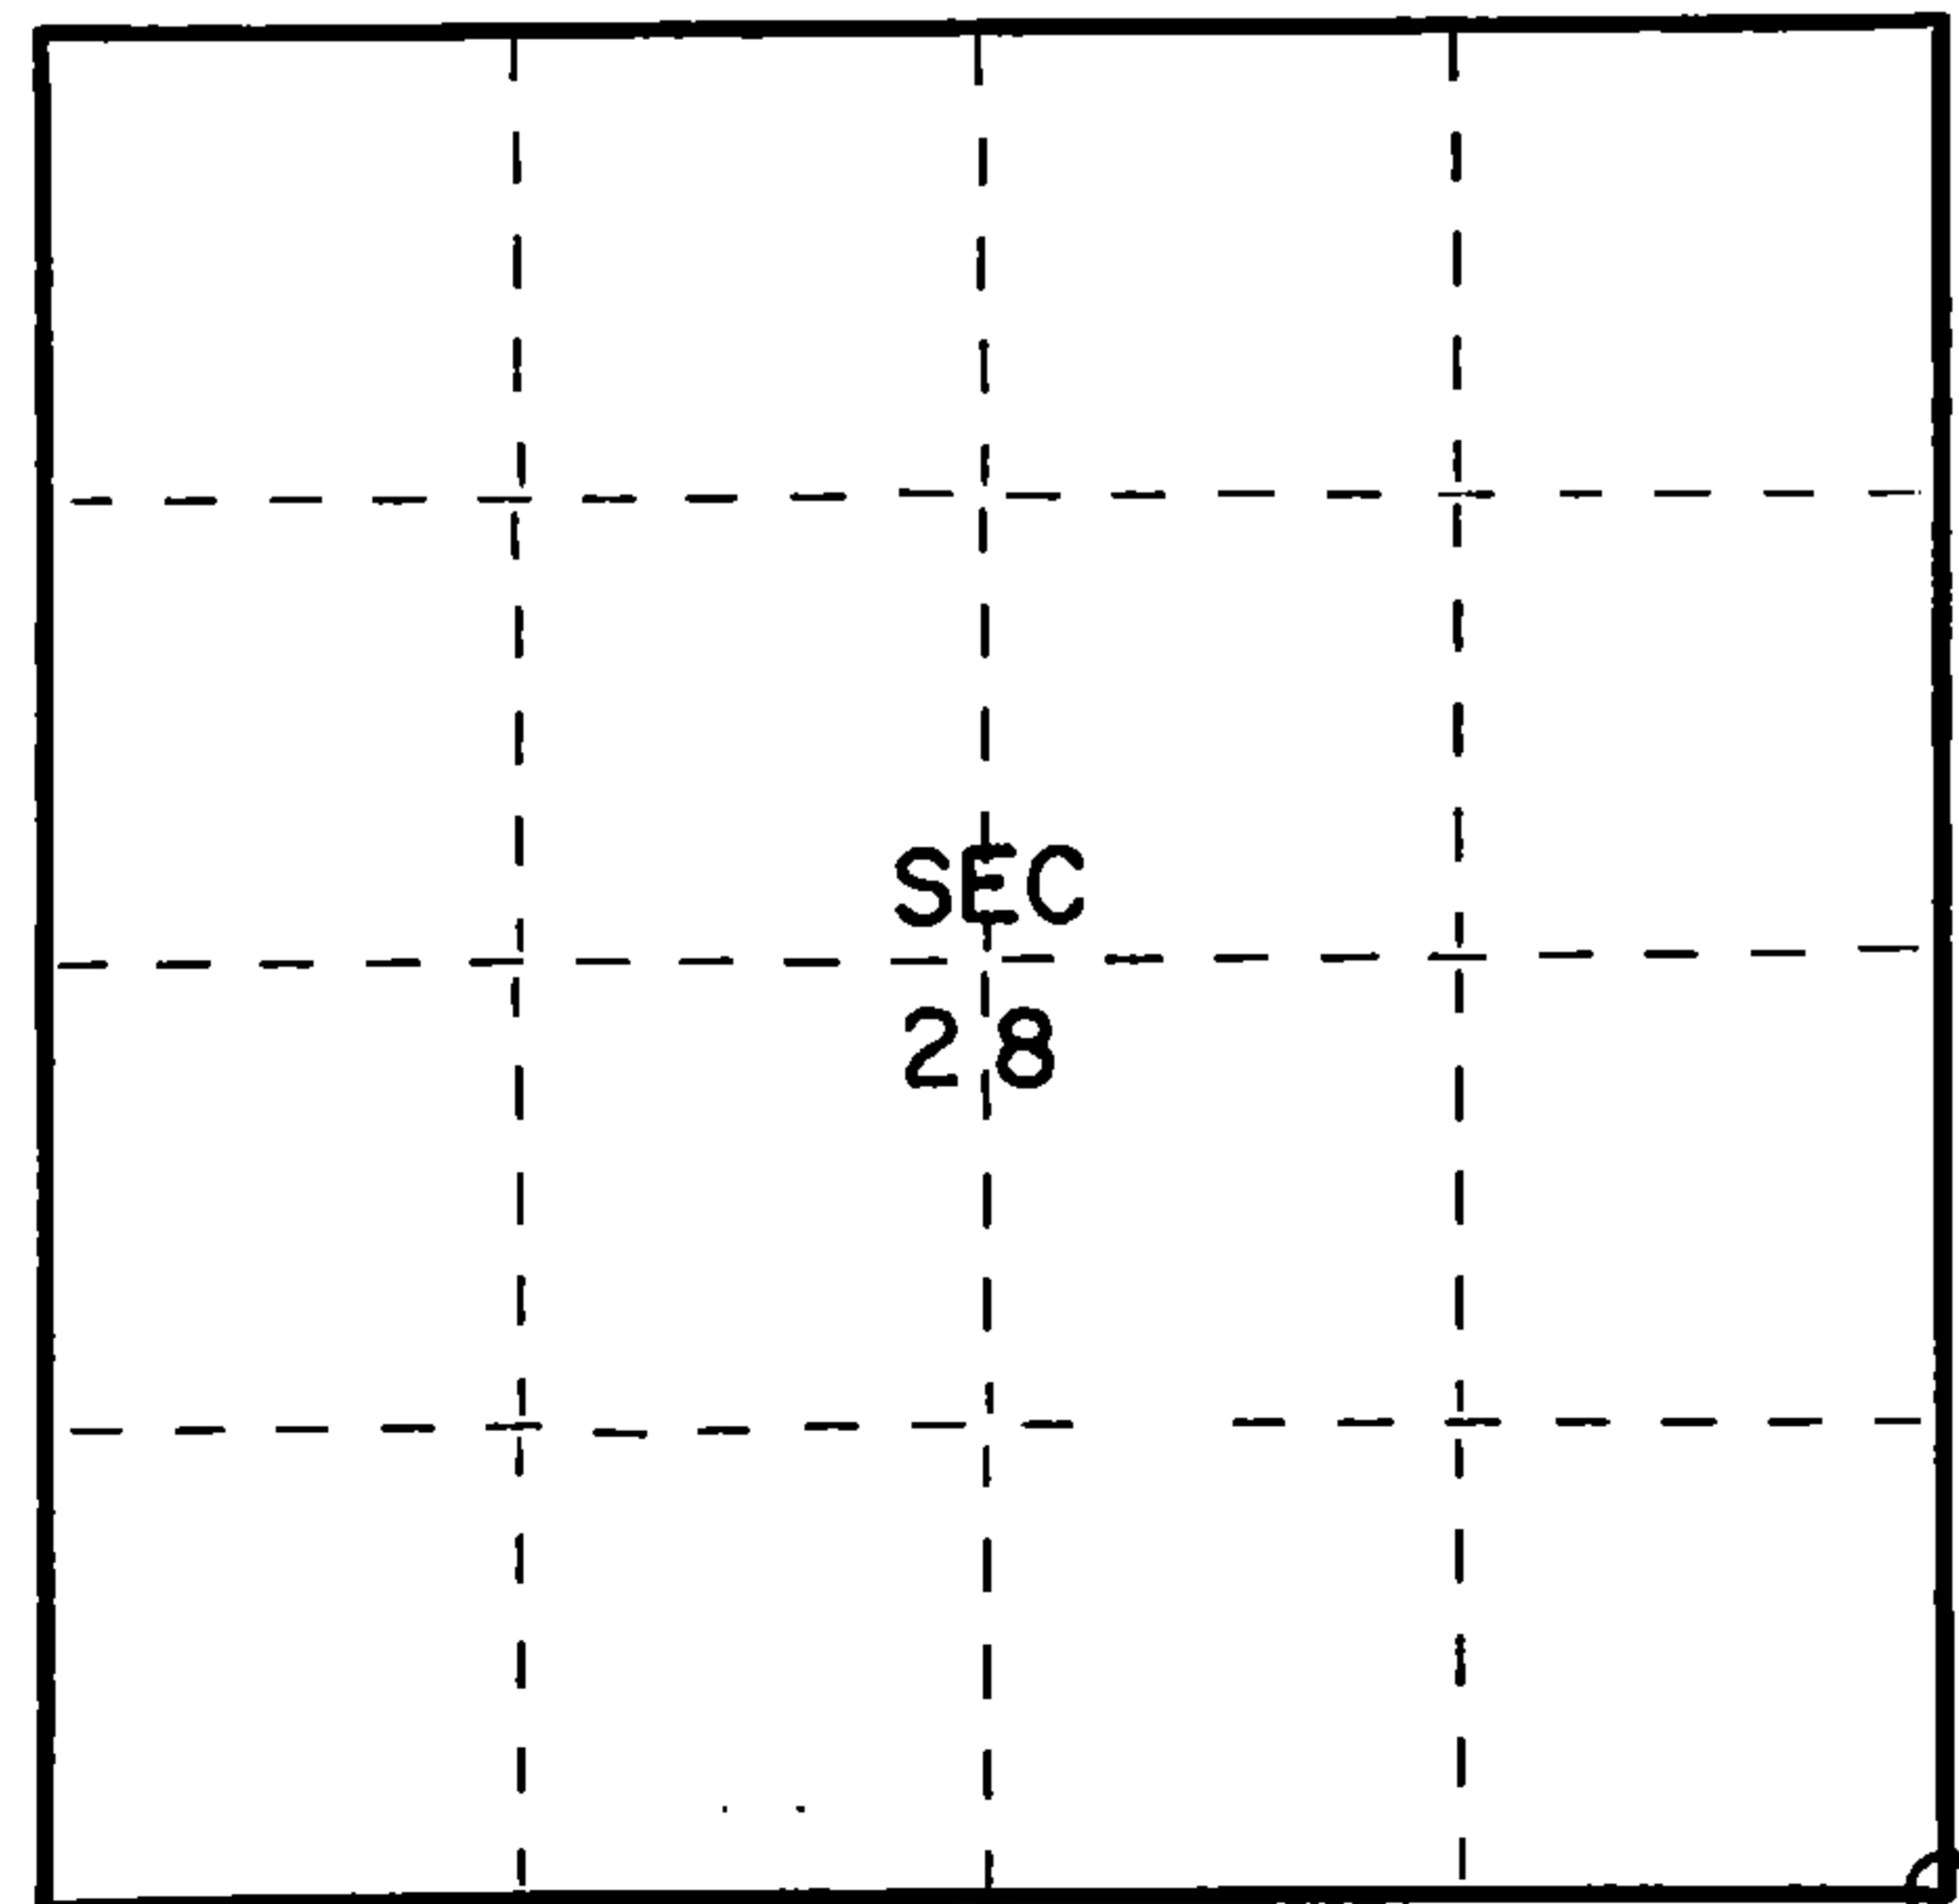

○ = Corner monument restored.

History of original corner establishment:

Original subdivision by James L. Nowlin June 2 - June 12, 1865

Hemlock                    15                    S5W                    6 Lks.  
Sugar                      15                    N35E                    16 Lks.

Description of corner evidence found:

2" iron pipe 5' long with brass cap offset 33 feet east of corner, set by C.E. Walker in 1938

Description of monument and accessories I established to perpetuate the original location of this corner.

Left monument set by Walker  
set RR spike at location of corner

Ties:

power pole (3613-27L1)                    N50E                    37.86 feet  
Walker monument                         East                    33.00 feet  
road sign                                     S46W                    49.05 feet



43613280000

Dated at Crandon, Wis., this 30th day of October, 1975.

Signature..... Title Land Surveyor Registration No. S-887  
(County Surveyor, Registered Land Surveyor, or other duly authorized official)

Office of Register of Deeds, County of Forest, I hereby certify that the within instrument was filed in this office for record on the 30th day of October, 1975 at 1 o'clock P. M.

Eugene Stategraf  
(Register of Deeds)

Document Number **108113**

By..... Deputy