

CERTIFIED LAND CORNER RESTORATION

Index No. **X13**


State of Wisconsin }
County of Forest } ss.

I Thomas R. Arnett, do hereby certify that on the 15th day of September, 1975, I found evidence of the 1/4 corner of sections 33 & 34 Township 36, North, Range 13 E, Fourth Principal Meridian, as described hereon; and that from this evidence I established a new monument and accessories as described hereon to perpetuate the original location of this corner.

Resident witnesses:

Herbert Wagoner

FORM 985 M. C. MILLER CO., MILWAUKEE

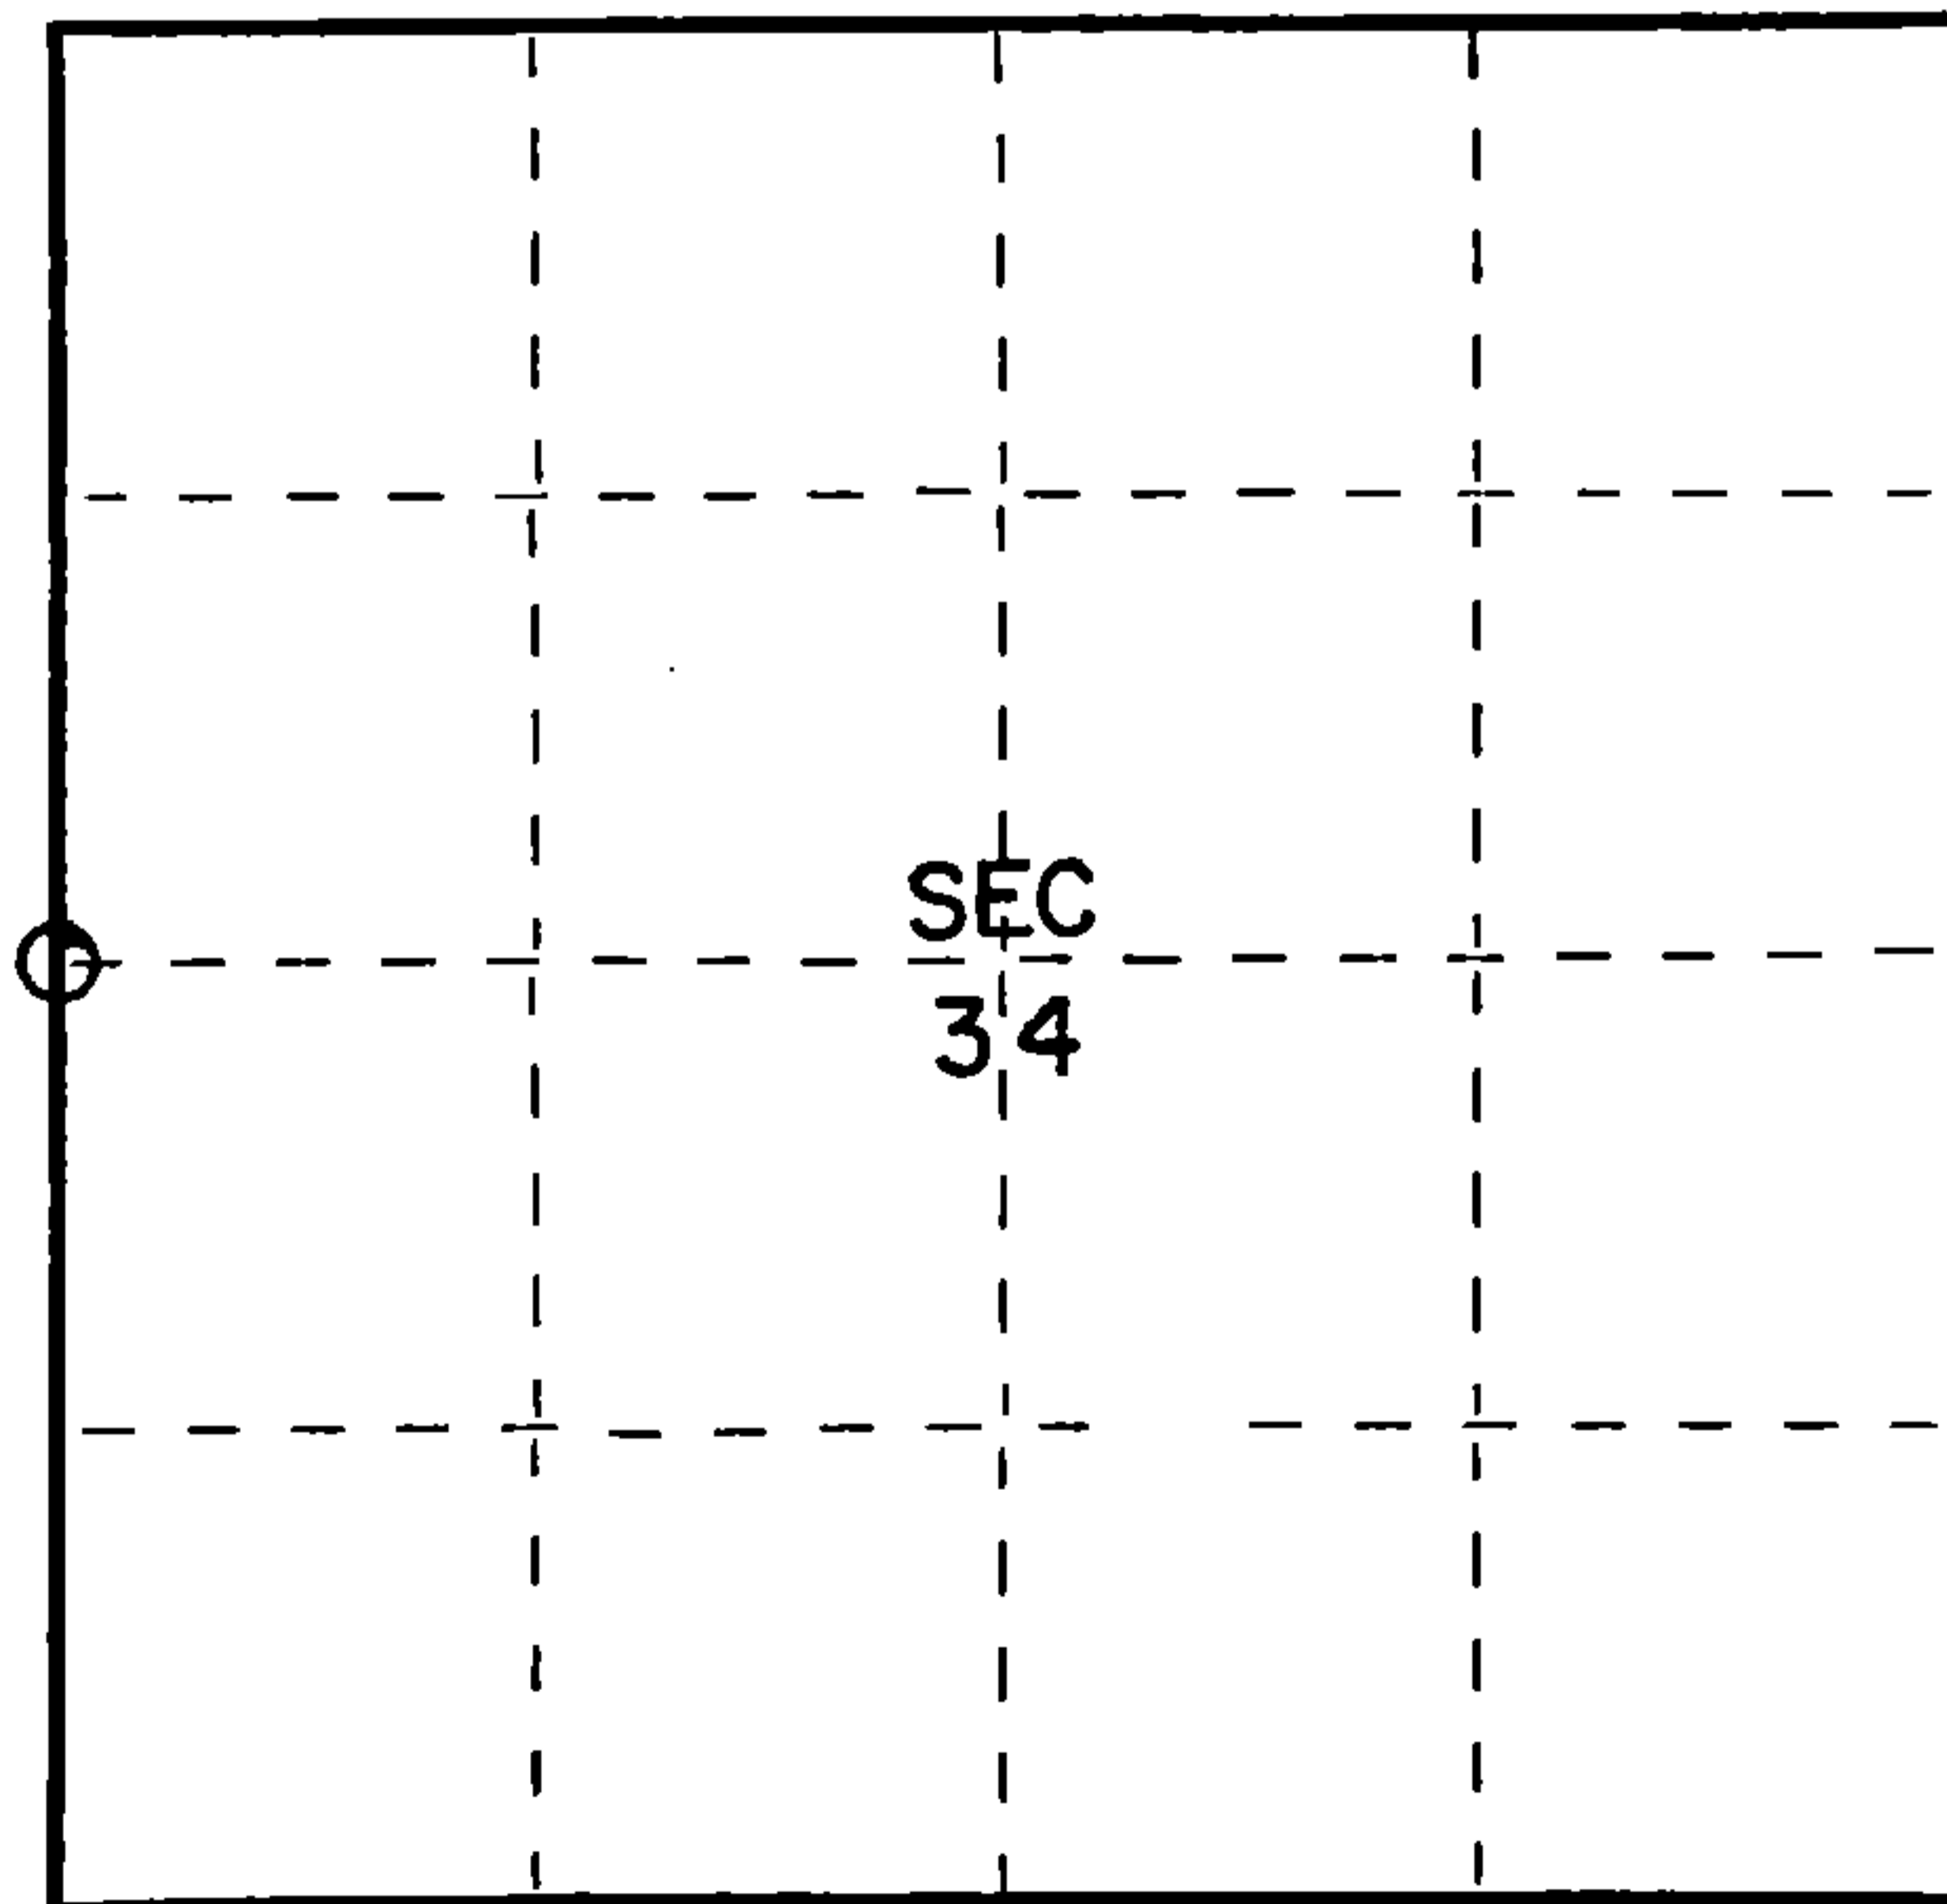

○ = Corner monument restored.

History of original corner establishment:

Original subdivision by James L. Nowlin June 2 - June 12, 1865

Birch 24 N87W 43 Lks.
Birch 8 N82 1/2 W 30 Lks.

Description of corner evidence found:

2" iron pipe with brass capp 5' long set by C.E. Walker in 1938

Description of monument and accessories I established to perpetuate the original location of this corner.

Left monument set by Walker

Ties:

Oak 14" S15E 11.80 feet
Maple 6" S48W 27.66 feet



Dated at Crandon, Wis., this 30th day of October, 1975

Signature Thomas R. Arnett Title Land Surveyor Registration No. S-887
(County Surveyor, Registered Land Surveyor, or other duly authorized official)

Office of Register of Deeds, County of Forest, I hereby certify that the within instrument was filed in this office for record on the 30th day of October, 1975 at 1 o'clock P. M.

Eugene Stutzman
(Register of Deeds)
By _____ Deputy

Document Number **108114**

43613332000