

CERTIFIED LAND CORNER RESTORATION

Index No. **A-15**

State of Wisconsin }
County of Forest } ss.

History of original corner establishment:

Aspen 10 N60W 20 Lks.
Aspen 10 S35W 16 Lks.

I Thomas R. Arnott, do hereby certify that on the 21 st day of January, 1976, I found evidence of the M.C. corner of sections 3 & 34 West side Lake Lucerne Township 35 & 36, North, Range 13 E, Fourth Principal Meridian,


as described hereon; and that from this evidence I established a new monument and accessories as described hereon to perpetuate the original location of this corner.

Description of corner evidence found:

2" iron pipe 5' long with brass cap set by C.E. Walker in 1938

Resident witnesses:

.....
.....
.....

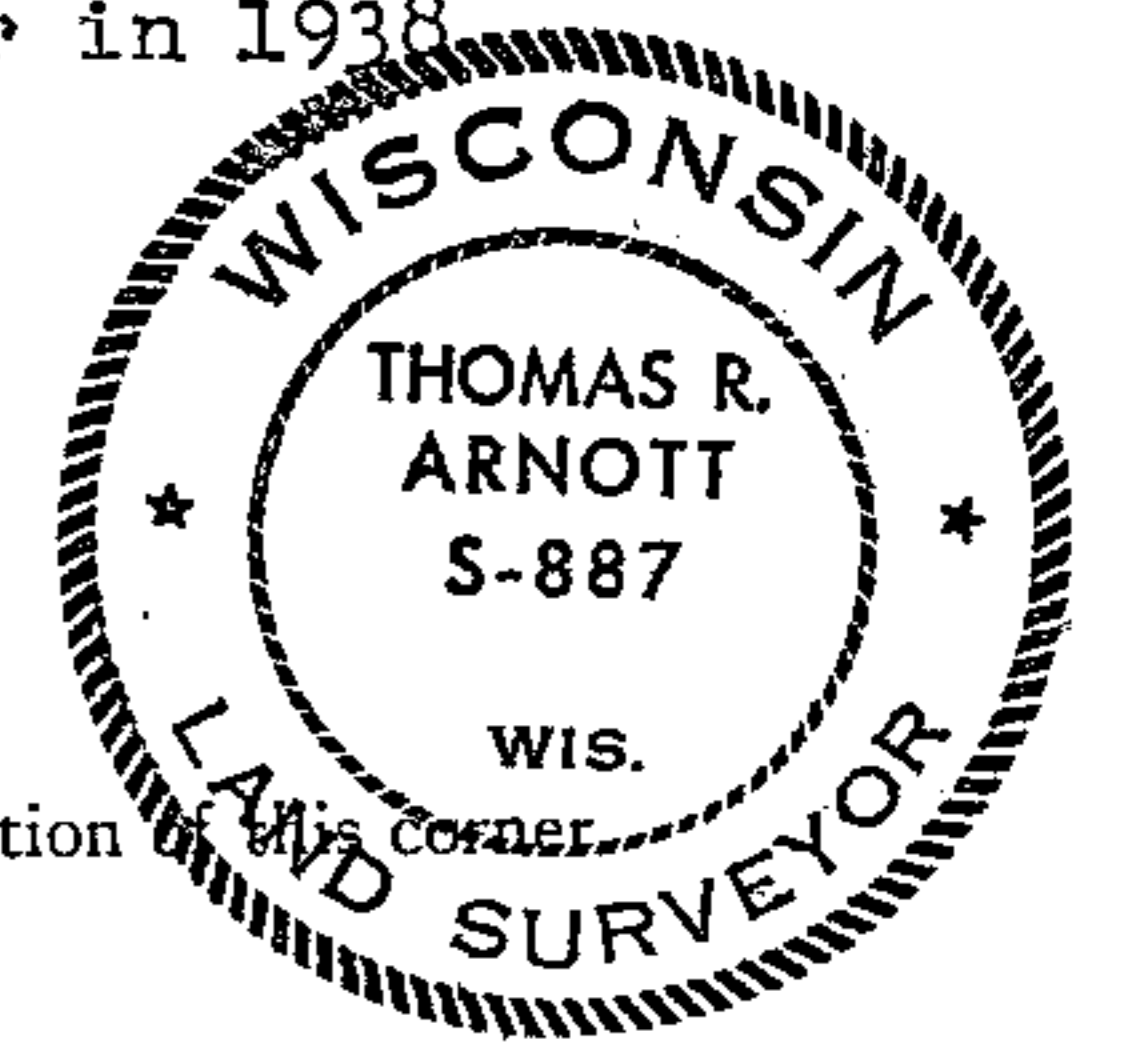

43613340022


Description of monument and accessories I established to perpetuate the original location of this corner:

Left monument set by Walker

Ties:

Cedar 8 N77E 8.34 feet (lawn tree, no BT blaze)
Hemlock 8 S15W 20.43 feet
Maple 8 S53W 12.55 feet

FORM 985 H. C. MILLER CO., MILWAUKEE

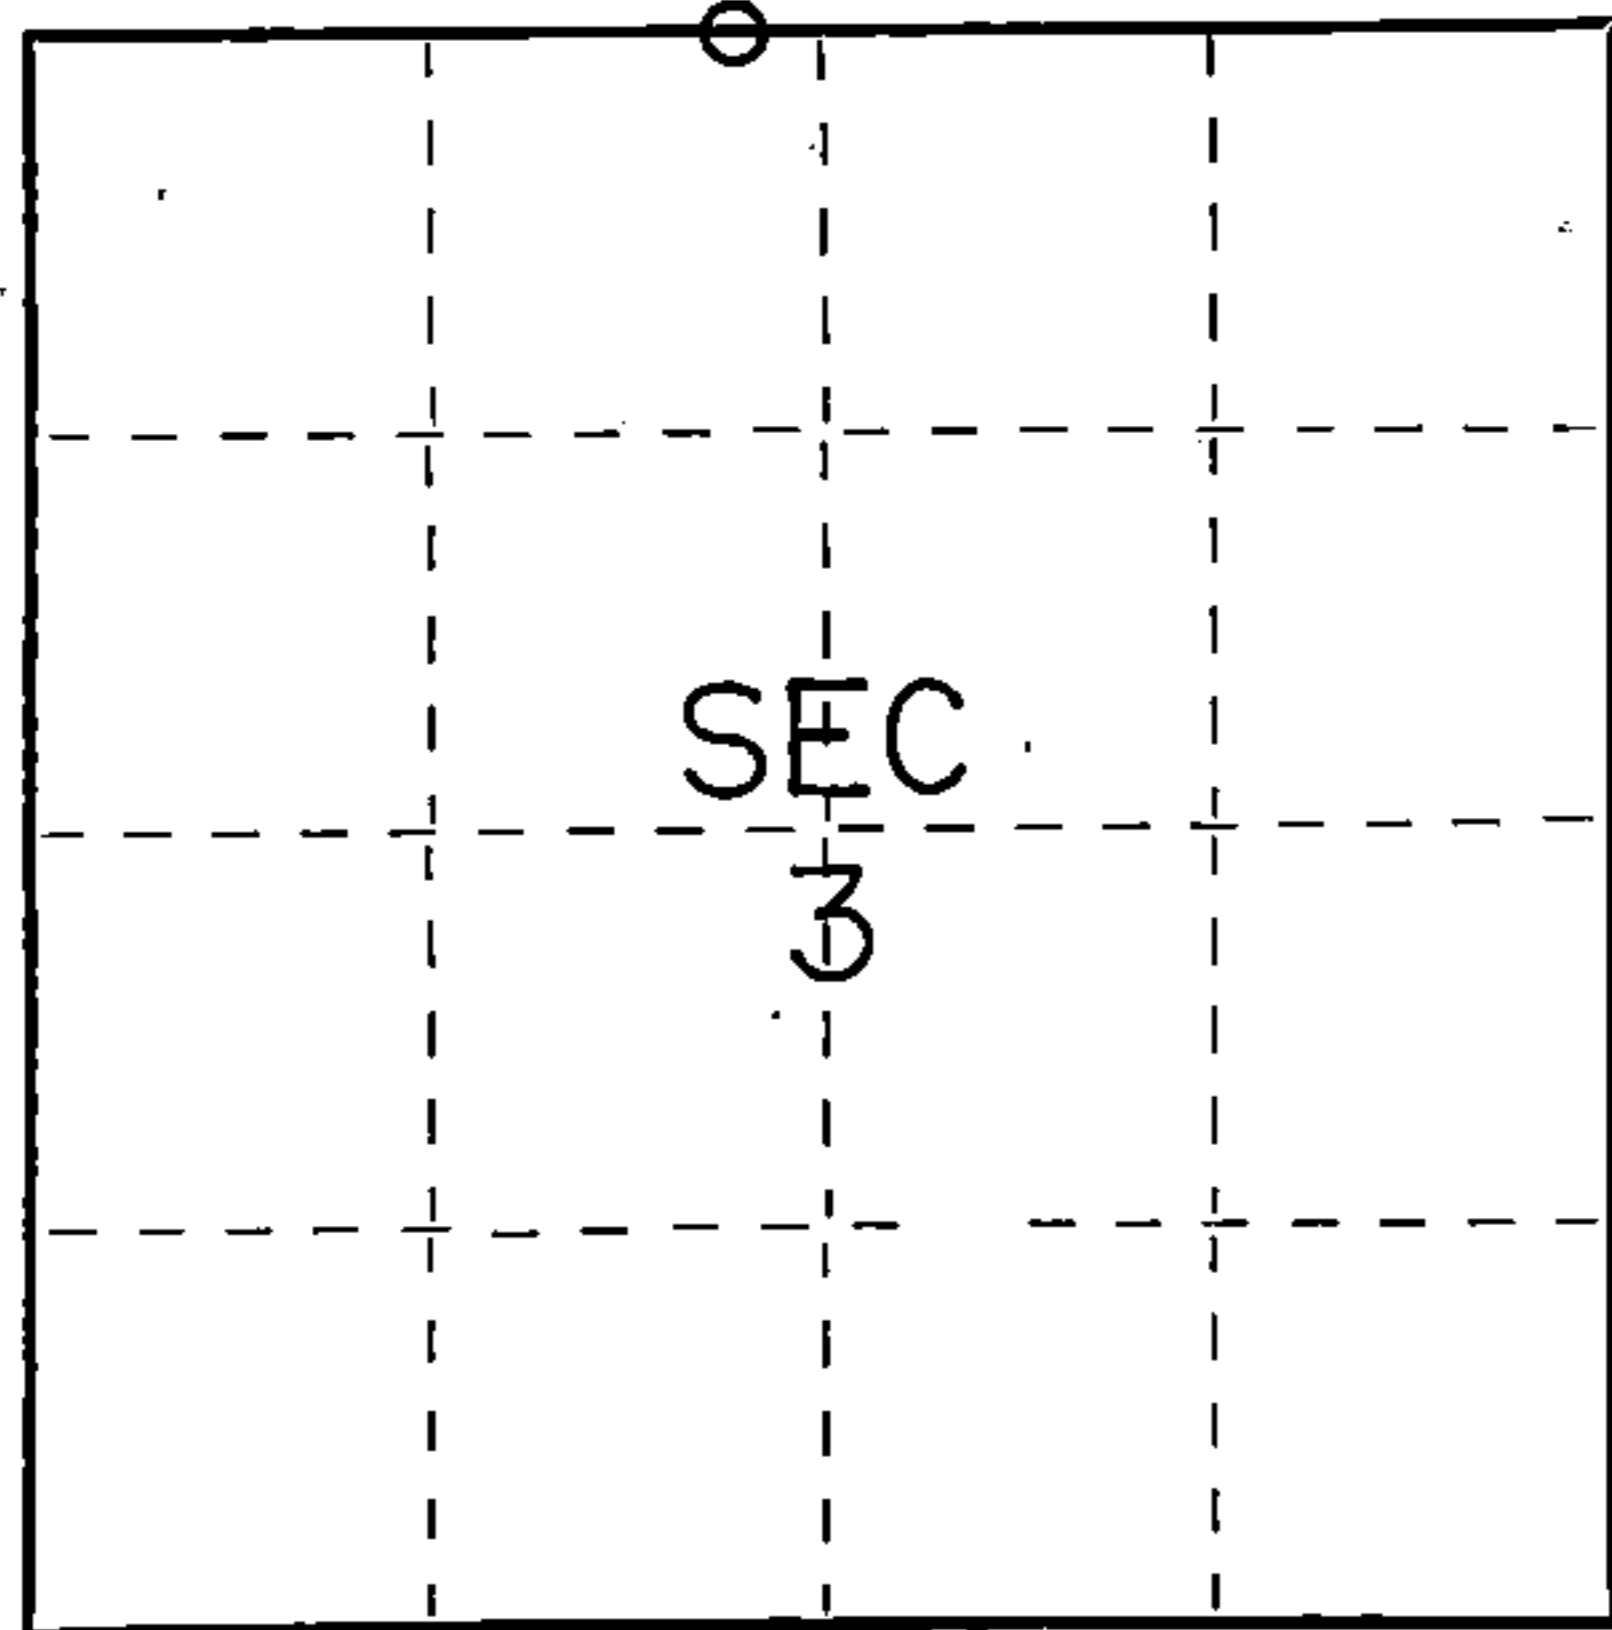

○ = Corner monument restored.

Dated at Crandon, Wis., this 26th day of January, 1976.

Signature Thomas Arnott Title Surveyor Registration No. S-887
(County Surveyor, Registered Land Surveyor, or other duly authorized official)

Office of Register of Deeds, County of Forest, I hereby certify that the within instrument was filed in this office for record on the 26th day of January, 1976 at 11 o'clock A.M.

Eugene Stegny Document Number 108647
(Register of Deeds)

By..... Deputy