

CERTIFIED LAND CORNER RESTORATION

State of Wisconsin }
County of Forest } ss.

I, Jean F. Resvick, do hereby certify that on the 27 day of April, 1977, I found evidence of the Northwest corner of Section 14 Township 36 North, Range 14 East, Fourth Principal Meridian, as described hereon; and that from this evidence I established a new monument and accessories as described hereon to perpetuate the original location of this corner:

Description of original monument and accessories and subsequent restorations:



Surveyed by James McBride in 1859
80.00 chains North between Sections 14 & 15, set post, corner to Sections 10, 11, 14 & 15.
Tamarack, 16", N20°W, 24 lks.
Hemlock, 14", N68°E, 38 lks.
Birch, 12", S38°E, 22 lks.
Tamarack, 14", S40°W, 30 lks.

Description of corner evidence found:

4"x4"x2' fallen top of post with angle iron 1 1/8" x 1 1/8" x 4 1/2' long along side post point.
Tamarack stump and fallen tree N20°W, 24 lks., very decayed.
Hemlock stump, N68°E, 38 lks., very decayed
Birch remains, stump rotted beyond identification, S38E, 22 lks.
Tamarack snag, 12' high, S40°W, 30 lks., scribing present.

Description of monument and accessories I established to perpetuate the location of this corner:

Replaced post point and angle iron, which was at proper location from original bearing tree remains, with a 2" inside diameter, 5 foot long, filled with concrete, galvanized iron pipe, capped with a 3" brass cap stamped T36N, R14E, S10, S11, S14, S15, 1977, S-802.
Blazed and scribed the following new bearing trees:
Hemlock 8", bears N61°E, 35.00 ft.
Hemlock 14", bears S20°E, 22.06 ft.
White pine 6", Bears S60°W, 33.38 ft.
Set sign post 0.50 ft. East of monument

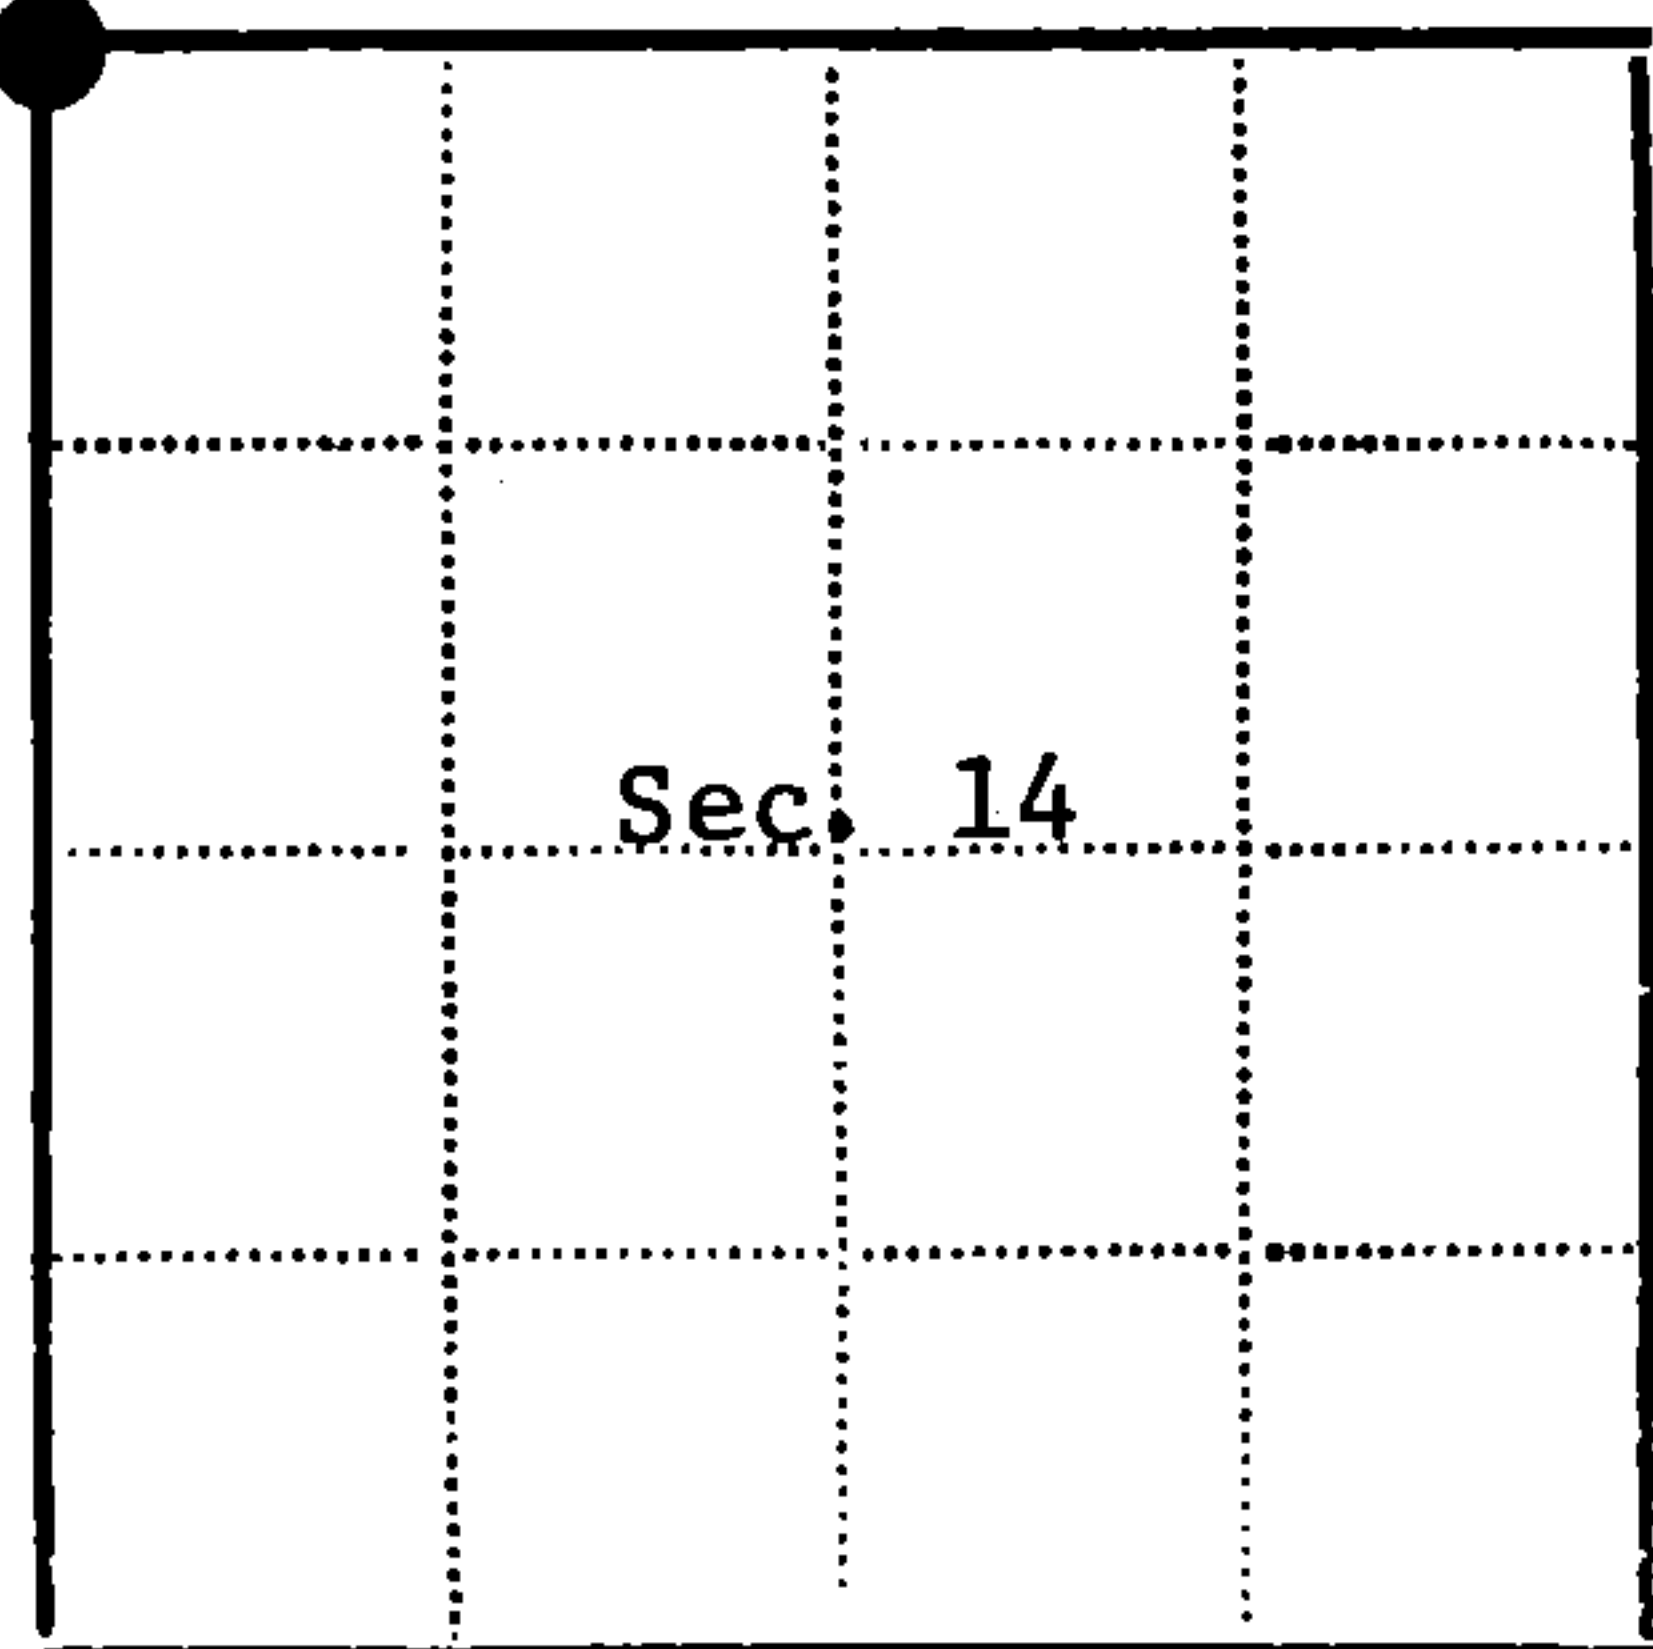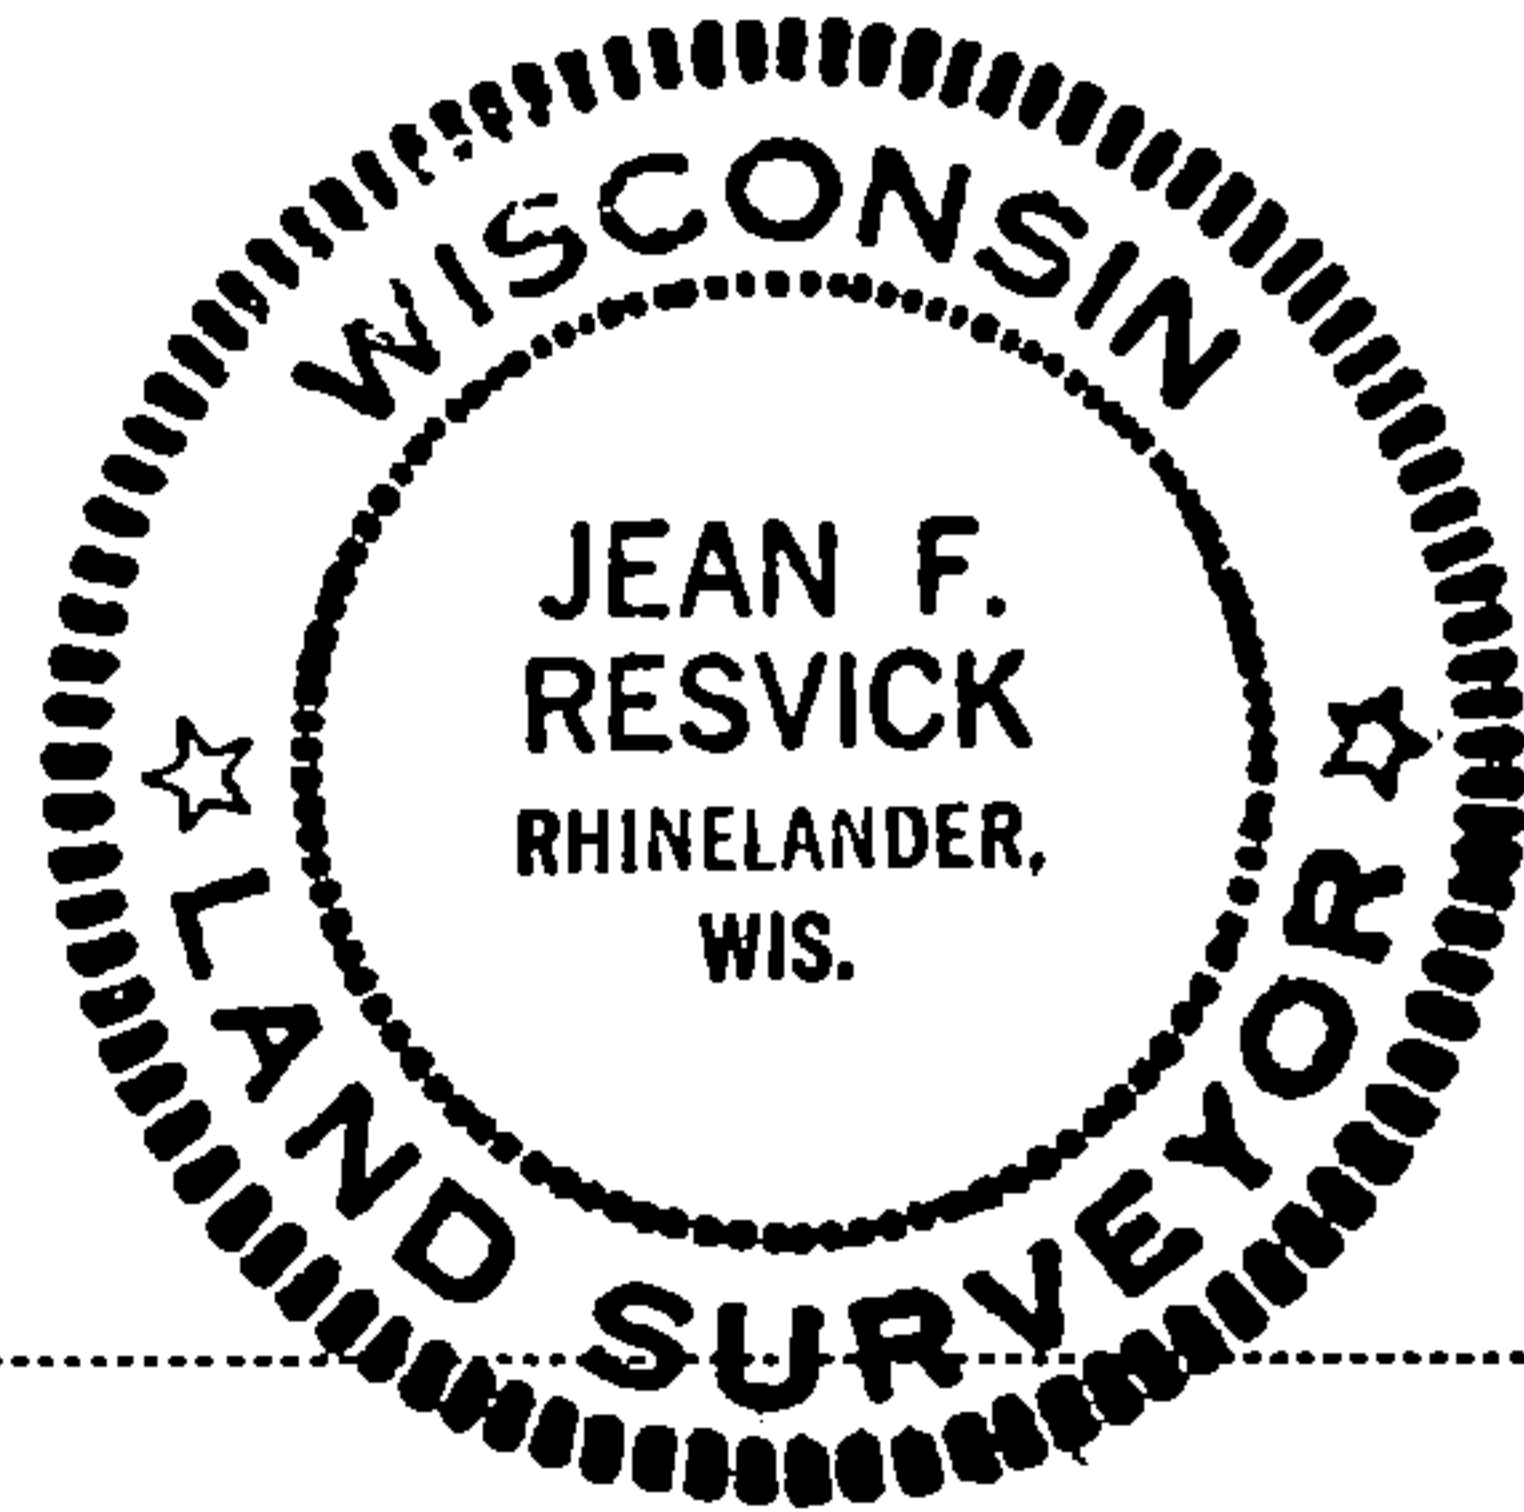

● - Corner monument restored
□ -

Resident witnesses _____

Dated at Rhinelander Wisconsin, this 13 day of May 1977.

Signature *Jean F. Resvick* Title Land Surveyor
(County Surveyor, Registered Land Surveyor, or other duly authorized official)

Surveyors Registration No. S-802 DOCUMENT NUMBER -111736

Office of Register of Deeds County of Forest

I hereby certify that the within instrument was filed in this office for record on the 27th day of June 1977, and was filed in Book No. _____ Page No. _____ of County Records.

Signature *Eugene Stutzman* Title Register of Deeds

Township 36 North, Range 14 East, Section 14, Index No. J-17, Page No. _____

317