

CERTIFIED LAND CORNER RESTORATION

State of Wisconsin }  
County of Forest } ss.

I Milo E. Stefan, do hereby certify that on the 21 day of October, 19 80, I found evidence of the East Quarter corner of Section 12 Township 36 North, Range 14 and 15 East, Fourth Principal Meridian, as described hereon; and that from this evidence I established a new monument and accessories as described hereon to perpetuate the original location of this corner:

Description of original monument and accessories and subsequent restorations:

Surveyed by Alfred Curtis in 1858.  
Set Post.  
Spruce 9", S65°E, 14 lks.  
Spruce 14", N36°W, 20 lks.

Description of corner evidence found:

Blazed line north to plantation edge.  
Swamp edge 3.5 chains north.  
Spruce Stump, S65°E, 9.3'  
Spruce Stump 18" - 20", N36°W, 13.2'


Description of monument and accessories I established to perpetuate the location of this corner:

At corner position set a 2 inch by 5 foot aluminum pipe with cap stamped:  
T36N, R14E, R15E, 1/4, S12, S7, 1980, R.L.S. 1558

From which the following bear:

Cedar 6", N77°E, 19.97'  
B. Spruce 6", S11°E, 40.35'  
Tamarack 7", N29°W, 43.52'

DOCUMENT NO.  
**119866**

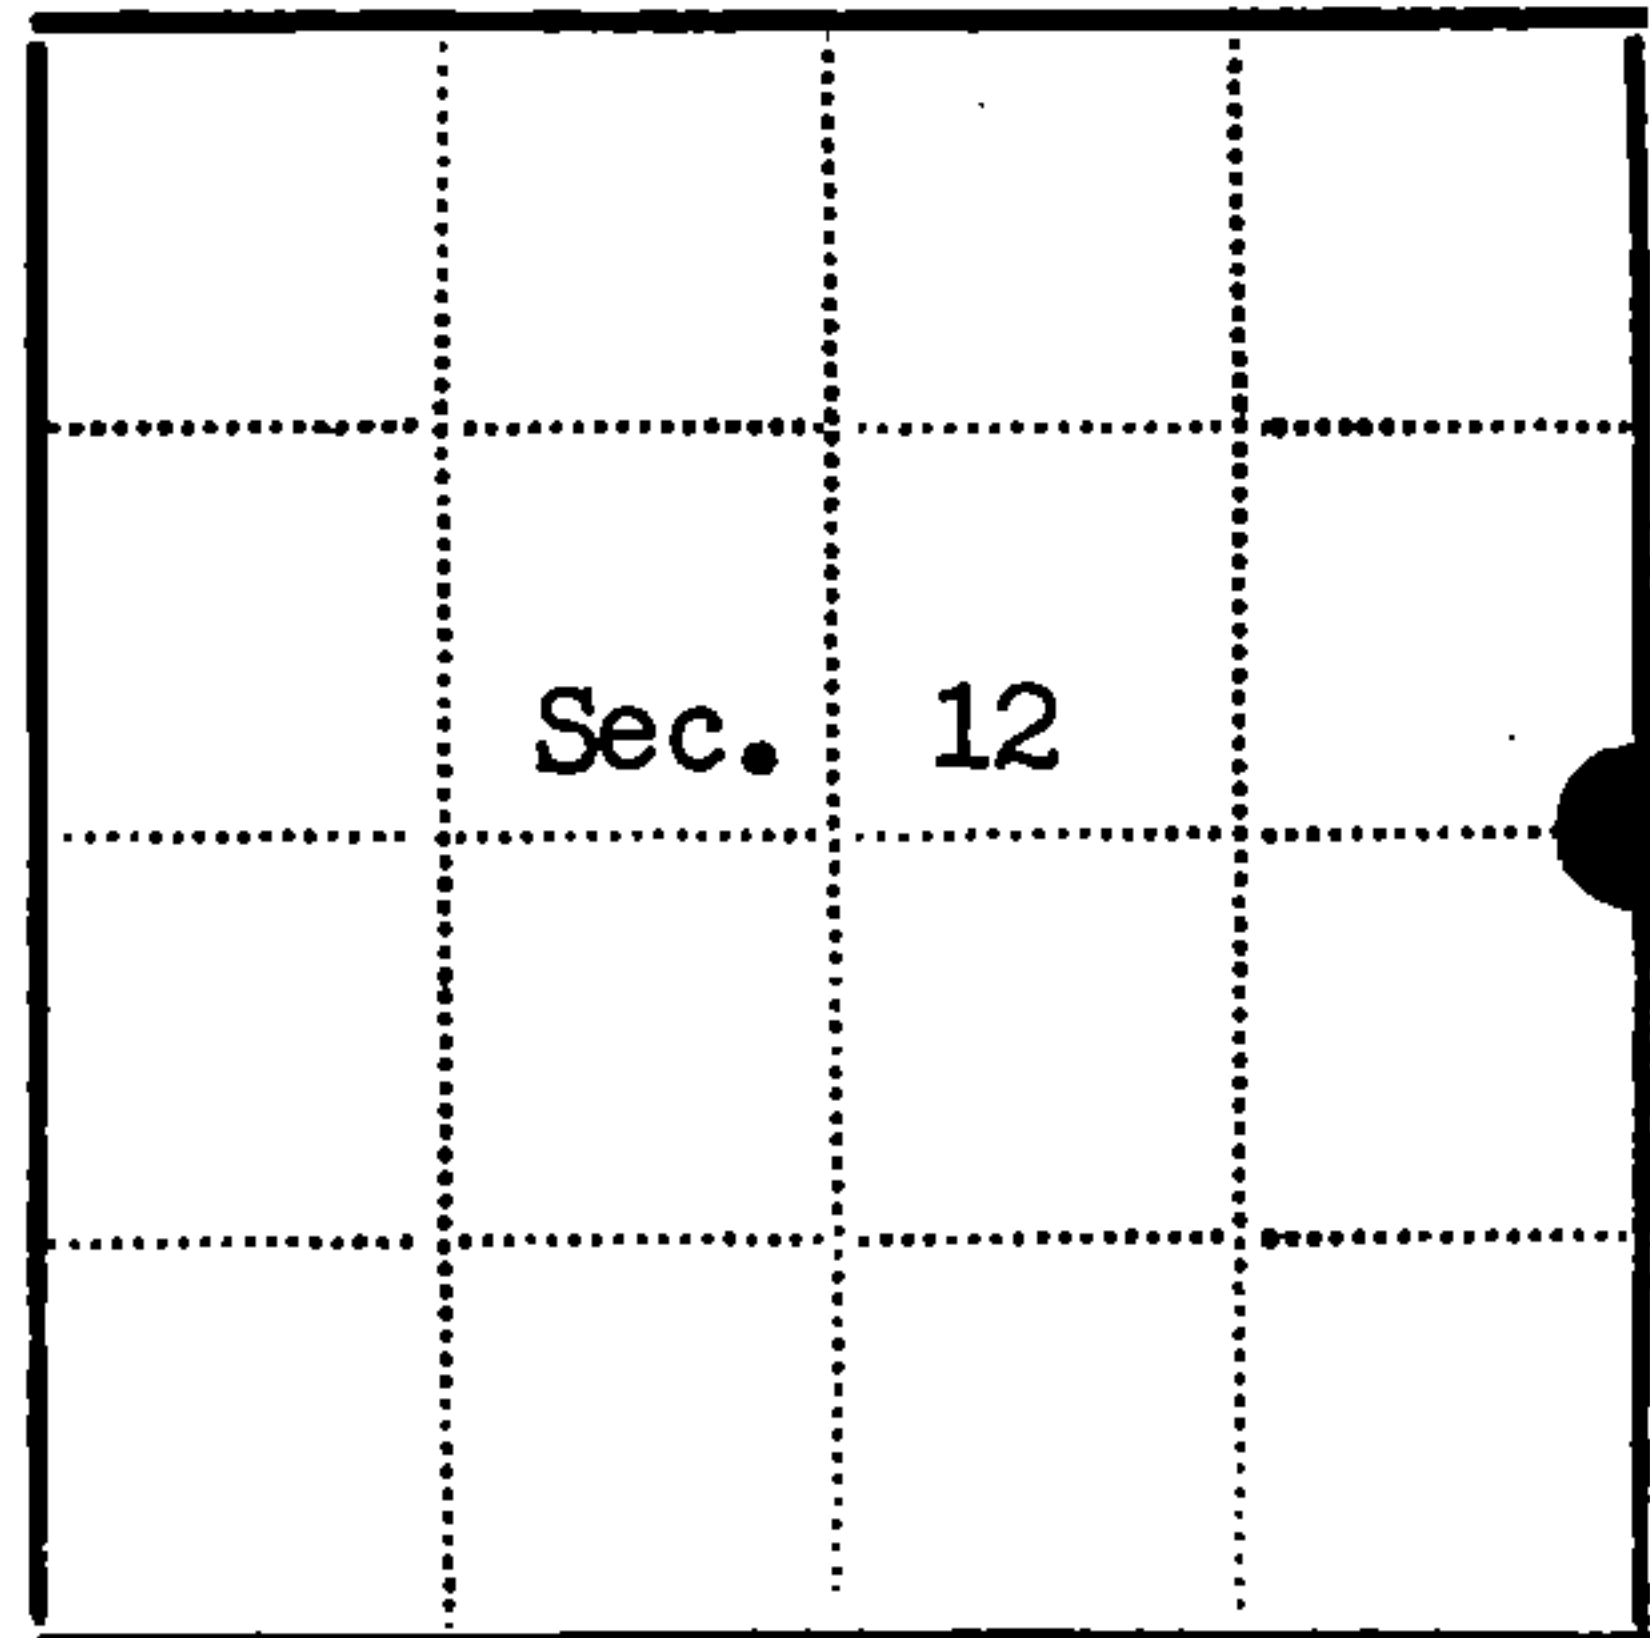

● - Corner monument restored  
□ -

Resident witnesses.....

Dated at Laona Wisconsin, this 3 day of November 19 80.

Signature *Milo E. Stefan* Title Land Surveyor  
(County Surveyor, Registered Land Surveyor, or other duly authorized official)

Surveyors Registration No. 1558

Office of Register of Deeds County of Forest

I hereby certify that the within instrument was filed in this office for record on the 2nd day of June 19 81, and was filed in Book No. Page No. of County Records.

Signature *Eugene Stutzman* Title Register of Deeds

Township 36N, Range 14E, Section 12, Index No. G-25, Page No.

CERTIFIED LAND CORNER RESTORATION

Index No. G-25

State of Wisconsin }  
County of Forest } ss.

I Gary L. Pisoni, do hereby certify that on the 12th day of August, 1995, I found evidence of the East Quarter corner of Section 12 Township 36, North, Range 14 East, Fourth Principal Meridian, as described hereon; and that from this evidence I established a new monument and accessories as described hereon to perpetuate the original location of this corner.

Resident witnesses:

.....  
.....  
.....

History of original corner establishment:

Original Government Survey in 1857 by Artemas Curtis. North between Sections 12 and 7 at 40.00 chains, set Quarter Section post from which the following bear: Spruce, 9", S 65°E, 14 lks; Spruce, 14", N 36°W, 20 lks.

In 1980, Milo E. Stefan, RLS with the U.S. Forest Service, restored the corner position from found original bearing tree stumps. Set a 2" dia. aluminum pipe monument with an aluminum cap from which the following bear:

Cedar	6"	N 77°E	19.97 feet	Black Spruce	6"	S 11°E	40.35 feet
Tamarack	7"	N 29°W	43.52 feet				

Description of corner evidence found:


Found the monument and bearing trees as described above:

Cedar	6"	N 77°E	19.97 feet
Black Spruce	6"	S 11°E	40.35 feet
Tamarack	7"	N 29°W	43.52 feet

Description of monument and accessories I established to perpetuate the original location of this corner.

Set an additional assessorry at the corner postion:

Steel sign post	S 35°W	0.80 feet
-----------------	--------	-----------

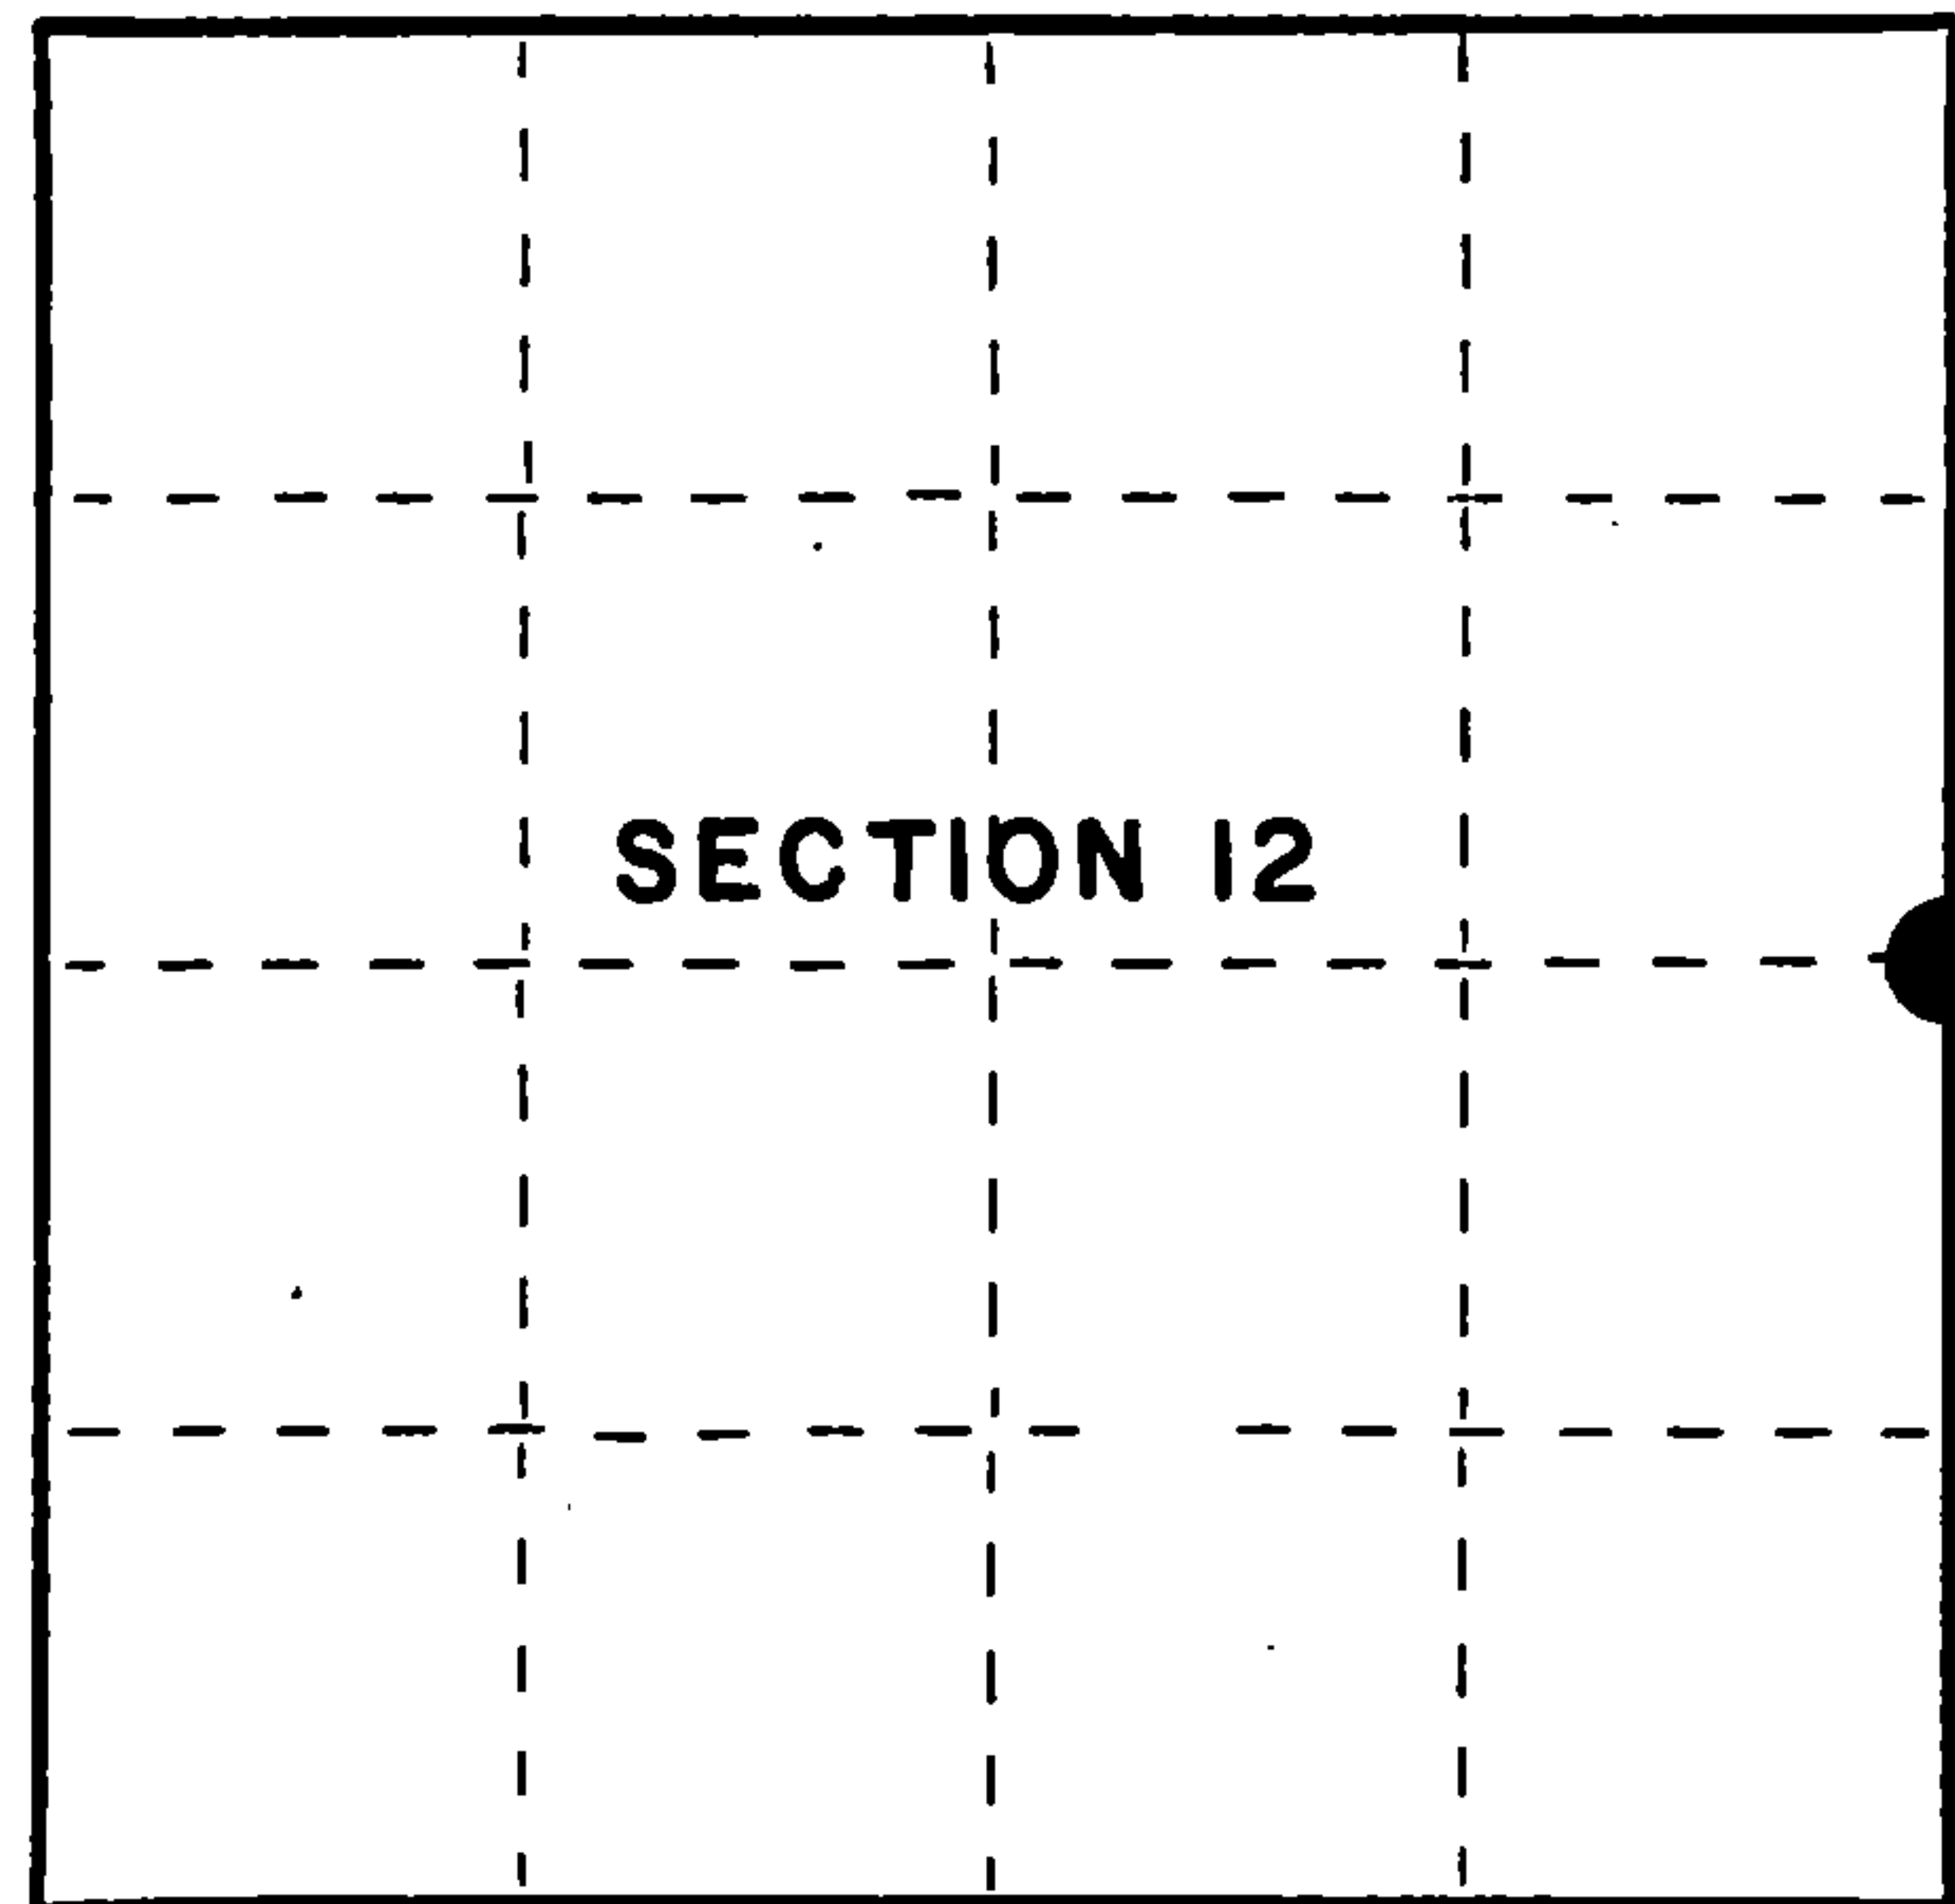

● = Corner monument restored.

Dated at Iron River, MI, this 12th day of June, 1995

Signature Gary L. Pisoni Title Land Surveyor Registration No. S-1634  
(County Surveyor, Registered Land Surveyor, or other duly authorized official)

Office of Register of Deeds, County of Forest, I hereby certify that the within instrument was filed in this office for record on the 20th day of March, 1997 at 1:30 o'clock P M.

(Register of Deeds)

By [Signature] Deputy

FORM NO. 985-A



Stock No. 26273

158098

4301122000

