

CERTIFIED LAND CORNER RESTORATION

State of Wisconsin }  
County of Forest } ss.


I Philip T. Hansen, do hereby certify that on the 12th day of January, 1976, I found evidence of the WC-1/16 corner of Section 15 Township 36 North, Range 14 East, Fourth Principal Meridian, as described hereon; and that from this evidence I established a new monument and accessories as described hereon to perpetuate the original location of this corner.

Resident witnesses:


Glen Barker

Jim Claflin

Tom Jewell

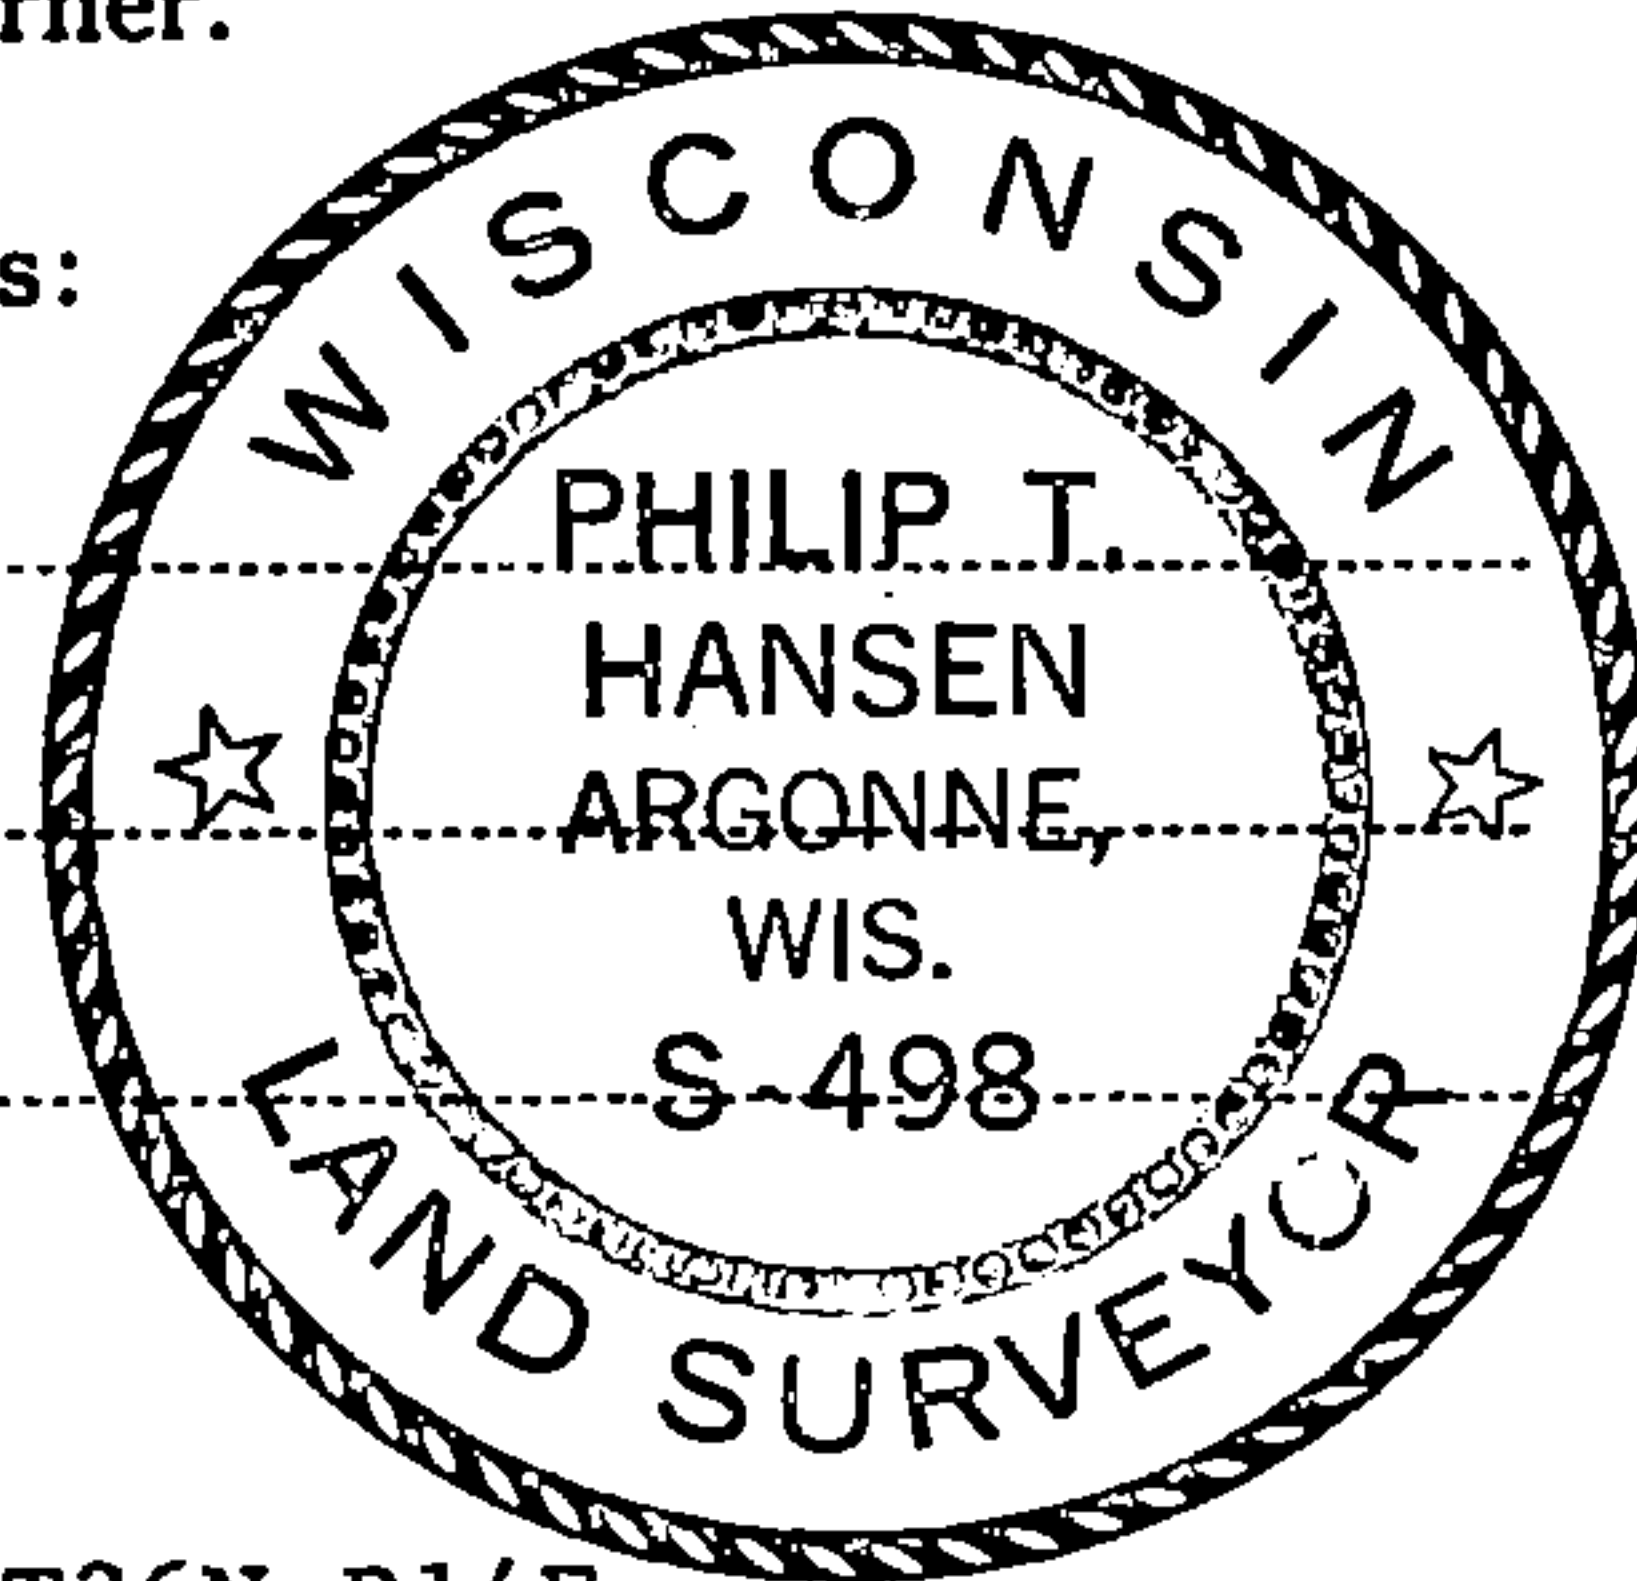

FORM 985 H. C. MILLER CO., MILWAUKEE

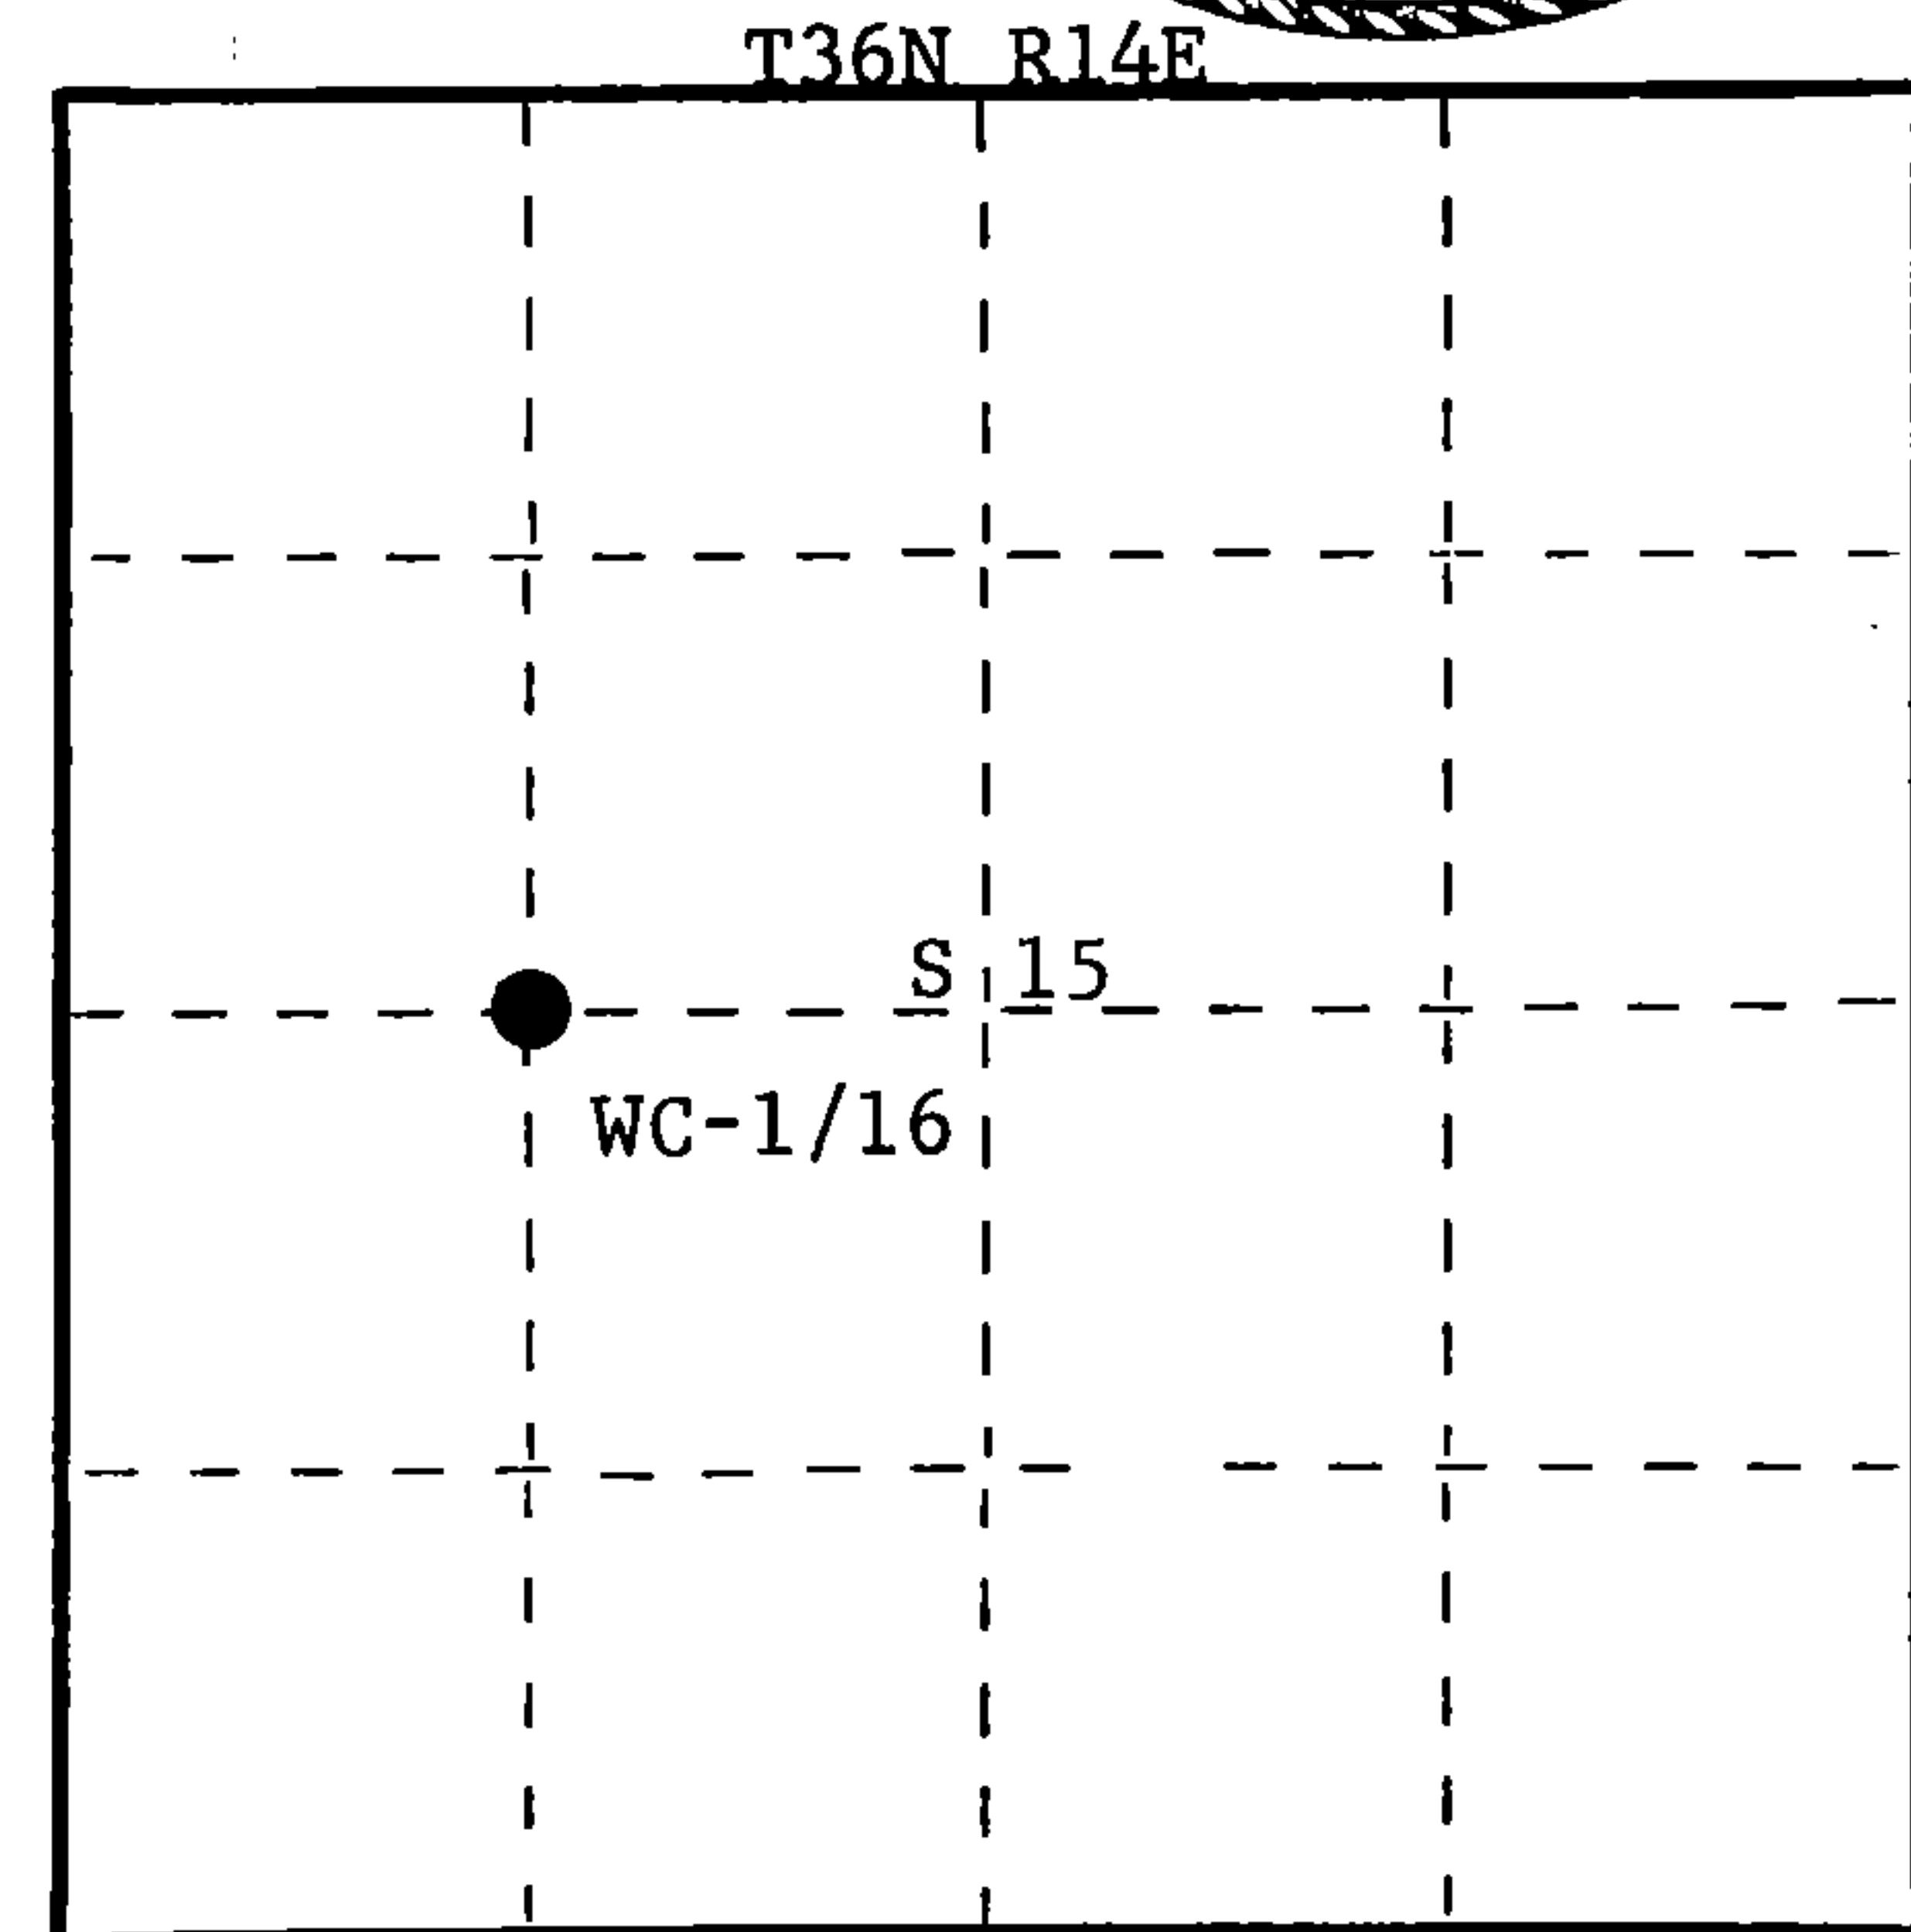

○ = Corner monument restored.

History of original corner establishment:

Origin of this corner unknown. No records on file in County Courthouse. Corner recovered and maintained by Ray Leigh, Consolidated forester, in 1949.

Description of corner evidence found:

Recovered 4" squared cedar post in poor condition. Also recovered a 2-1/2" iron pipe sitting beside it. No OBT's were in evidence.

Description of monument and accessories I established to perpetuate the original location of this corner.

Replaced 4" cedar post with 1-1/2" OD iron pipe with 2" brass cap stamped - S498  
Pipe projects 18" above ground. Placed old wood post and 2-1/2" iron T36N R14E  
pipe beside it.  
NBT's - Cedar 7" N20°W 24.8 links - scribed 1/16 BT WC-1/16 S 15  
Hemlock 12" N47°E 25 links - scribed 1/16 BT 1975  
Pipe, old post, and old pipe and BT's painted blue.

Dated at Argonne, Wis., this 19th day of January, 1976

Signature *Philip T. Hansen* Title Registered Land Surveyor Registration No. S-498  
(County Surveyor, Registered Land Surveyor, or other duly authorized official)

Office of Register of Deeds, County of Forest, I hereby certify that the within instrument was filed in this office for record on the 4th day of February, 1976 at 4:00 o'clock P. M.

*Eugene Staszynski*  
(Register of Deeds)

By Deputy

DOCUMENT NUMBER 108716

43614152030