

CERTIFIED LAND CORNER RESTORATION

Index No. **K 15**

State of Wisconsin }
County of Forest } ss.


I, Philip T. Hansen, do hereby certify that on the 12th day of January, 1976, I found evidence of the NC-1/16 corner of Section 15 Township 36 North, Range 14 East, Fourth Principal Meridian, as described hereon; and that from this evidence I established a new monument and accessories as described hereon to perpetuate the original location of this corner.

Resident witnesses:


Glen Barker

Jim Claflin

Tom Jewell

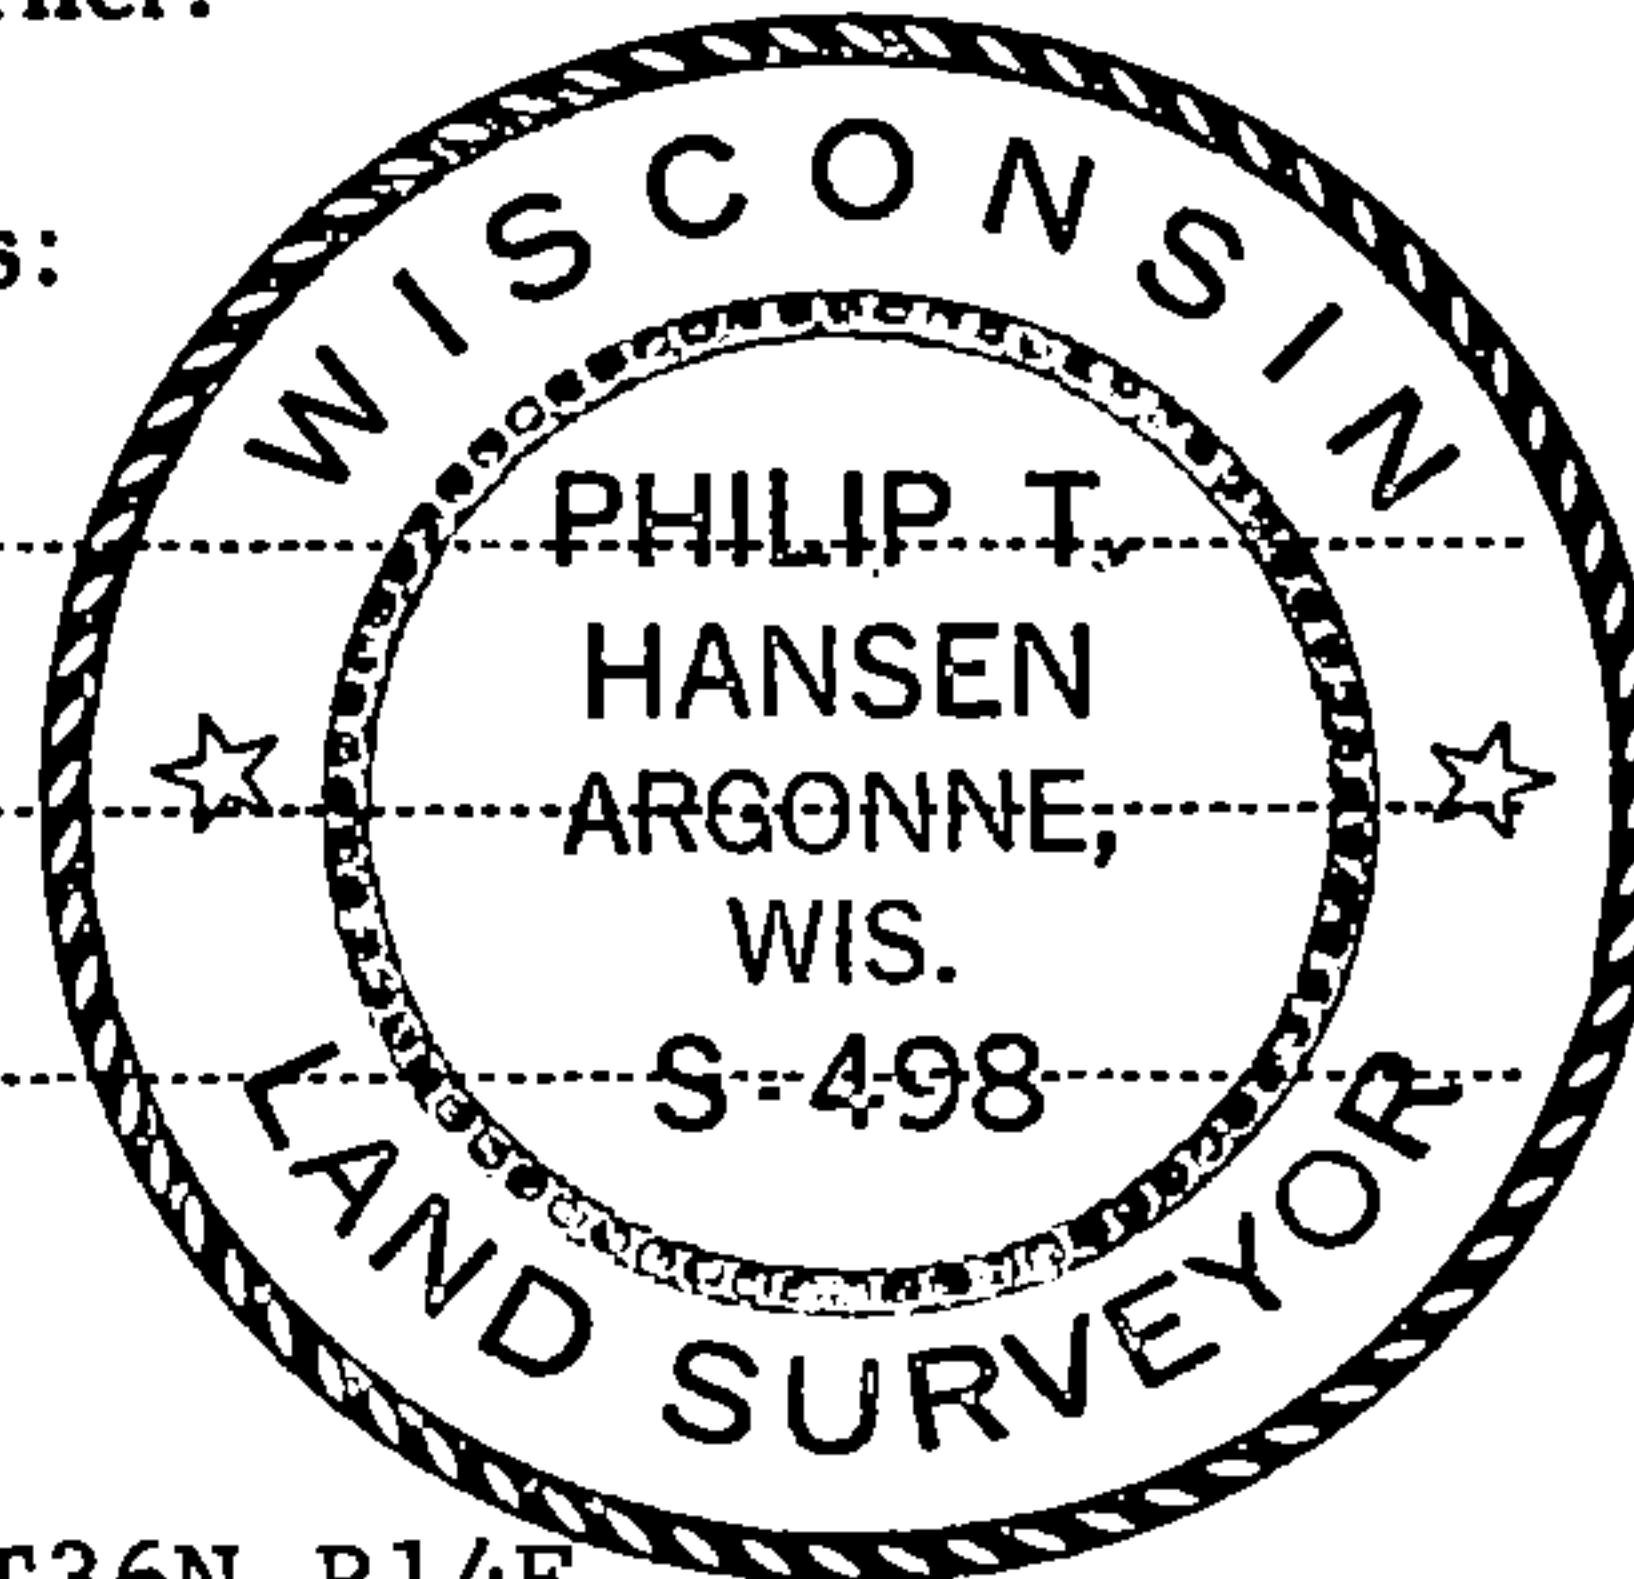

FORM 985 H. G. MILLER CO., MILWAUKEE

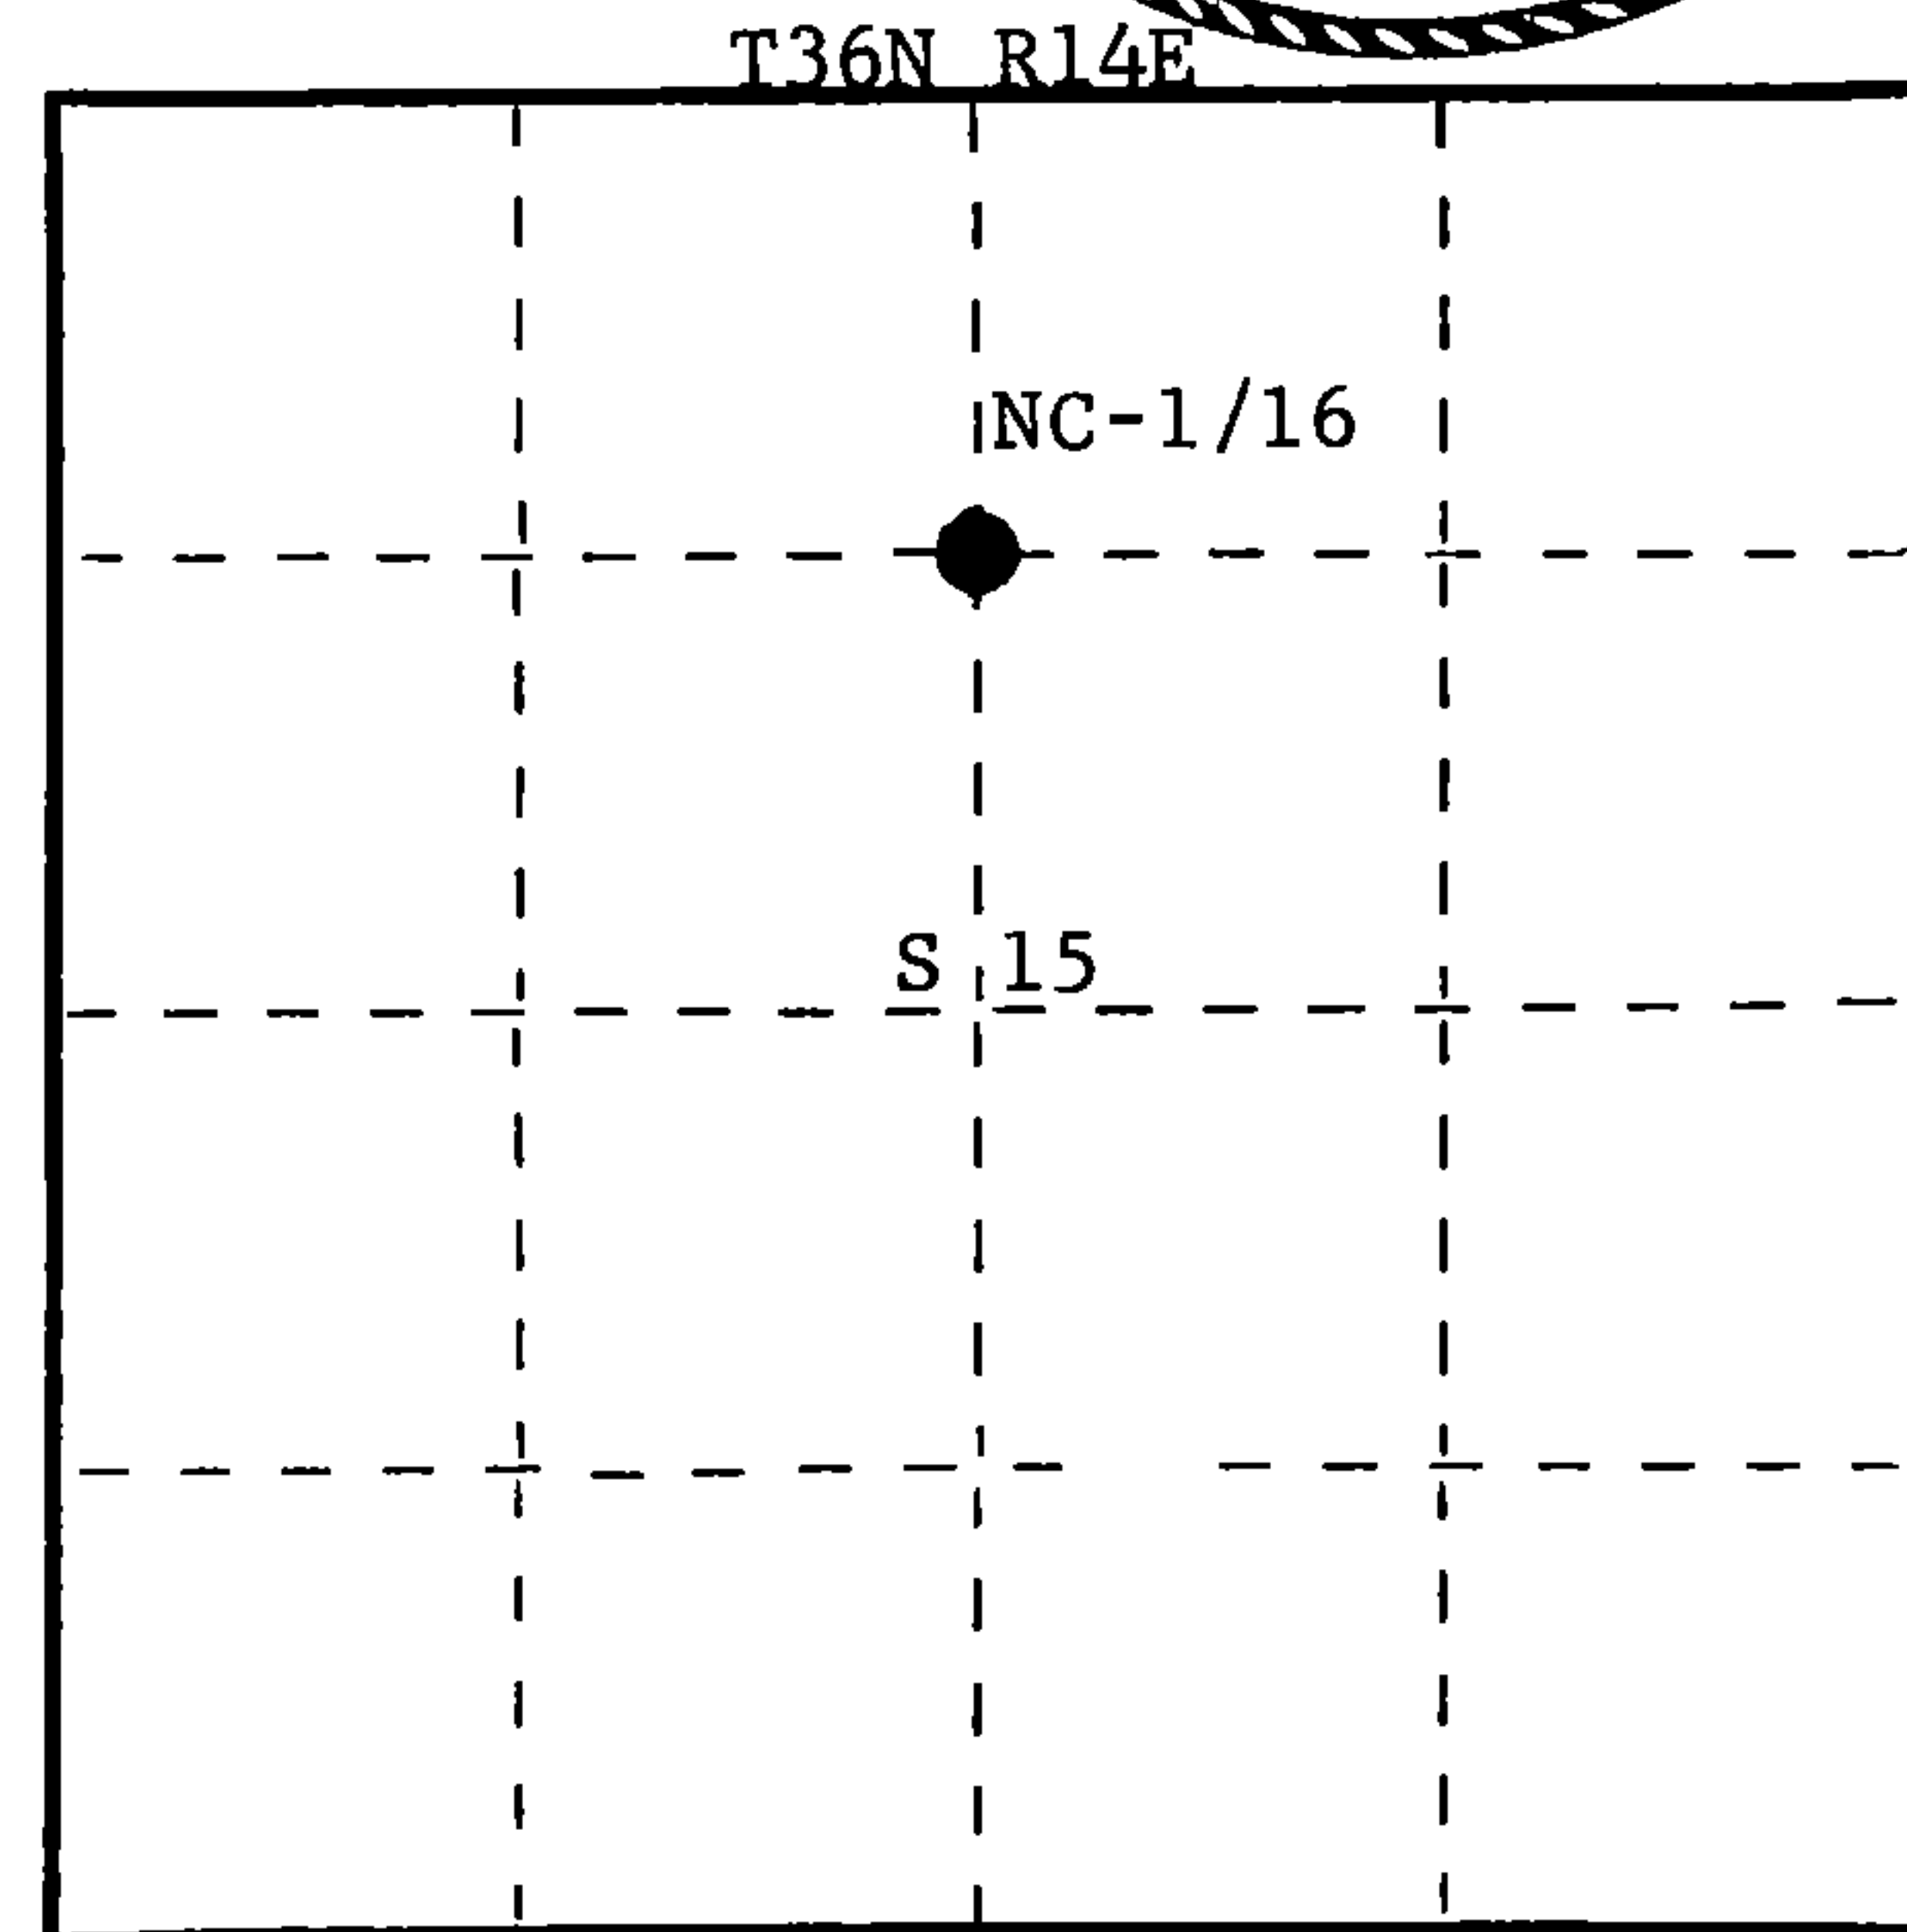

○ = Corner monument restored.

History of original corner establishment:

Origin of corner unknown. No records in Courthouse on file. Corner recovered by Consolidated foresters in 1949 while running N-S 1/4 line for cruising and mapping purposes.

Description of corner evidence found:

Recovered 3" iron pipe projecting 2' above ground. Recovered OBT - Cedar 14" S82°E 20.4 links - scribed 1/8 S BT.

Description of monument and accessories I established to perpetuate the original location of this corner.

Replaced 3" iron pipe with 1-1/2" OD iron pipe with brass cap stamped -

S498
T36N R14E

Pipe projects 18" above ground.

Placed old 3" iron pipe beside new pipe.

NBT - Cedar 7" N88°E 38 links - scribed 1/16 BT.

Pipes and BT's painted blue.

NC-1/16 S 15
1975

Dated at Argonne, Wis., this 19th day of January, 1976.

Signature *Philip T. Hansen* Title Registered Land Surveyor Registration No. S-498
(County Surveyor, Registered Land Surveyor, or other duly authorized official)

Office of Register of Deeds, County of Forest, I hereby certify that the within instrument was filed in this office for record on the 4th day of February, 1976 at 4:00 o'clock P. M.

Eugene Staszny
(Register of Deeds)

By Deputy

DOCUMENT NUMBER **108713**

43014153020