

CERTIFIED LAND CORNER RESTORATION


Index No. **K 13**

State of Wisconsin }
County of Forest } ss.


I Philip T. Hansen, do hereby certify that on the 13th day of January, 1976, I found evidence of the N-1/16 corner of Sections 15 and 16 Township 36, North, Range 14 East, Fourth Principal Meridian, as described hereon; and that from this evidence I established a new monument and accessories as described hereon to perpetuate the original location of this corner.

Resident witnesses:

Glen Barker
Jim Claflin
Tom Jewell

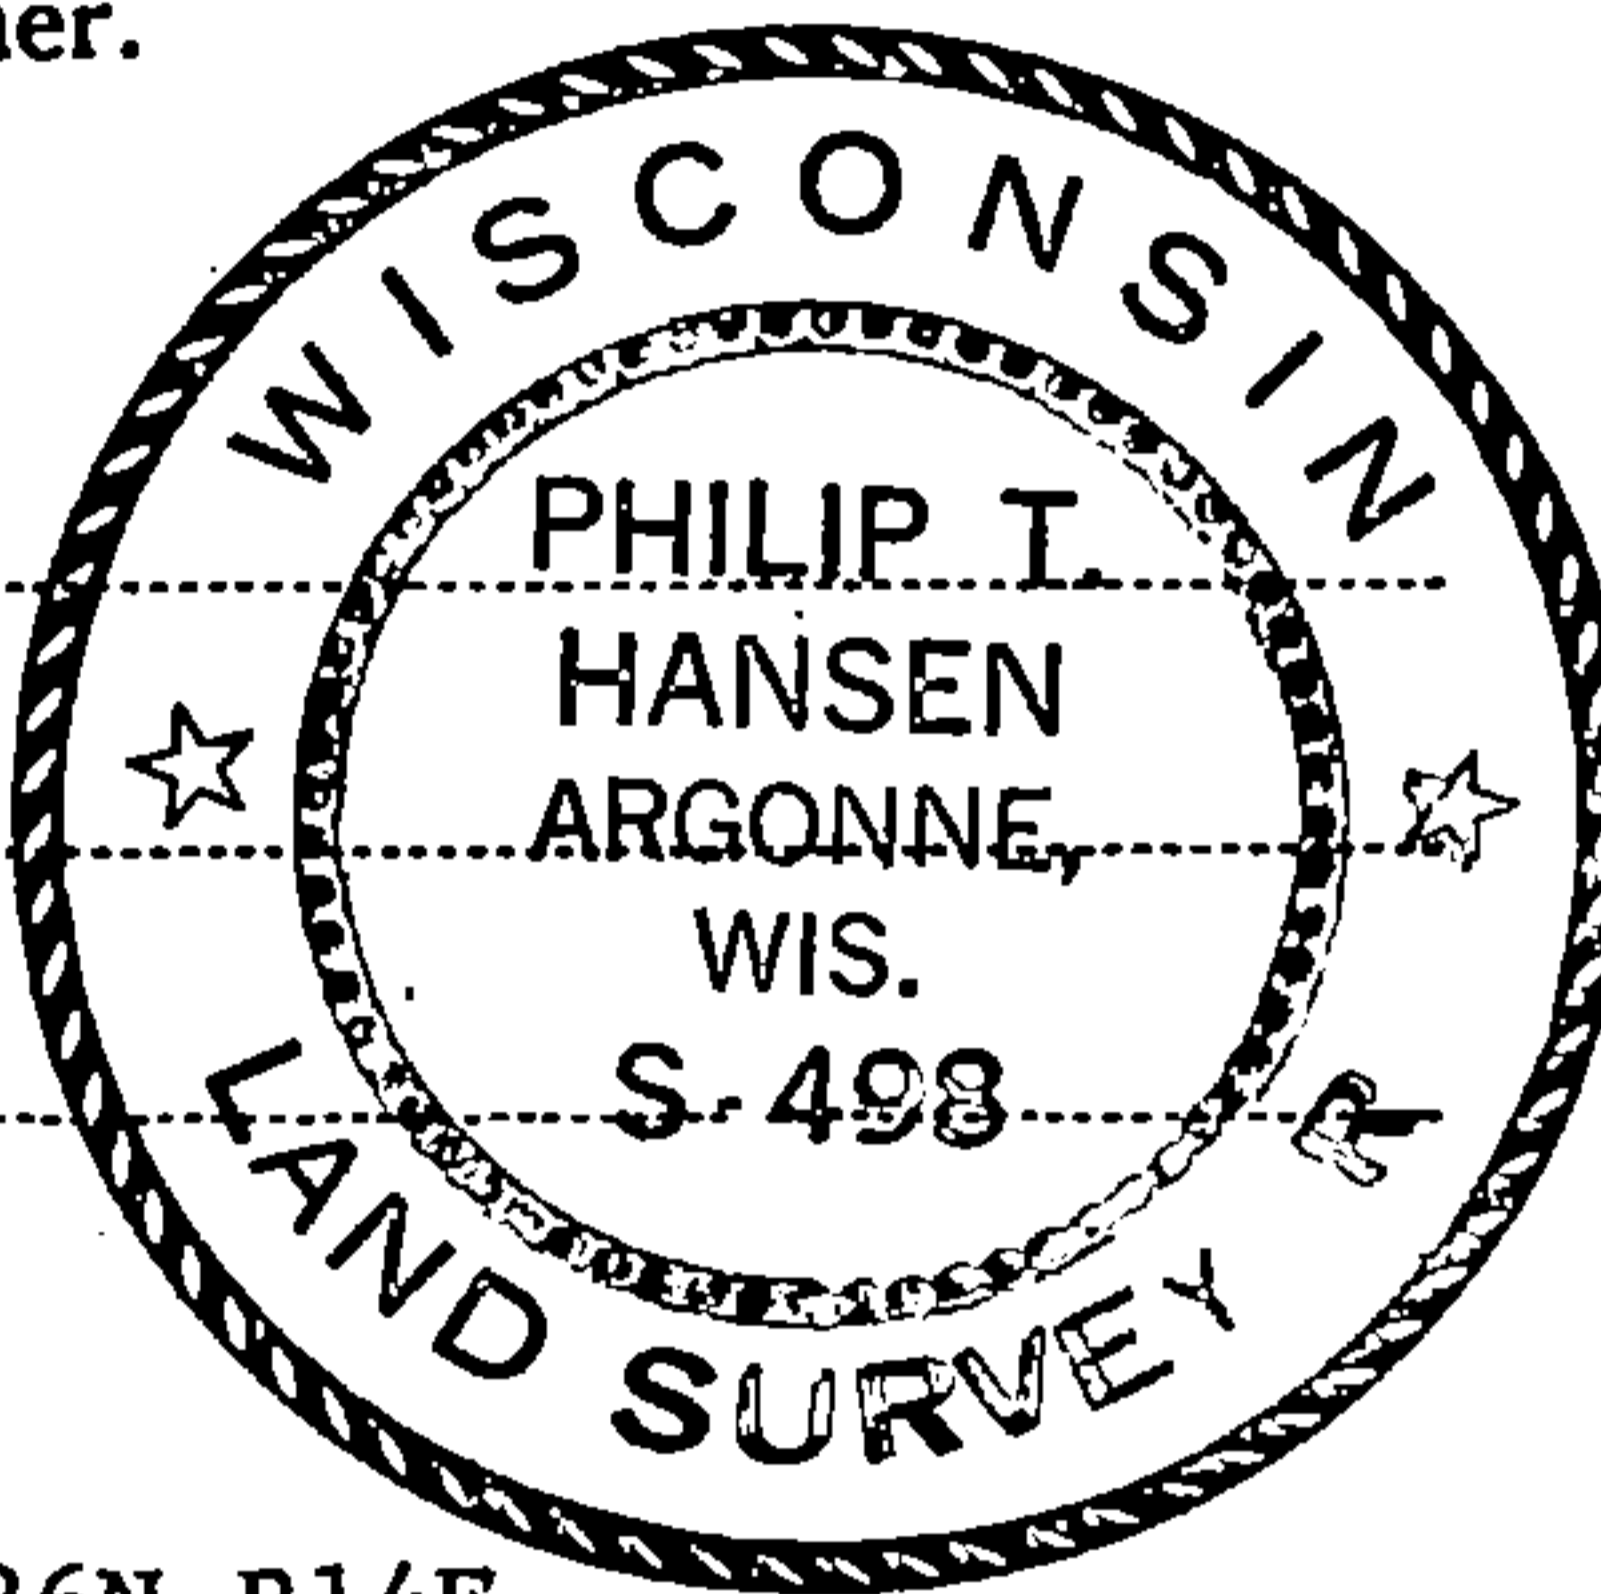

FORM 985 W. G. MILLER CO., MILWAUKEE

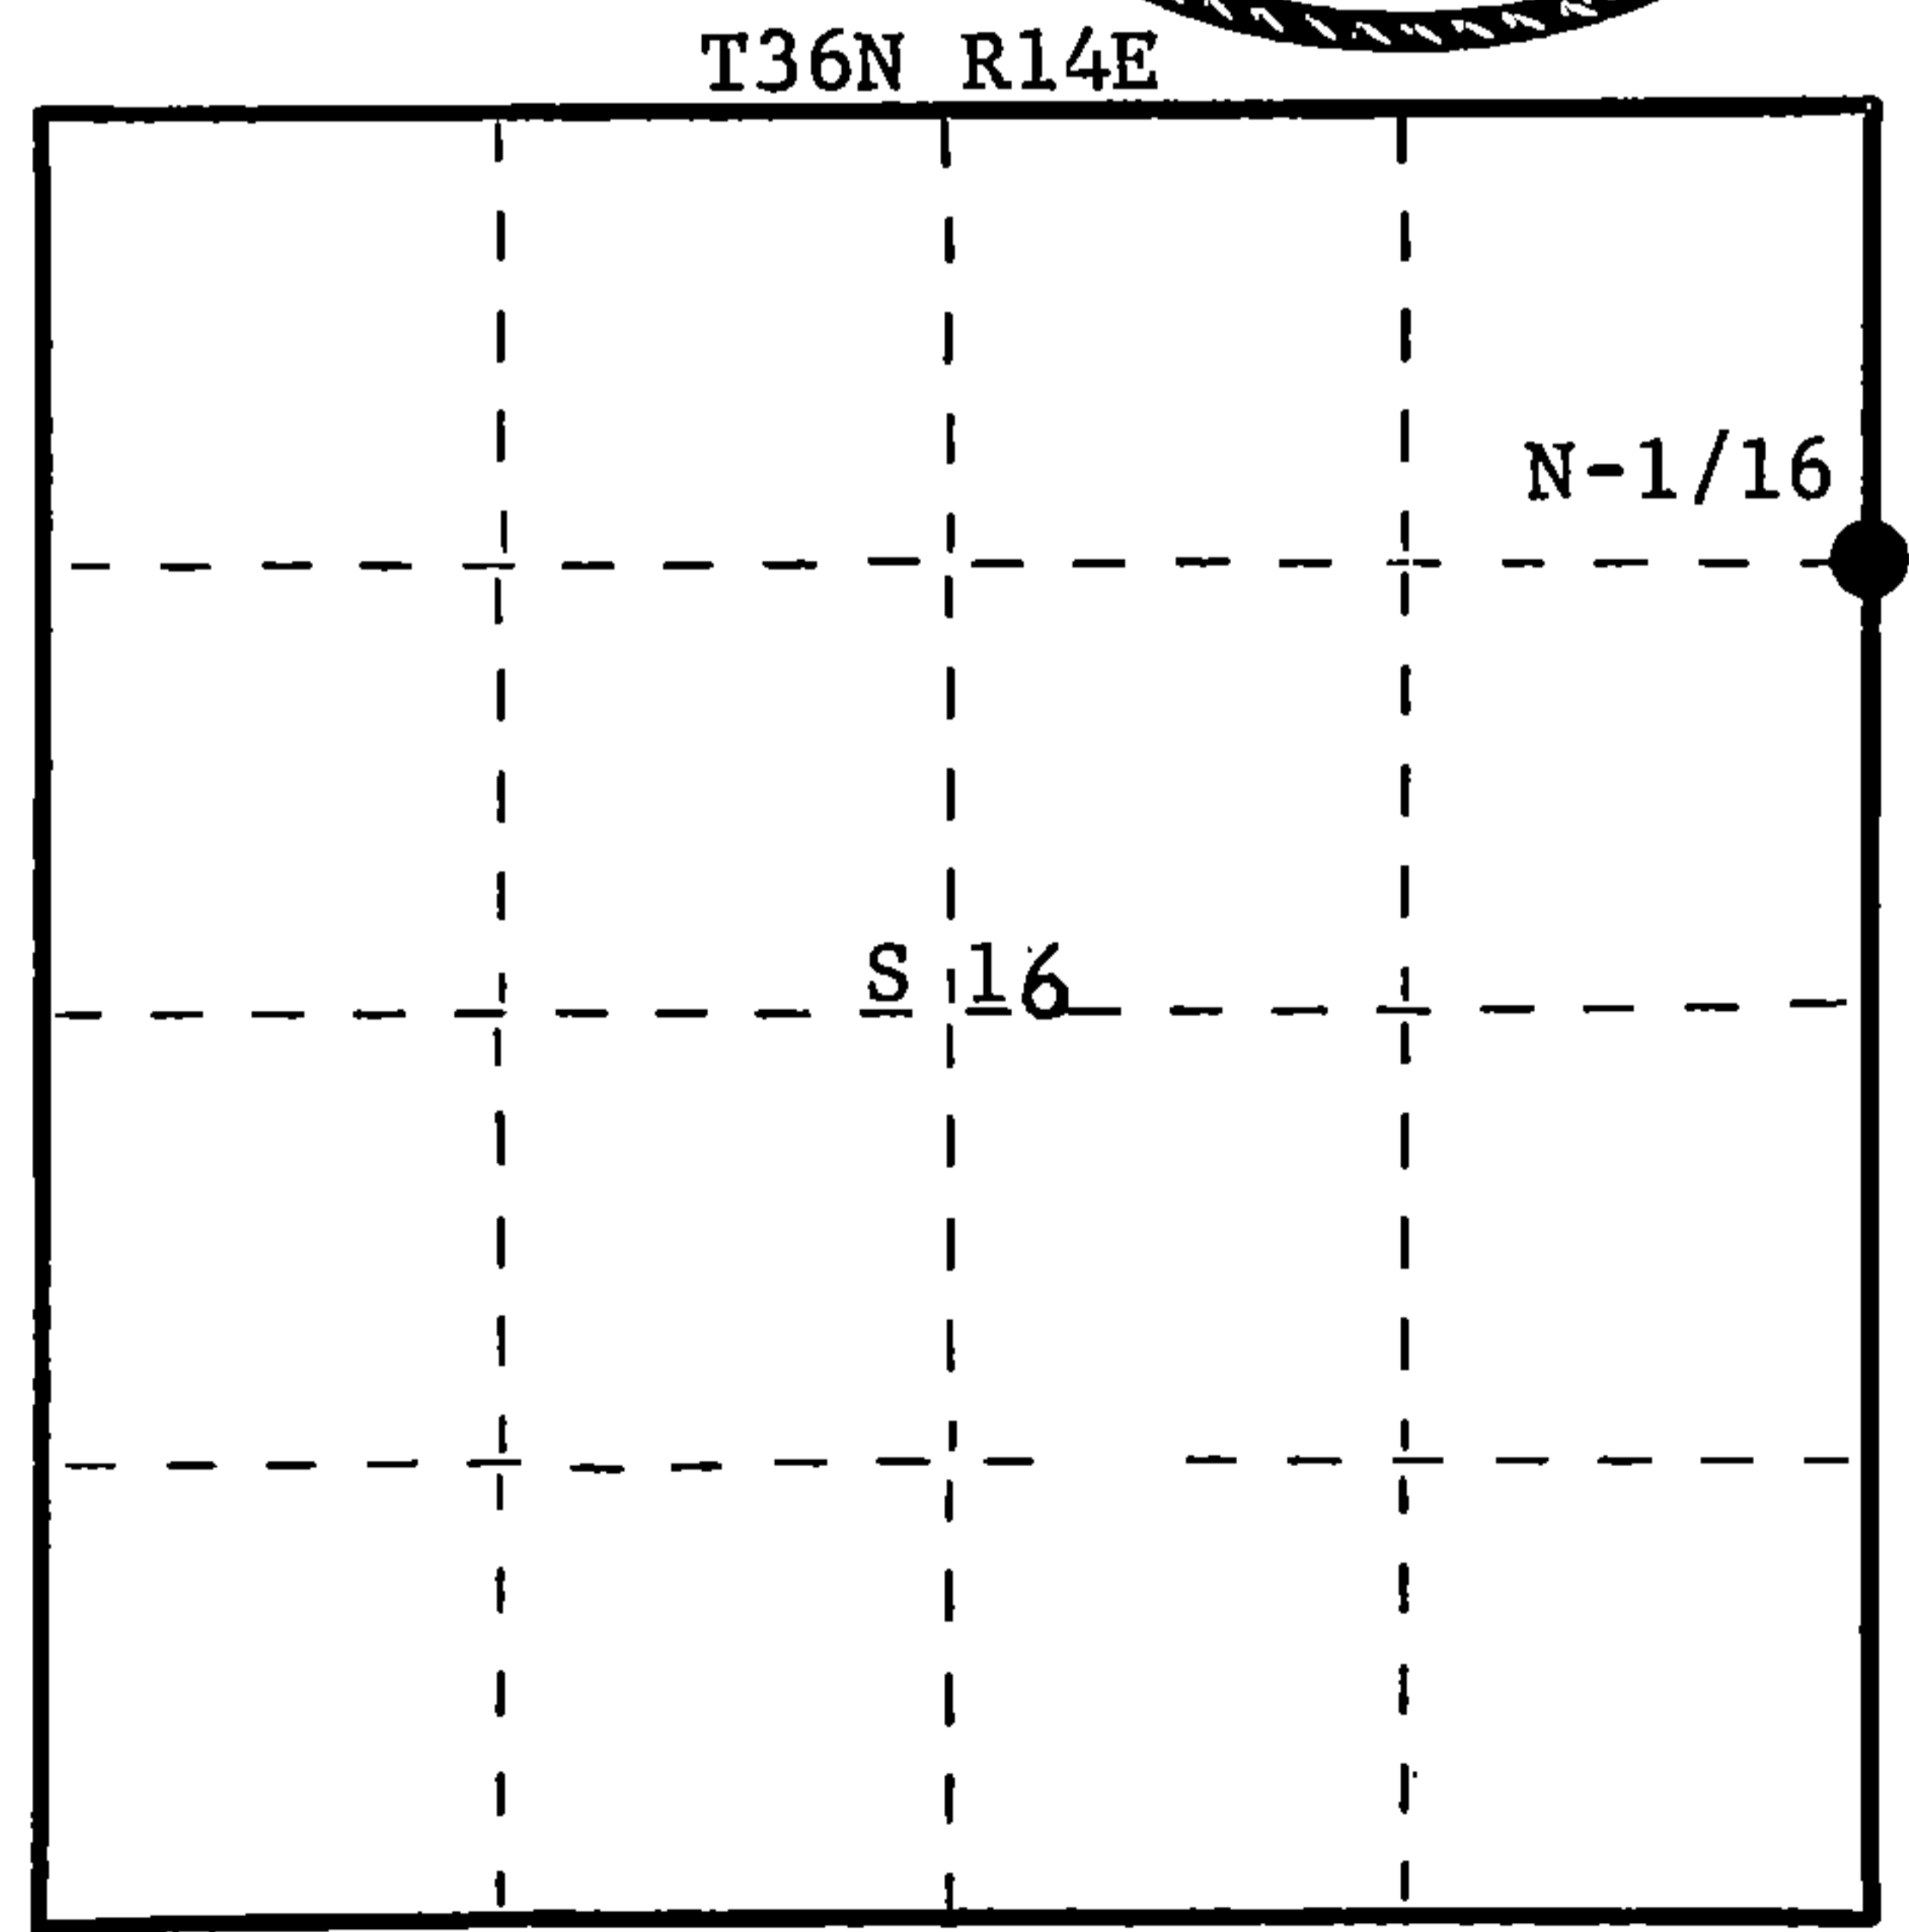

○ = Corner monument restored.

History of original corner establishment:
Origin of this corner unknown. No records on file in the County Courthouse. Corner recovered by Connor Forest Industries foresters, maintained by them. This corner accepted by Consolidated Papers, Inc. foresters as the corner since 1949.

Description of corner evidence found:
Recovered a 4" well casing projecting 3' above ground. Casing recovered in excellent condition.
No evidence of any BT's visible.

Description of monument and accessories I established to perpetuate the original location of this corner.
As this well casing designating corner was found in excellent condition, it was left as found. Set a 1-1/2" OD iron pipe with 2" brass cap for a witness corner, 30 links west of well casing. Brass cap stamped - S498 T36N R14E
Pipe projects 2' above ground.
NBT's - Hemlock 10" S83°E 63.5 links - scribed 1/16 BT
Hemlock 14" S62°W 21.7 links - scribed 1/16 BT
Measurements and bearings to BT's from true corner.
Well pipe, witness corner, and BT's painted blue.

N-1/16 $\frac{16}{15}$ W.C.
East 30 links
1975

Dated at Argonne, Wis., this 19th day of January, 1976.

Signature *Philip T. Hansen* Title Registered Land Surveyor Registration No. S-498
(County Surveyor, Registered Land Surveyor, or other duly authorized official)

Office of Register of Deeds, County of Forest, I hereby certify that the within instrument was filed in this office for record on the 4th day of February, 1976 at 4:00 o'clock P.M.

Eugene Staszynski
(Register of Deeds)
By Deputy

DOCUMENT NUMBER -- 108712

42614163000